







296307



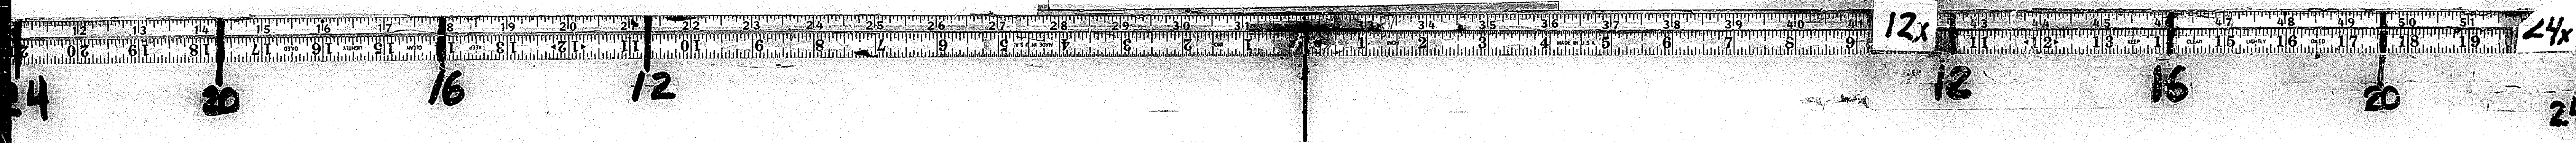

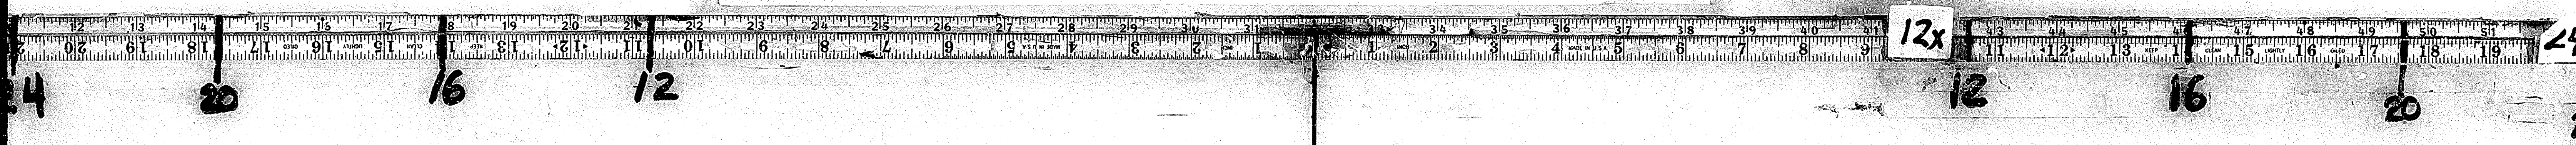

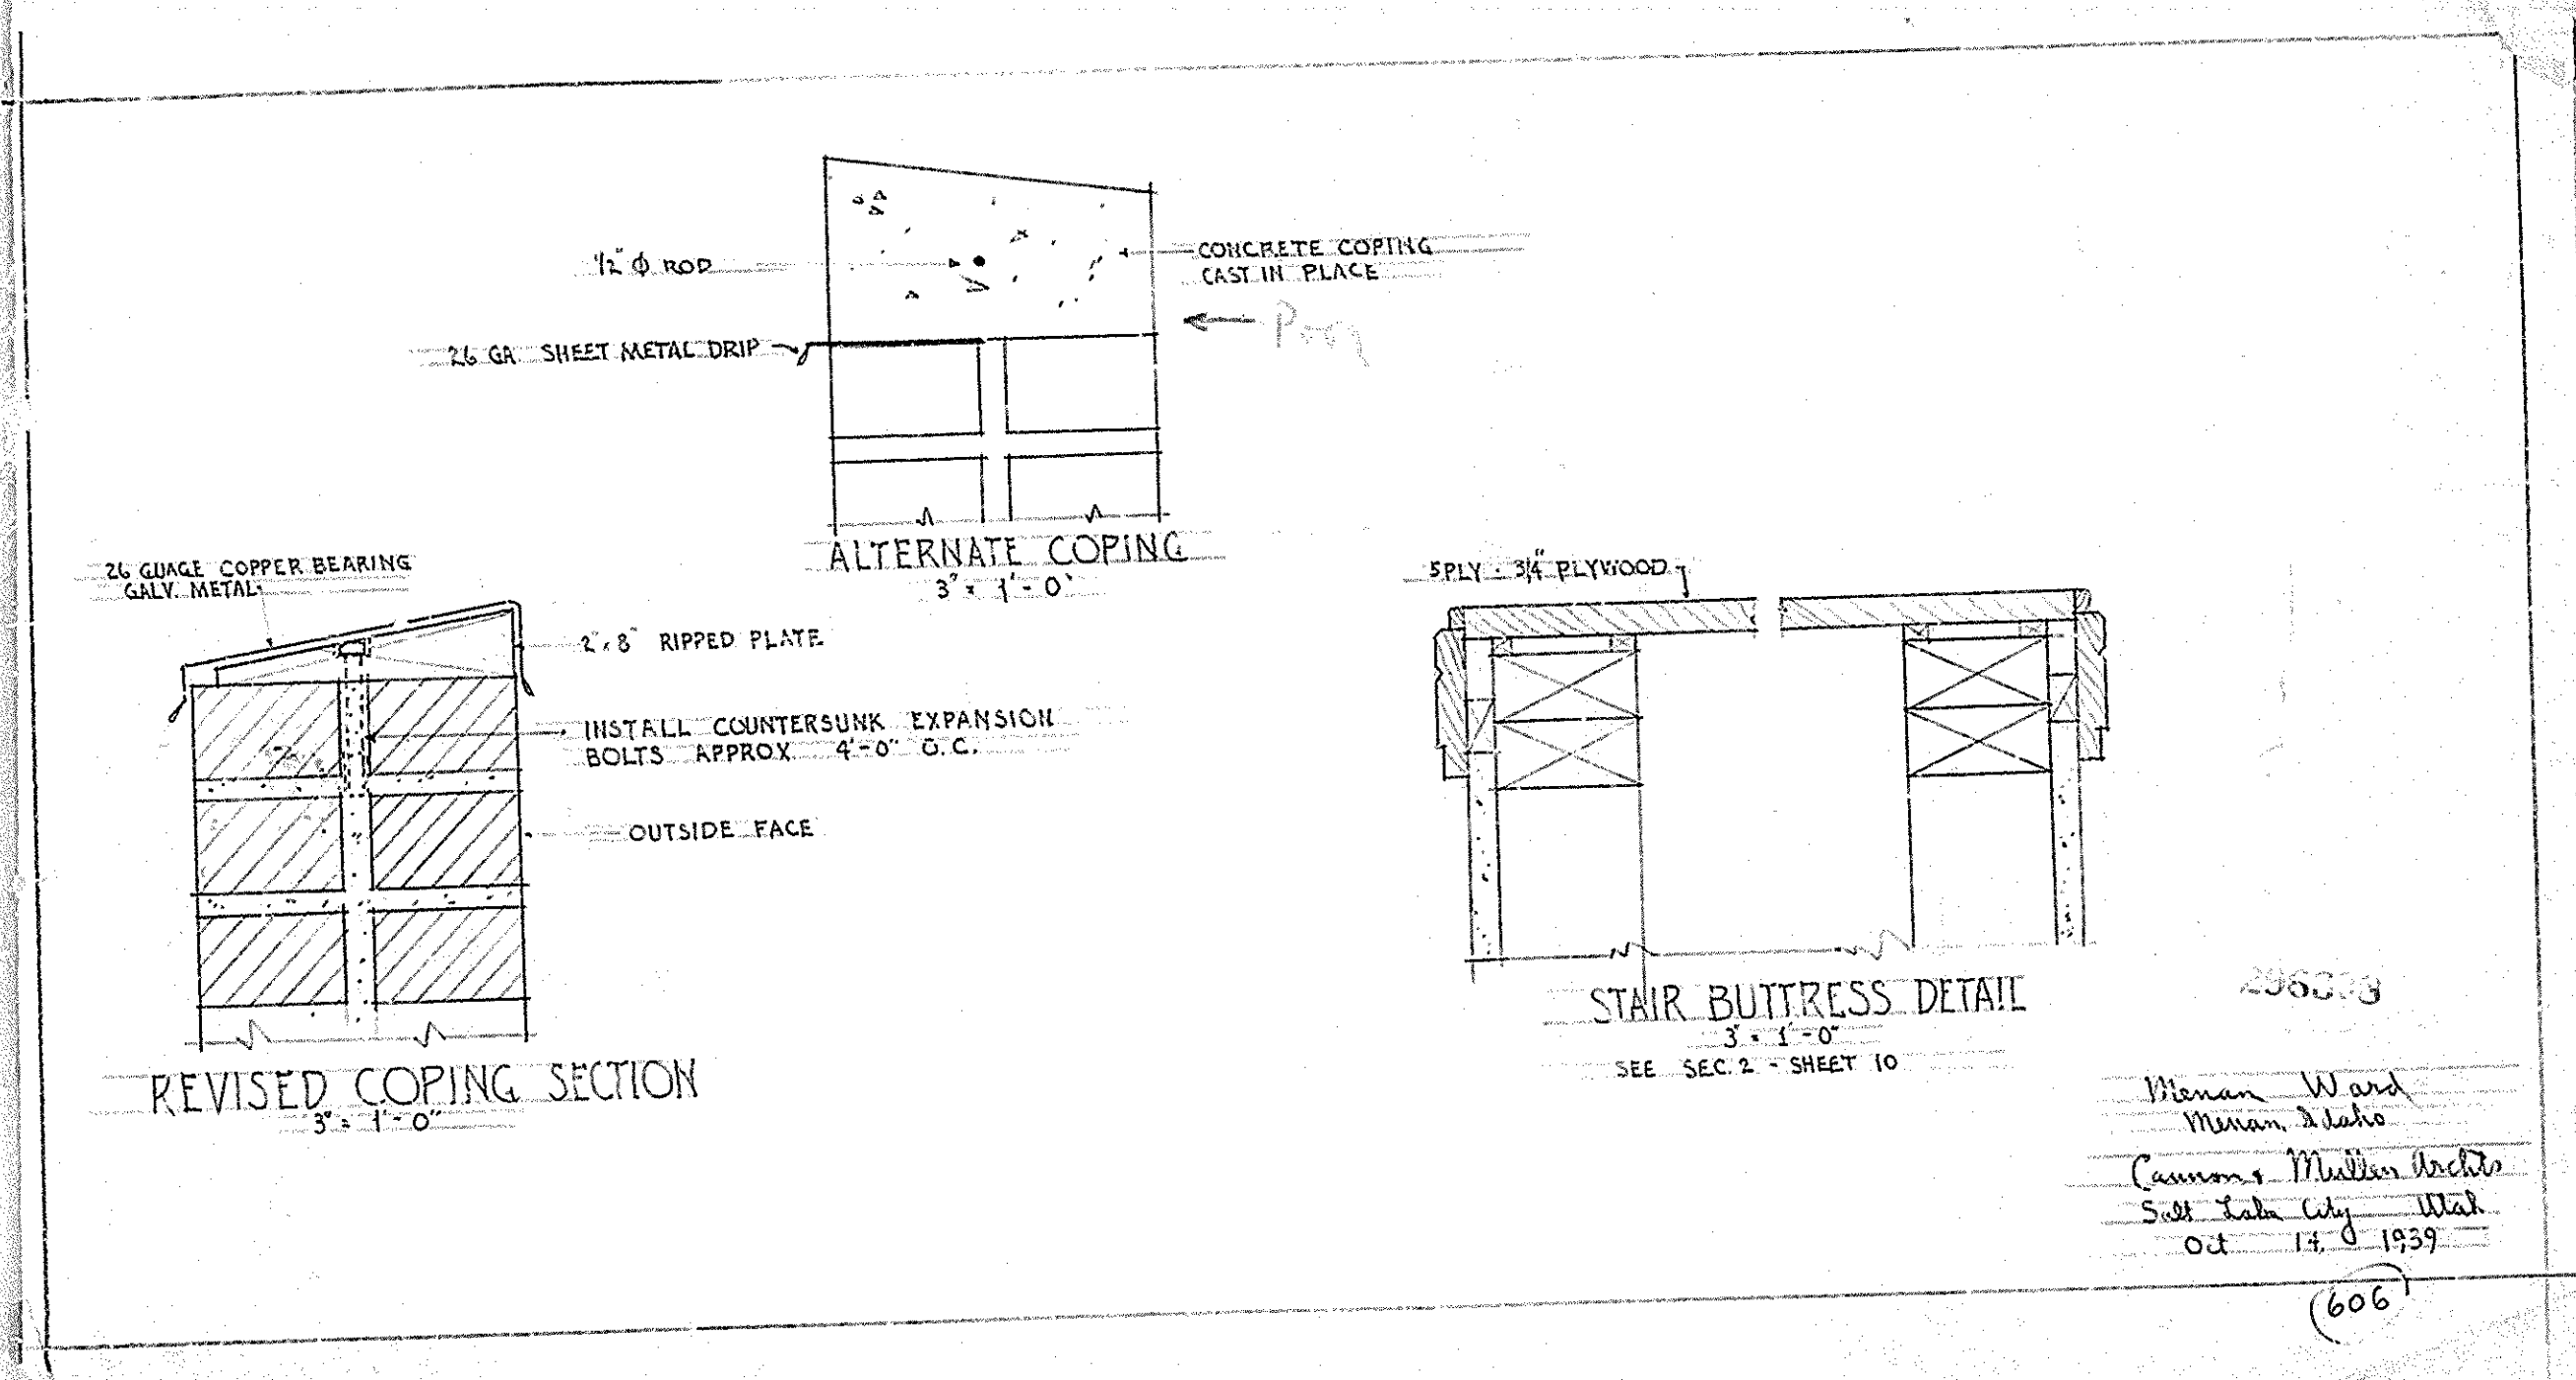

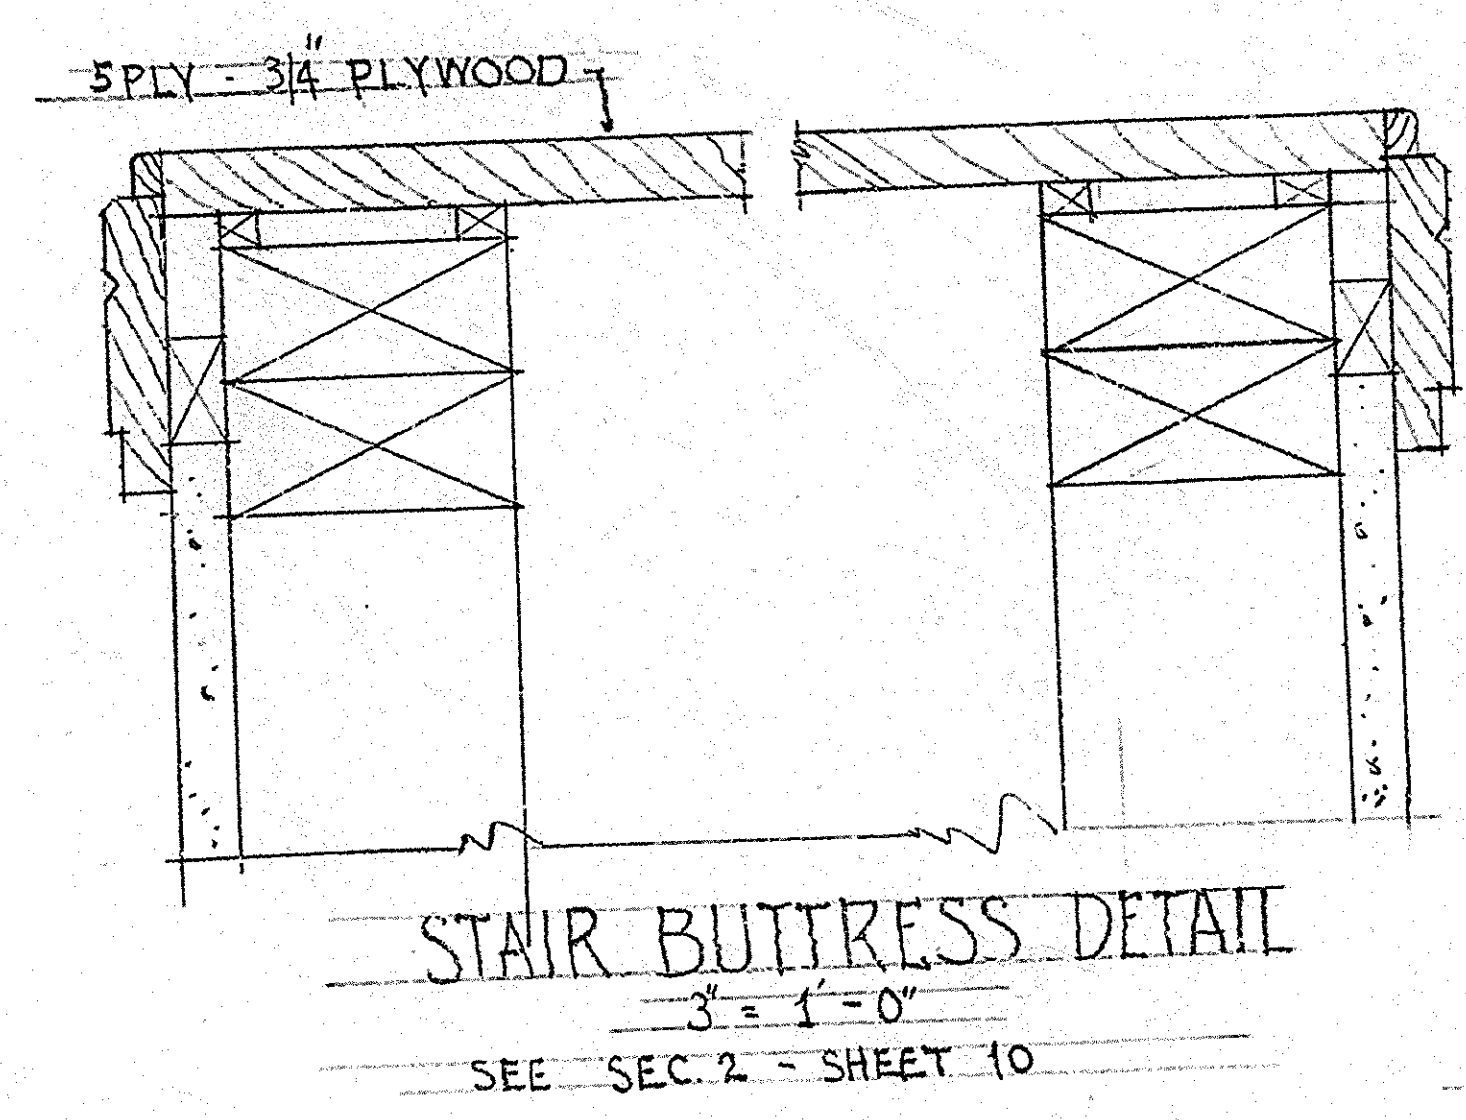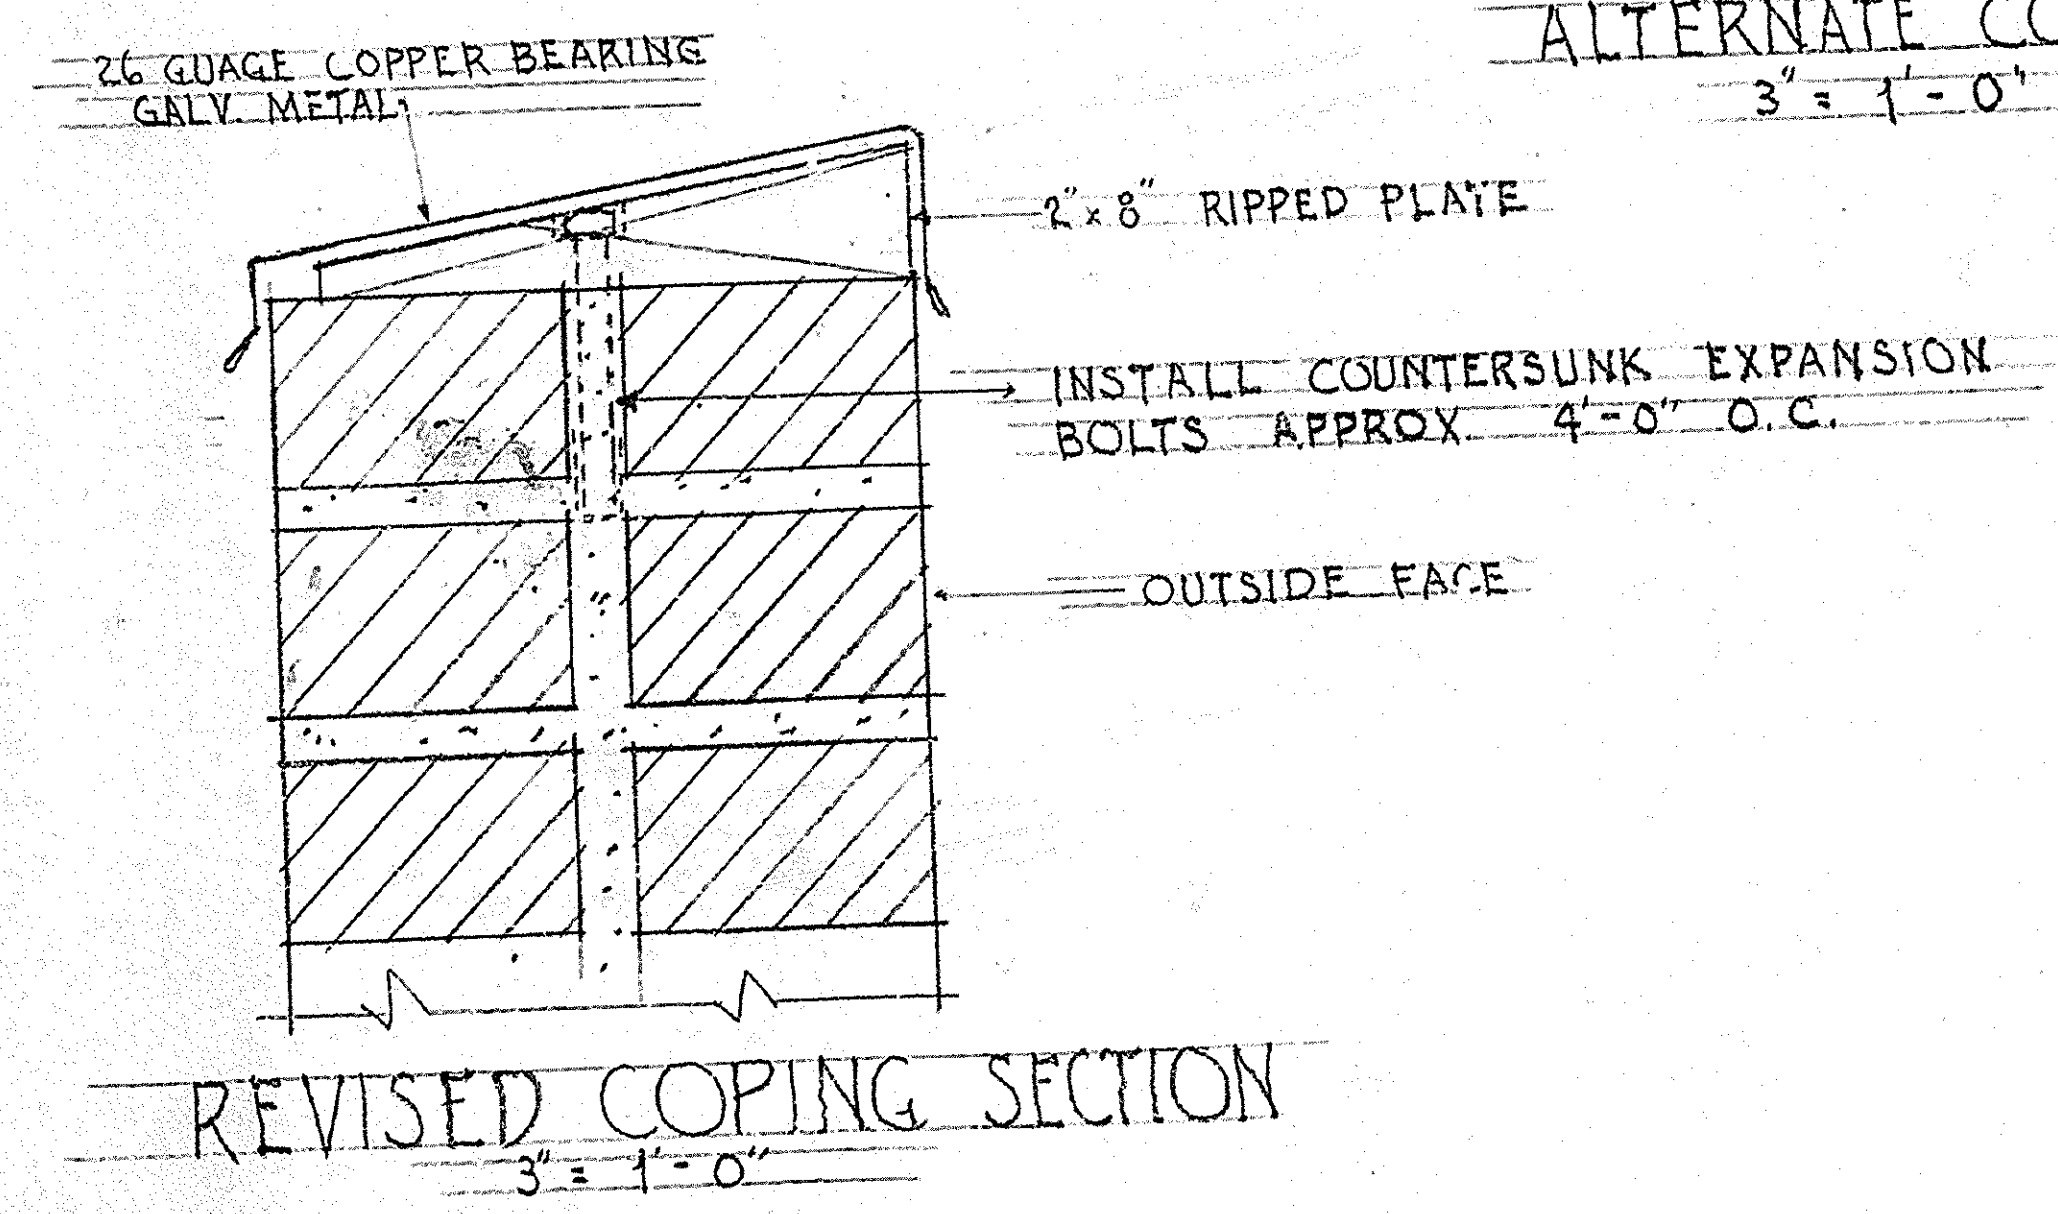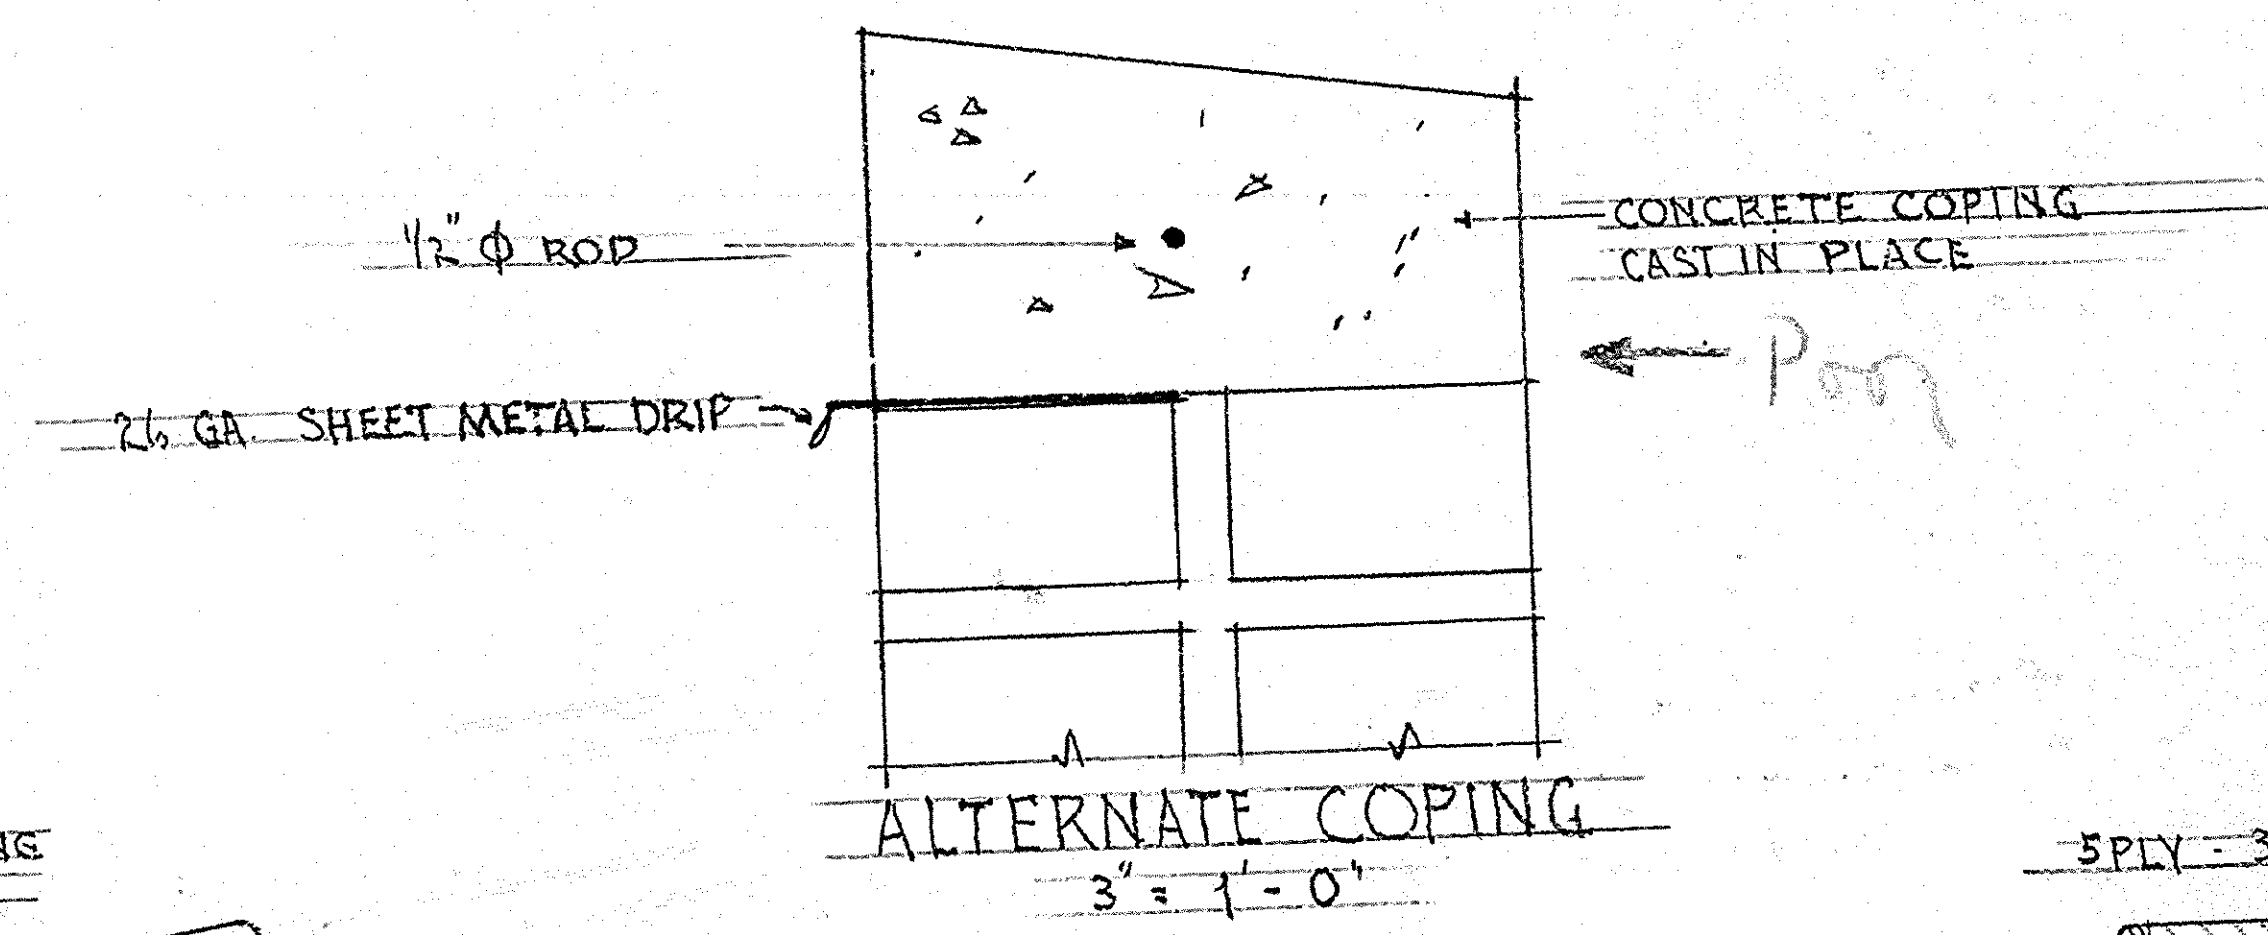

296308

Menan Ward  
Menan, Idaho  
Cannon & Muller Archts  
Salt Lake City Utah  
Oct 14 1939

(606)

296308

12x



ROOM	FLOOR	WOODS	TRIM	WAINSCOT	WALLS	CEILING	NOTE
VESTIBULE STAIR HALL #1	Silver Gray #2062	Driftwood #2063	Driftwood #2063	Monterey Gray #465	Decal Ivory #460	Decal Ivory #460	Submit design for stencil. Finish stencil in Green & Gold. Finish exterior doors in Dark Oak.
CHAPEL	See Spec's	Antique Green	Lighter Green	-	Gold	-	Submit proposed decorating scheme
RECREATION HALL	See Spec's	Driftwood #2063	Driftwood #2063	Foam Green #461	Monterey Gray #465	-	" " " "
STAGE	See Spec's	Silver Gray #2062	Silver Gray #2062	-	Horizon Blue #463	Horizon Blue #463	
BISHOP'S OFFICE	See Spec's	Warm light Green	Warm light Green	-	Canary #4159	-	Submit design for stencil. Stencil to be darkest tone of wall color.
CLASS RM 1107 INCLV KINDER GARTEN BANQUET RM HALL #3 COAT RM AARONIC PRIESTHOOD STAIR HALL #2	Silver White #5478	Silver Gray #2062	Silver Gray #2062	Foam Green #461	Green lighter than #461	Green lighter than wall	Floors include cement base
RELIEF SOCIETY	Silver White #5478	Silver Gray #2062	Silver Gray #2062	Foam Green #461	Green lighter than #461	Cream #4164	Submit design for stencil. Stencil to be Apricot #4154. Ceiling includes wall to top of stencil. Floor includes base.
KITCHEN MENS RM	Silver White #5478	Silver Gray #2062	Silver Gray #2062	Monterey Gray #465	Monterey Gray #465	White	Kitchen cabinets to be finished in white. Toilet stalls in Silver Gray.
WOMENS RM	Silver White	Driftwood #2063	Driftwood #2063	Wisteria #468	Wisteria #468	White	Toilet stalls to be finished in white. Floor includes base.
BOILER RM COAL RM SAC. RM BOOK ST. CLOSETS	See spec's	Silver Gray #2062	Silver Gray #2062	-	-	-	

NOTE:


Submit samples for stain & varnish work on type of wood to be used.  
 Submit sketches showing extent of decorating and color scheme proposed for chapel and recreation hall under \$350.00 allowance in Specs.  
 Exterior wood work, window sash, frames, and shutters to be finished in cream #5430.  
 See spec's for type of finish and extent of painting not in this schedule.

Wenau J. D. J. Chaput  
 Cannon & Allen Architects  
 10 12 39

296013


Trimming Line

605

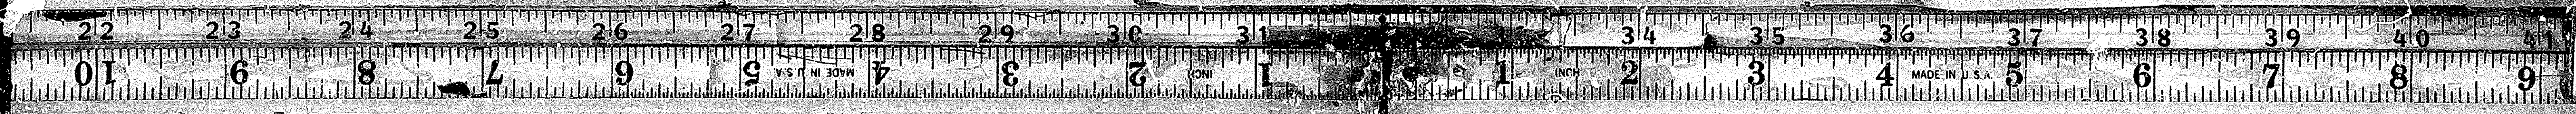


12x

2

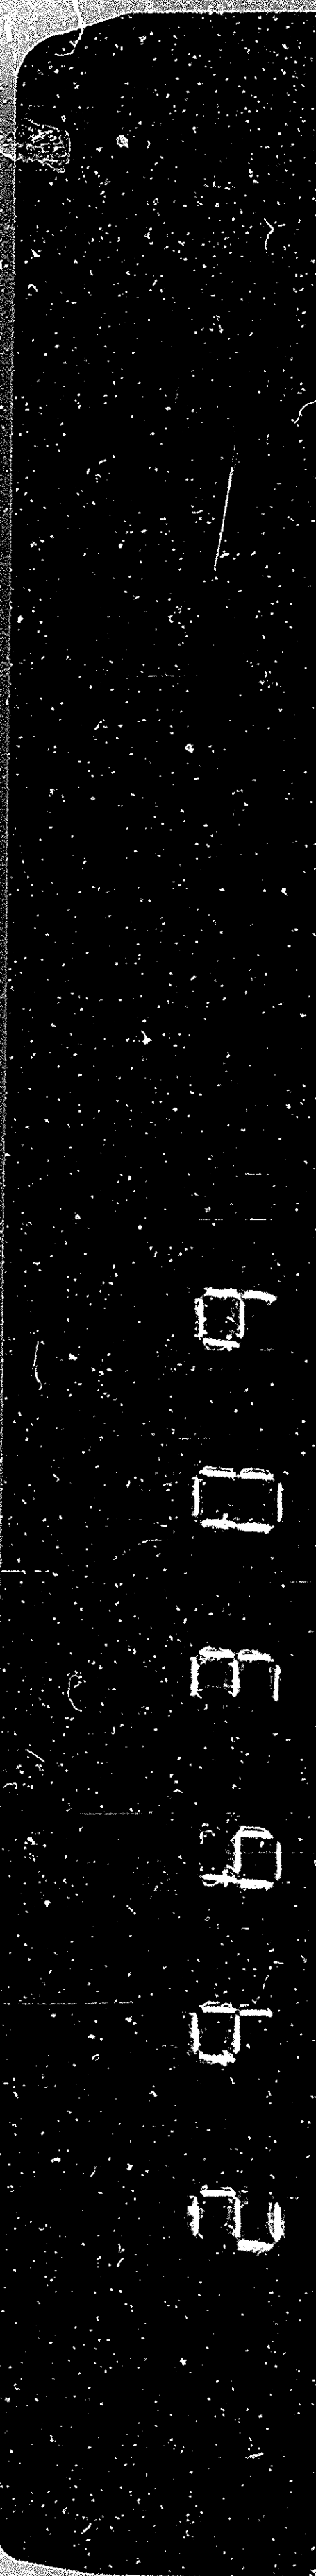



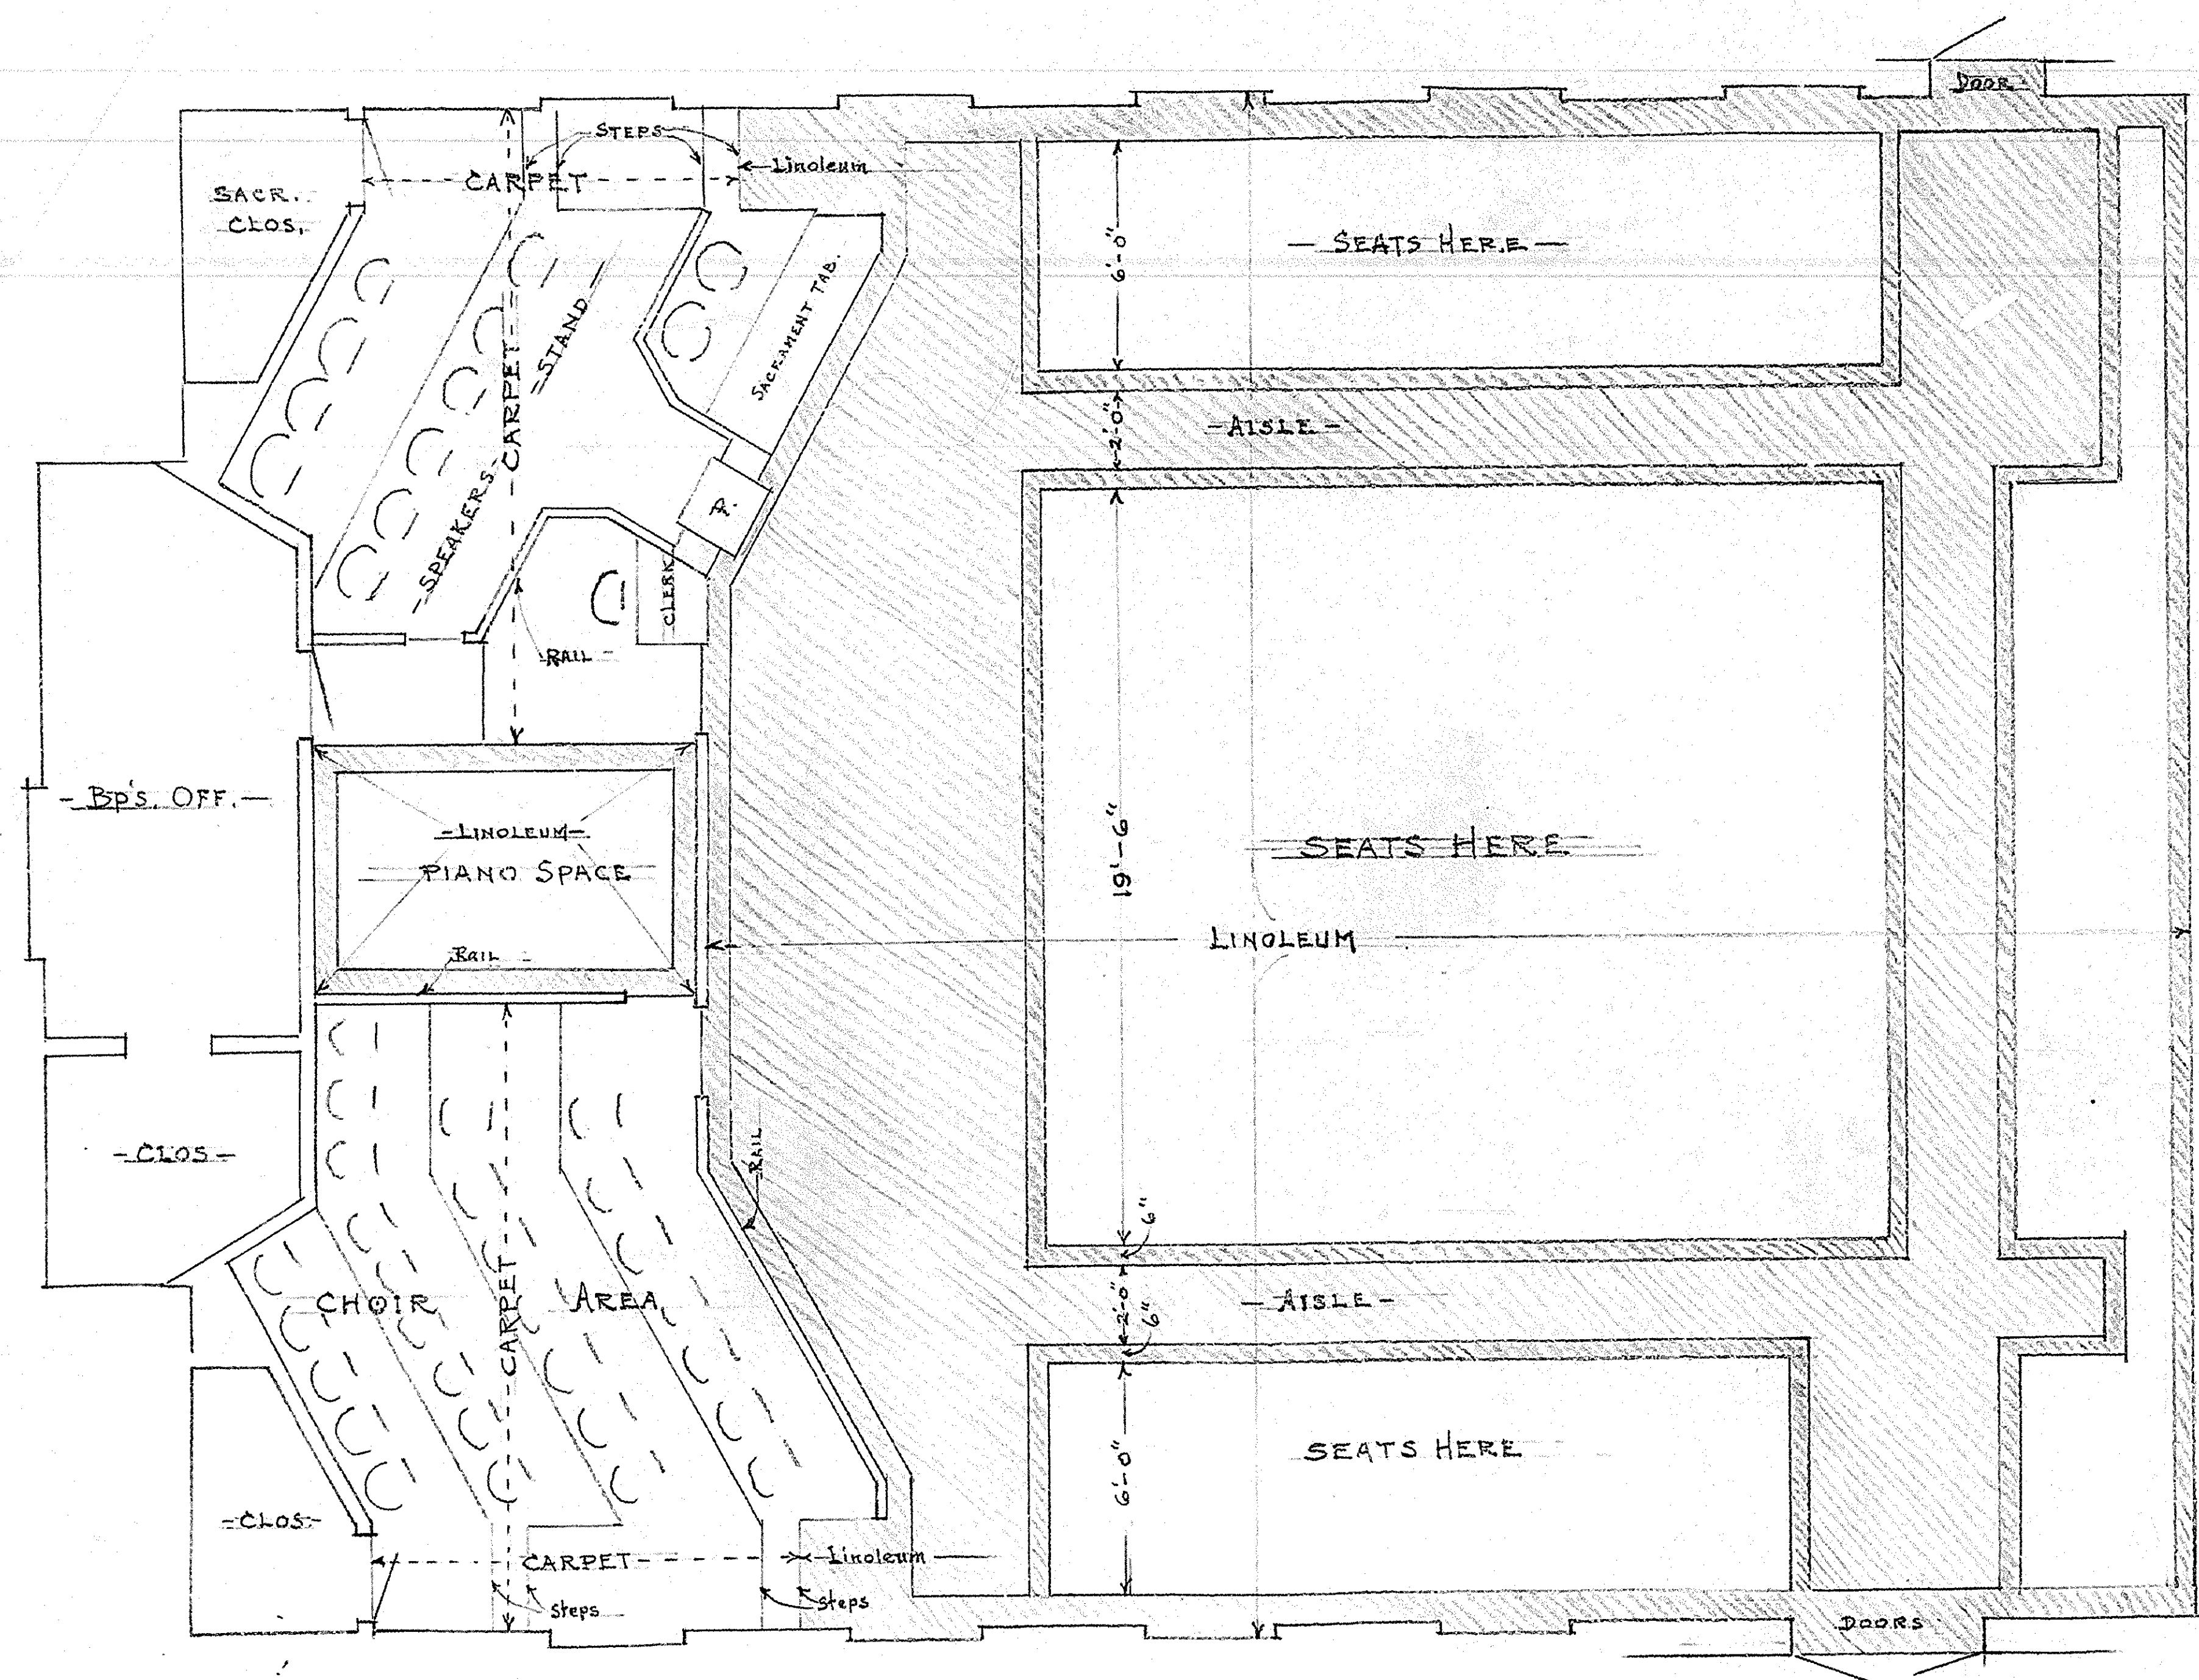


296810

- CHAPEL PLAN -  
 - SHOWING LINOLEUM AND CARPET COVERED AREAS -  
 - SCALE 1/4" -

LDS CHAPEL - MENAN, IDAHO -  
 CANNON AND MULLEN, ARCHTS.  
 SALT LAKE CITY, UTAH  
 12/18/39

(604)

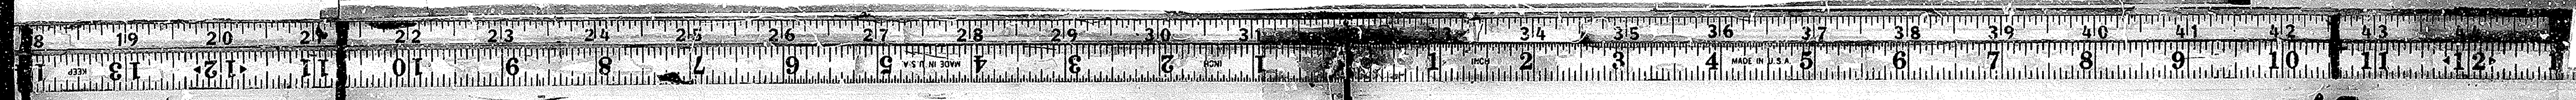


6

12

12



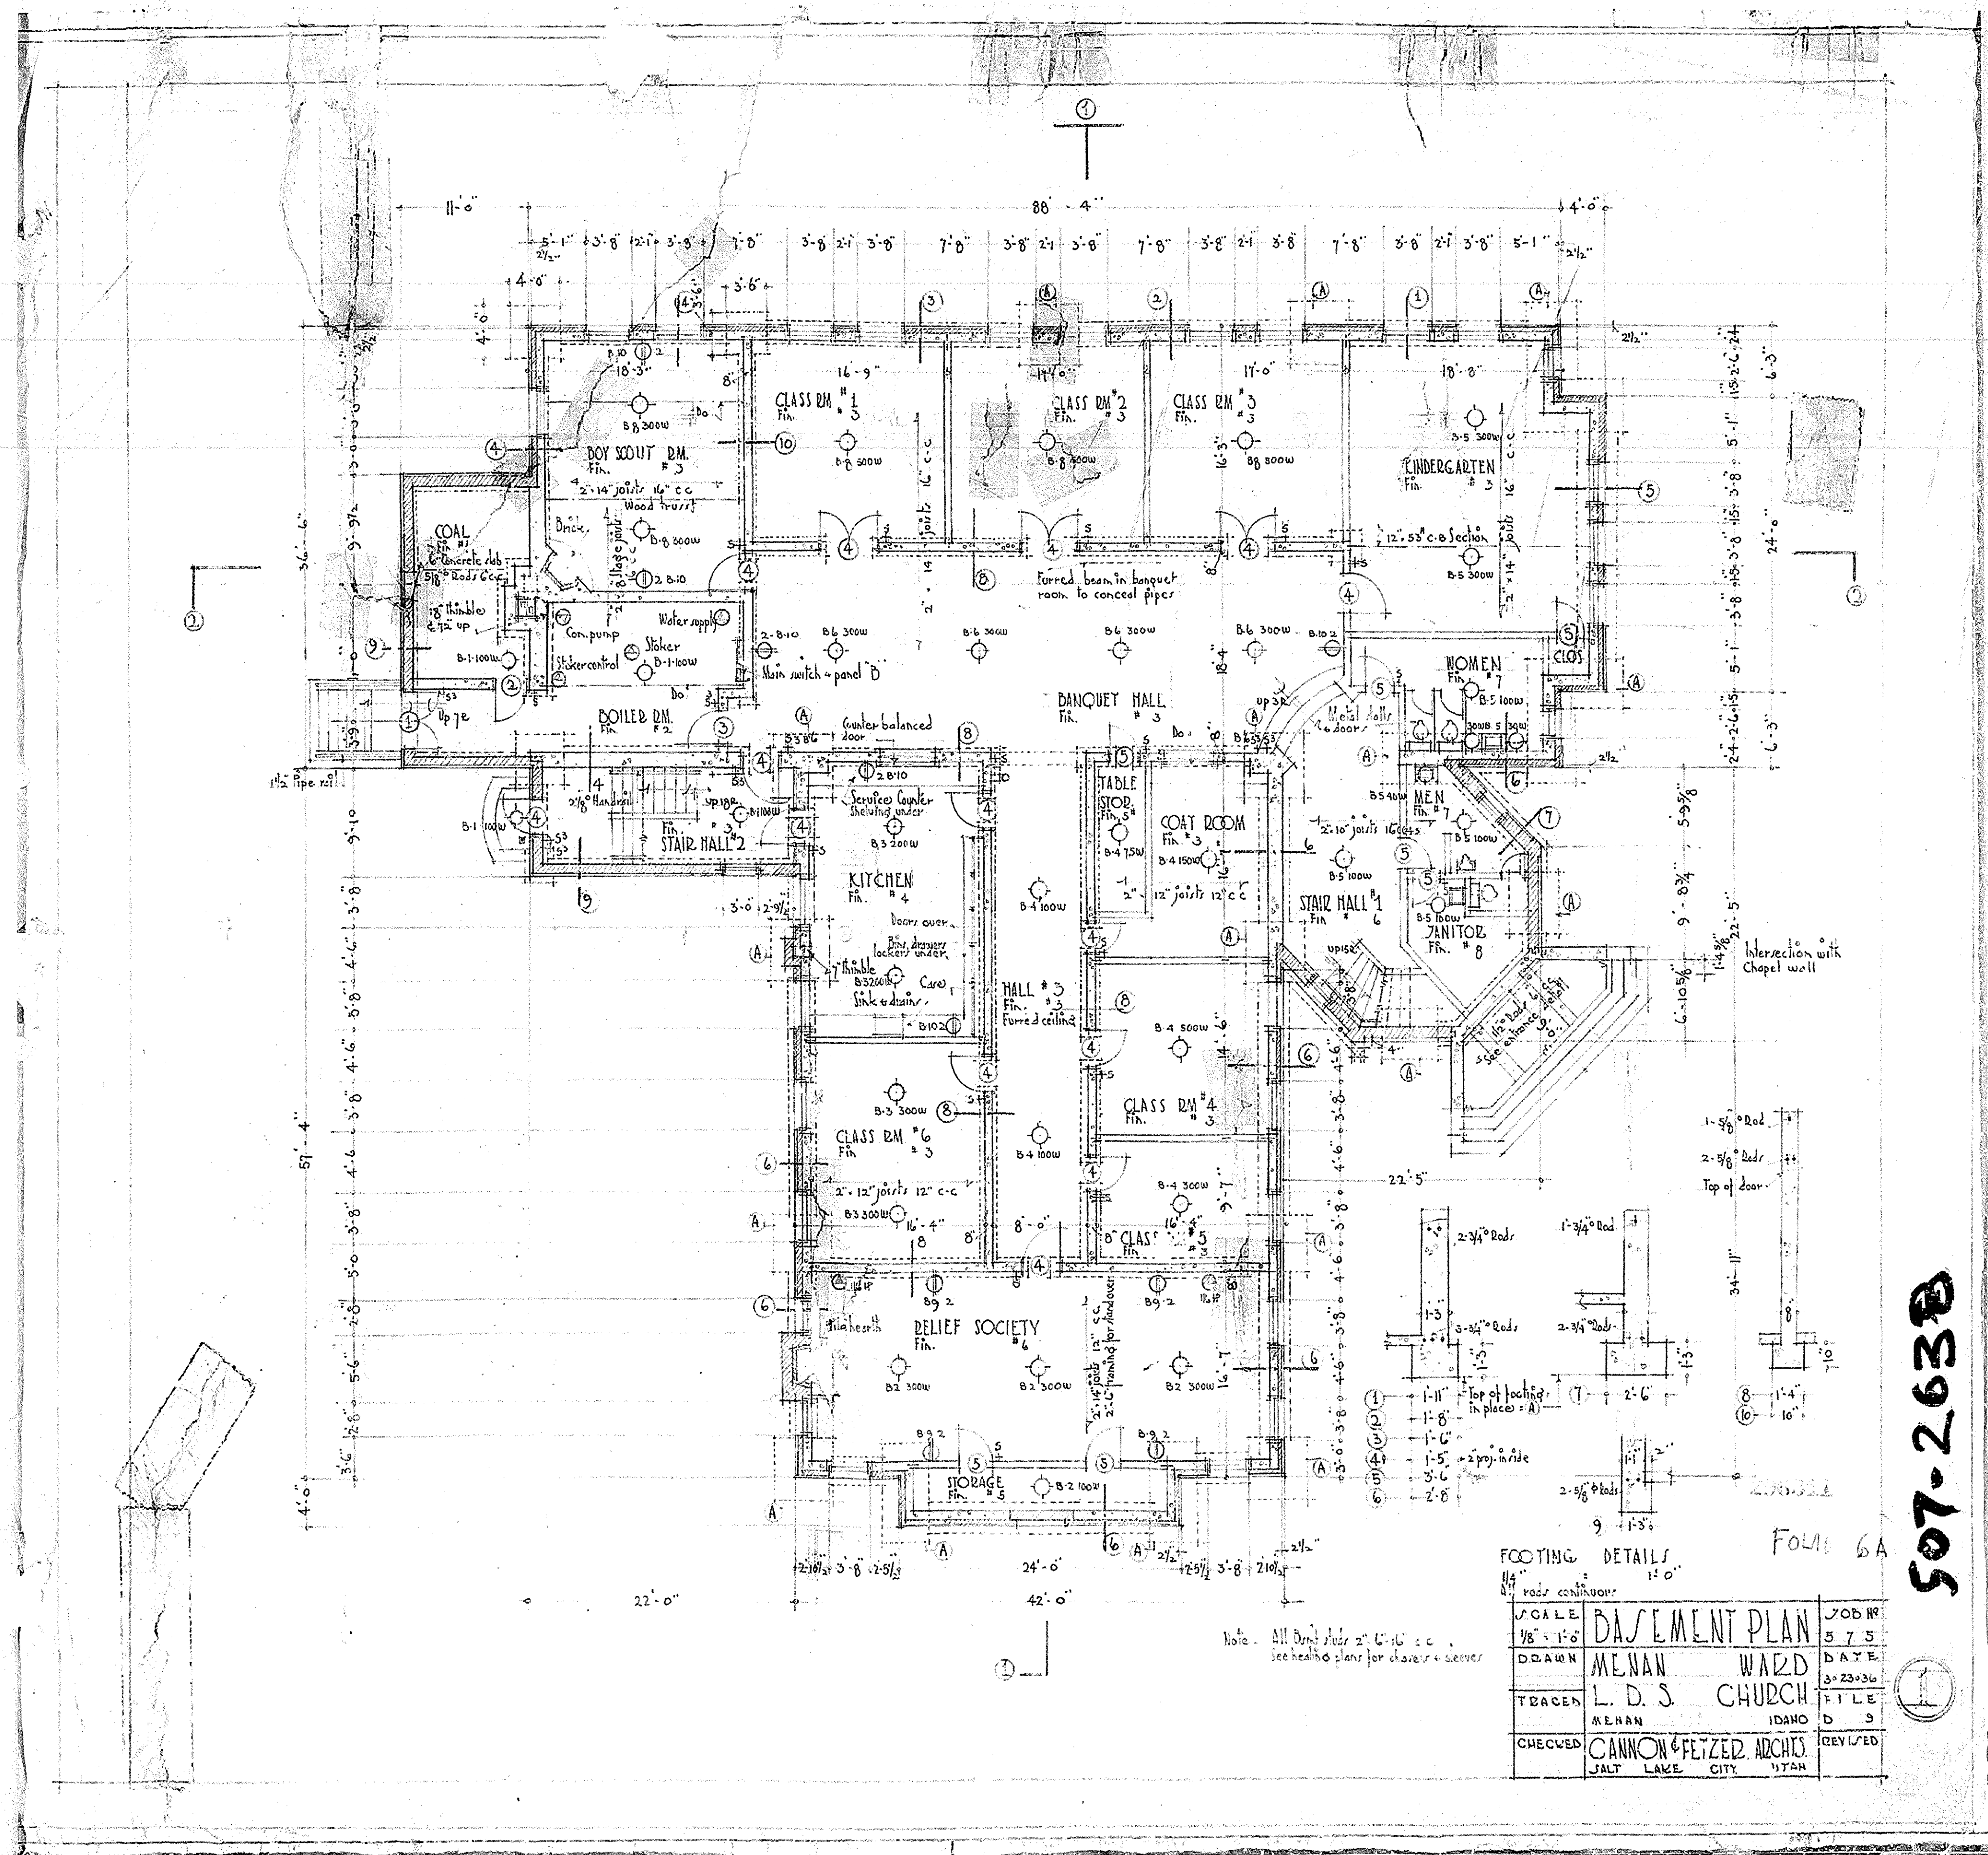

FOOTING DETAILS

1/4" floor construction

SCALE	1/8" = 1'-0"	JOB NO.	575
DRAWN	MENAN	DATE	3-23-36
TRACED	L. D. S. CHURCH	FILE	D 3
CHECKED	CANNON & FETZED, ARCHTS.	REVISED	
	SALT LAKE CITY		UTAH

507-263B



16

12



12

16

20x

2969111



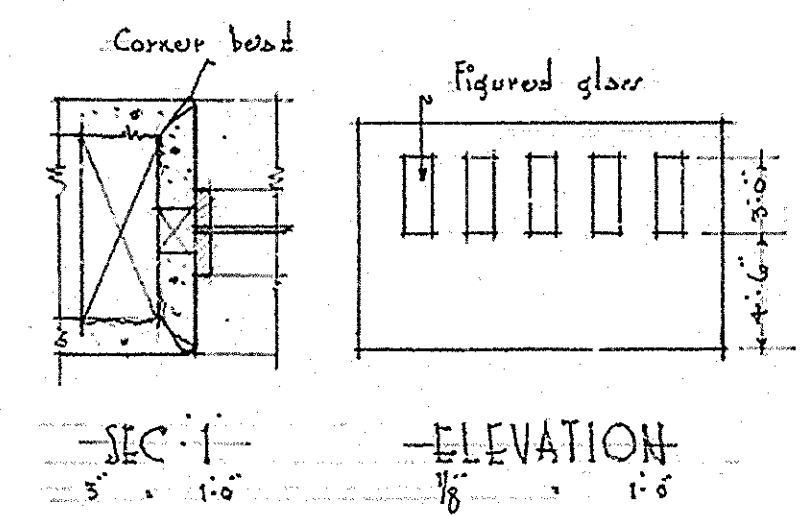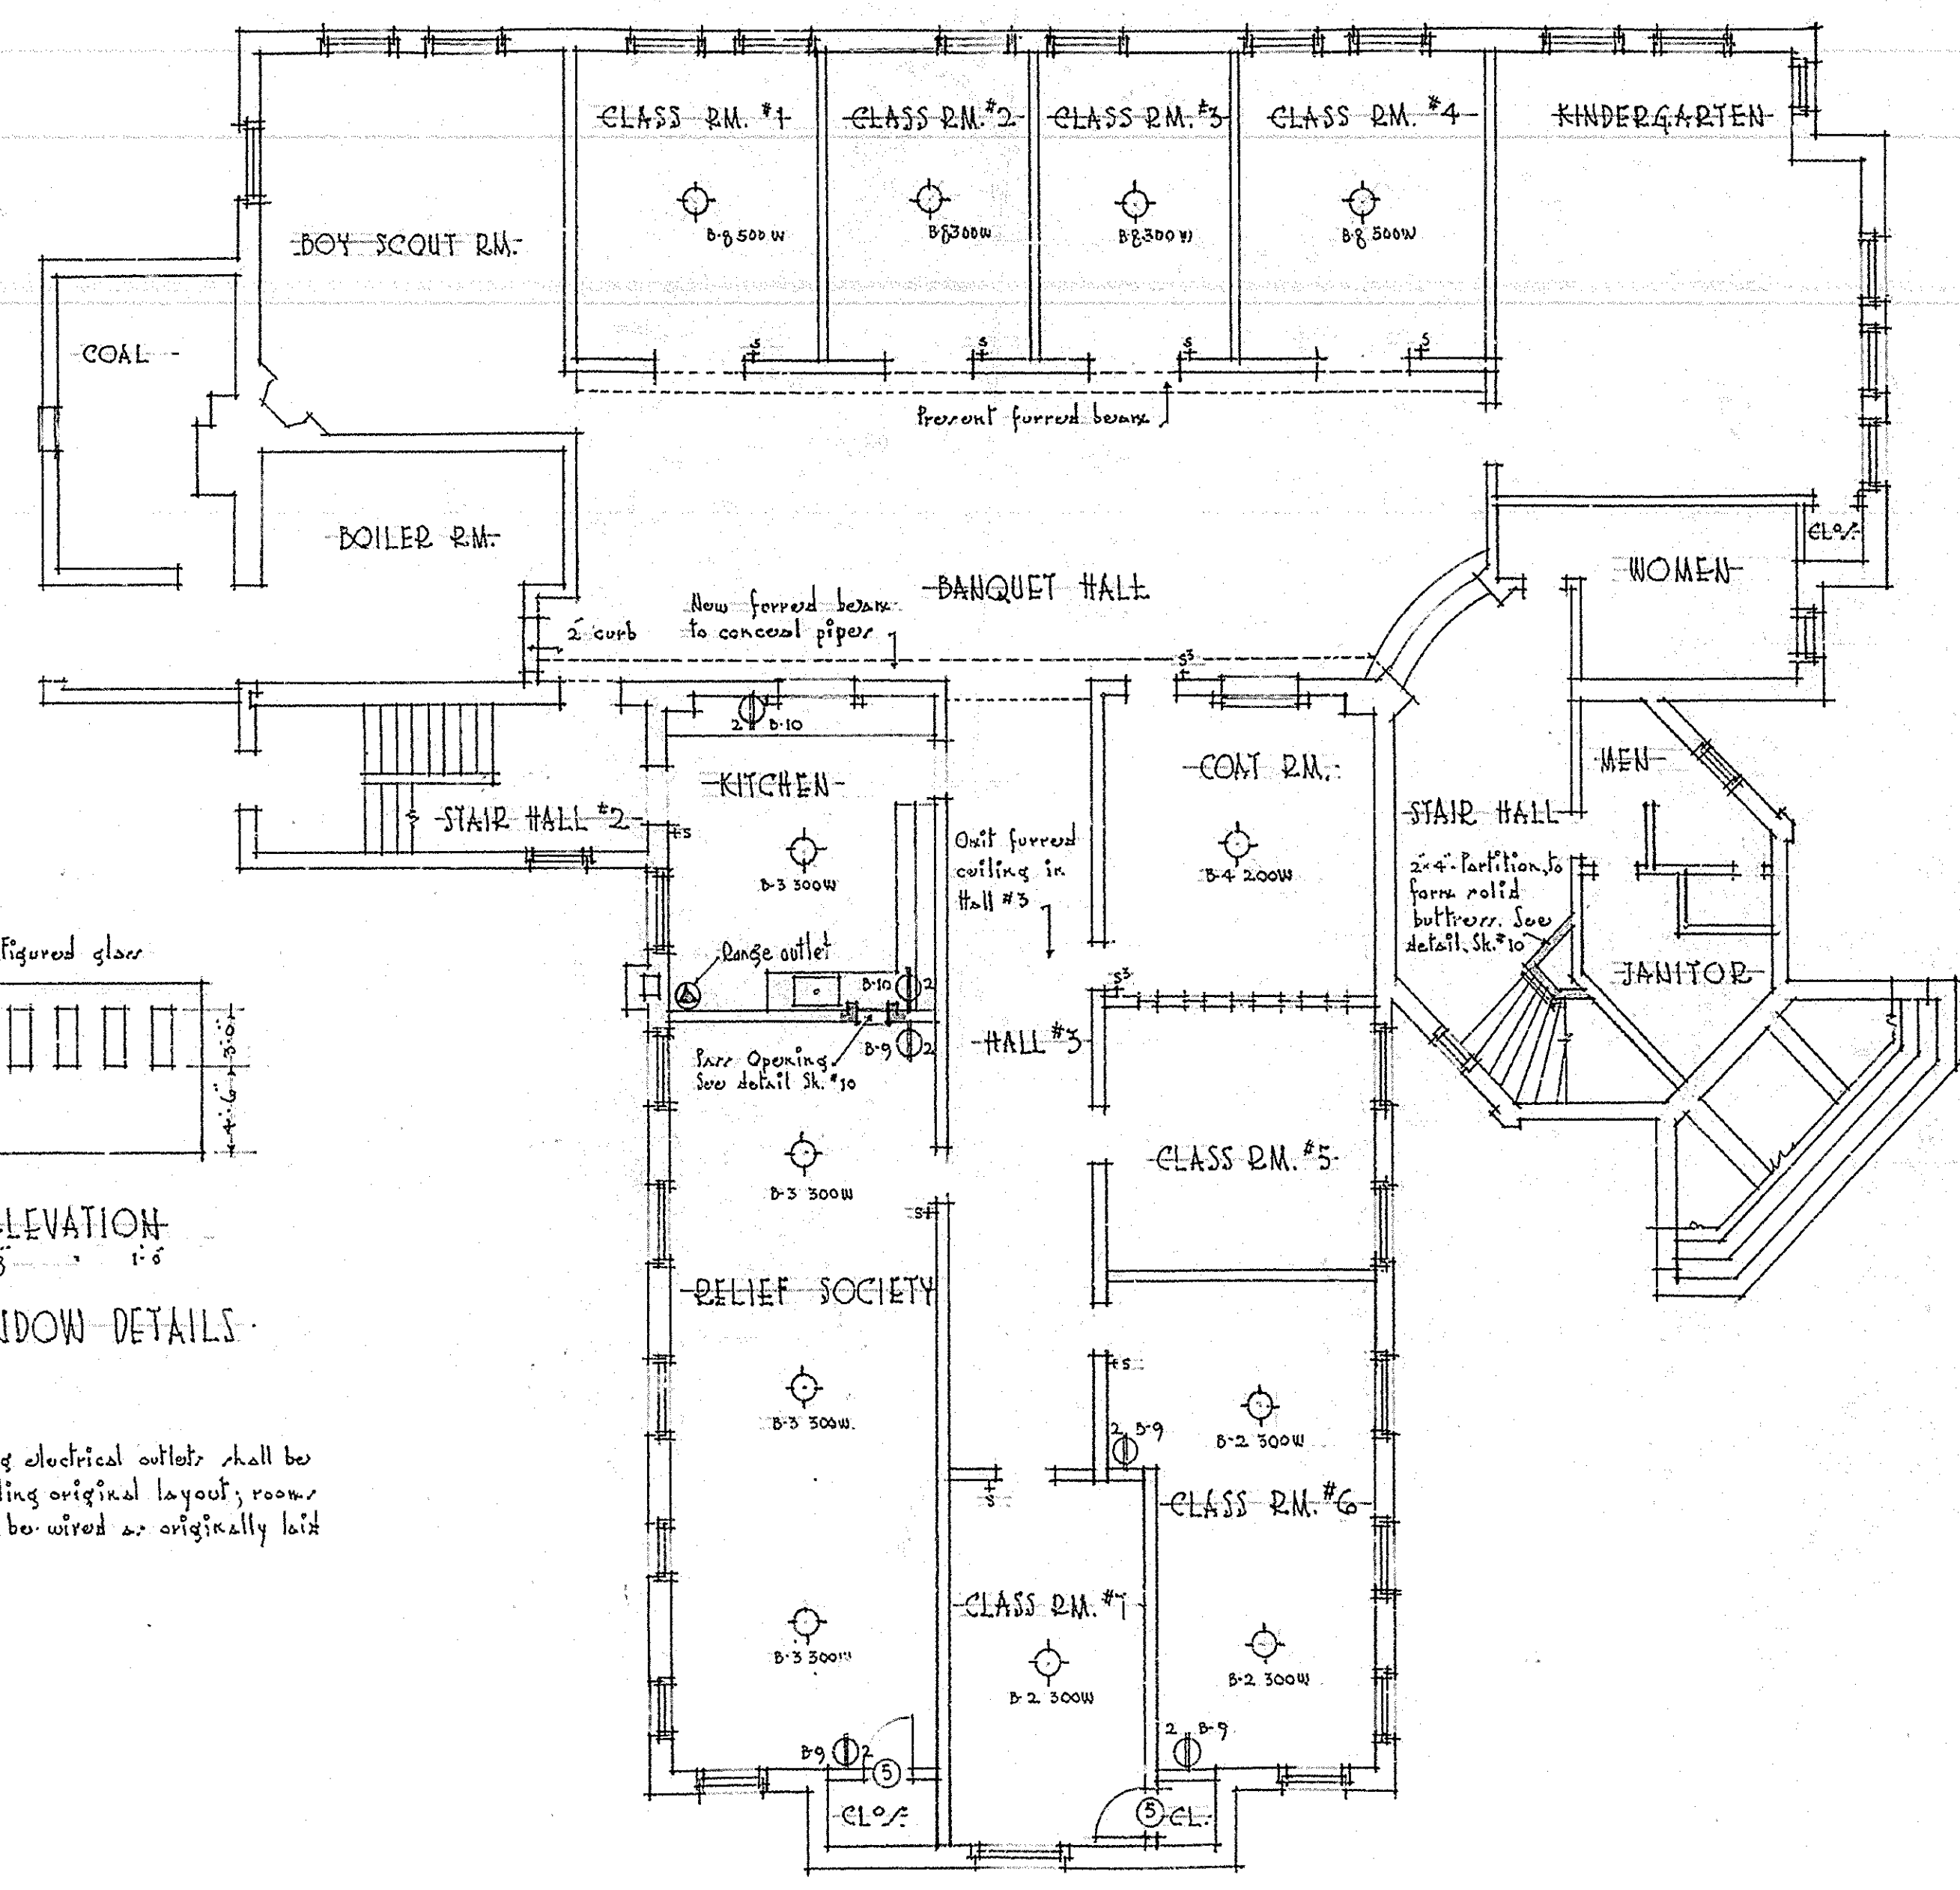

SEC. 1 - ELEVATION  
 1/8" = 1'-0"


COAT ROOM WINDOW DETAILS

NOTES: Rooms showing electrical outlets shall be wired as shown, disregarding original layout; rooms not showing outlets will be wired as originally laid out.

236012

SCALE 1/8" = 1'-0"	BASEMENT PLAN	JOB NO. 575
DRAWN R. F. M.	MENAN WARD	DATE 8-1-35
TRACED R. F. M.	L. D. S. CHURCH	FILE D-9
CHECKED J. L. M.	CANNON & FETZER ARCHT. SALT LAKE CITY, UTAH.	REVISED 8-1-35

1-A

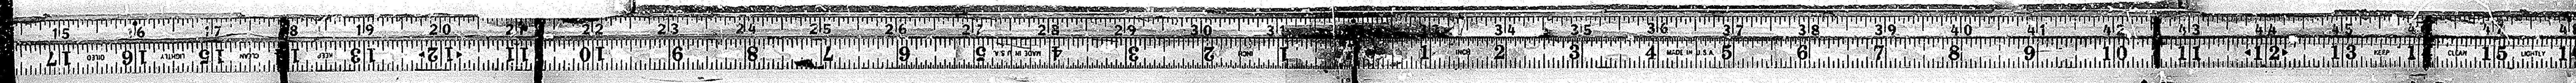

16


12

12

16

20



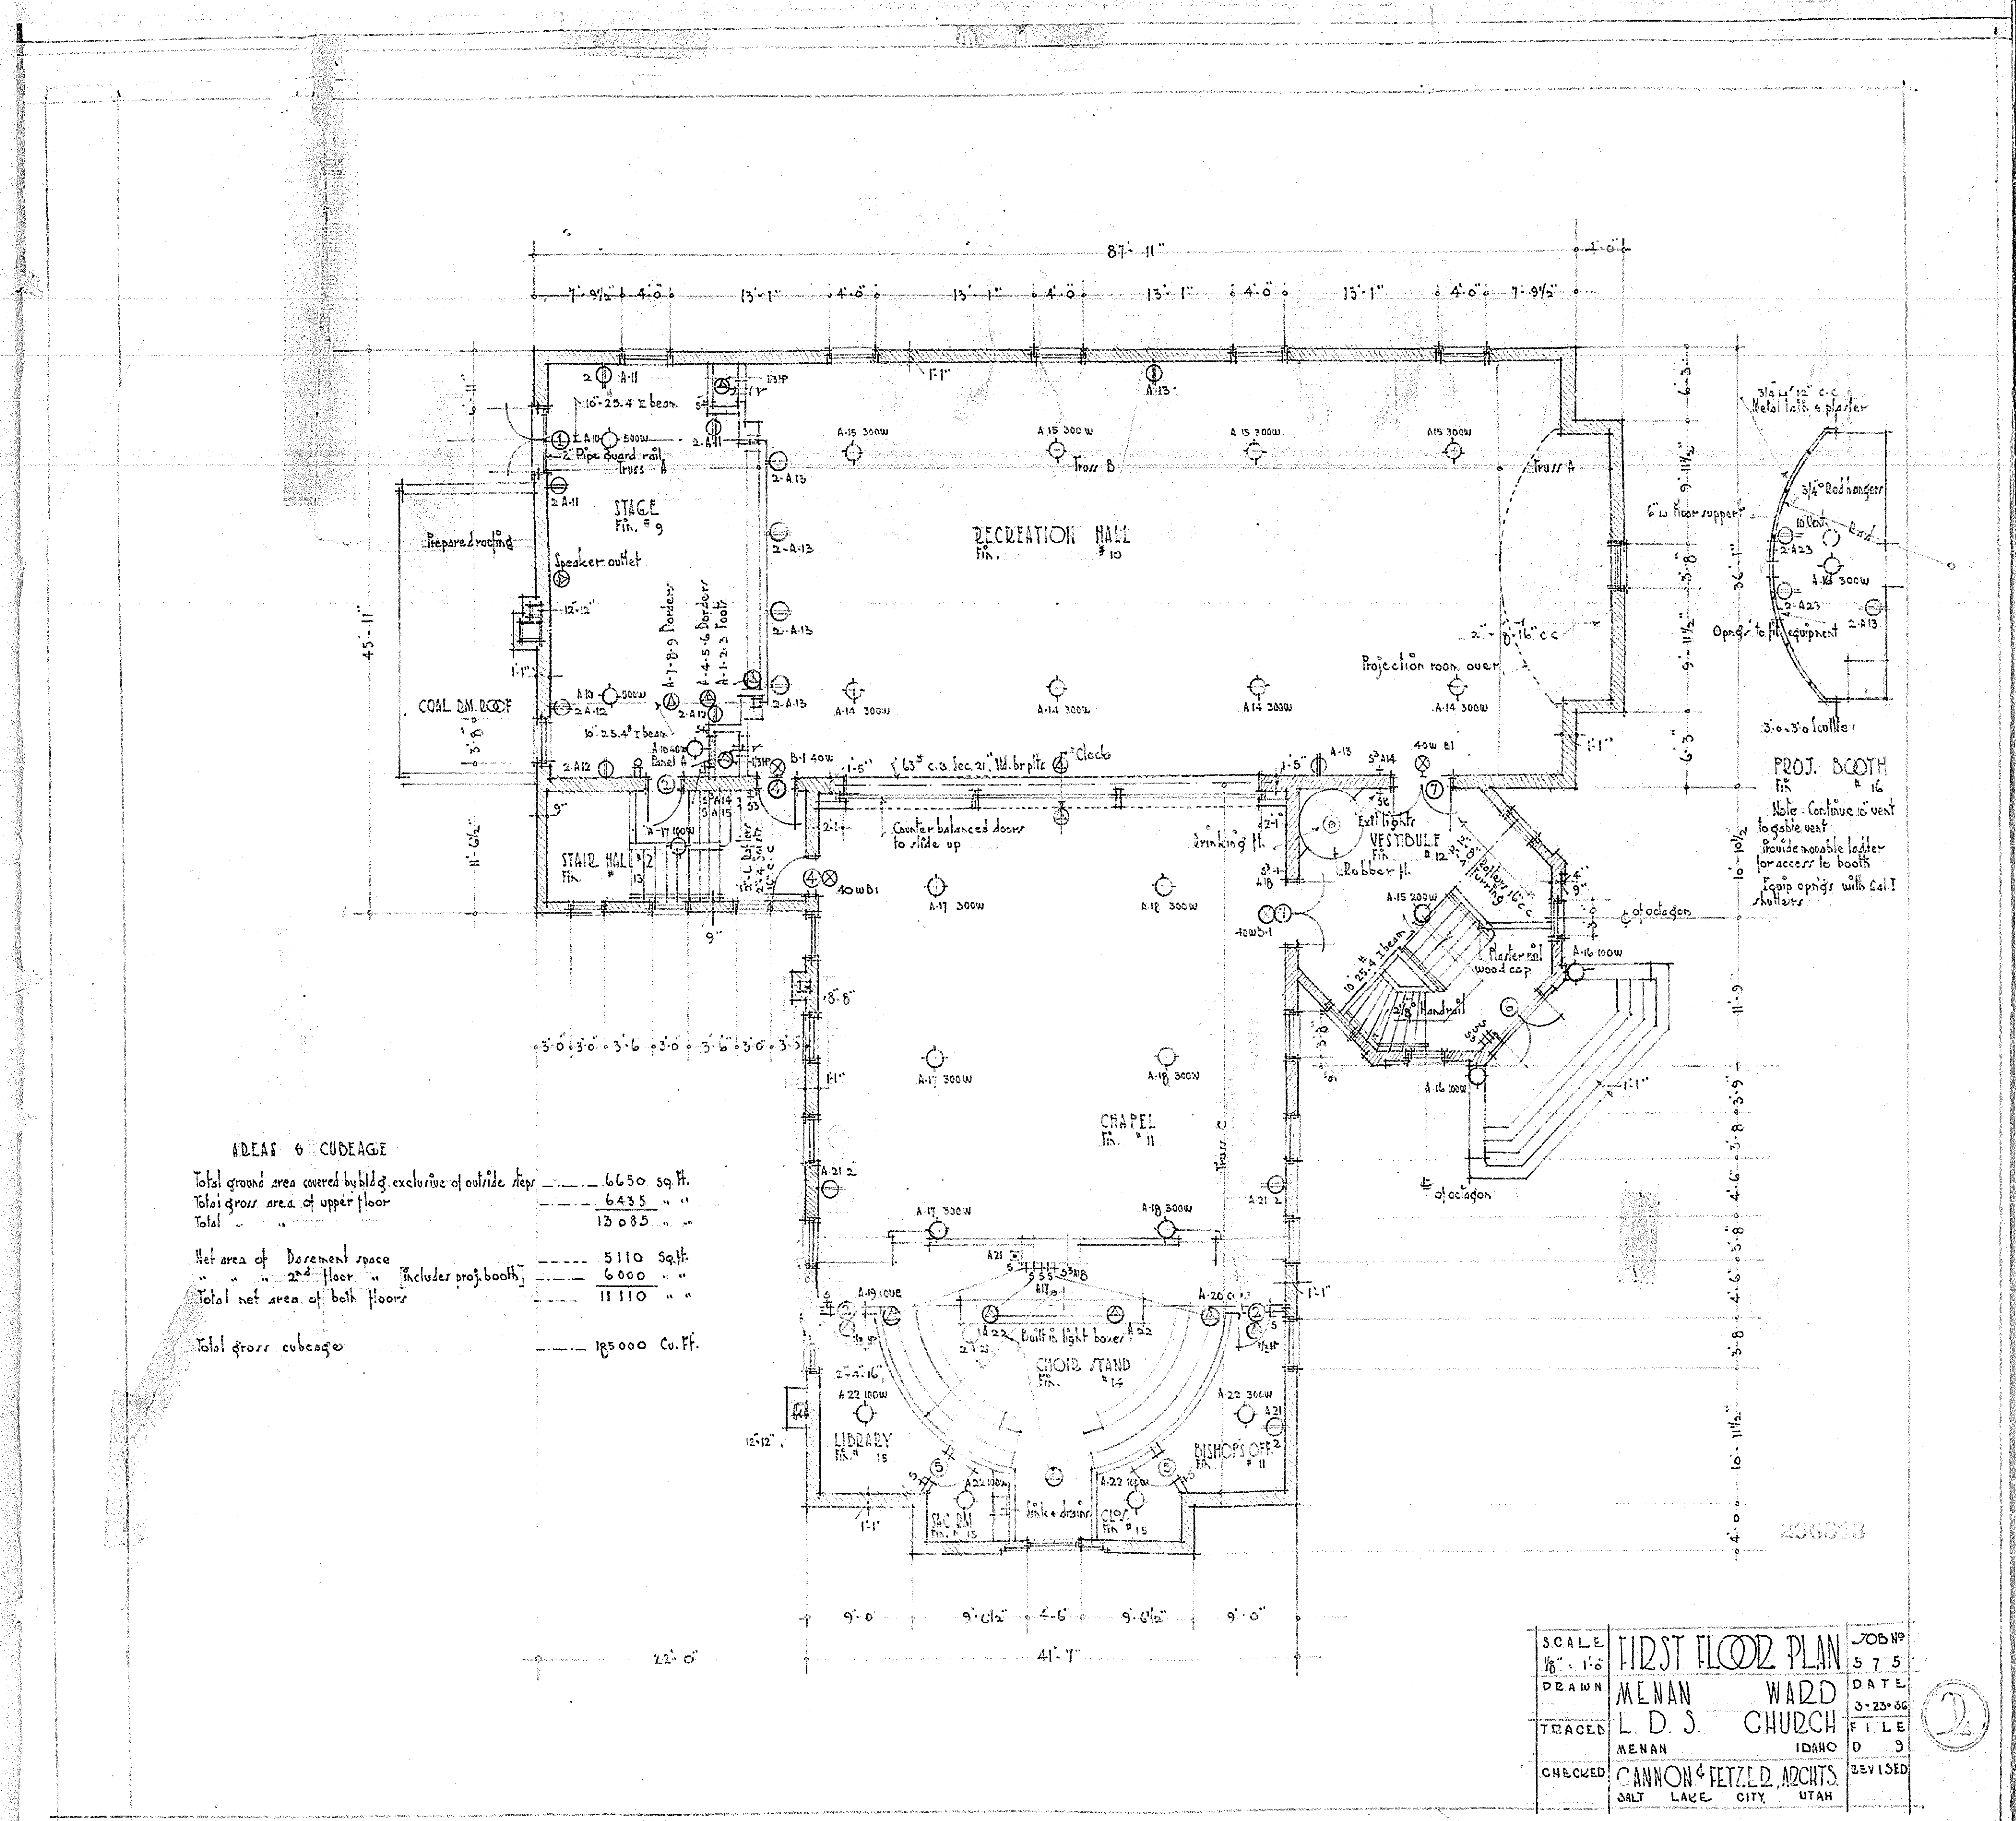

IDEAS & CODEAGE

Total ground area covered by bldg exclusive of outside steps ..... 6650 sq. ft.  
 Total gross area of upper floor ..... 6435 " "  
 Total ..... 13085 " "

Net area of basement space ..... 5110 sq. ft.  
 " " 2nd floor " [includes proj. booth] ..... 6000 " "  
 Total net area of both floors ..... 11110 " "

Total gross cubeage ..... 185000 Cu. Ft.

SCALE	FIRST FLOOR PLAN	JOB NO.
1/8" = 1'-0"	MENAN WARD	575
DRAWN	L. D. S. CHURCH	DATE
TRACED	MENAN IDAHO	3-25-56
CHECKED	CANNON & FETZEL, ARCHTS.	FILE
	SALT LAKE CITY UTAH	D 9
		REVISED

E 1 E 9 B 2



16


12

12


16

20x



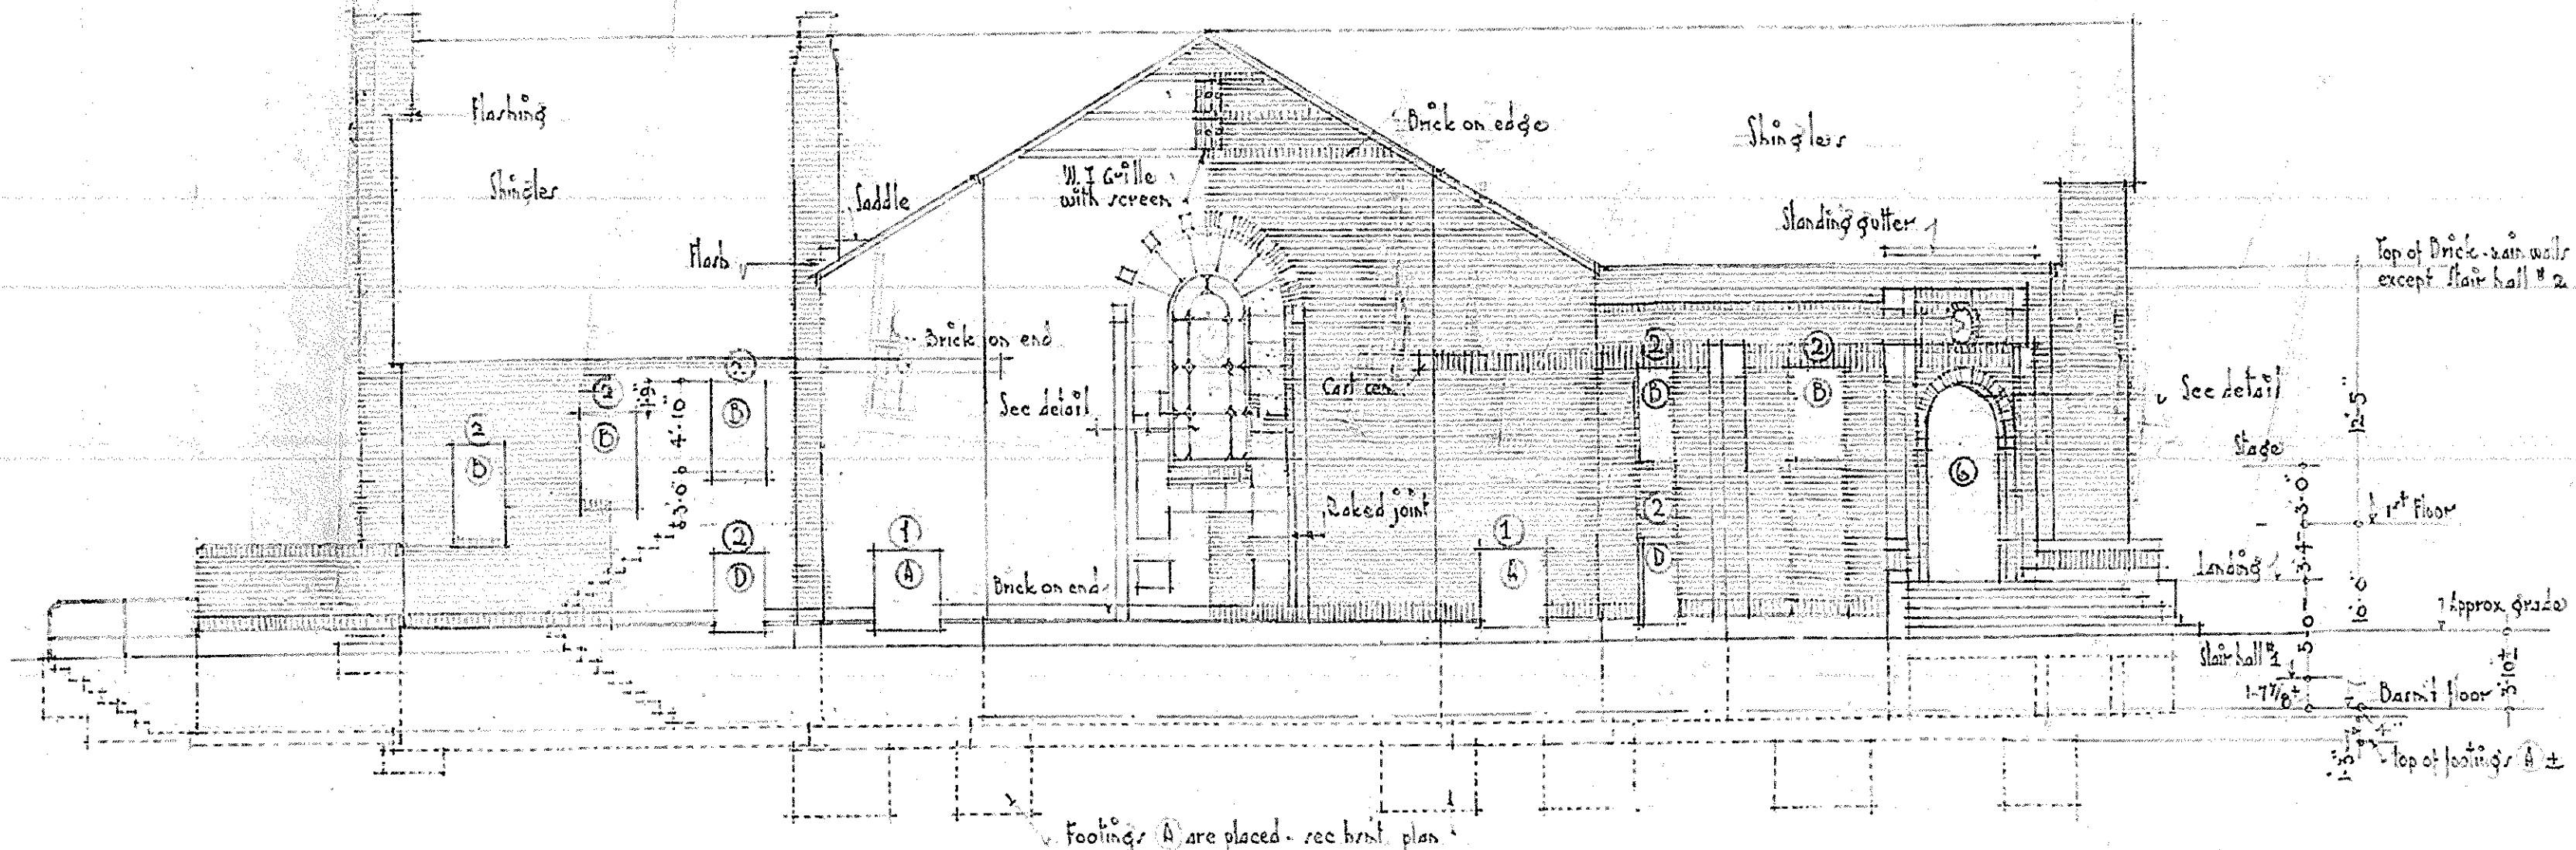


SOUTH ELEVATION.

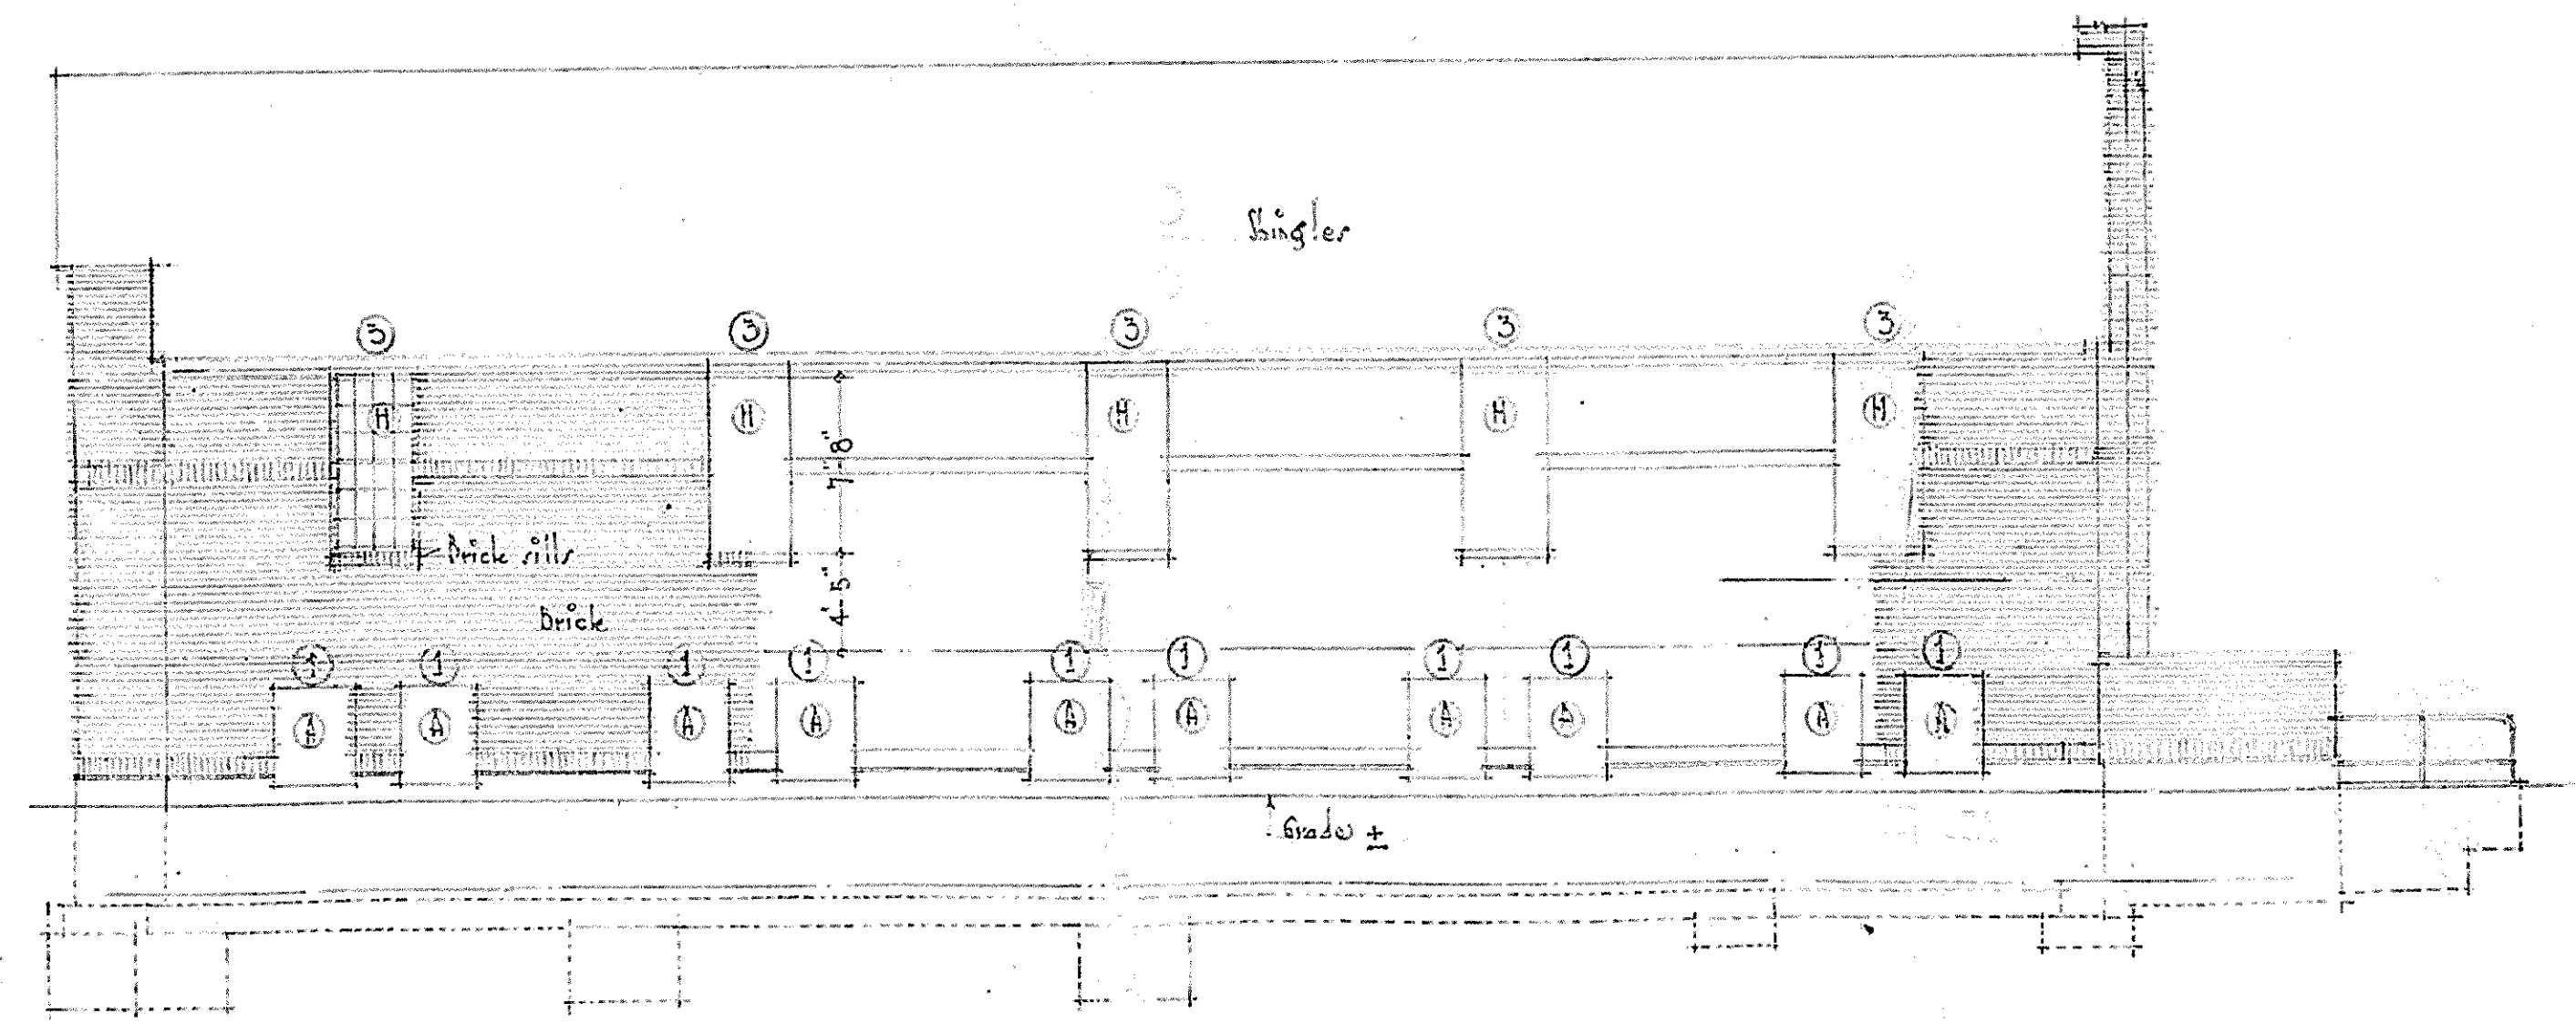

NORTH ELEVATION.

SCALE	ELEVATIONS		JOB NO.
1/8" = 1'-0"			575
DRAWN	MENAN	WARD	DATE
TERCED	L. D. S.	CHURCH	3-23-36
CHECKED	MENAN	IDAMO	FILE
	CANNON & FETZEL, ARCHTS.		REVISED
	SALT LAKE CITY, UTAH		

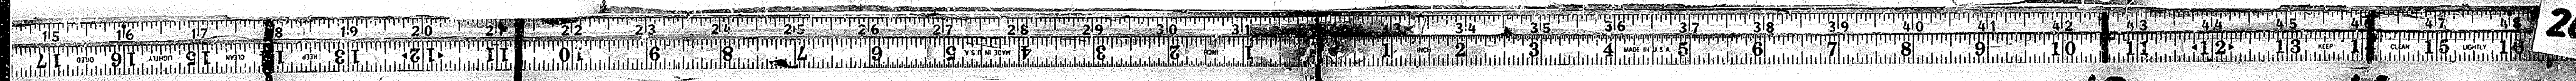


16

12


12

16

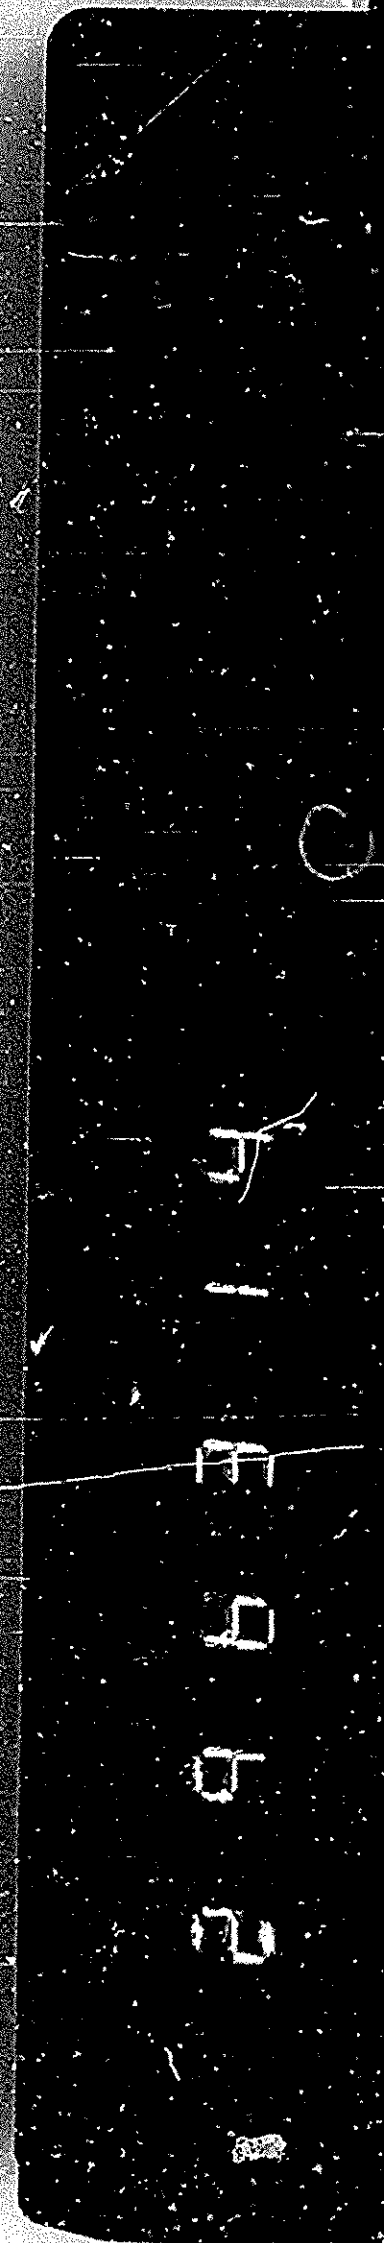


20x



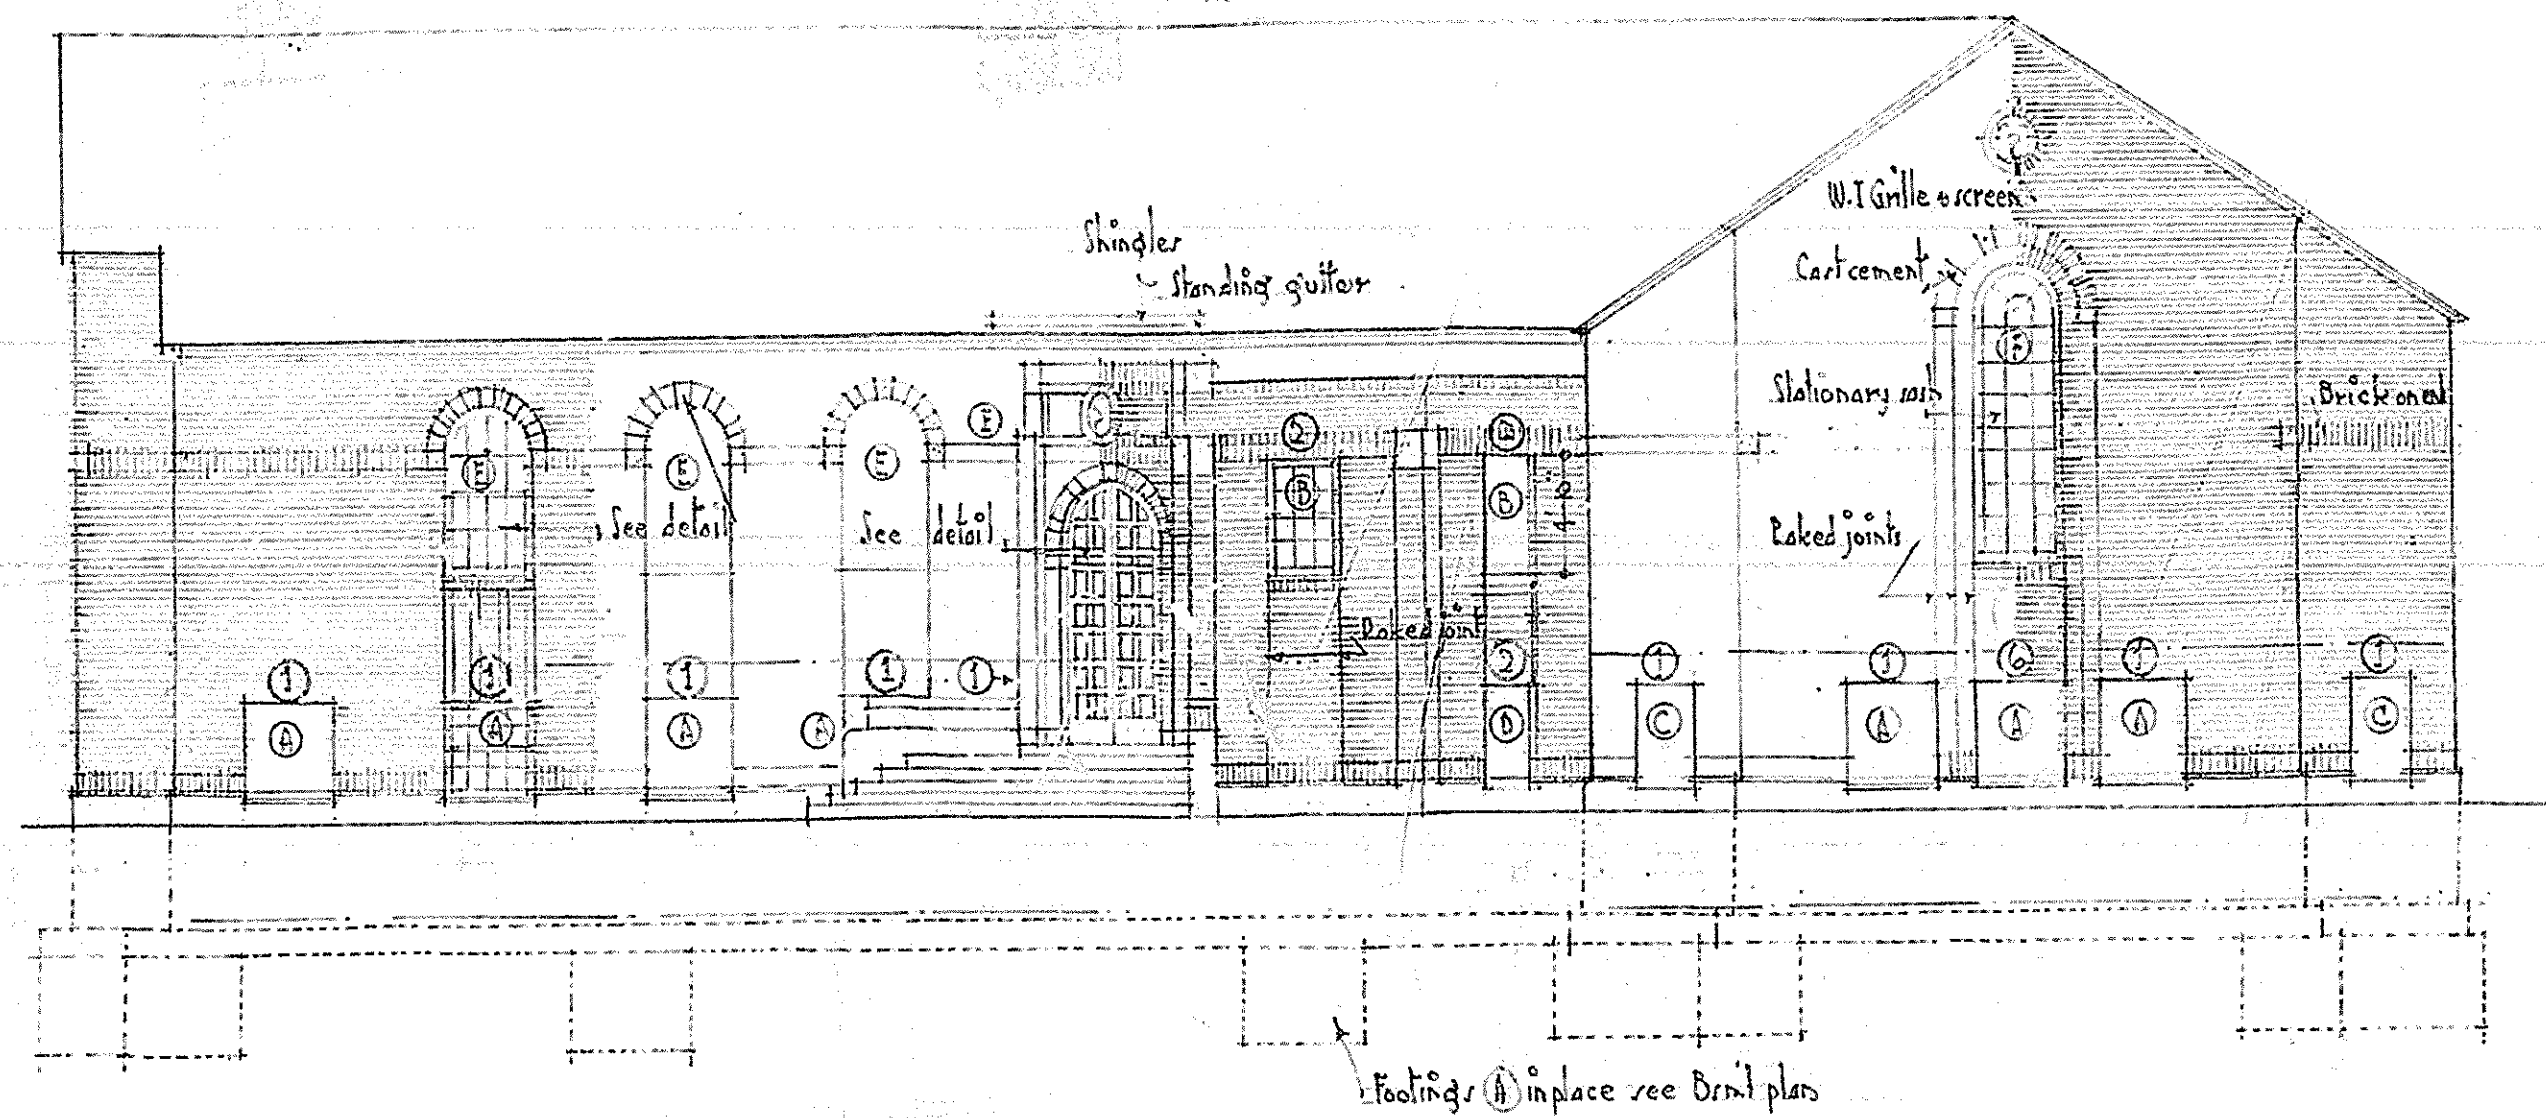

EAST ELEVATION

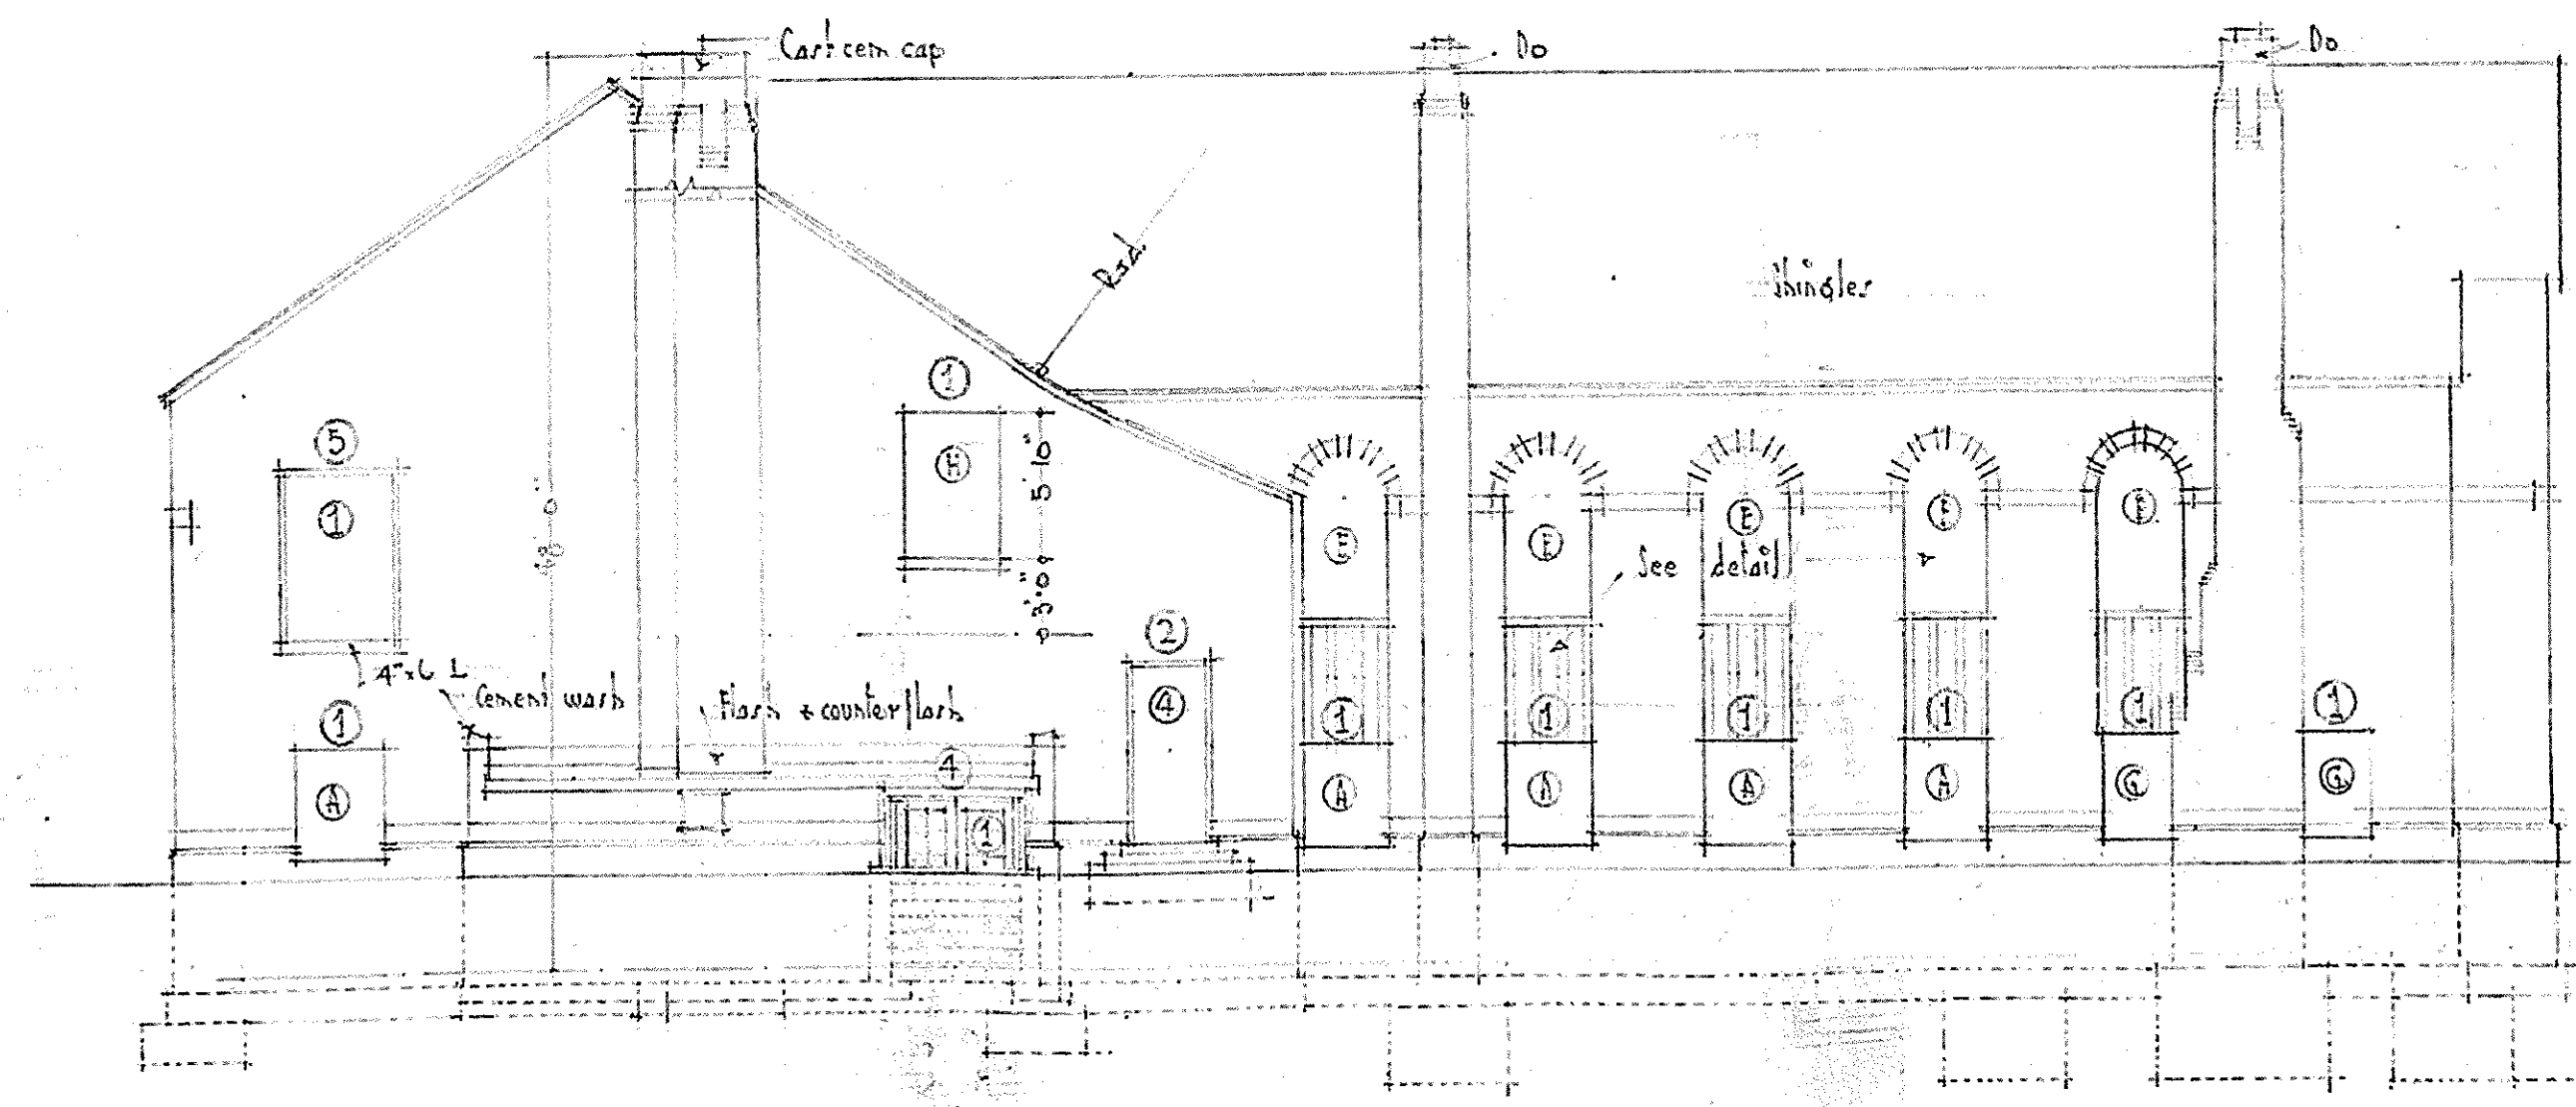


WEST ELEVATION

SCALE	ELEVATIONS		JOB NO.
1/8" = 1'-0"	MEANAN	WARD	575
DRAWN	L. D. S.	CHURCH	DATE
TRACED	MEANAN	IDaho	3-25-06
CHECKED	CANNON & FELTZER, ARCHTS.	SALT LAKE CITY, UTAH	REVISID

4

51E9B2

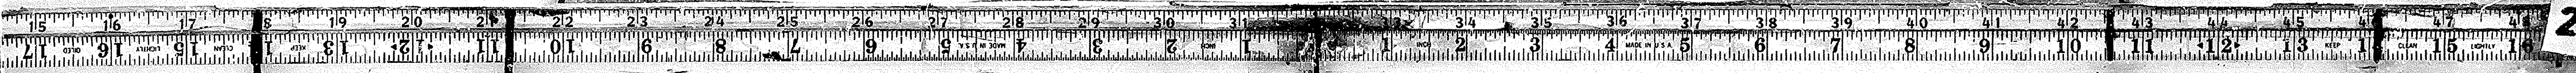

16


12

12


16

20x




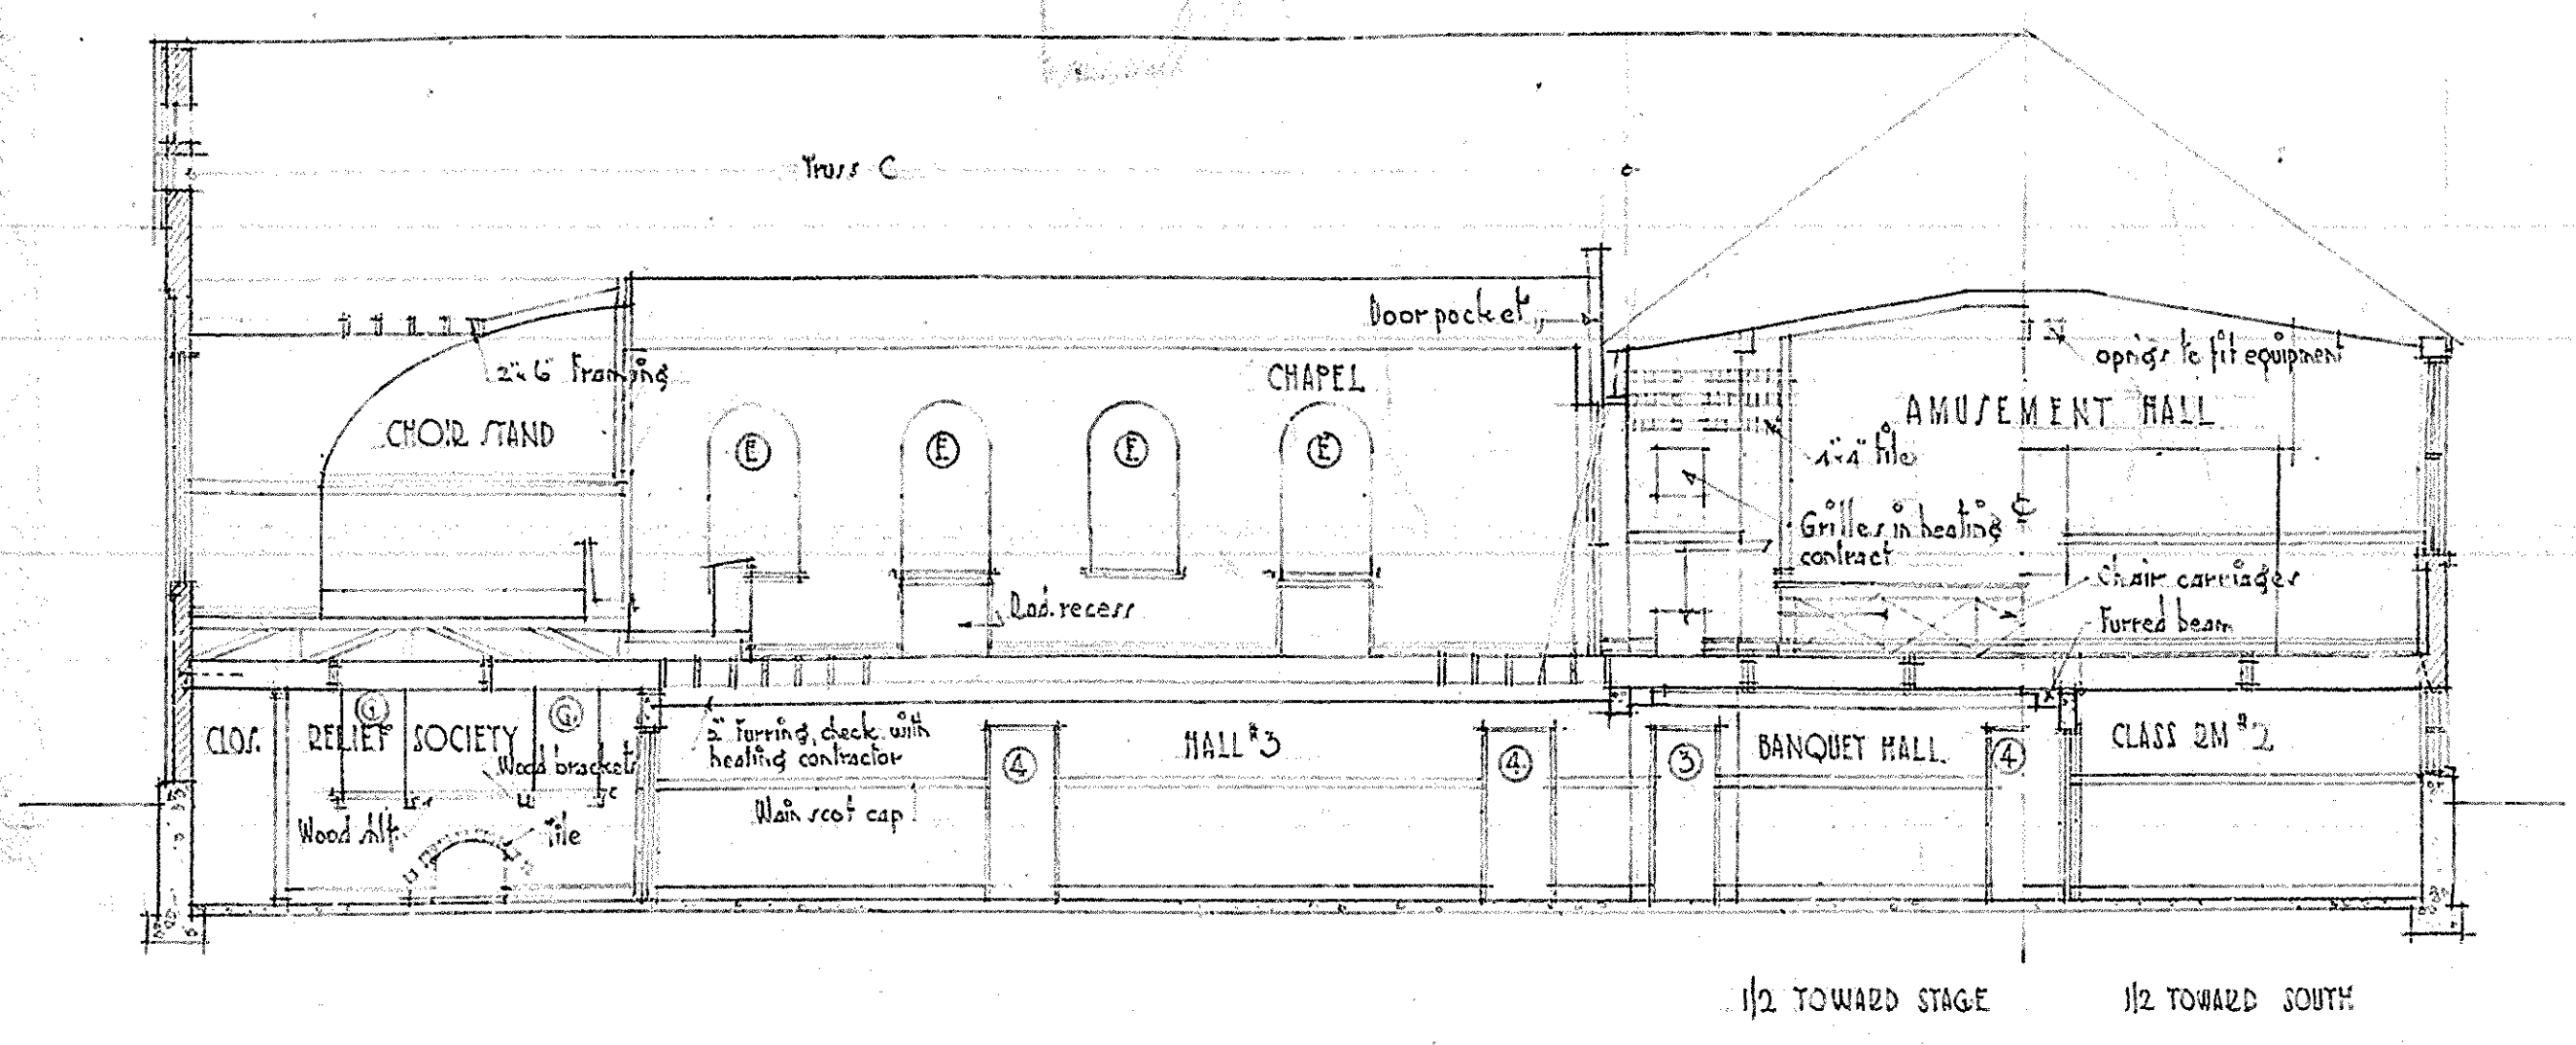


SECTION # 1

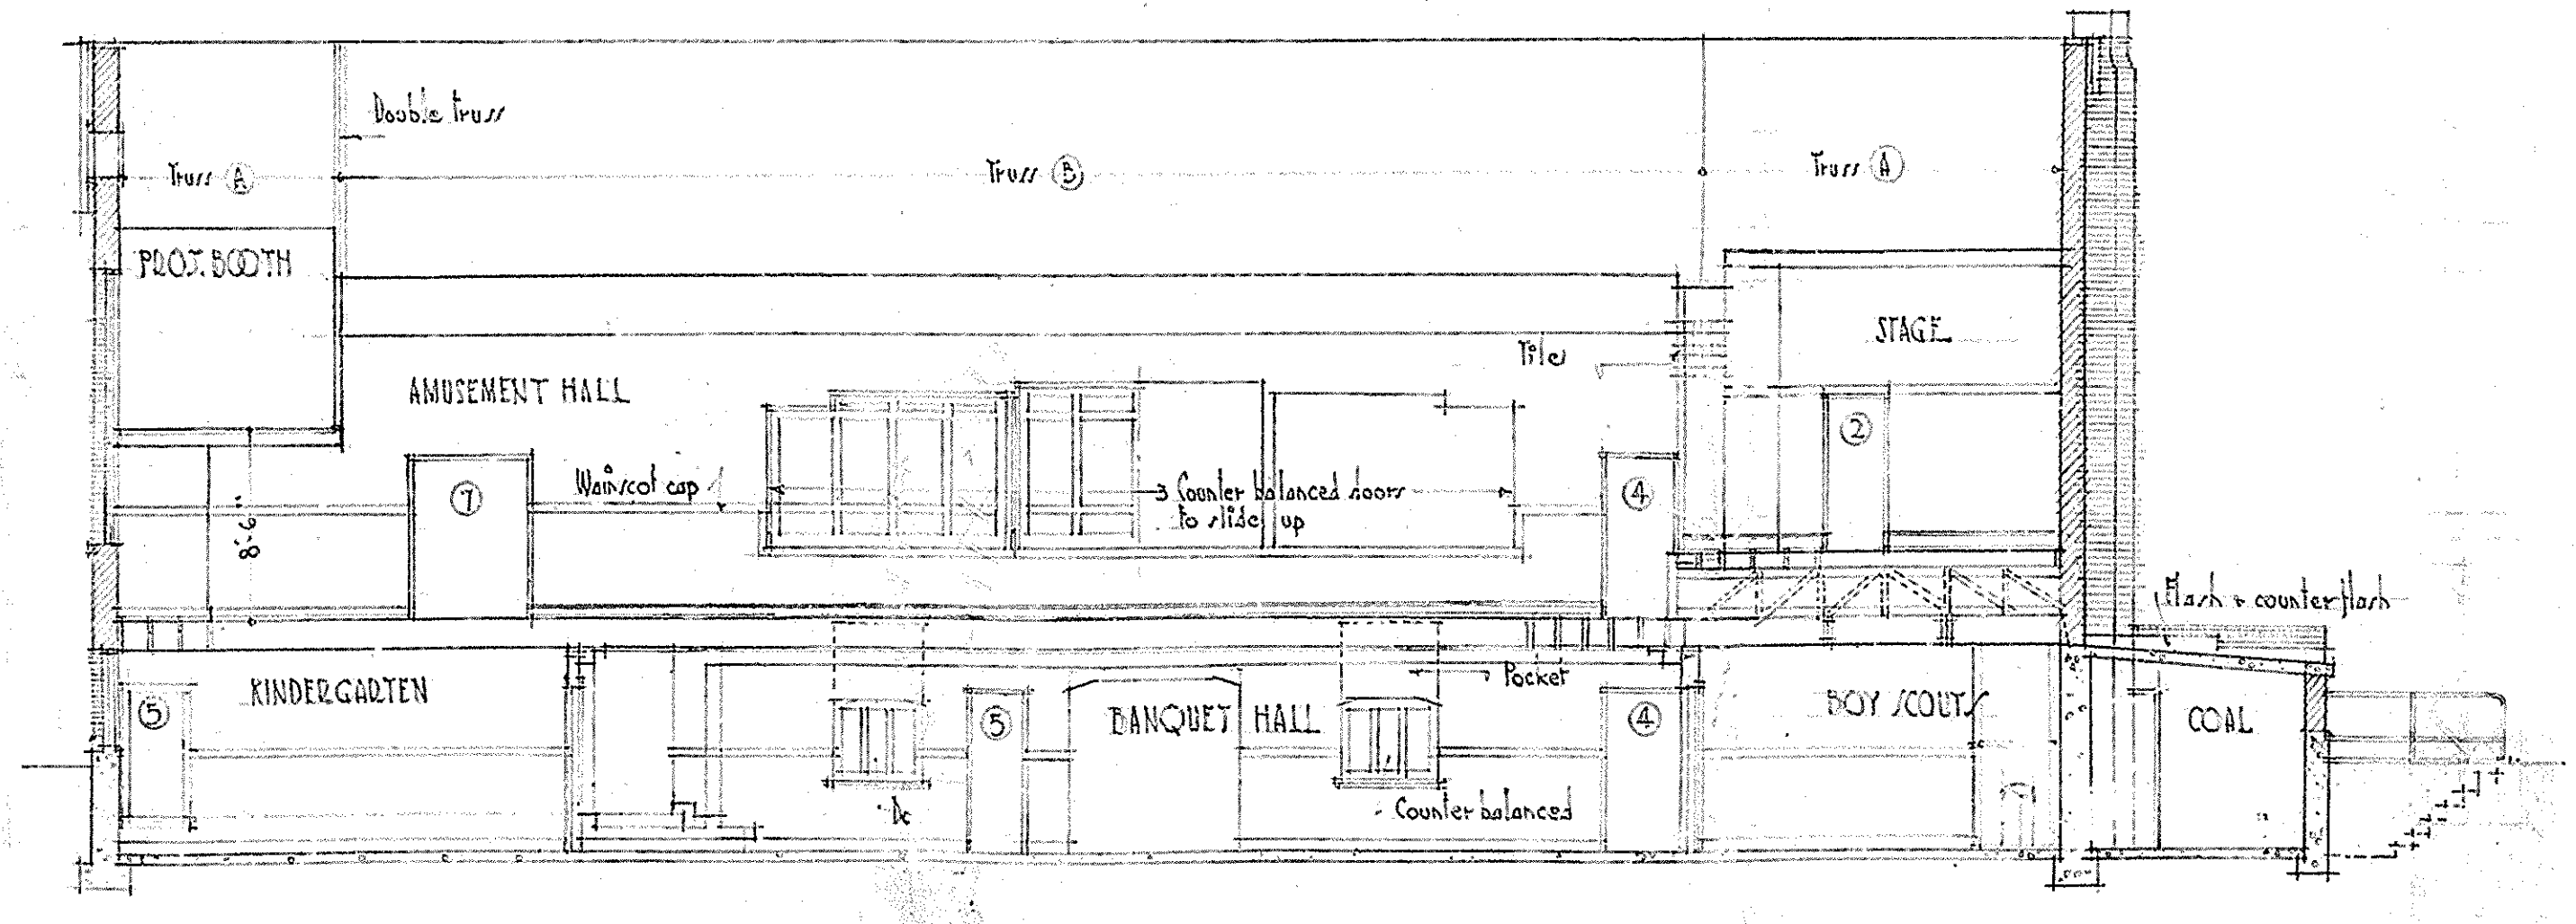

SECTION # 2

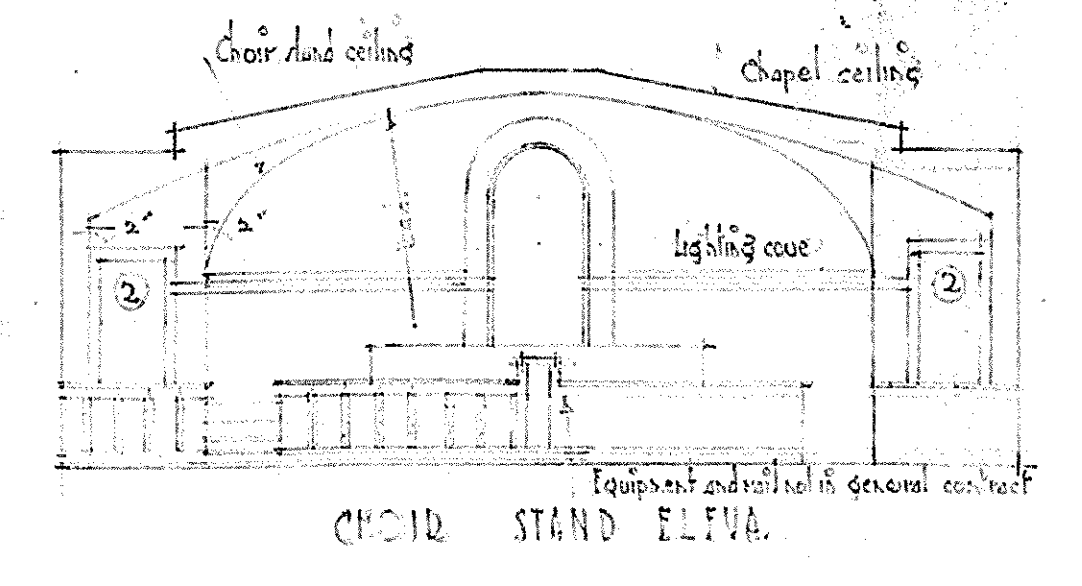

SCALE	1/8" = 1'-0"	JOB #	375
DRAWN	MENAN	DATE	3-23-36
TRACED	L. D. S. CHURCH	FILE	5
CHECKED	MENAN, IDAHO	DEV	5
	CANNON & FETZEL, ARCHTS.	DEV LISTED	
	SALT LAKE CITY, UTAH		

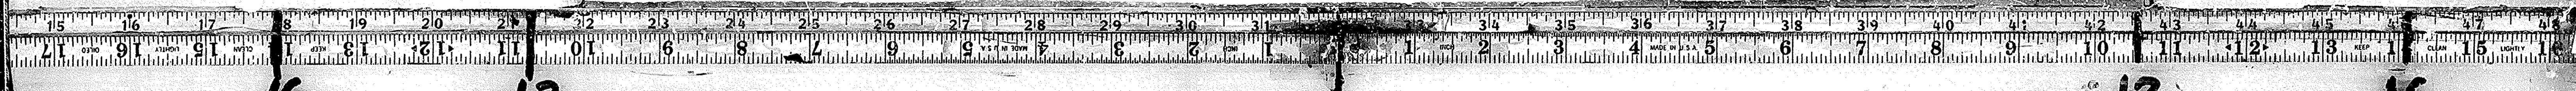

16


12

12

16

20x



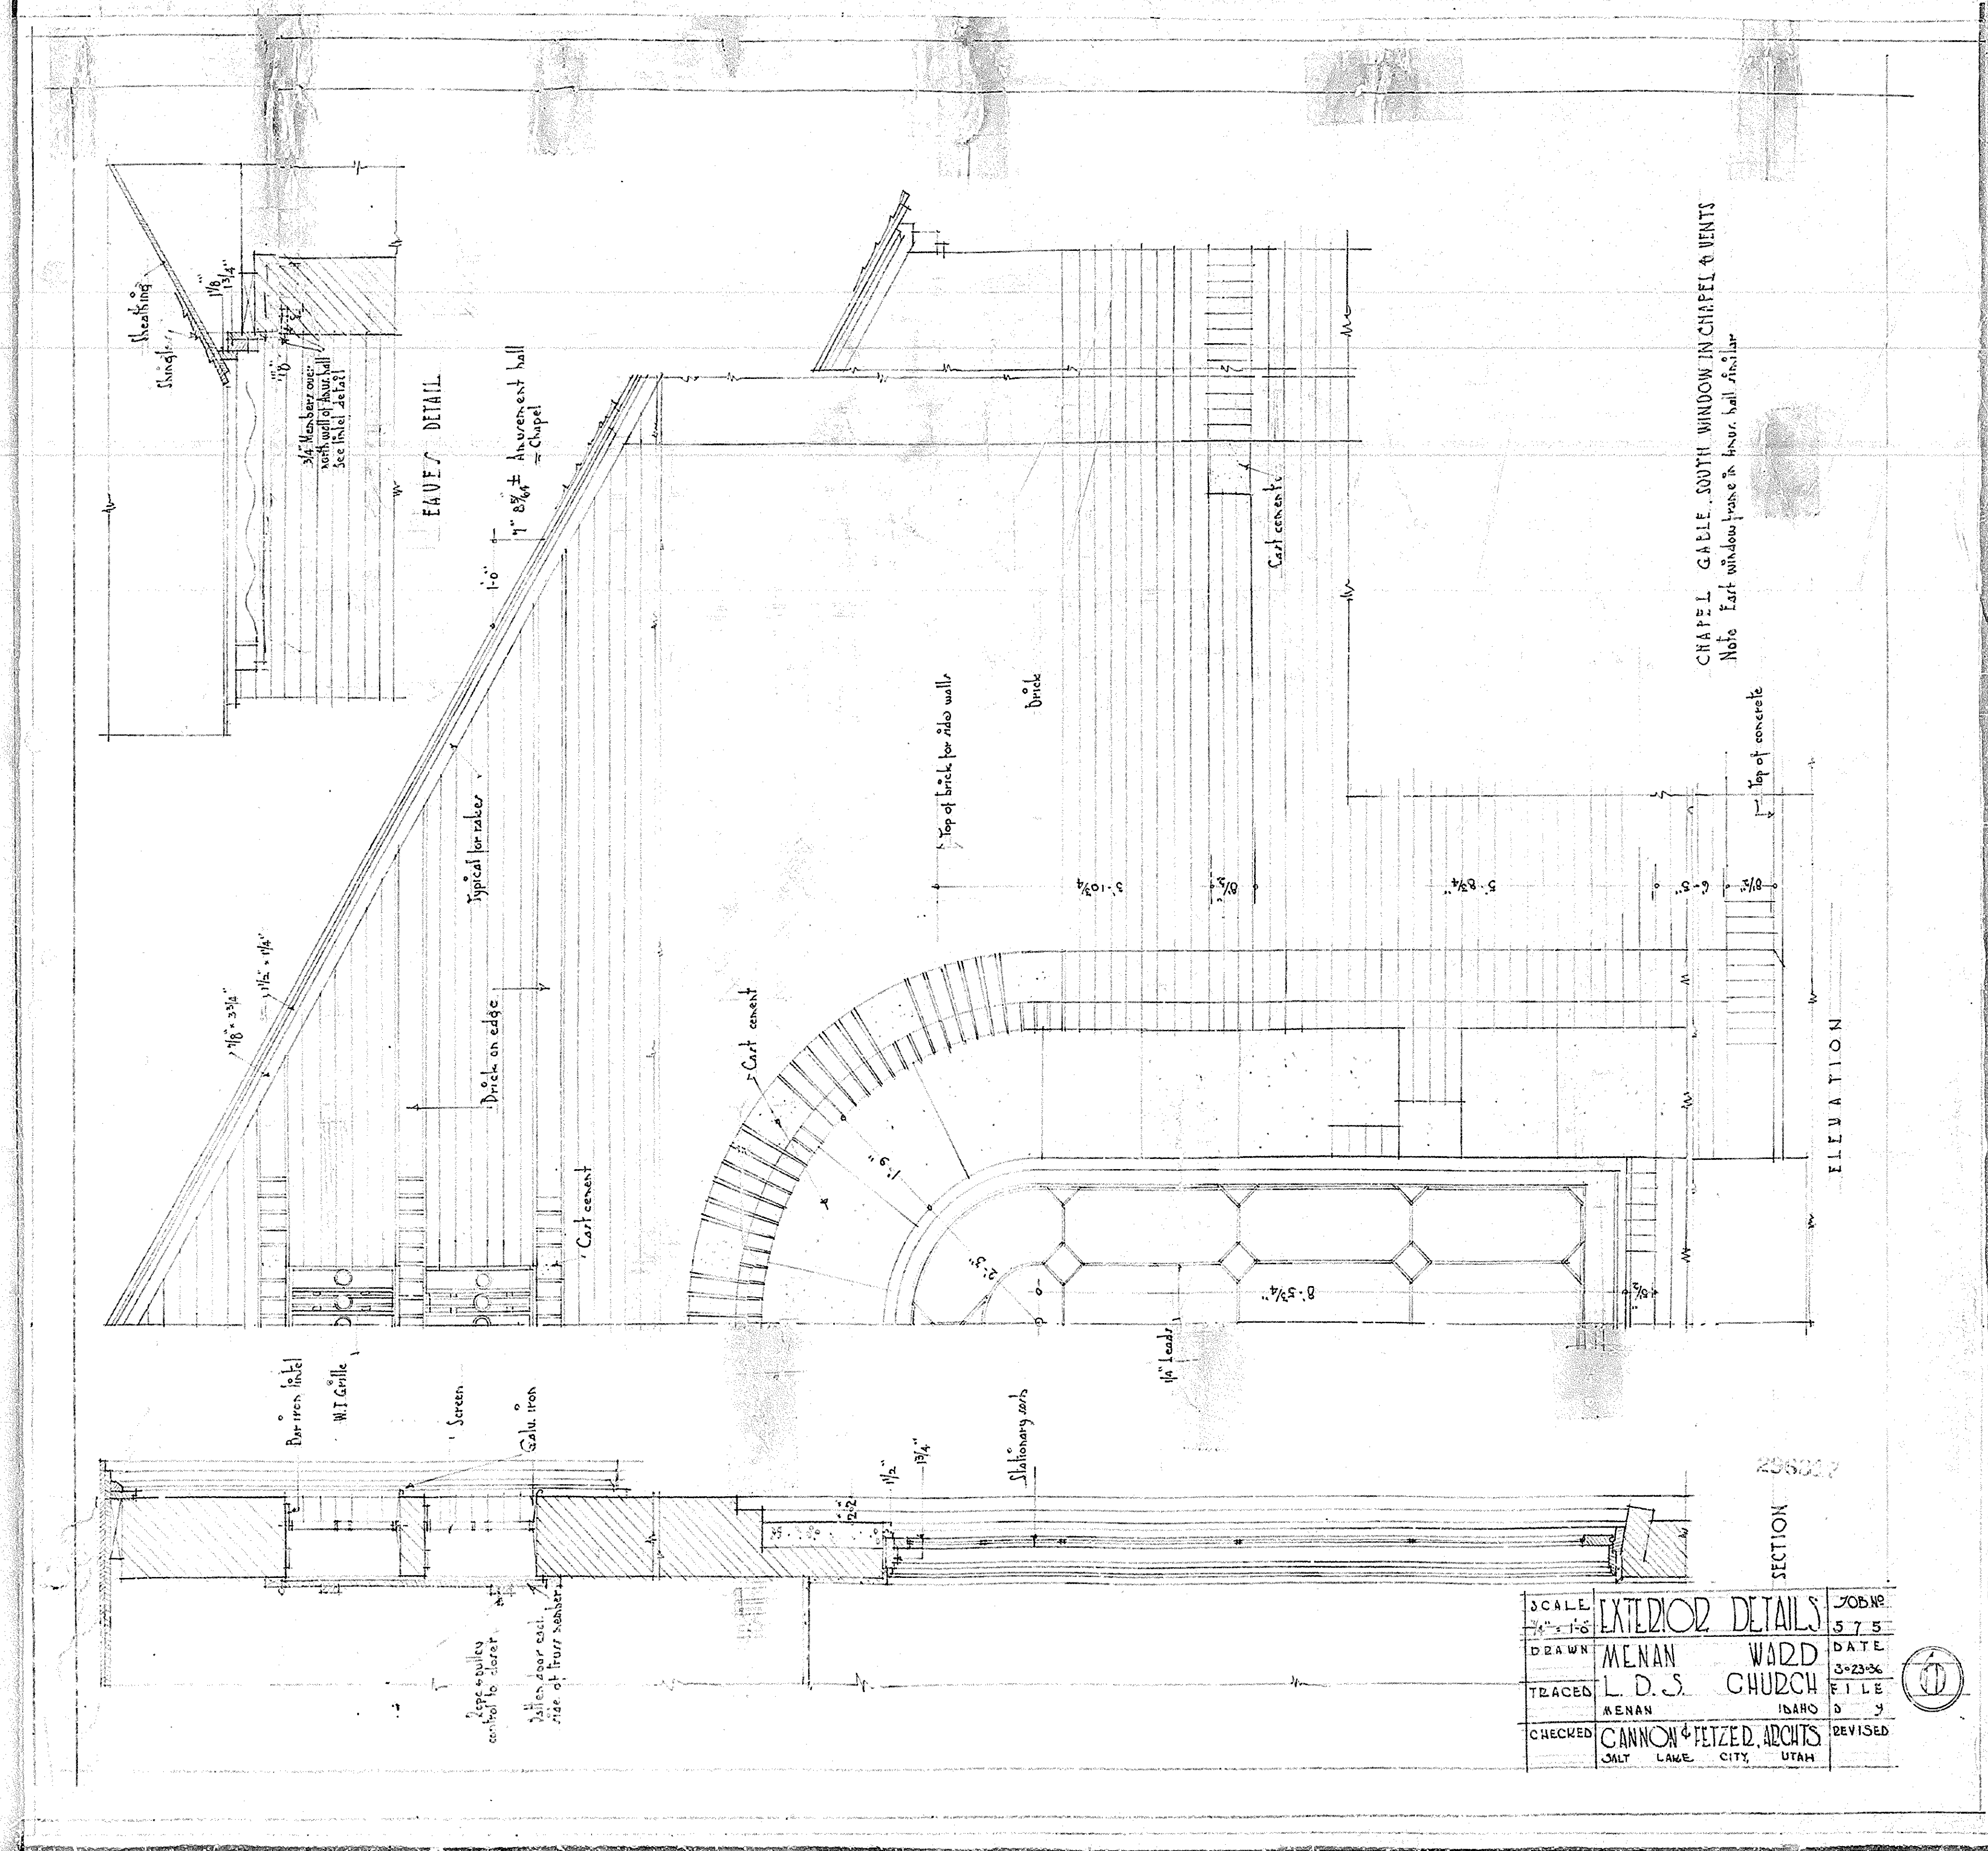


CHAPEL GABLE SOUTH WINDOW IN CHAPEL & VENTS  
 Note East window same as hour. hall similar

206007

SECTION

SCALE	EXTERIOR DETAILS	JOB NO.
1/8" = 1'-0"	MENAN WARD	575
DRAWN	L. D. S. CHURCH	DATE
TRACED	MENAN	3-23-36
CHECKED	CANNON & PETZEL ARCHTS	FILE
	SALT LAKE CITY, UTAH	REVISED

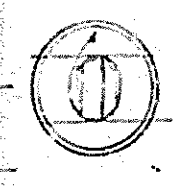

16


12

12

16

20



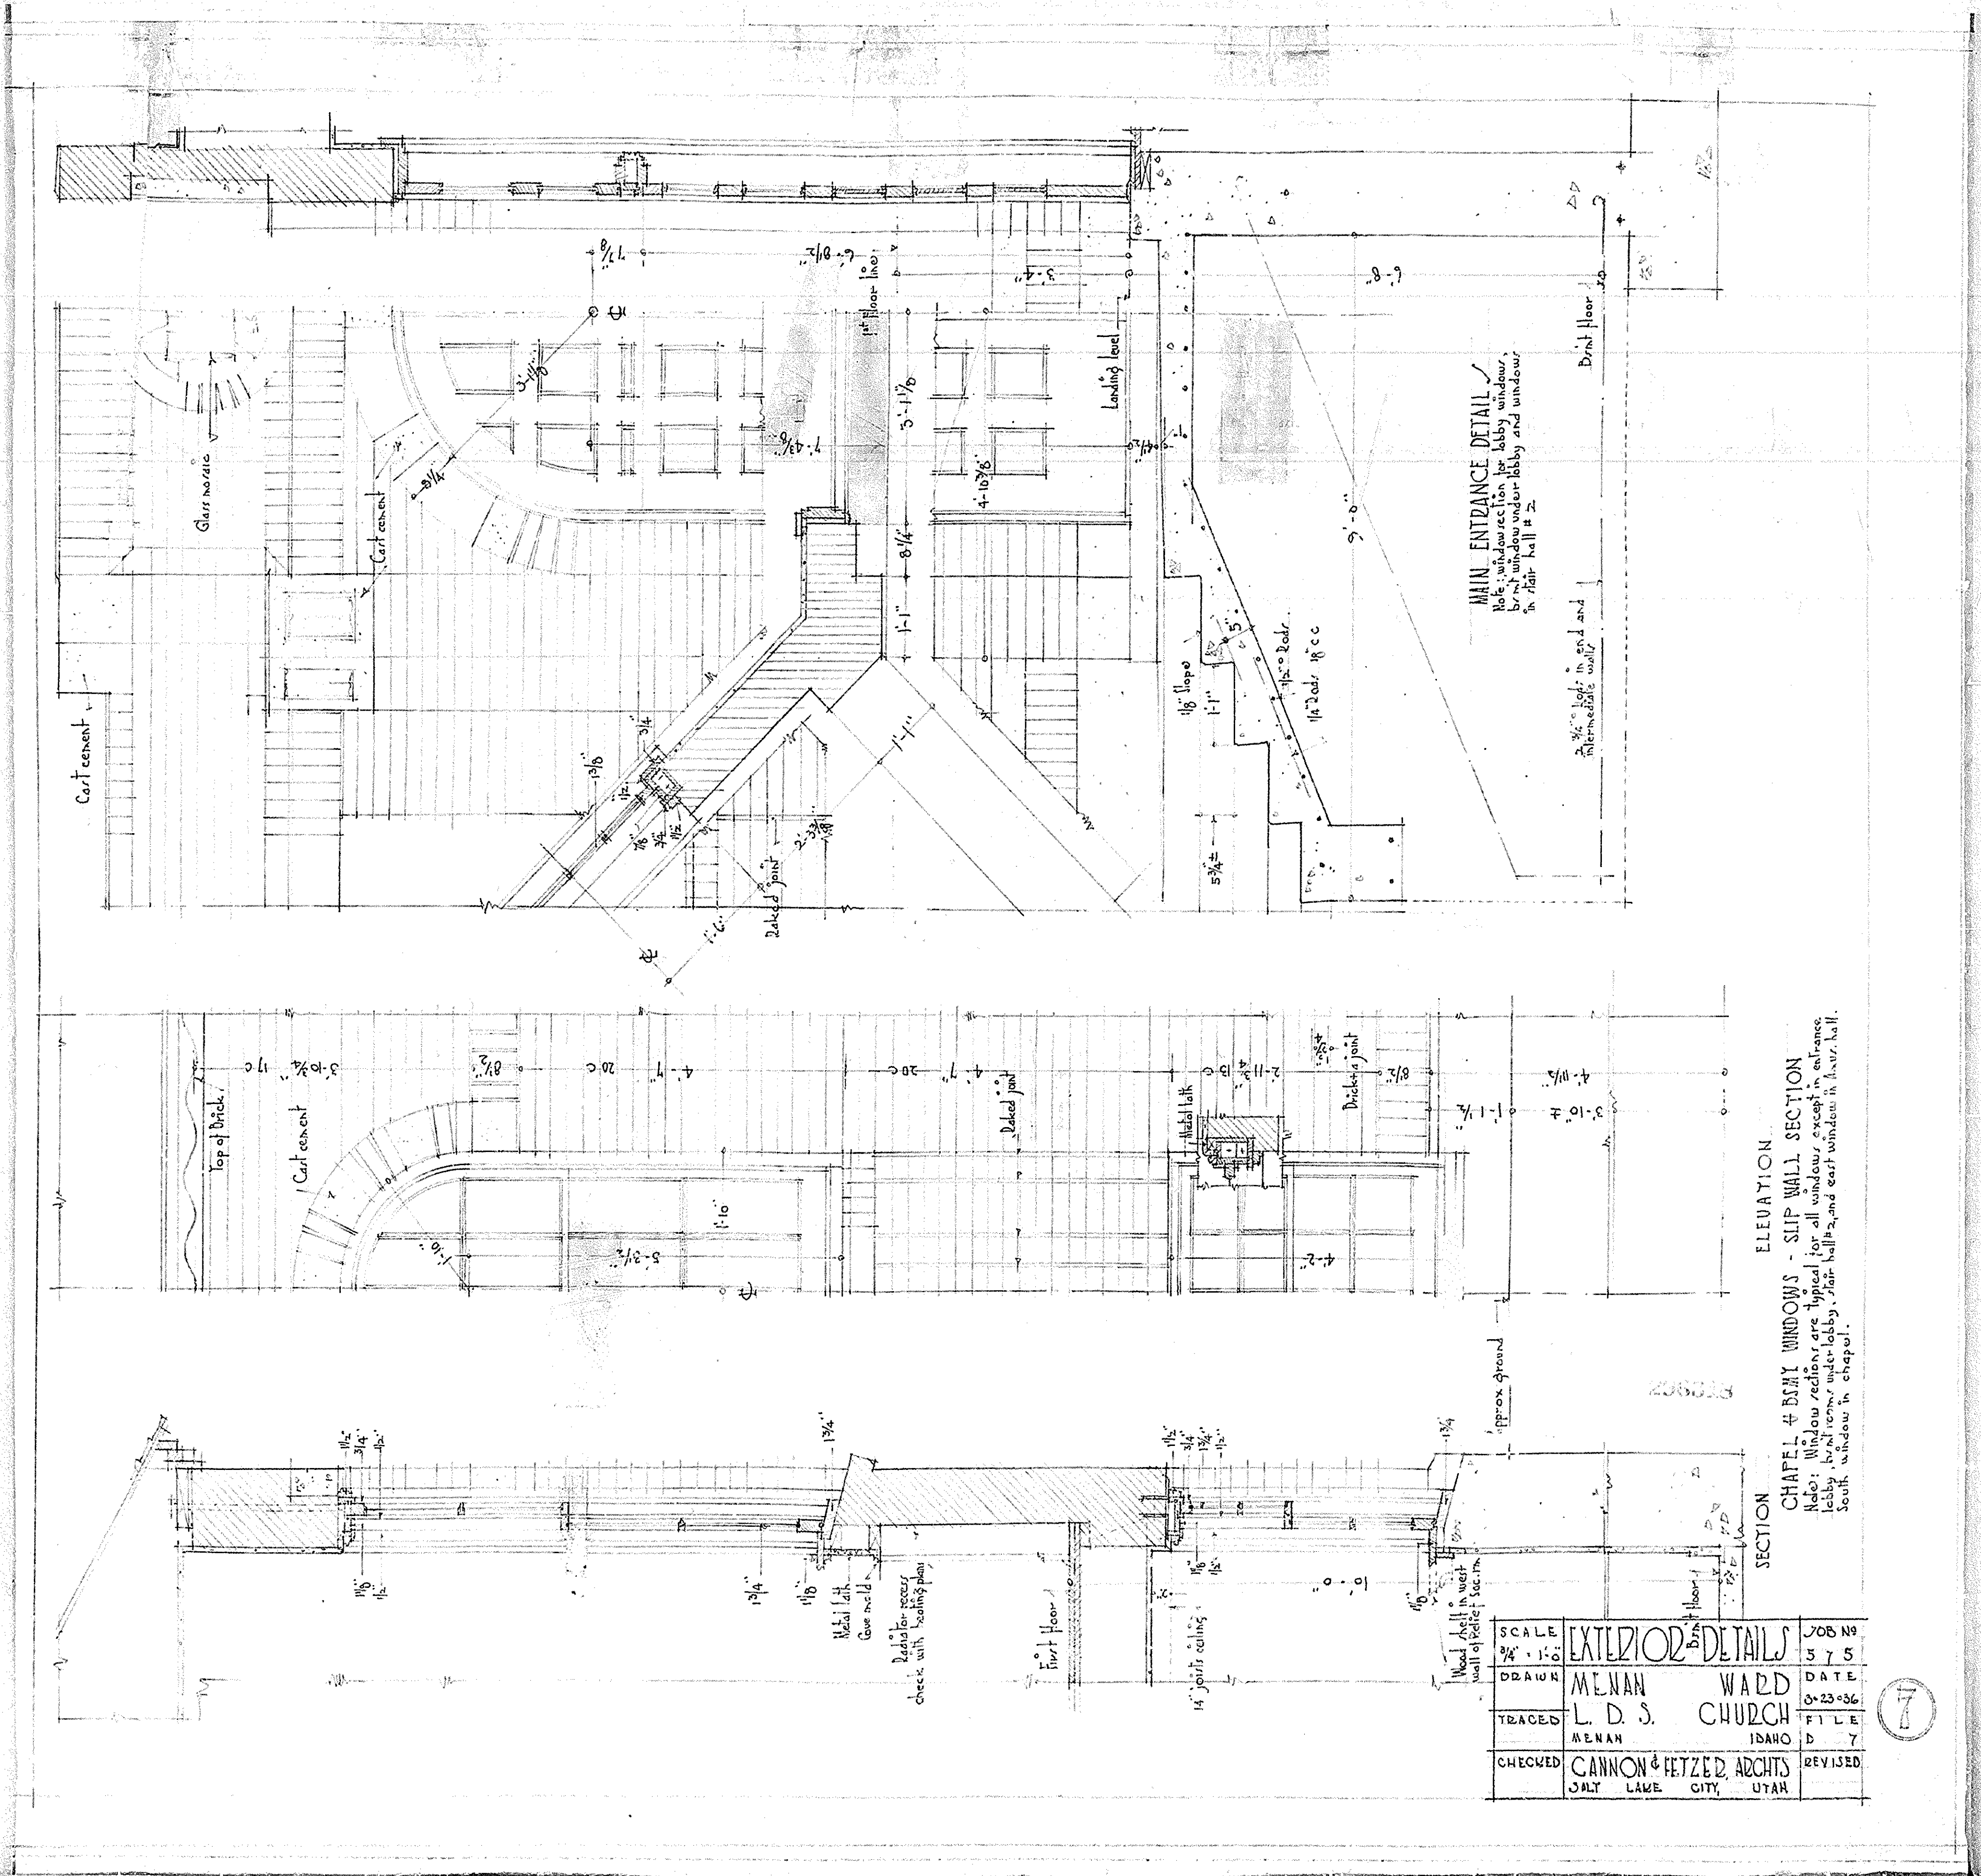

MAIN ENTRANCE DETAIL  
 Note: Window section for lobby window,  
 lobby, but room, water-lobby, stair-hall, and east window in stair hall.

ELEVATION  
 CHAPEL & BELFRY WINDOWS - SLIP WALL SECTION  
 Note: Window section are typical for all windows except in entrance,  
 lobby, but room, water-lobby, stair-hall, and east window in stair hall.  
 South window in chapel.

SCALE	3/8" = 1'-0"	JOB NO.	575
DATE		DATE	6-23-36
TRACED	MENAN	FILE	D 7
CHECKED	CANNON & FETZEL, ARCHTS.	REVISED	
	SALT LAKE CITY, UTAH		

7



16

12


12

16

296318

20x




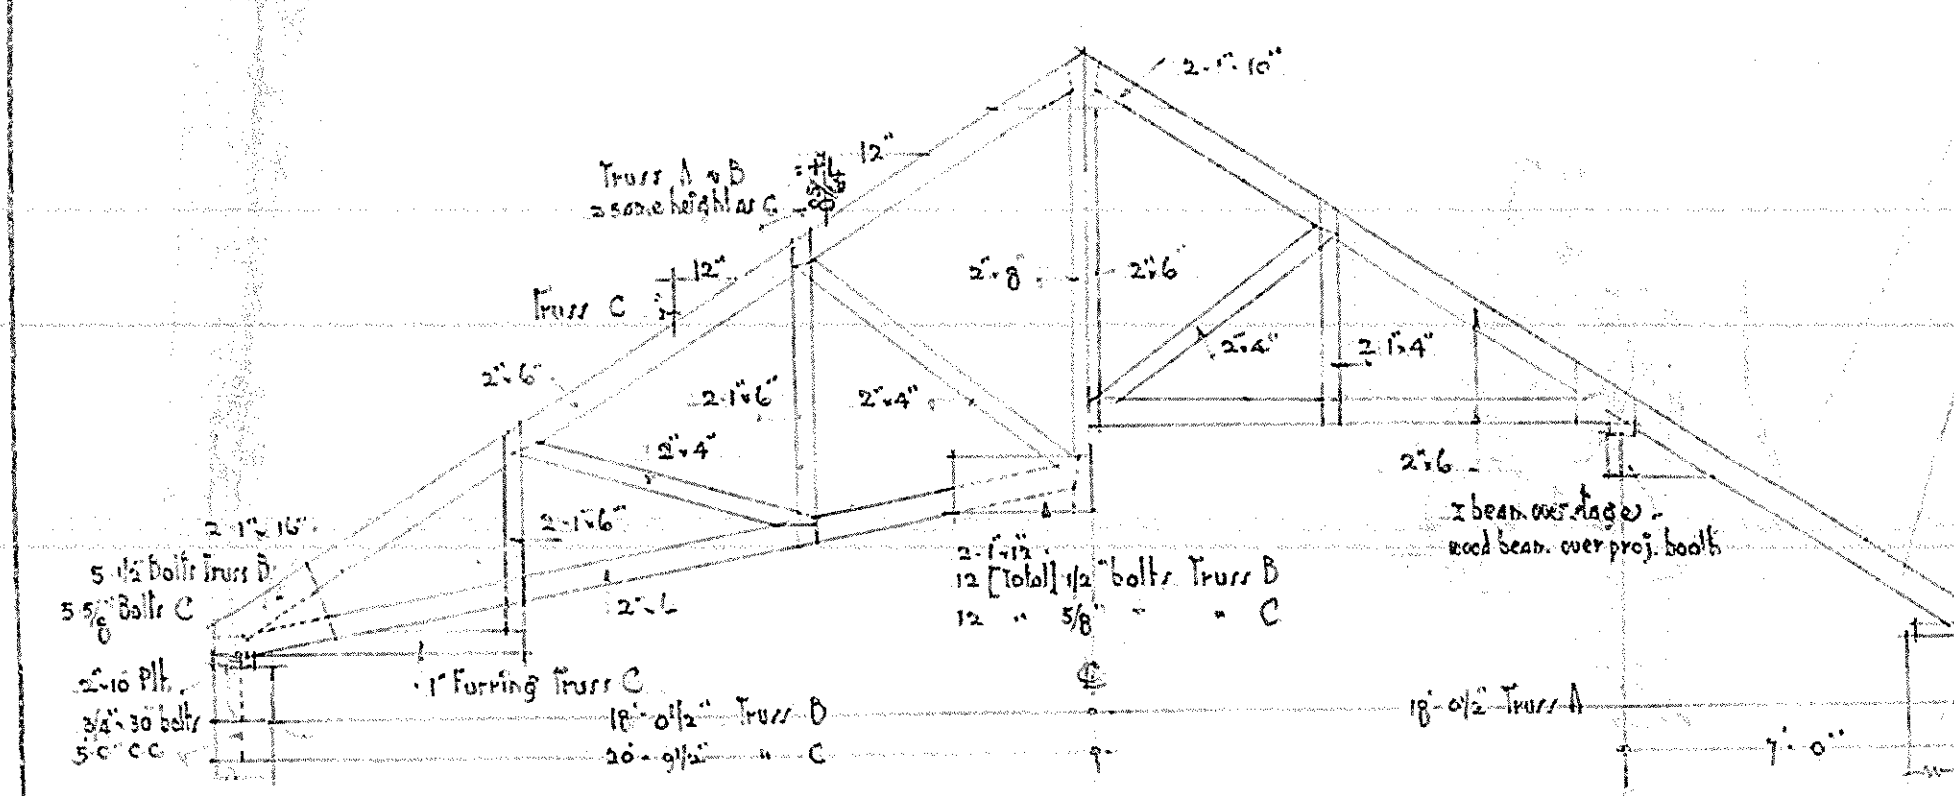



1/2 TRUSS B+C  
 1/4" = 1'-0"  
 1/2 TRUSS A

NOTES: - ALL TRUSSES  
 All joints to be well spaced  
 Spacing 2'-0" c-c  
 Strip with 1/2" forming 16" c-c


WOOD WINDOW SCHEDULE 1/2" x 1'-0"

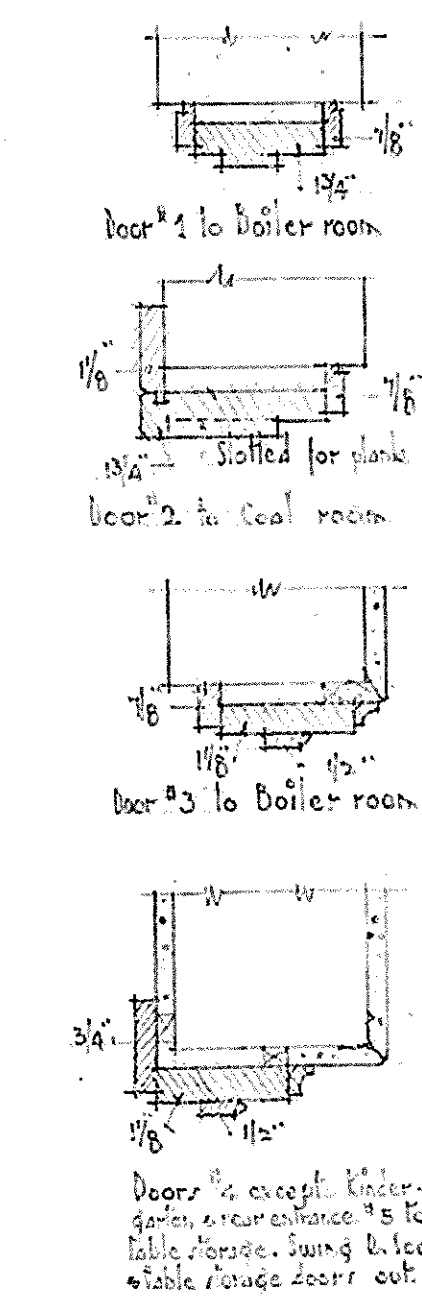

Doors 1 & 2 to boiler room  
 Door 3 to coal room  
 Door 4 to boiler room  
 Door 5 to boiler room  
 Door 6 to boiler room  
 Door 7 to boiler room  
 Door 8 to boiler room  
 Door 9 to boiler room  
 Door 10 to boiler room  
 Door 11 to boiler room  
 Door 12 to boiler room  
 Door 13 to boiler room  
 Door 14 to boiler room  
 Door 15 to boiler room  
 Door 16 to boiler room

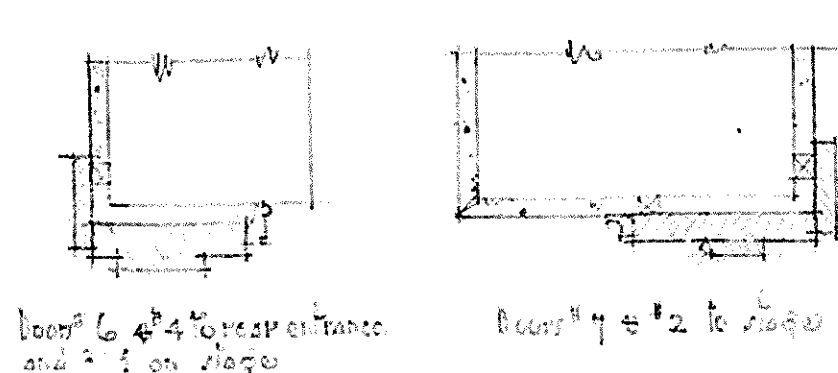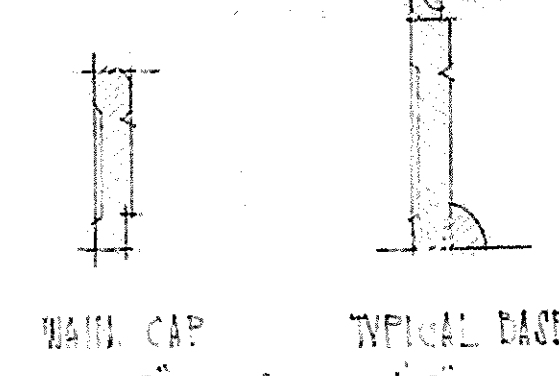


NO	FLOOR	BASE	WALL	CEILING	WAIN/COT	WAIN. CAP	WOOD TRIM
1	Cement	---	---	---	---	---	---
2	---	---	---	Cement plaster	---	---	---
3	---	Cement	Hardwall plaster	Hardwall plaster	Keener cen. plaster	Wood	V.G. Fir
4	---	---	---	---	---	---	---
5	---	---	Cement plaster	Cement plaster	---	---	---
6	---	---	Hardwall plaster	Hardwall plaster	Textured plaster	Wood	V.G. Fir
7	---	---	---	---	Keener cen. plaster	---	---
8	---	---	Cement plaster	Cement plaster	---	---	---
9	Maple	V.G. Fir	Hardwall plaster	Hardwall plaster	Cement plaster	Wood	V.G. Fir
10	---	---	---	---	Keener cen. plaster	---	---
11	V.G. Fir	---	Textured plaster	---	---	---	---
12	Oak	Oak	Hardwall plaster	Hardwall plaster	Textured plaster	Wood	Oak
13	Maple	V.G. Fir	---	---	Keener cen. plaster	---	V.G. Fir
14	---	---	---	---	Textured plaster	---	---
15	V.G. Fir	---	---	---	---	---	---
16	Cement	---	Cement plaster	Cement plaster	---	---	---

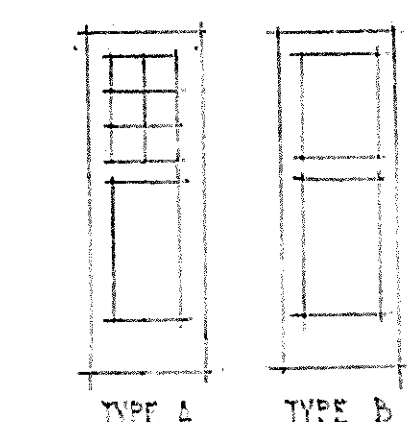

NO	TYPE	SIZE	NOTE
1	A	2'-4" x 6'-8" x 1 3/4"	All exterior doors solid
2	B	2'-10" x 6'-8" x 1 3/4"	Door in coal room to have rolled ironwork on inside leaves
3	B	2'-10" x 6'-8" x 1 3/4"	Not covered by sign on boiler room side
4	A	2'-8" x 6'-8" x 1 3/4"	All double doors to have casing
5	B	2'-6" x 6'-8" x 1 3/4"	See entrance detail
6	C	2'-10" x 6'-8" x 1 3/4"	See entrance detail
7	C	2'-8" x 6'-8" x 1 3/4"	See entrance detail

LINTEL SCHEDULE

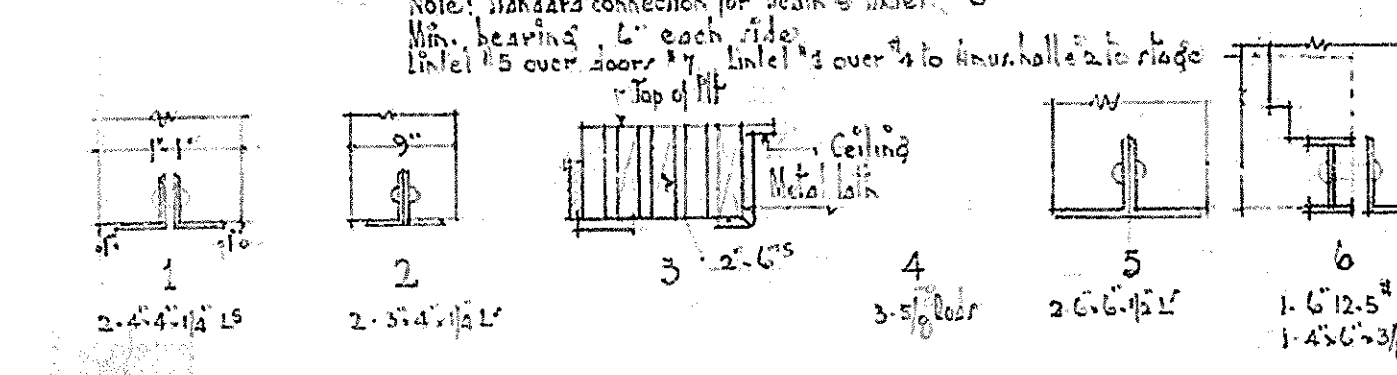

WINDOW SCHEDULE

Note: Windows with size symbol are same size as type - see detail  
 Waincot cap to form window apron in vestibules


GLASS SCHEDULE

Opalescent glass: Chapel, library office, library, vestibule & East window in Amusement Hall.  
 Figured glass: All doors & windows except where opalescent glass is specified.

SCALE	SCHEDULES & DETAILS	JOB NO.	875
DESIGN	MENAN WADD	DATE	3/25/25
TRACED	L. D. S. CHURCH	FILE	16
CHECKED	MENAN	15410	3
	CANNON & FETTER, ARCHTS.	REVISED	
	3217 LAURE CITY UTAH		

296319



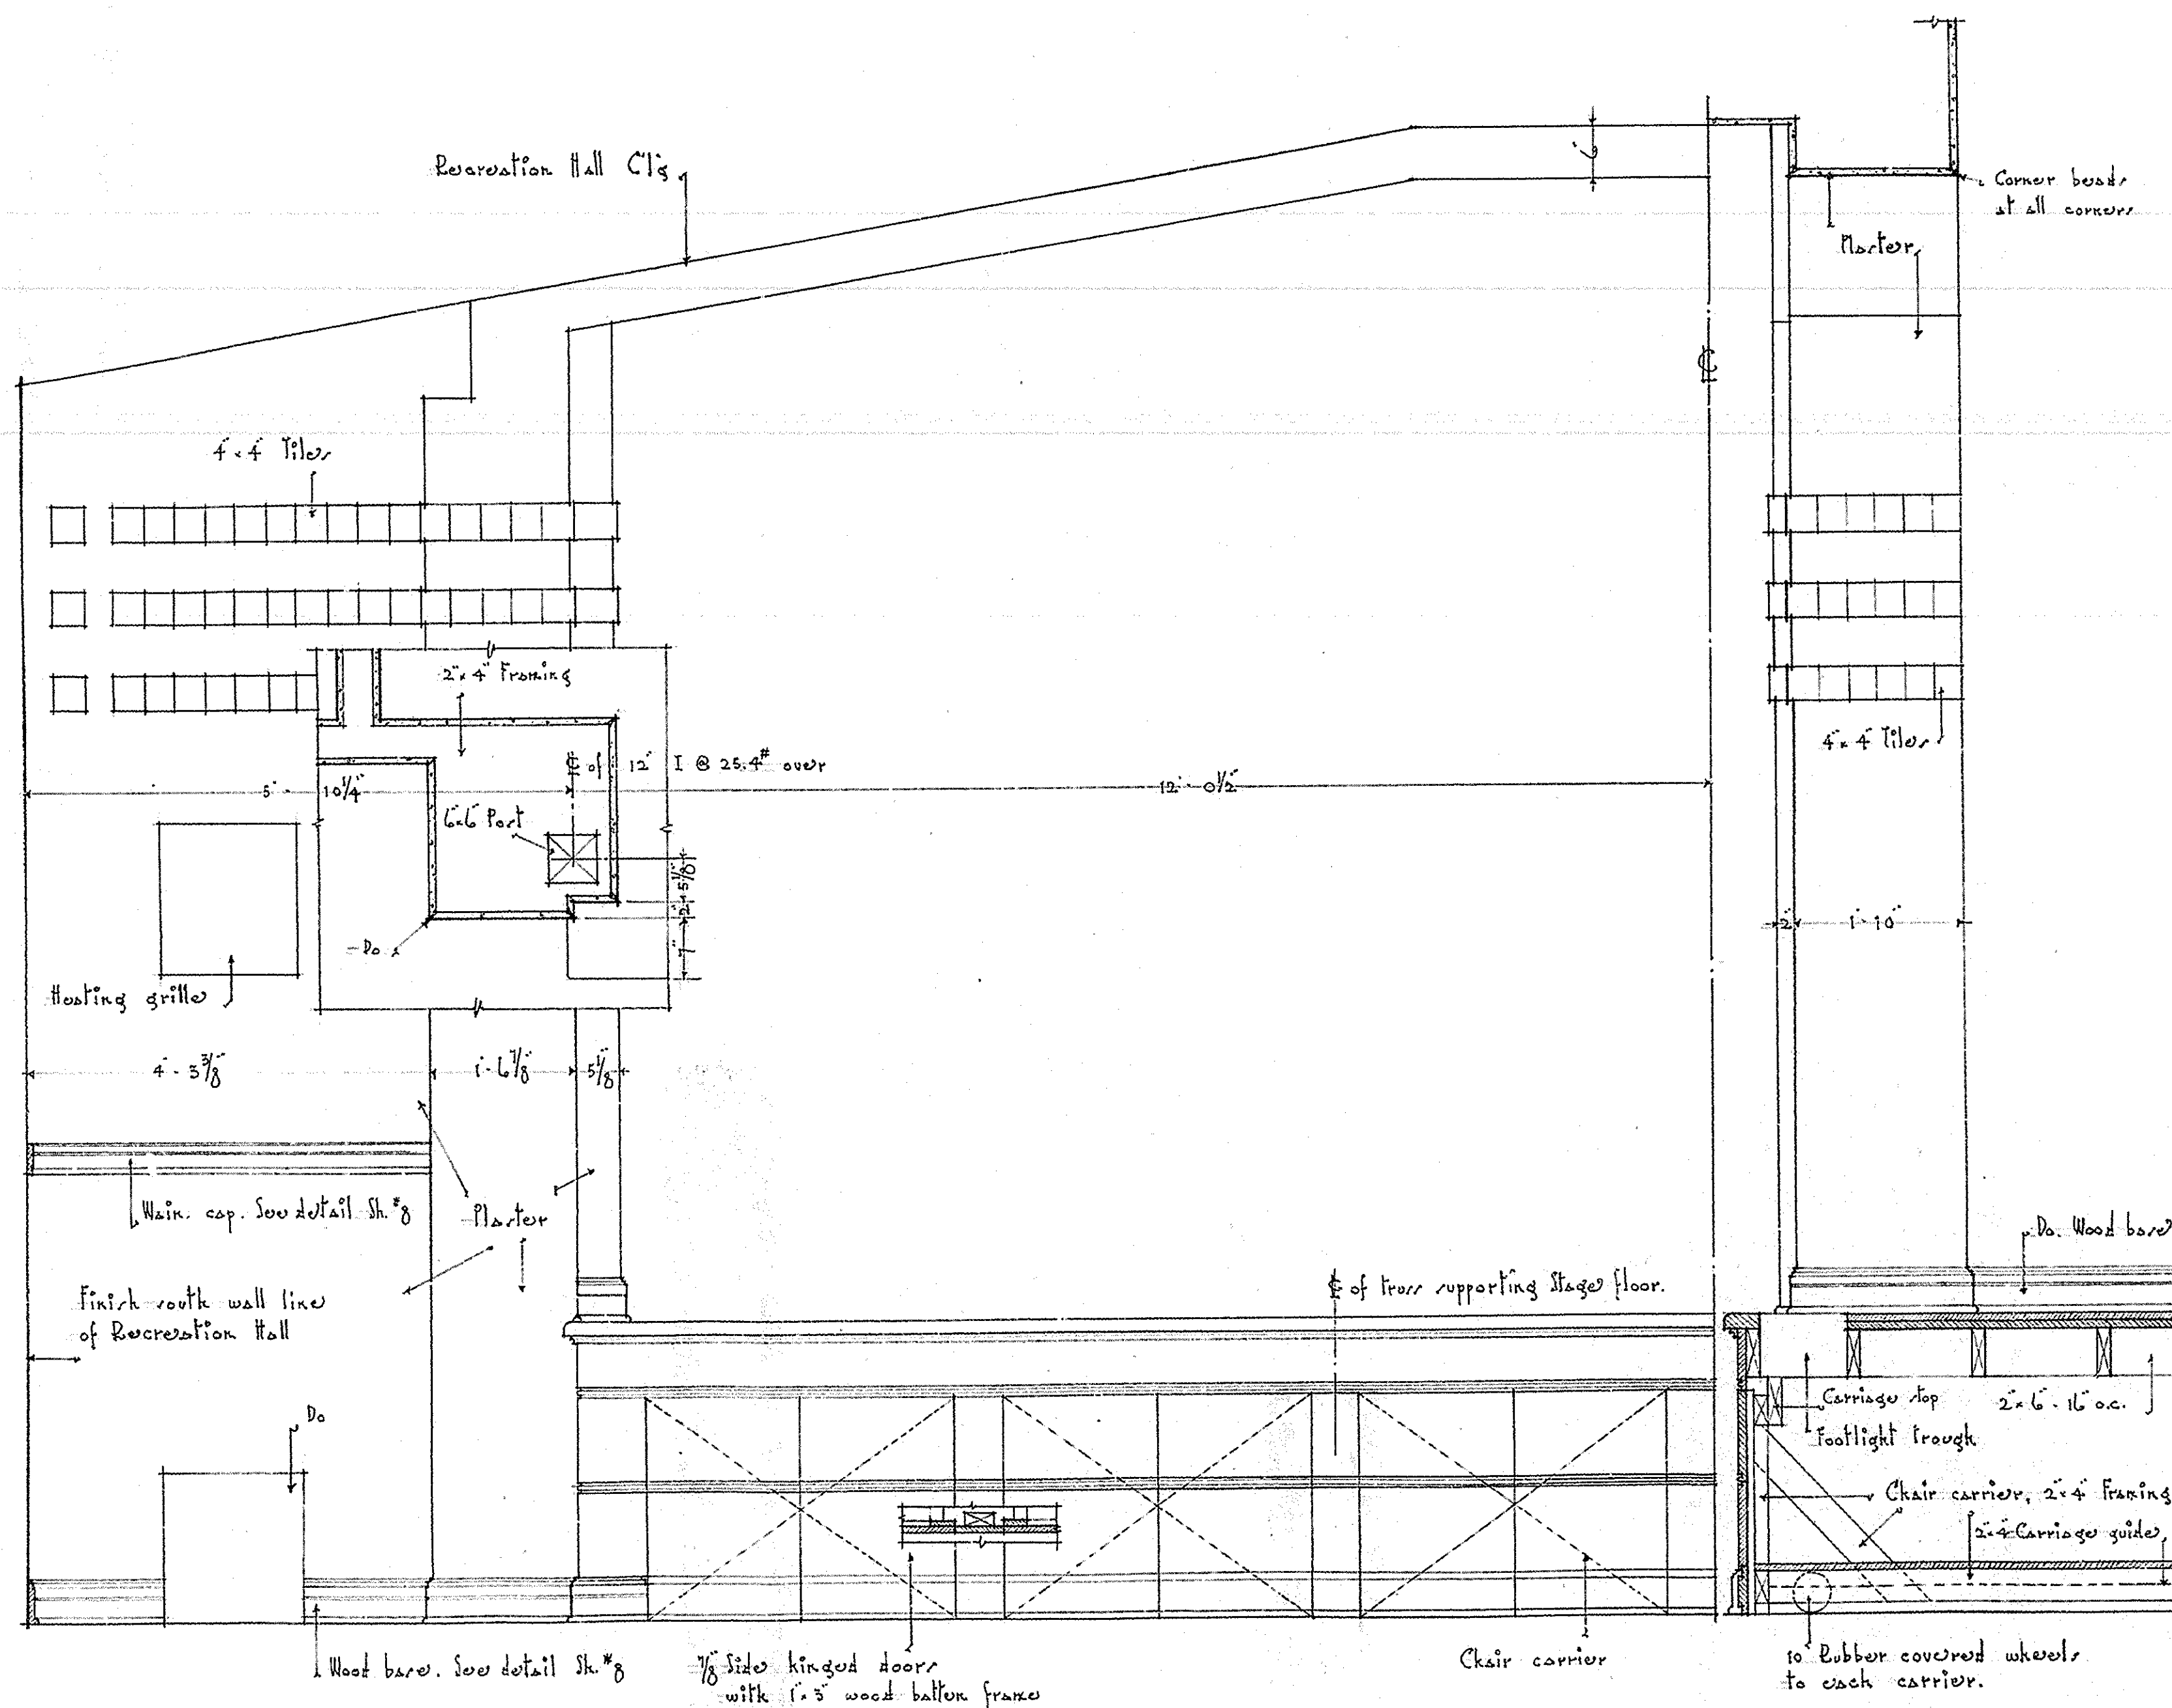


1/2 ELEVATION  
3/4 1'-0"

SECTION  
3/4 1'-0"

NOTE: Contractor shall verify all dimensions at site.  
Contractor shall check present construction and notify architect of any changes.

SCALE	PROSCENIUM ARCH	JOB NO
3/4" = 1'-0"	MENAN WARD	575
DRAWN	L. D. S. CHURCH	DATE
W. F. H.	IDAHO	7-21-39
TRACED		FILE
R. F. H.		D 9
CHECKED	CANNON-FETZER ARCHTS	REVISED
J. L. H.	SALT LAKE CITY, UTAH	

9

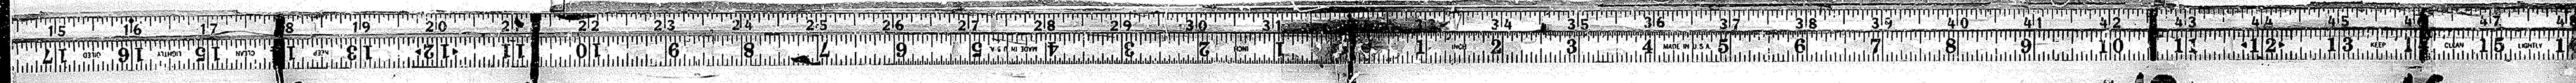


16

12


12

16




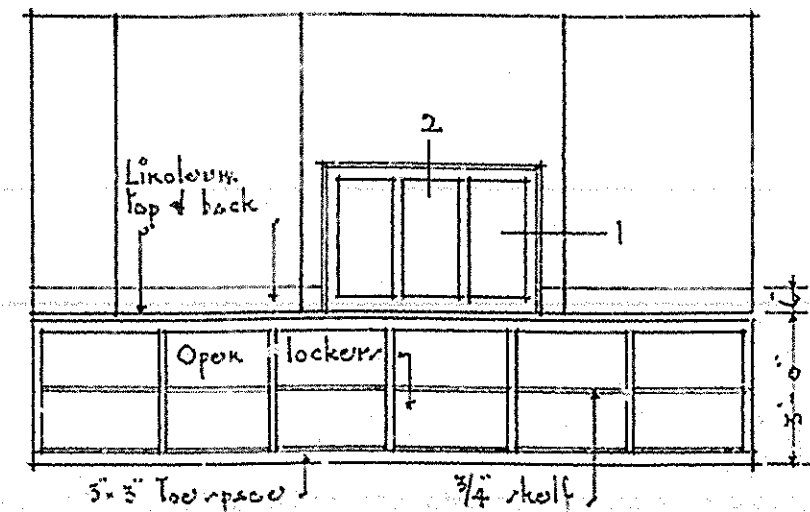


- NORTH ELEVATION -  
1.0  
1.0

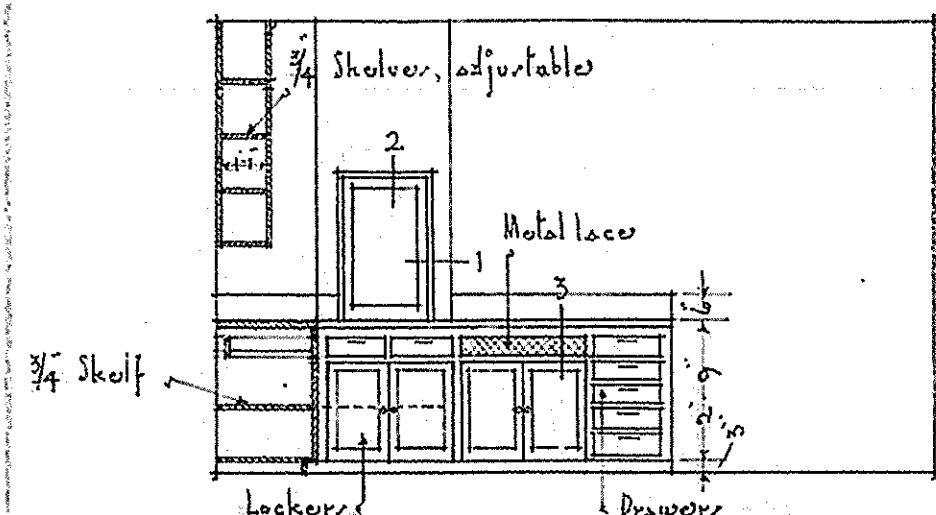


- SOUTH ELEVATION -  
1.0  
1.0

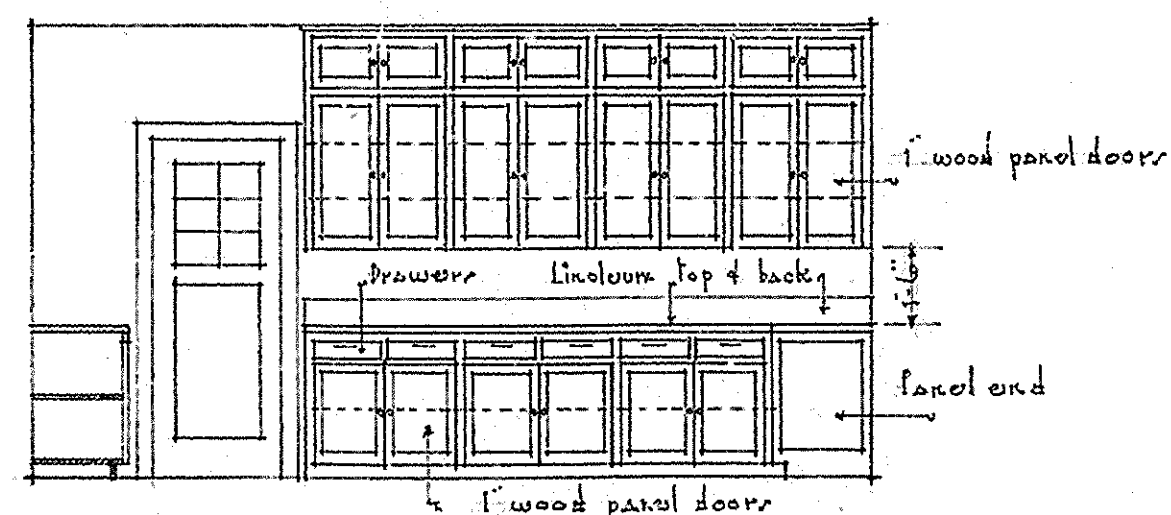


- EAST ELEVATION -  
1.0  
1.0

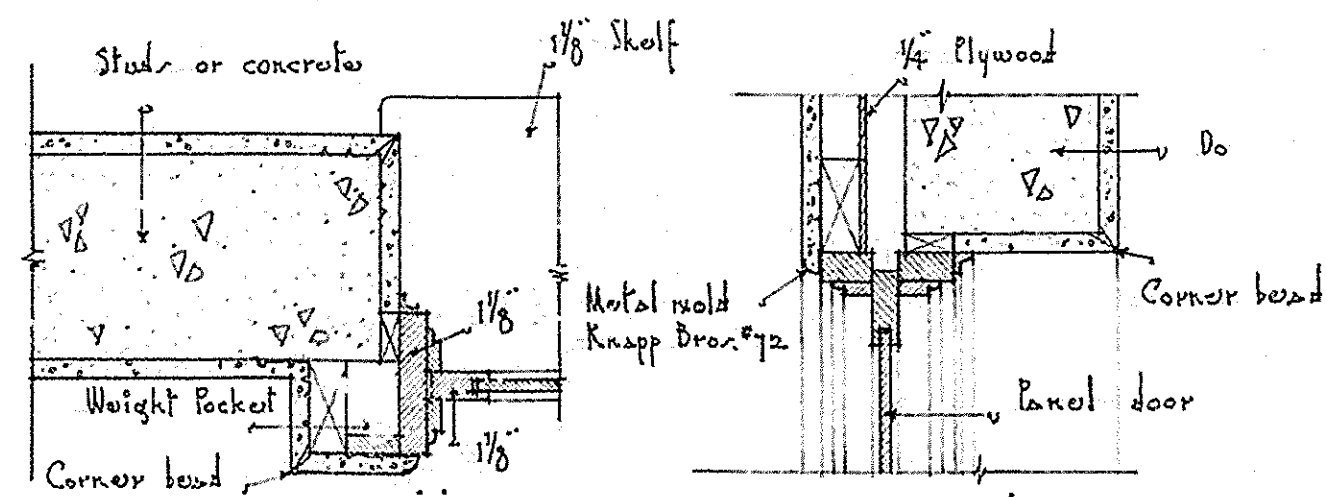

- SEC. 1 -  
1.0  
1.0

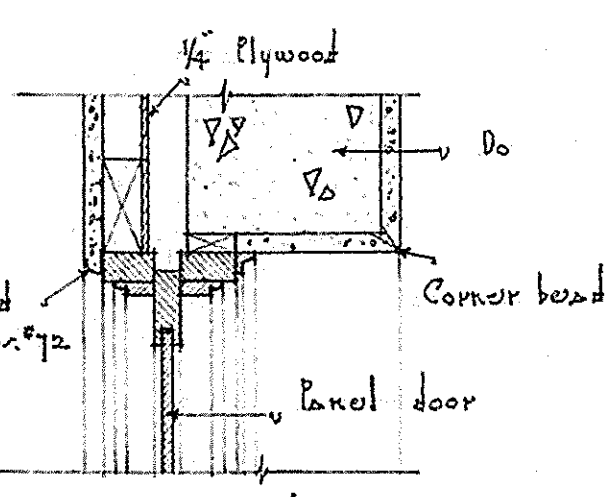


- SEC. 2 -  
1.0  
1.0

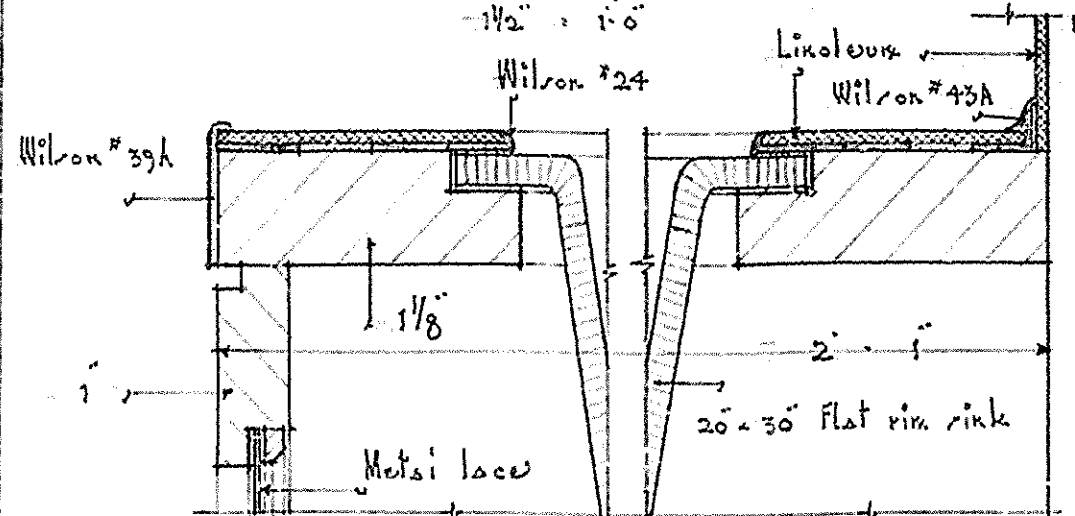


- SEC. 3 -  
1.0  
1.0


- KITCHEN DETAILS -

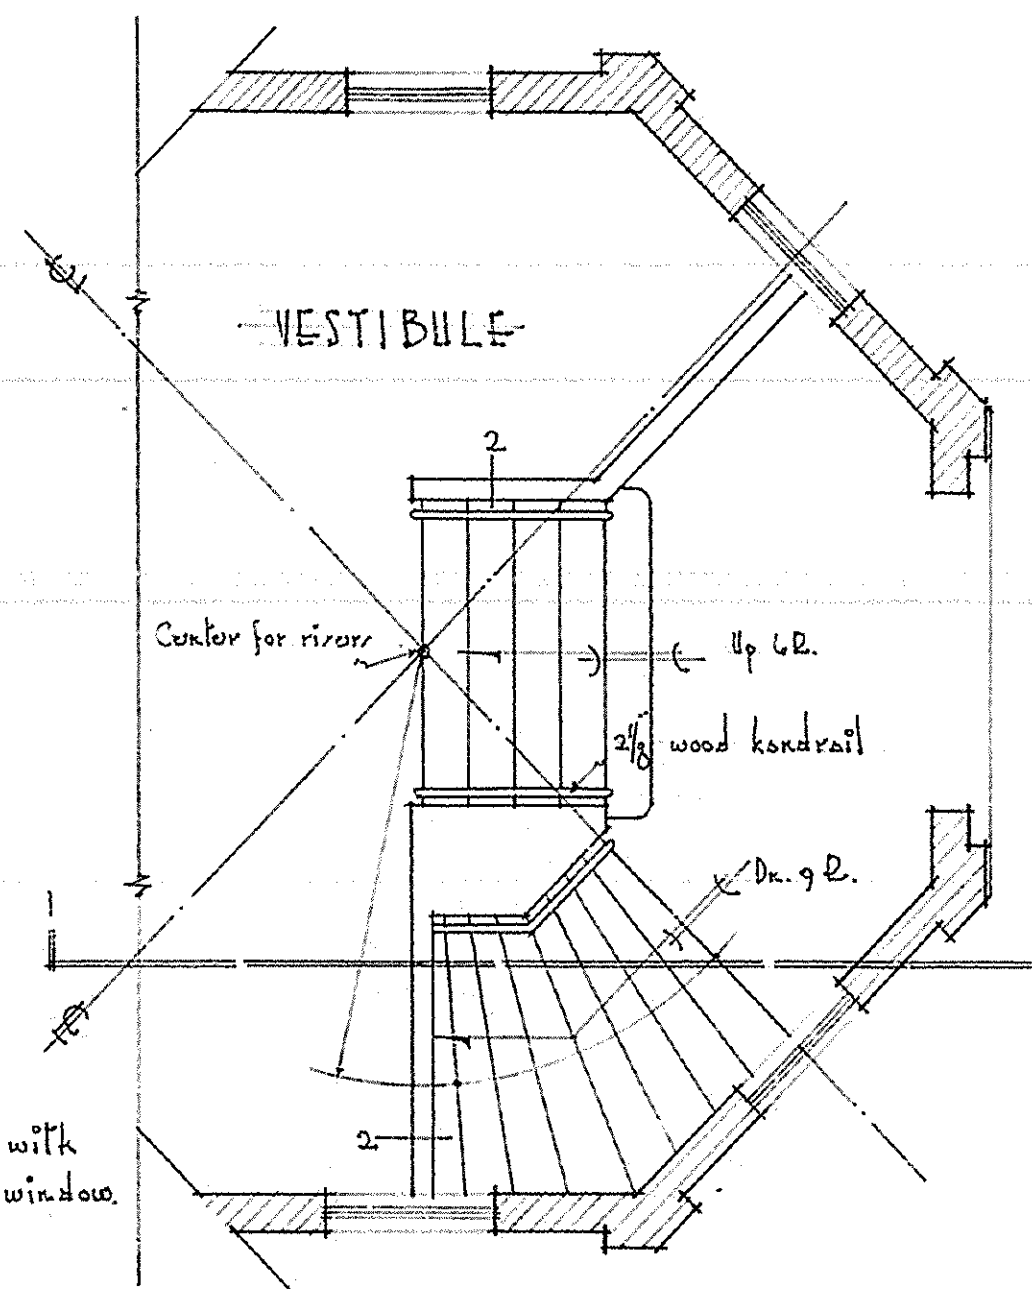

- PLAN -  
1.0  
1.0

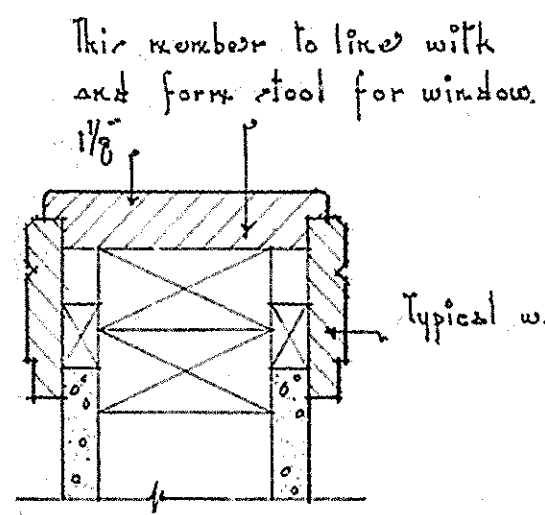

- SEC. 2 -  
1.0  
1.0

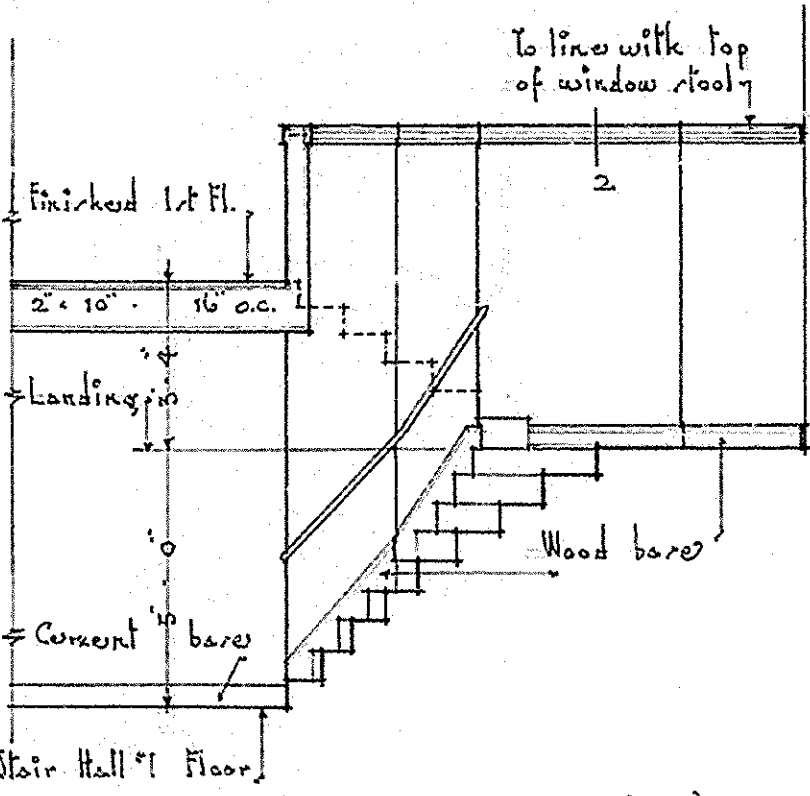

- SECTION 1 -  
1.0  
1.0

- MAIN STAIR DETAIL -

208211

SCALE	NOTED	DETAILS	JOB NO.
			575
DRAWN	BY	WARD	DATE
E. F. M.	L. D. S.	CHURCH	8-1-39
TRACED	E. F. M.	IDAHO	FILE
CHECKED	J. L. M.	CANNON FETZER ARCHTS	0-9
		SALT LAKE CITY UTAH	REVISED



16



12

12


16

20



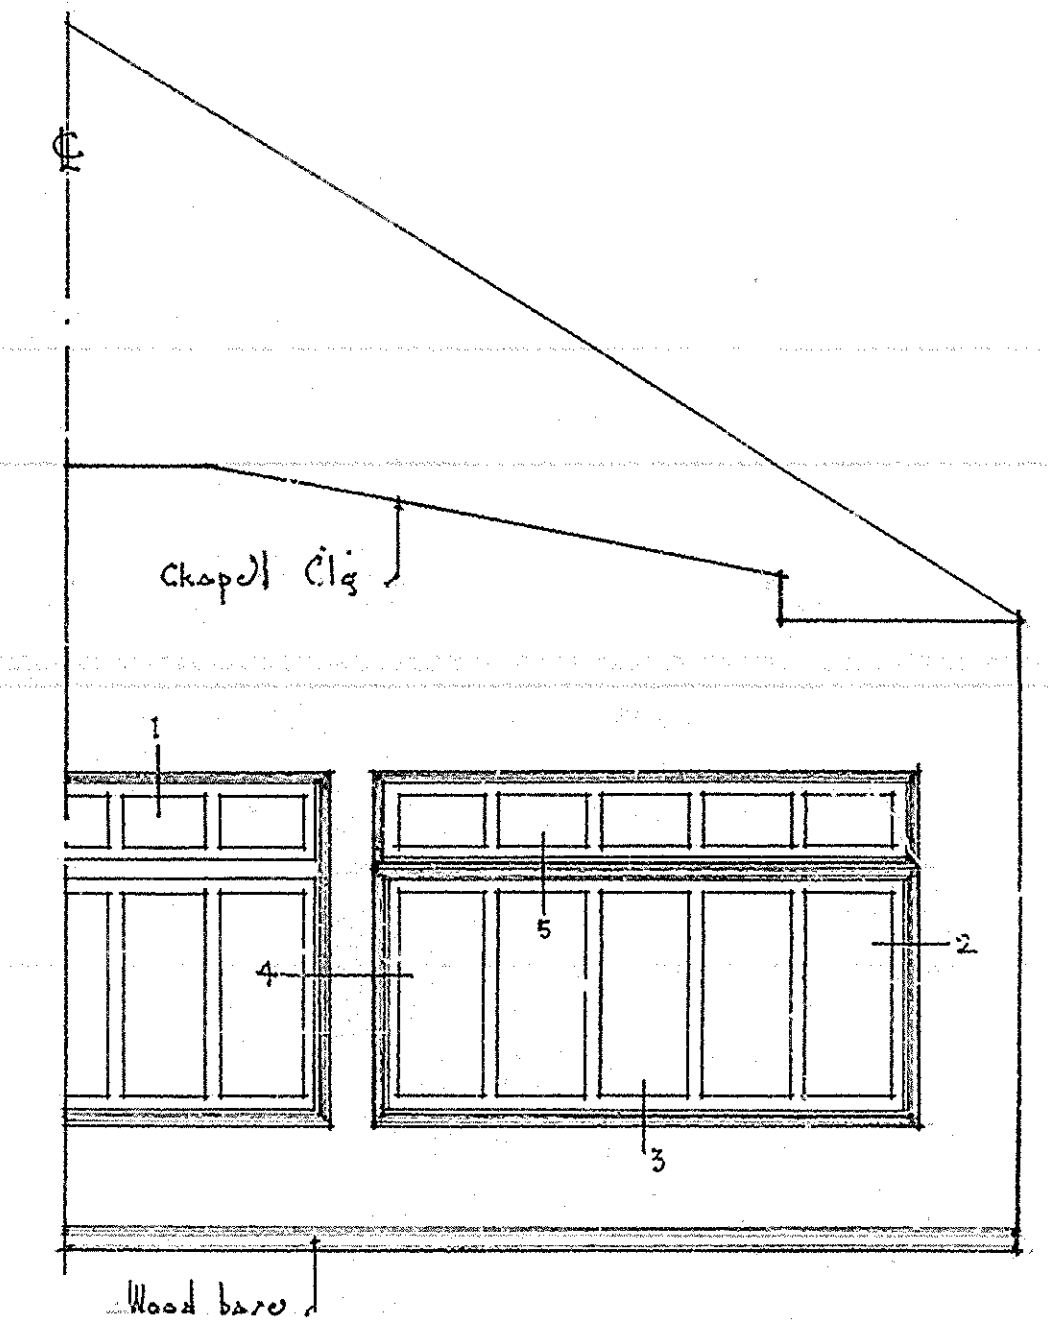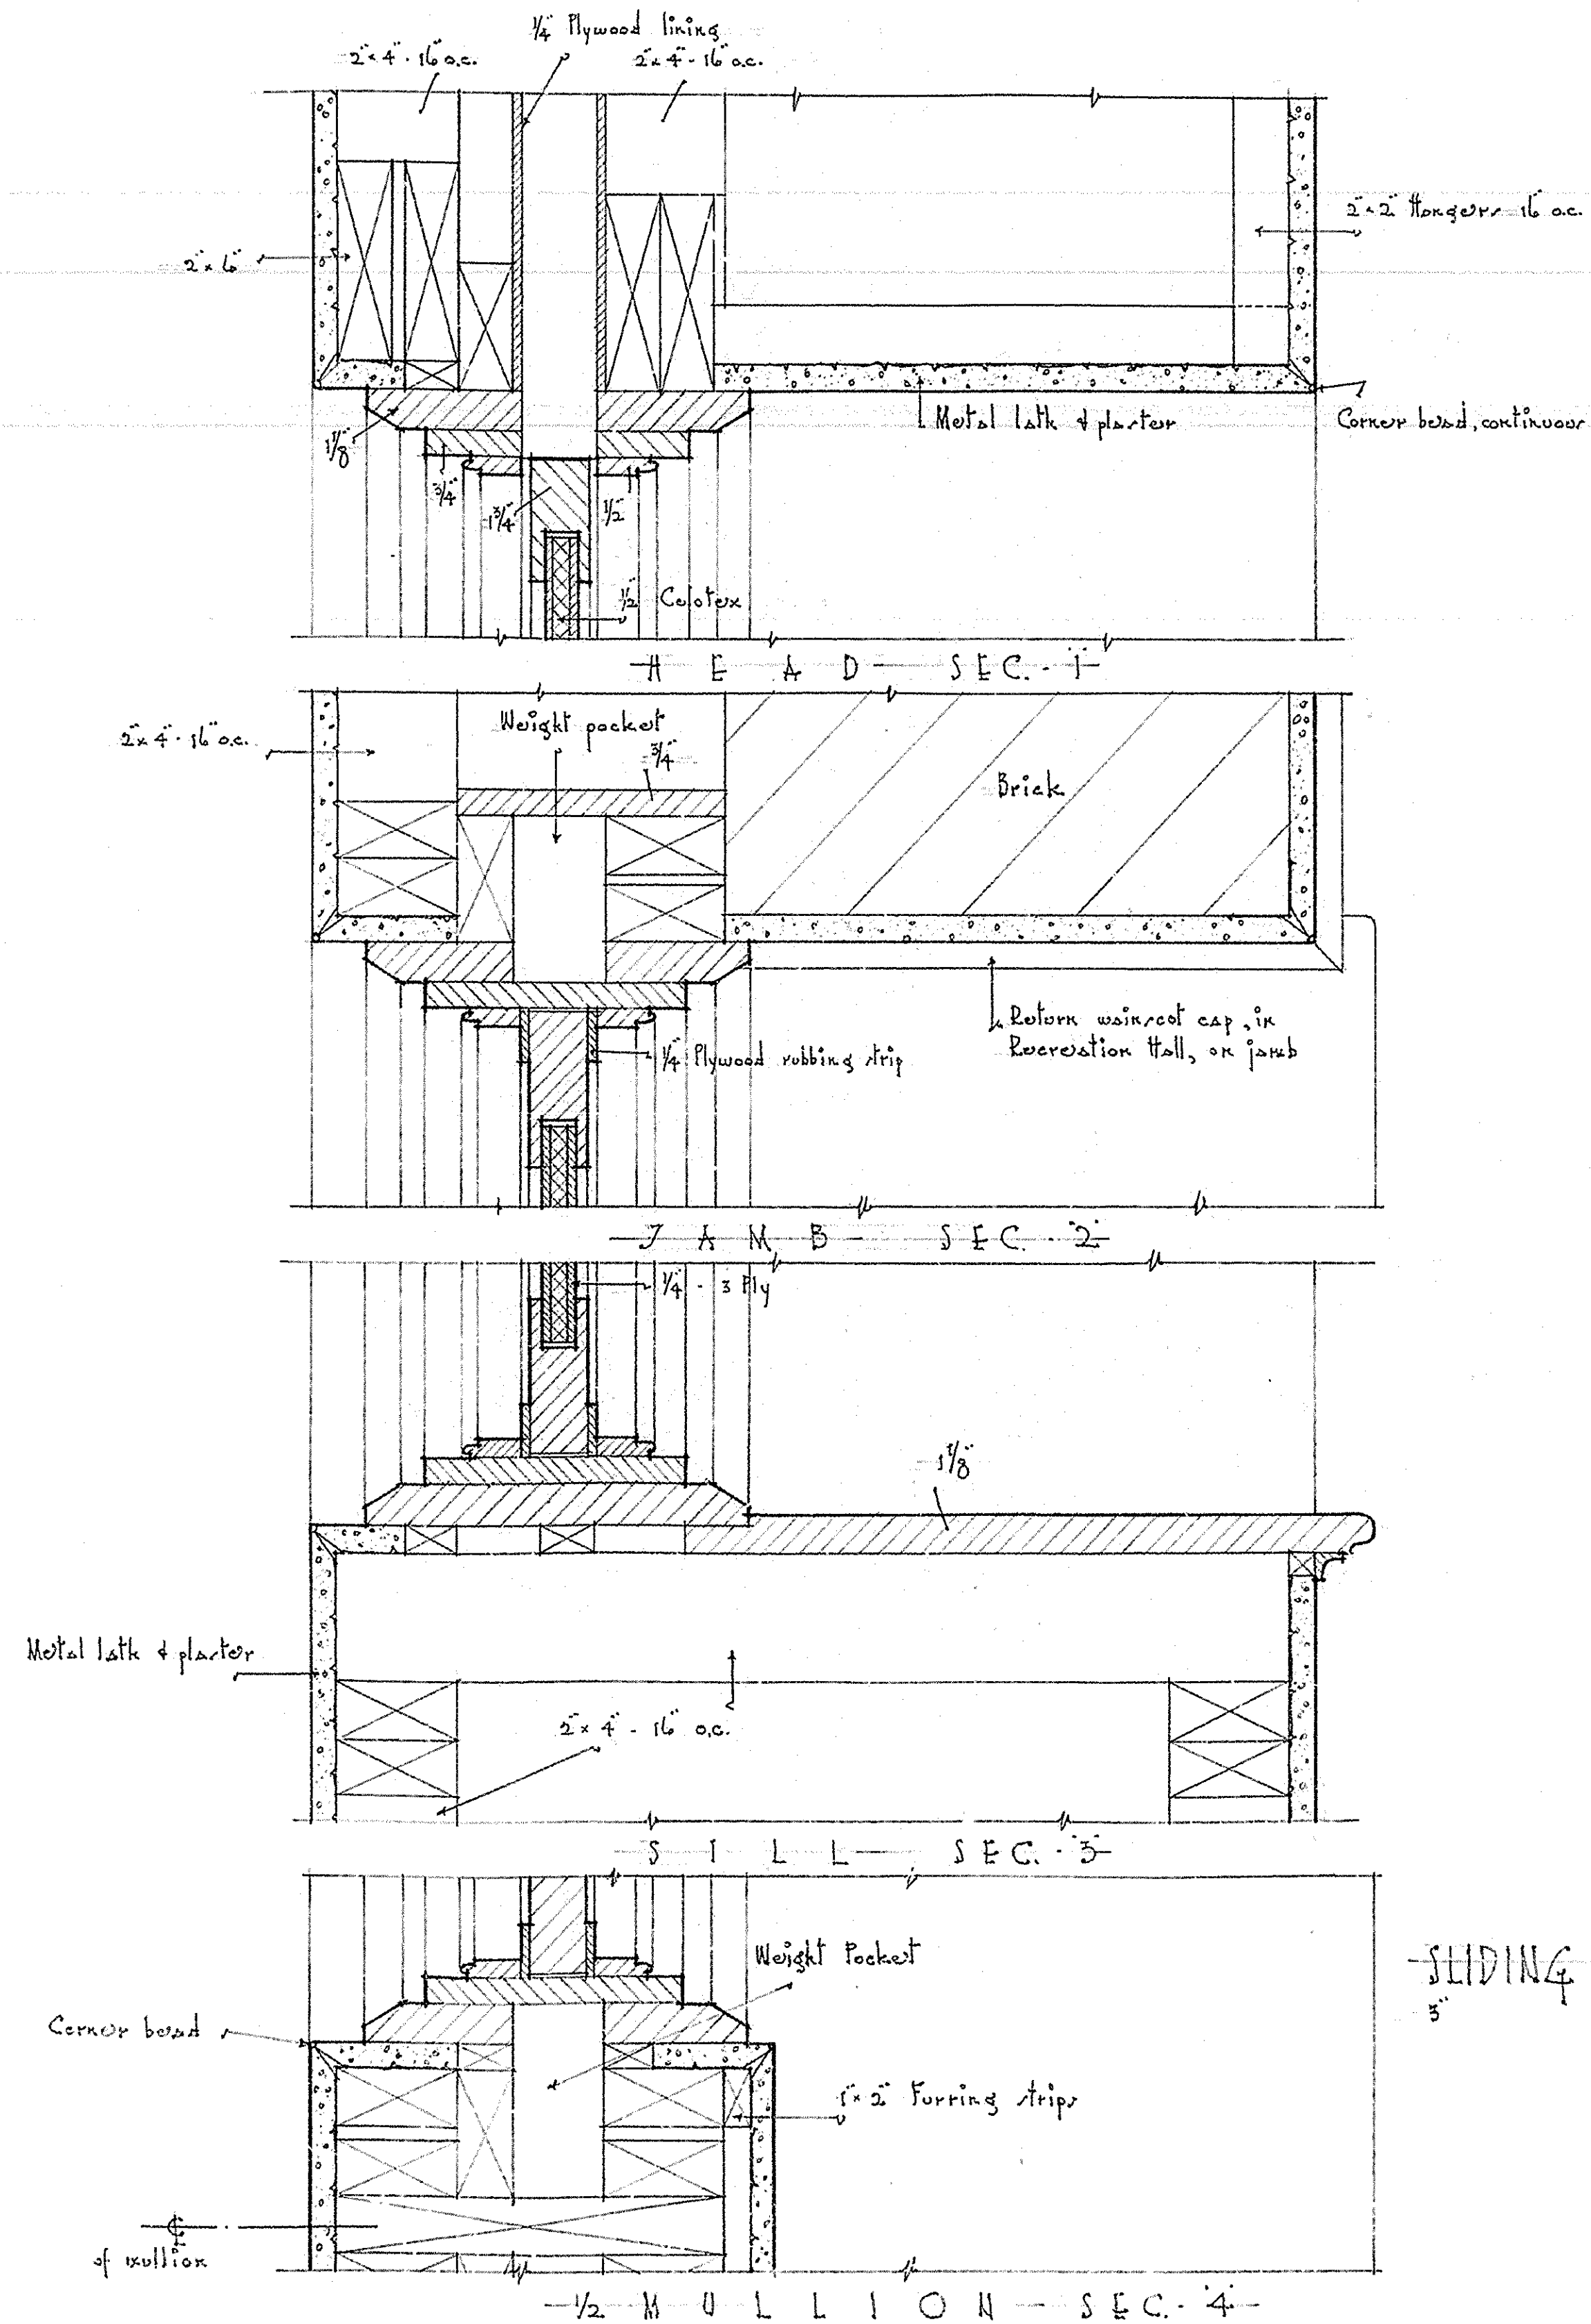

1/2 NORTH ELEVATION OF CHAPEL  
1/4 1:0

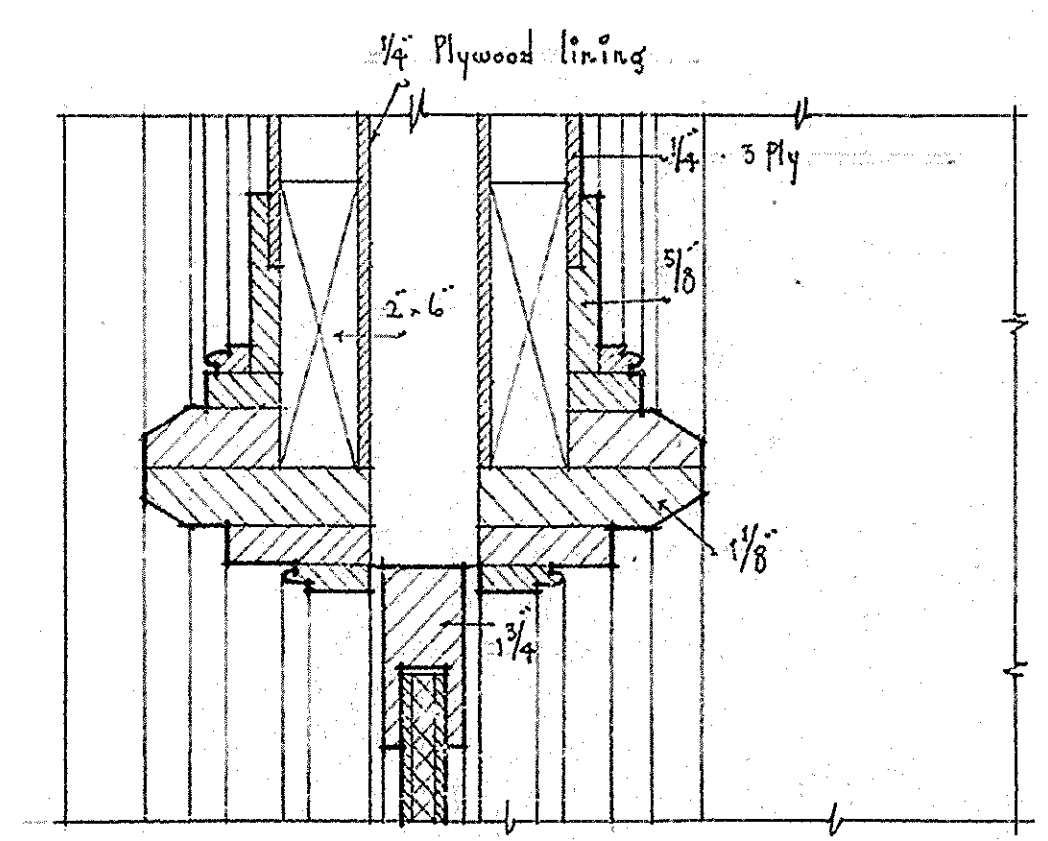

TRANSOM BAR SEC. 5

SLIDING DOOR DETAILS  
5 1:0

SCALE NOTED	INTERIOR DETAILS	JOB NO. 575
DRAWN BY E. F. M.	MENAN WARD	DATE 3-3-33
TRACED BY C. F. M.	L. D. S. CHURCH	FILE 11
CHECKED BY J. L. M.	CANNON & FETZER ARCHTS.	REVISION
	SALT LAKE CITY, UTAH	



16

12


12

16

22 E 9 B 2


20x



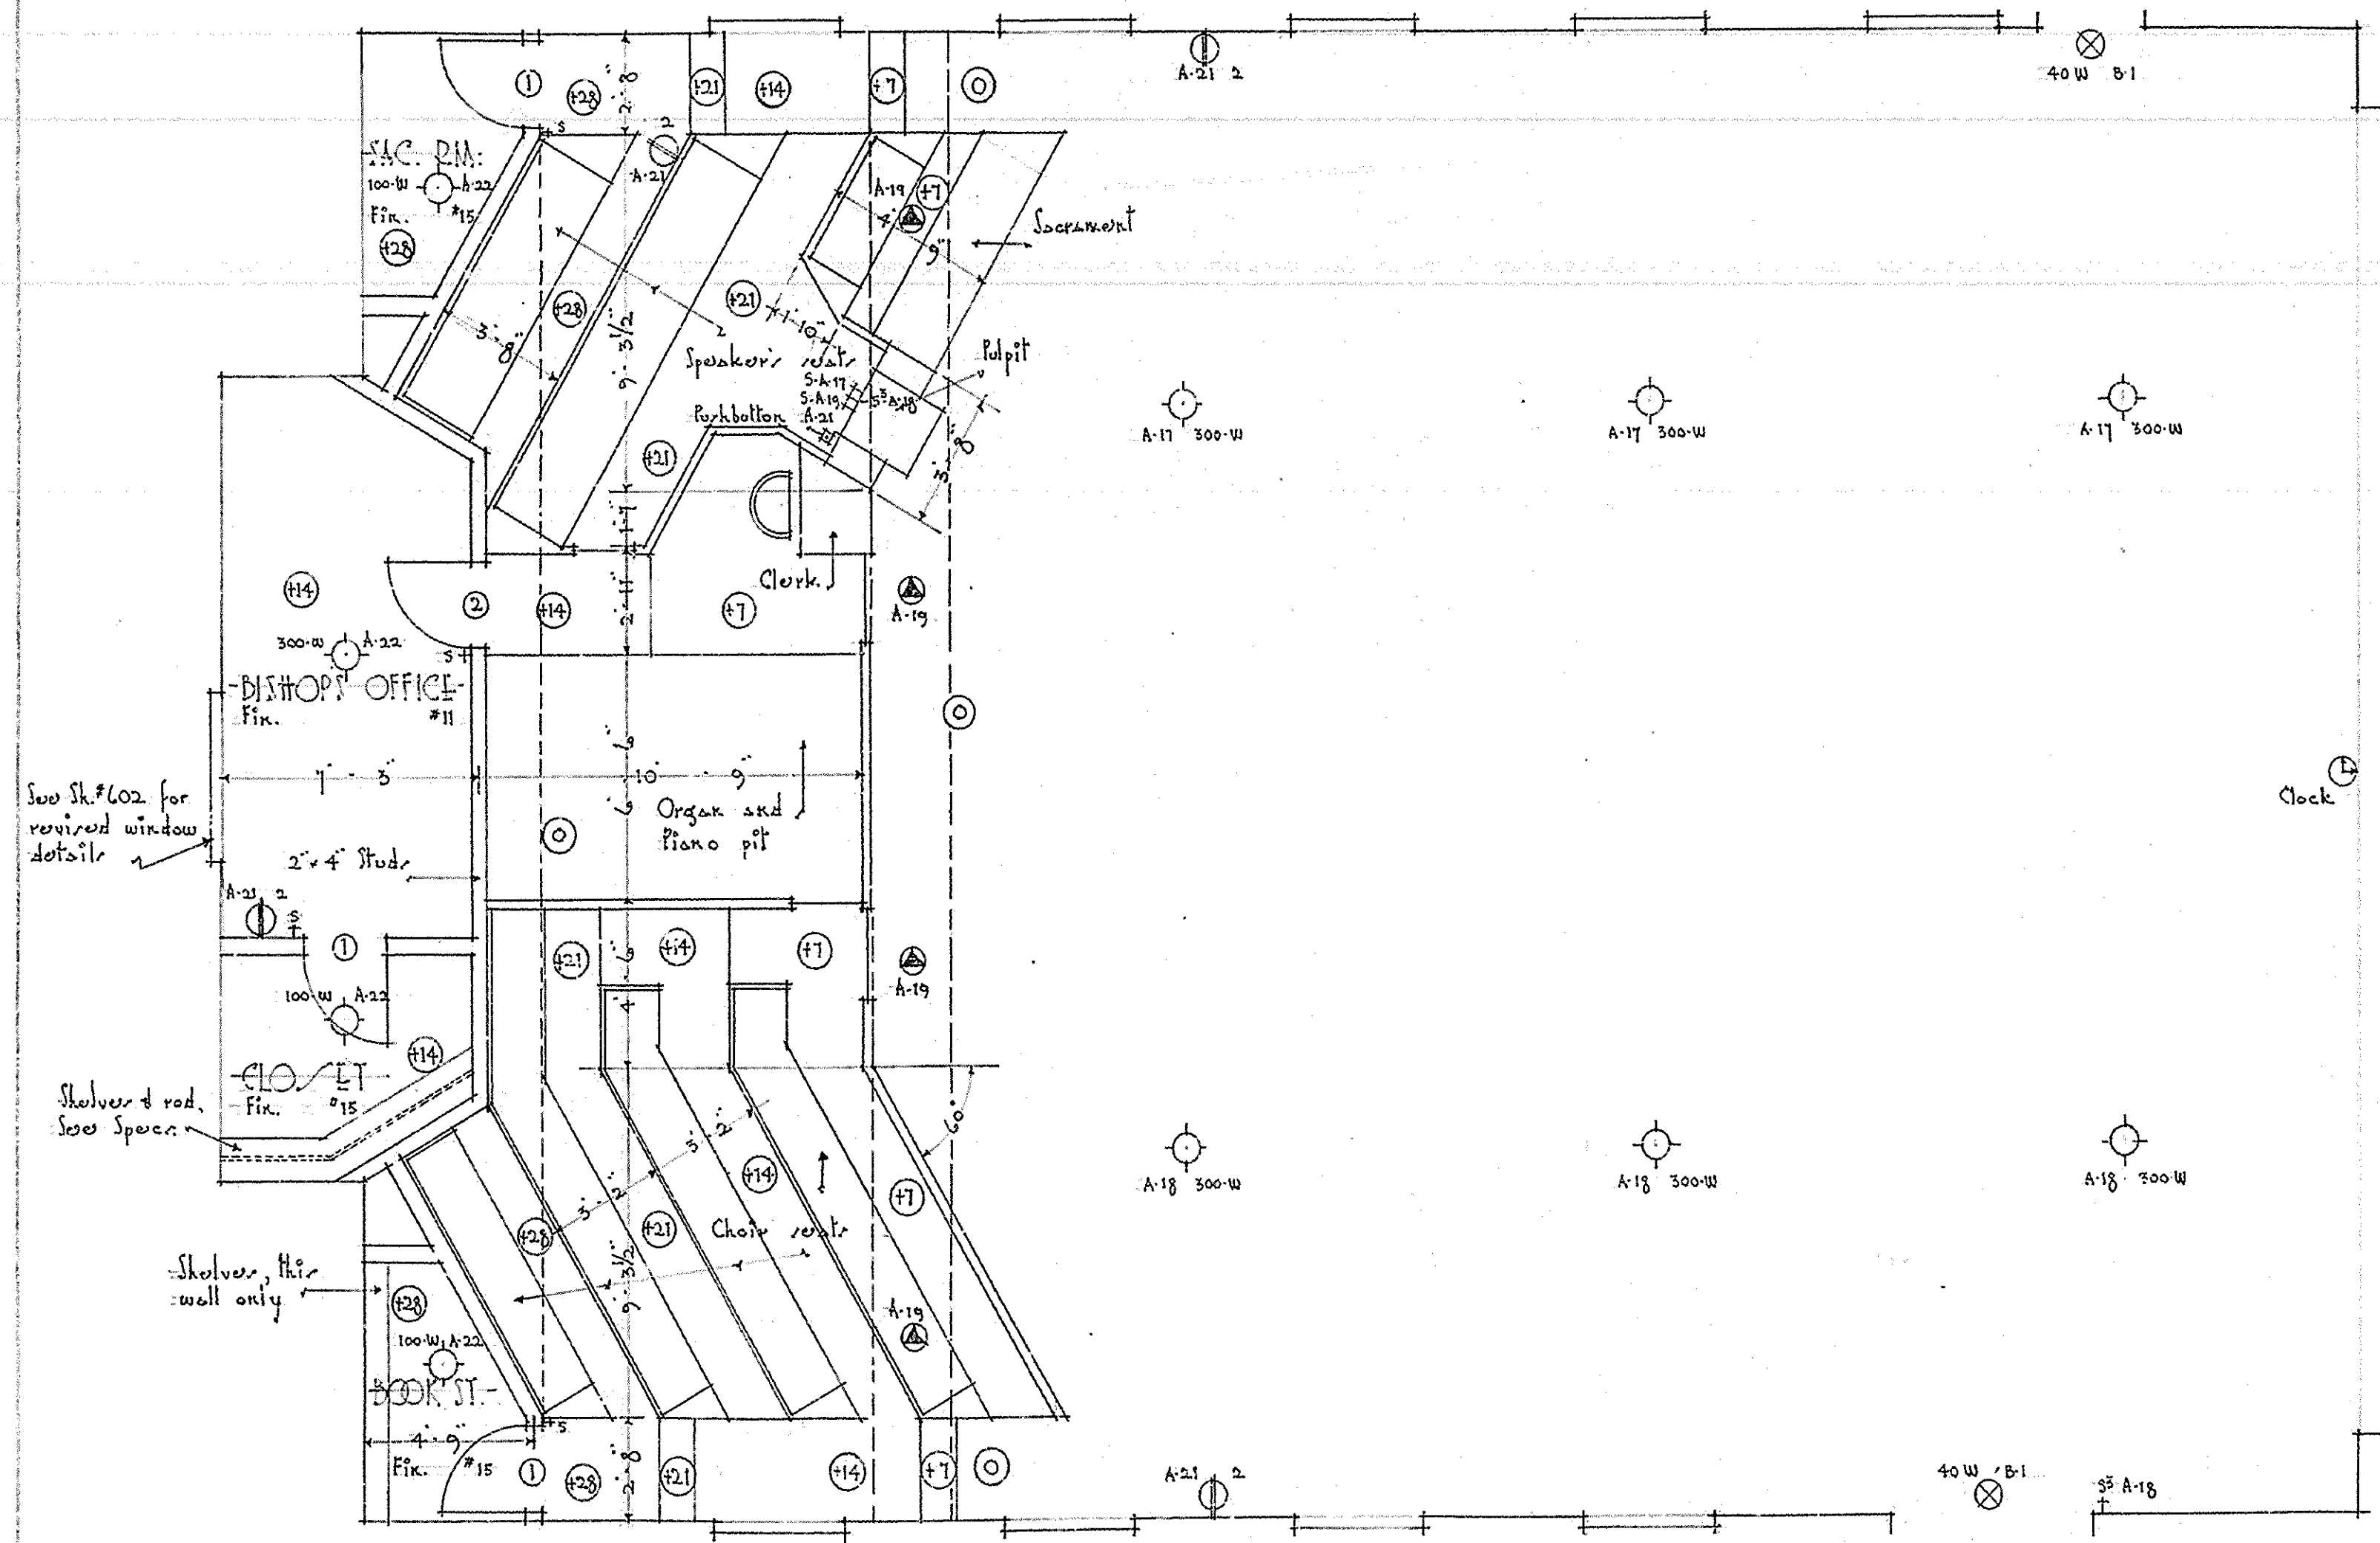


Eliminate circuit A-20.  
 NOTE 5: All dimensions are to rough.  
 Contractor shall verify all dimensions at site.  
 Seats, pulpit, sacrament, etc., not in this contract.  
 Rooms shown on this plan are to be wired exactly as shown, disregarding original layout.

- ① 2'-4" x 6'-5" x 1 7/8" Type-A
- ② 2'-8" x 6'-8" x 1 7/8" " " B

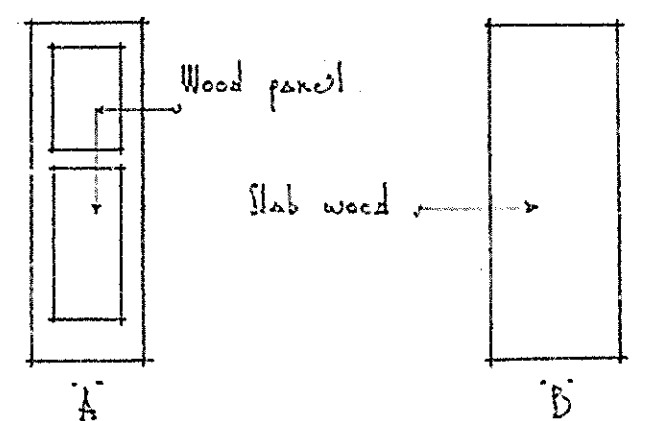


This door schedule shall supersede original door schedule.

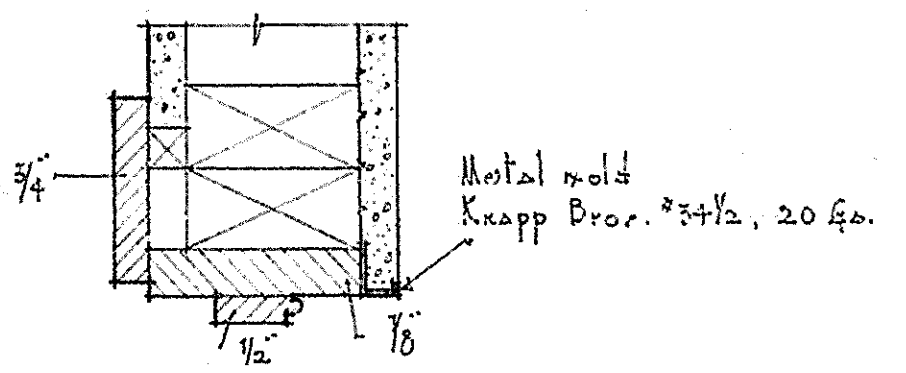

DOOR JAMB - DOORS #142 - 1'-6"

SCALE 1/4" = 1'-0"	CHapel SEATING PLAN	JOB NO. 575
DRAWN D. F. M.	MENAN WARD	DATE 7-27-29
TRACED R. F. M.	L. D. J. CHURCH	FILE
CHECKED J. L. M.	CANNON & FETZER ARCHTS. SALT LAKE CITY, UTAH	DEVIDED

601

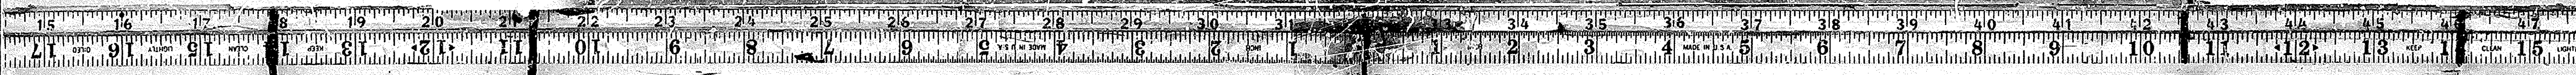

16


12

12

16

20




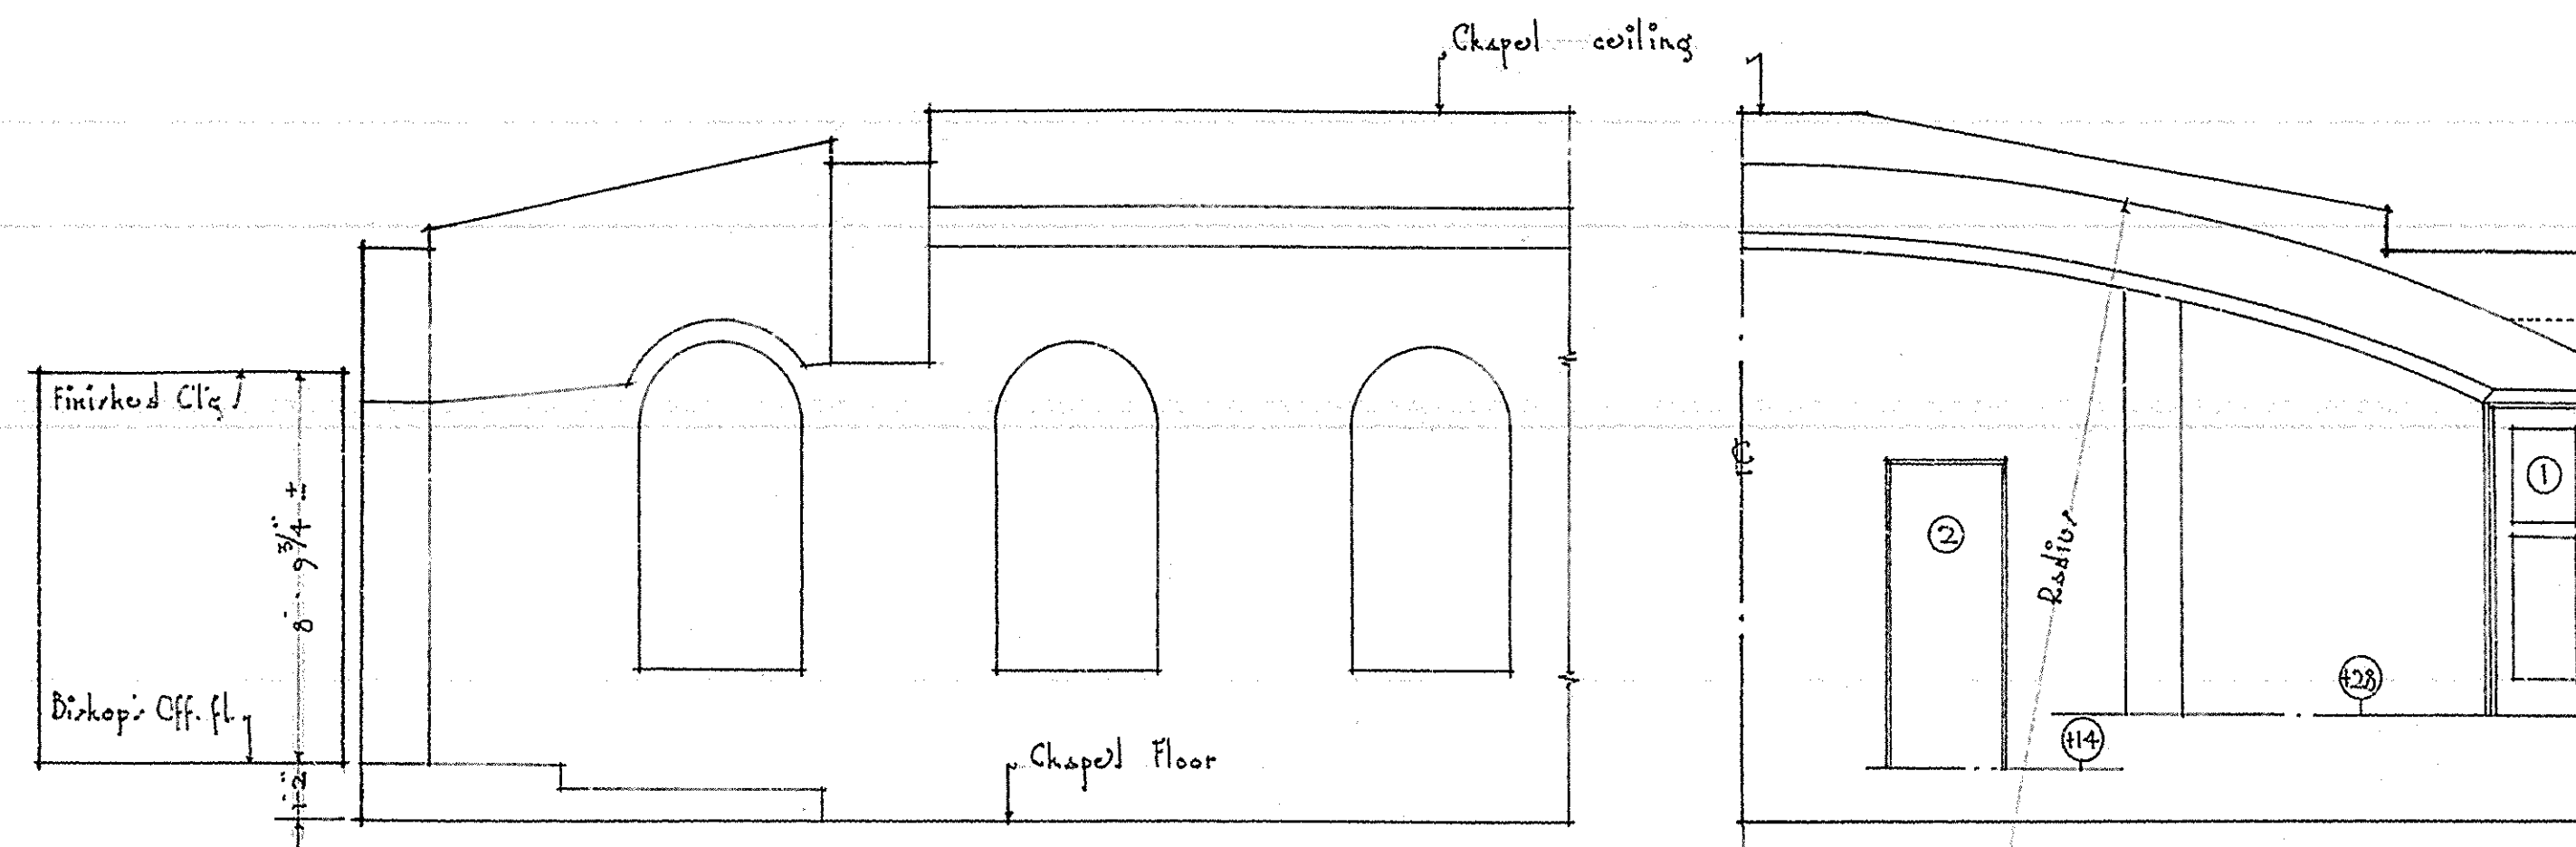

LONGITUDINAL SECTION AT  $\phi$ -  
1/4" 1'-0"

1/2 ELEVATION  
1/4" 1'-0"

NOTES: Contractor shall verify all dimensions at site.  
See Sit 601 for Restroom floor levels.

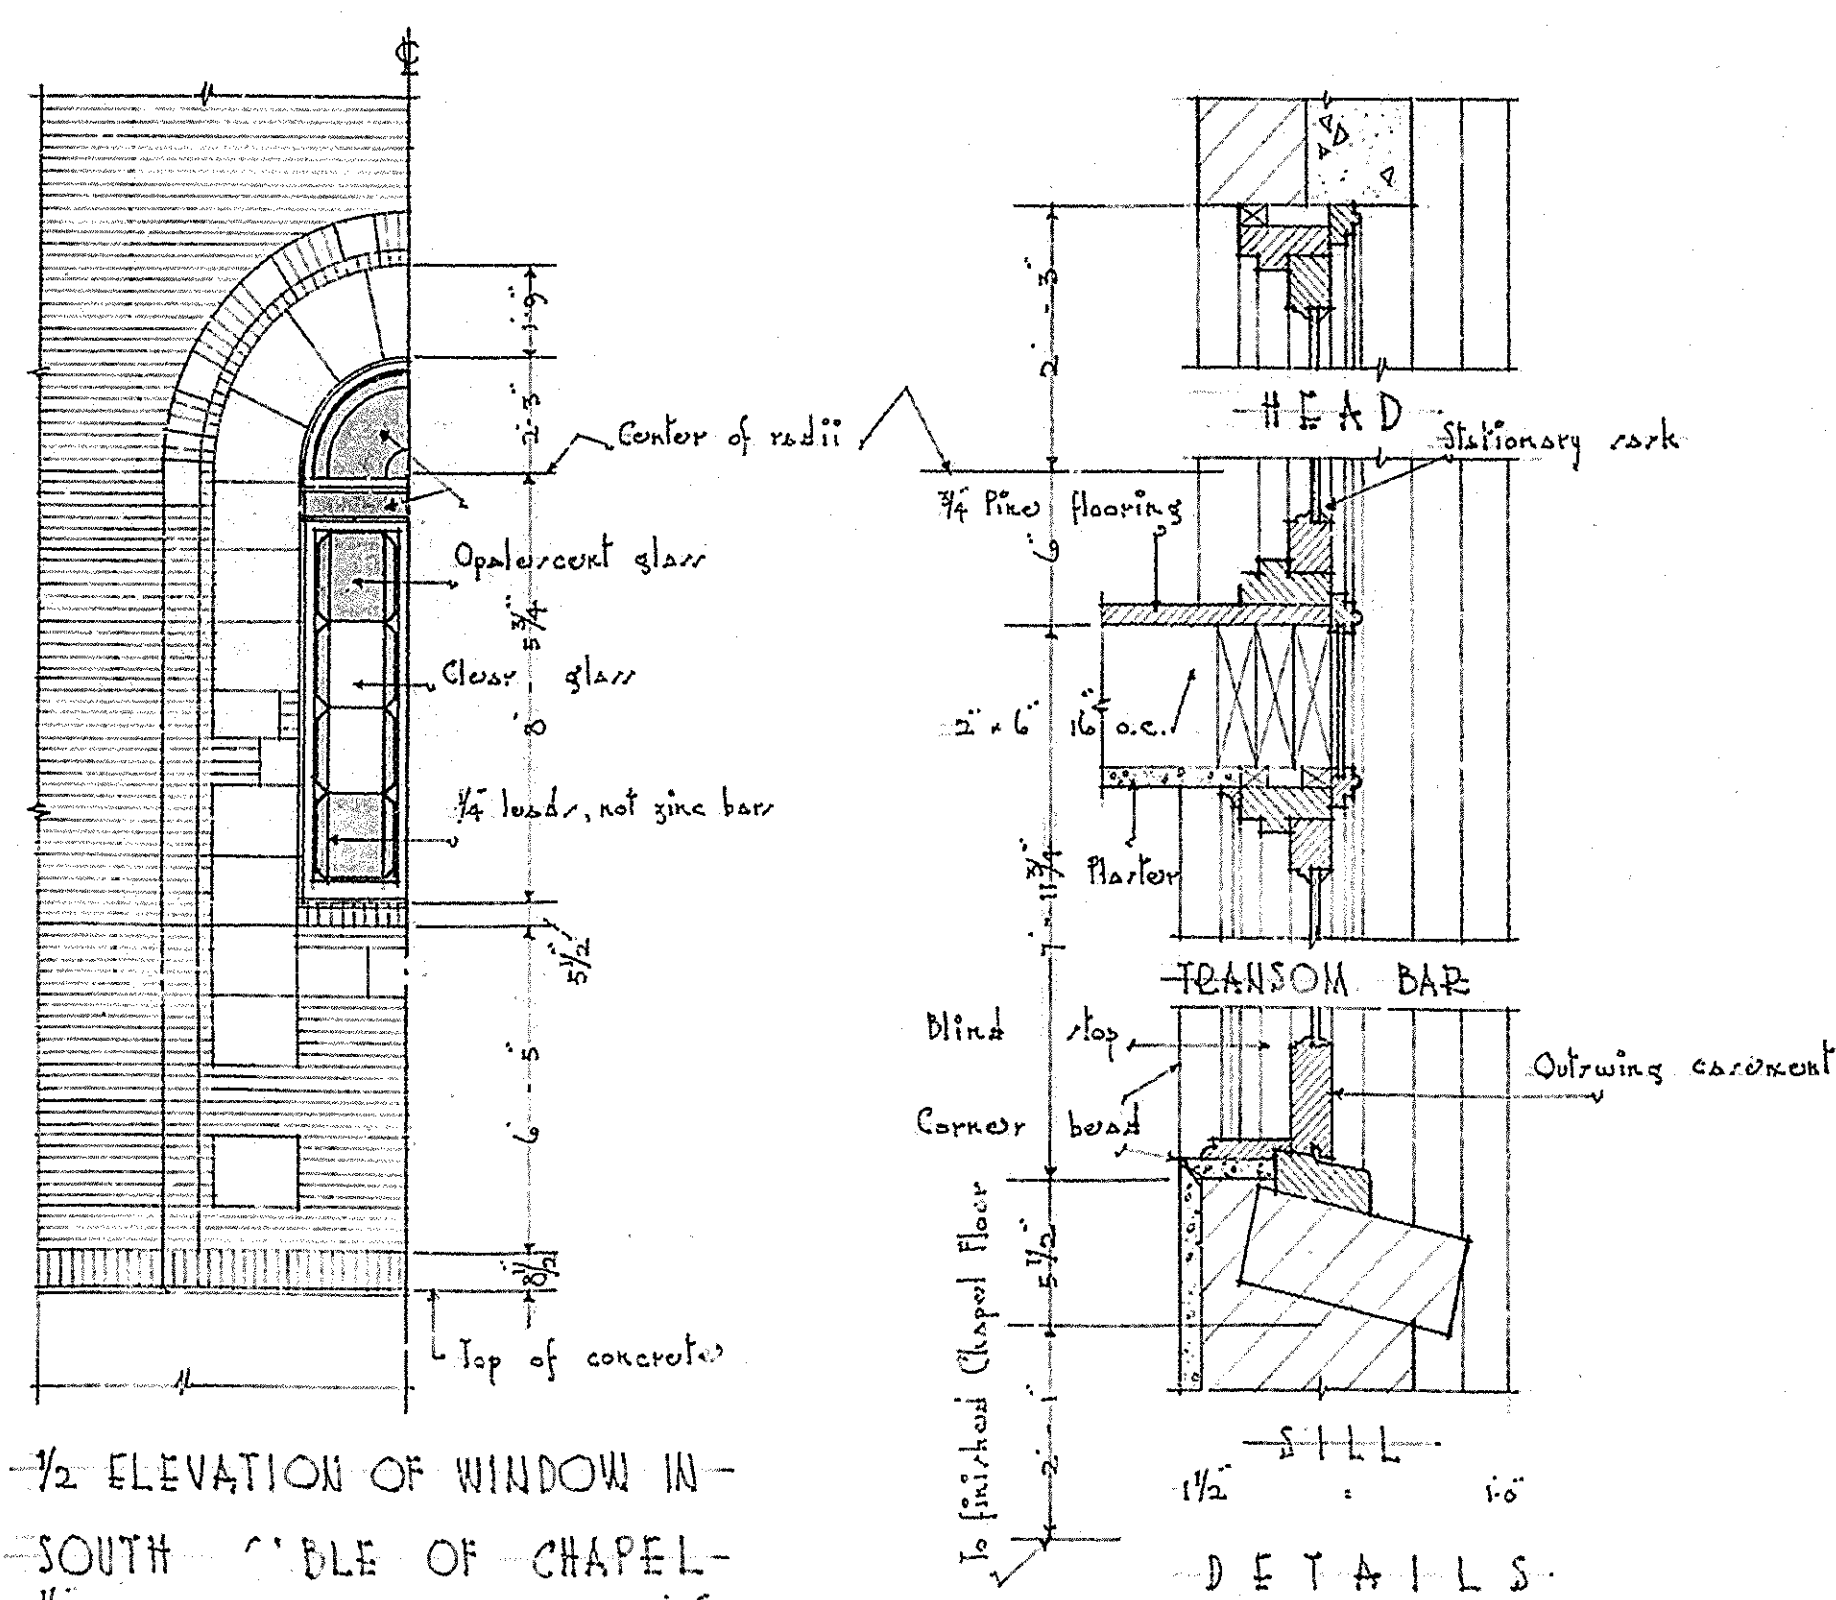

1/2 ELEVATION OF WINDOW IN -  
SOUTH SIBLE OF CHAPEL -  
1/4" 1'-0"

DETAILS

SCALE 1/4" = 1'-0"	REVISIONS	JOB NO. 575
DRAWN E. F. M.	MENAN WARD	DATE 1-27-39
TRACED E. F. M.	L. D. S. CHURCH	FILE 2-9
CHECKED J. L. M.	CANNON & FETZER ARCHTS.	REVISED
	SALT LAKE CITY, UTAH	

602




16

12

12


16



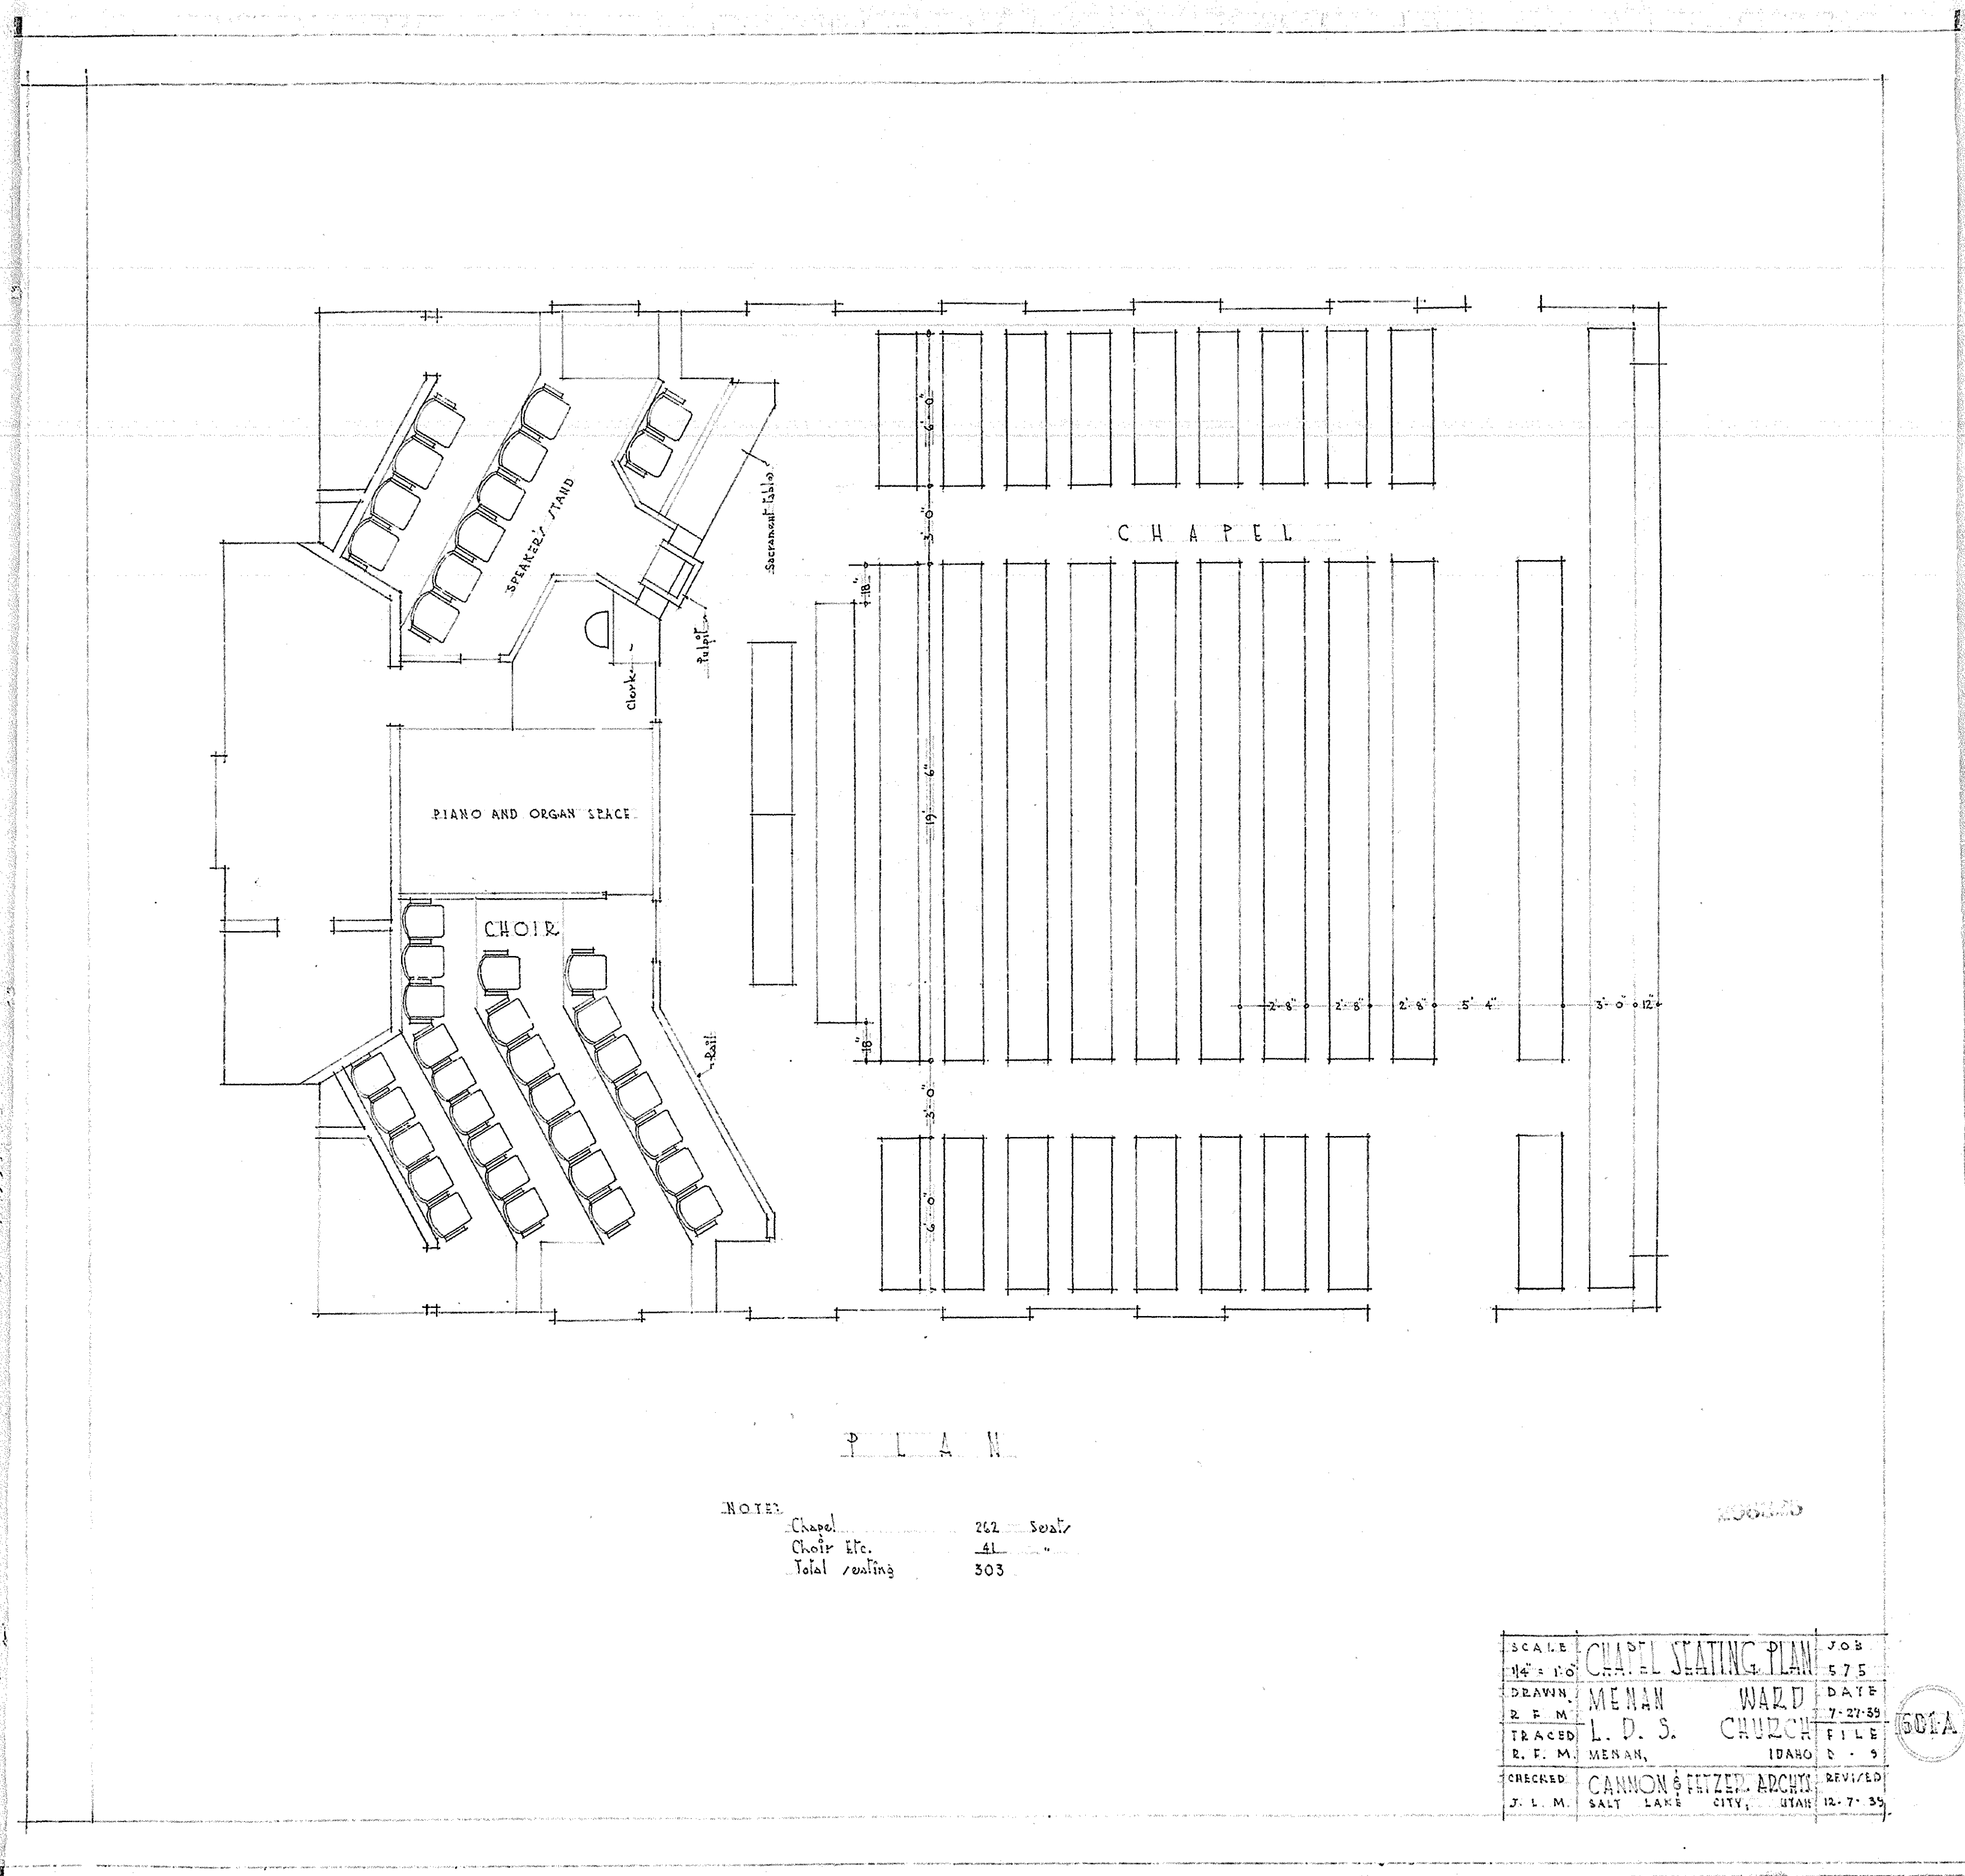

NOTES  
 Chapel 262 Seats  
 Choir Etc. 41  
 Total Seating 303

SCALE	CHAPEL SEATING PLAN	JOB
1/4" = 1'-0"		575
DRAWN	MENAN	WARD
R. F. M.	L. D. S.	CHURCH
TRACED	MENAN,	IDAHO
R. F. M.		2 - 5
CHECKED	CANNON & FITZGERALD ARCHTS.	REVISED
J. L. M.	SALT LAKE CITY, UTAH	12-7-35

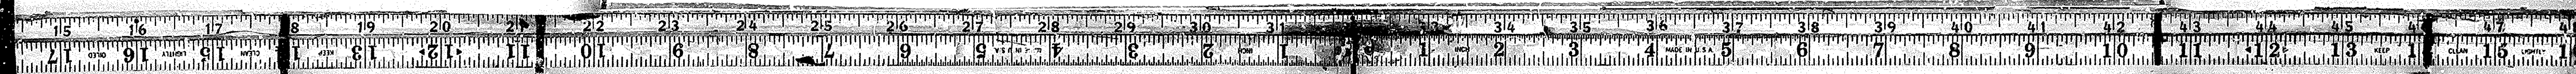


16


12

12


16

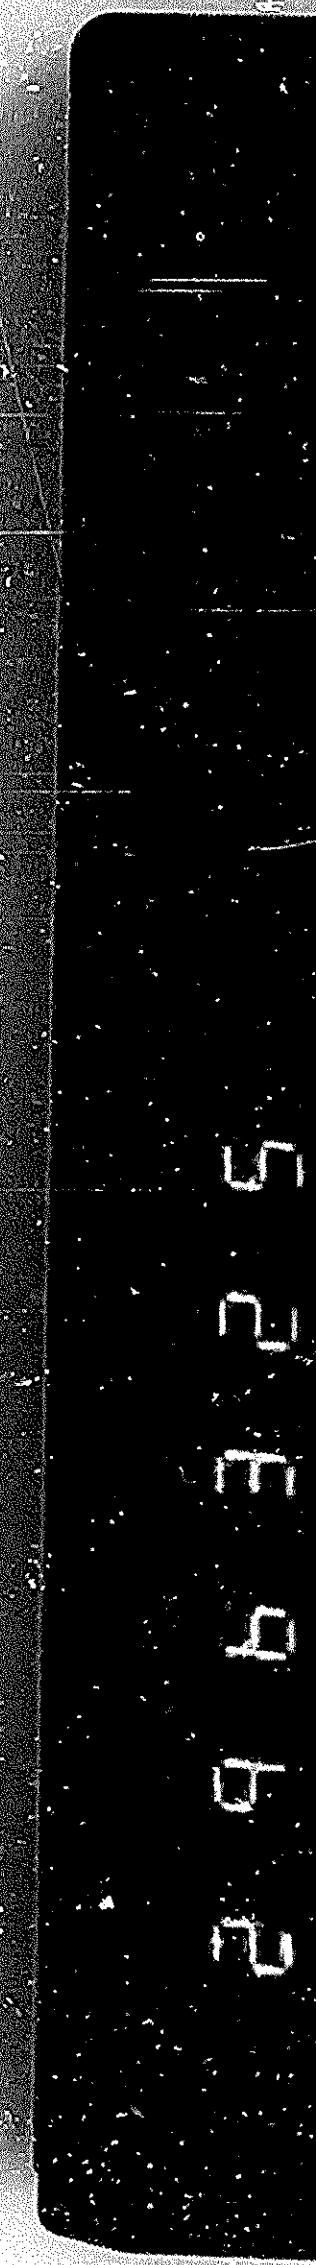




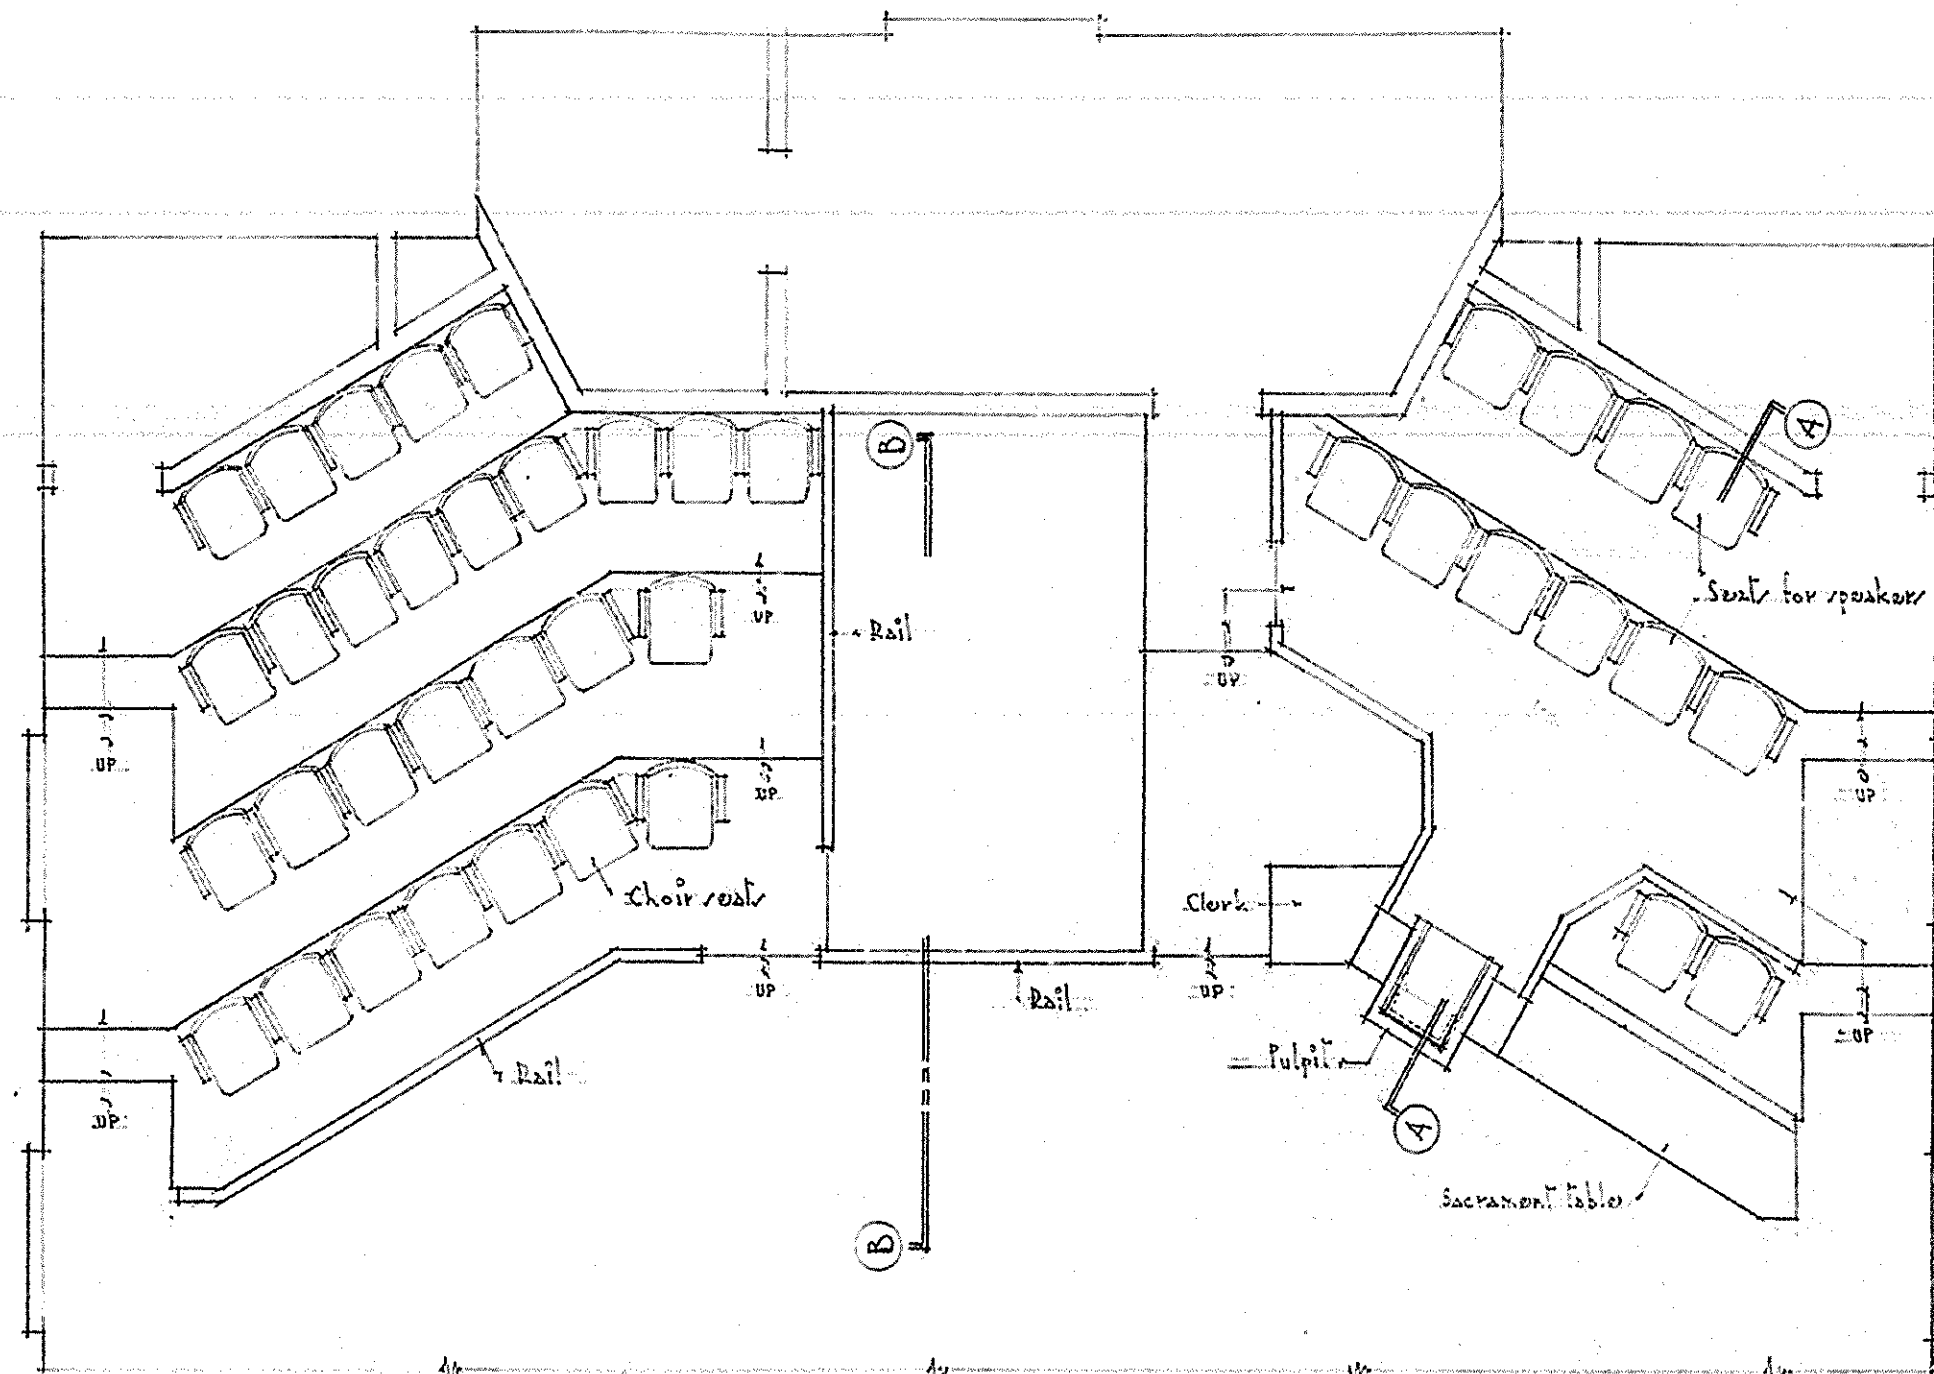


PLAN OF CHOIR STAND AND PULPIT ETC.  
SCALE 1/4" = 1' 0"

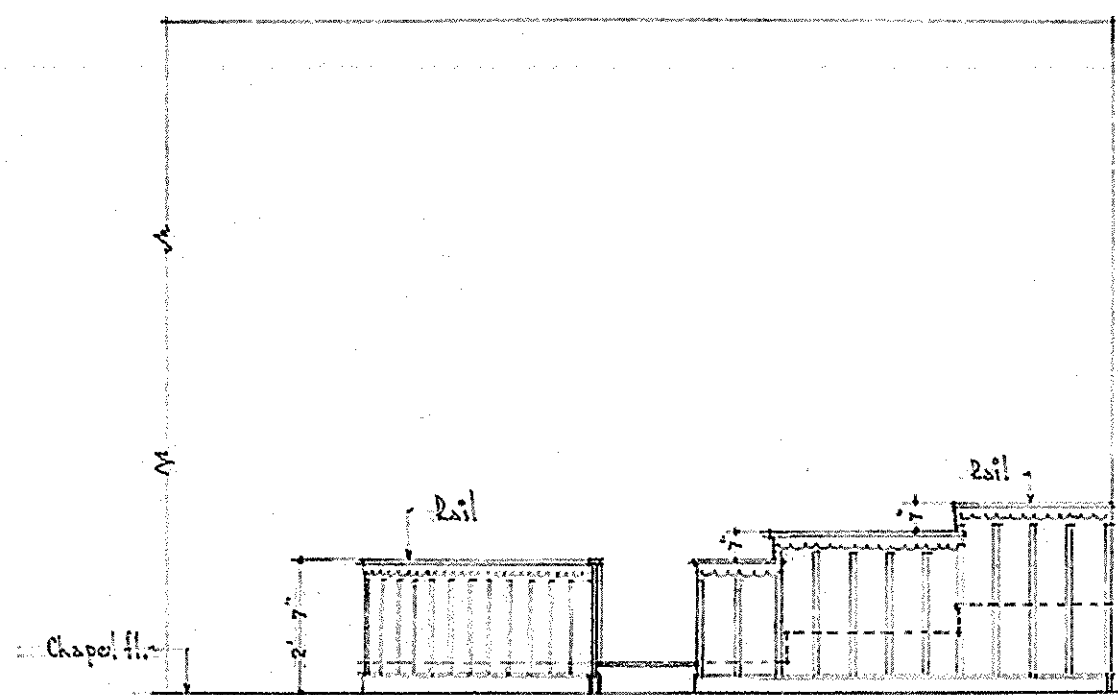

SECTION B - B  
SCALE 1/4" = 1' 0"

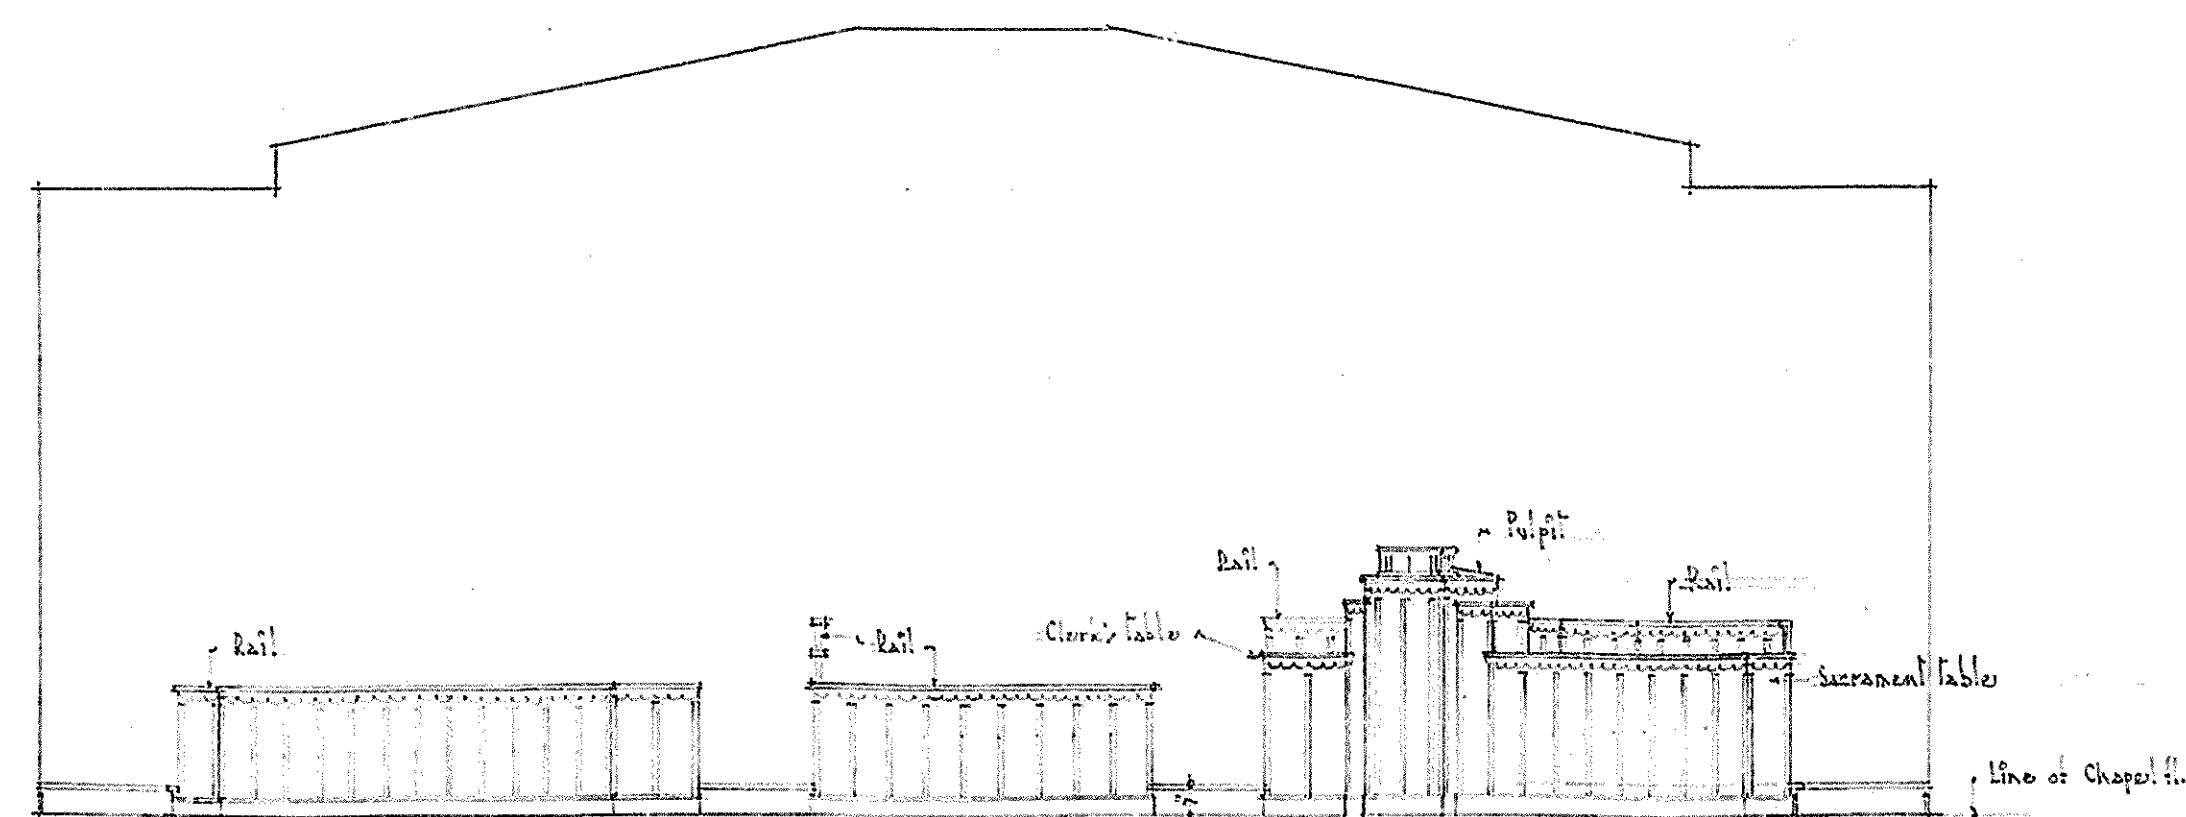


ELEVA. OF CHOIR RAIL AND PULPIT ETC.  
SCALE 1/4" = 1' 0"

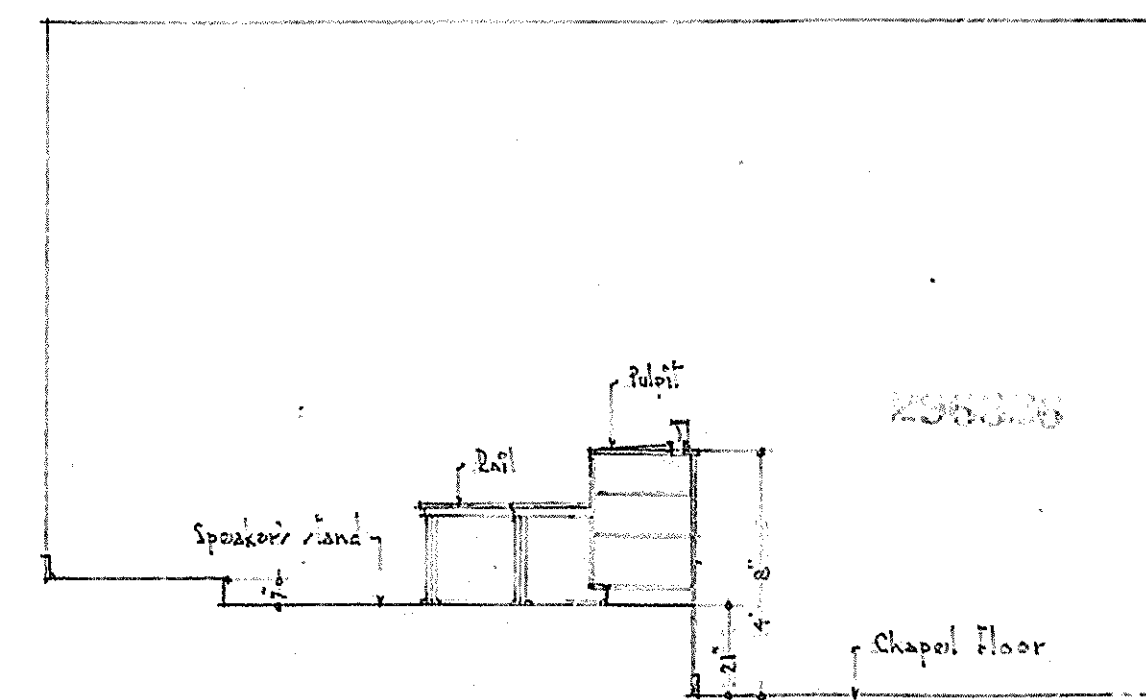

SECTION A - A  
SCALE 1/4" = 1' 0"

SCALE	DETAIL	JOB
1/4" = 1' 0"		576
DRAWN	MENAN	WARD
TEACED	L. D. S.	CHURCH
CHECKED	CANNON, FETZER, ARCHTS.	SALT LAKE CITY, UTAH
		DATE
		12-7-21
		FILE
		D-3
		REVISED

602A

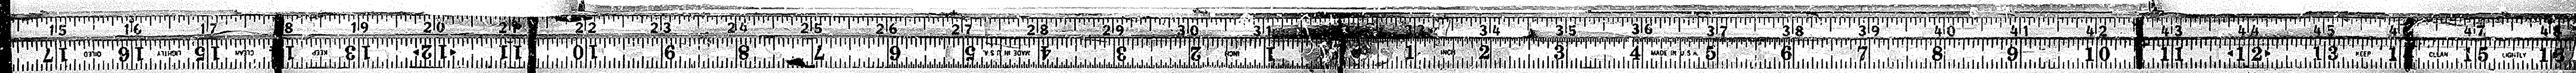

16

12


12

16


20x

296326




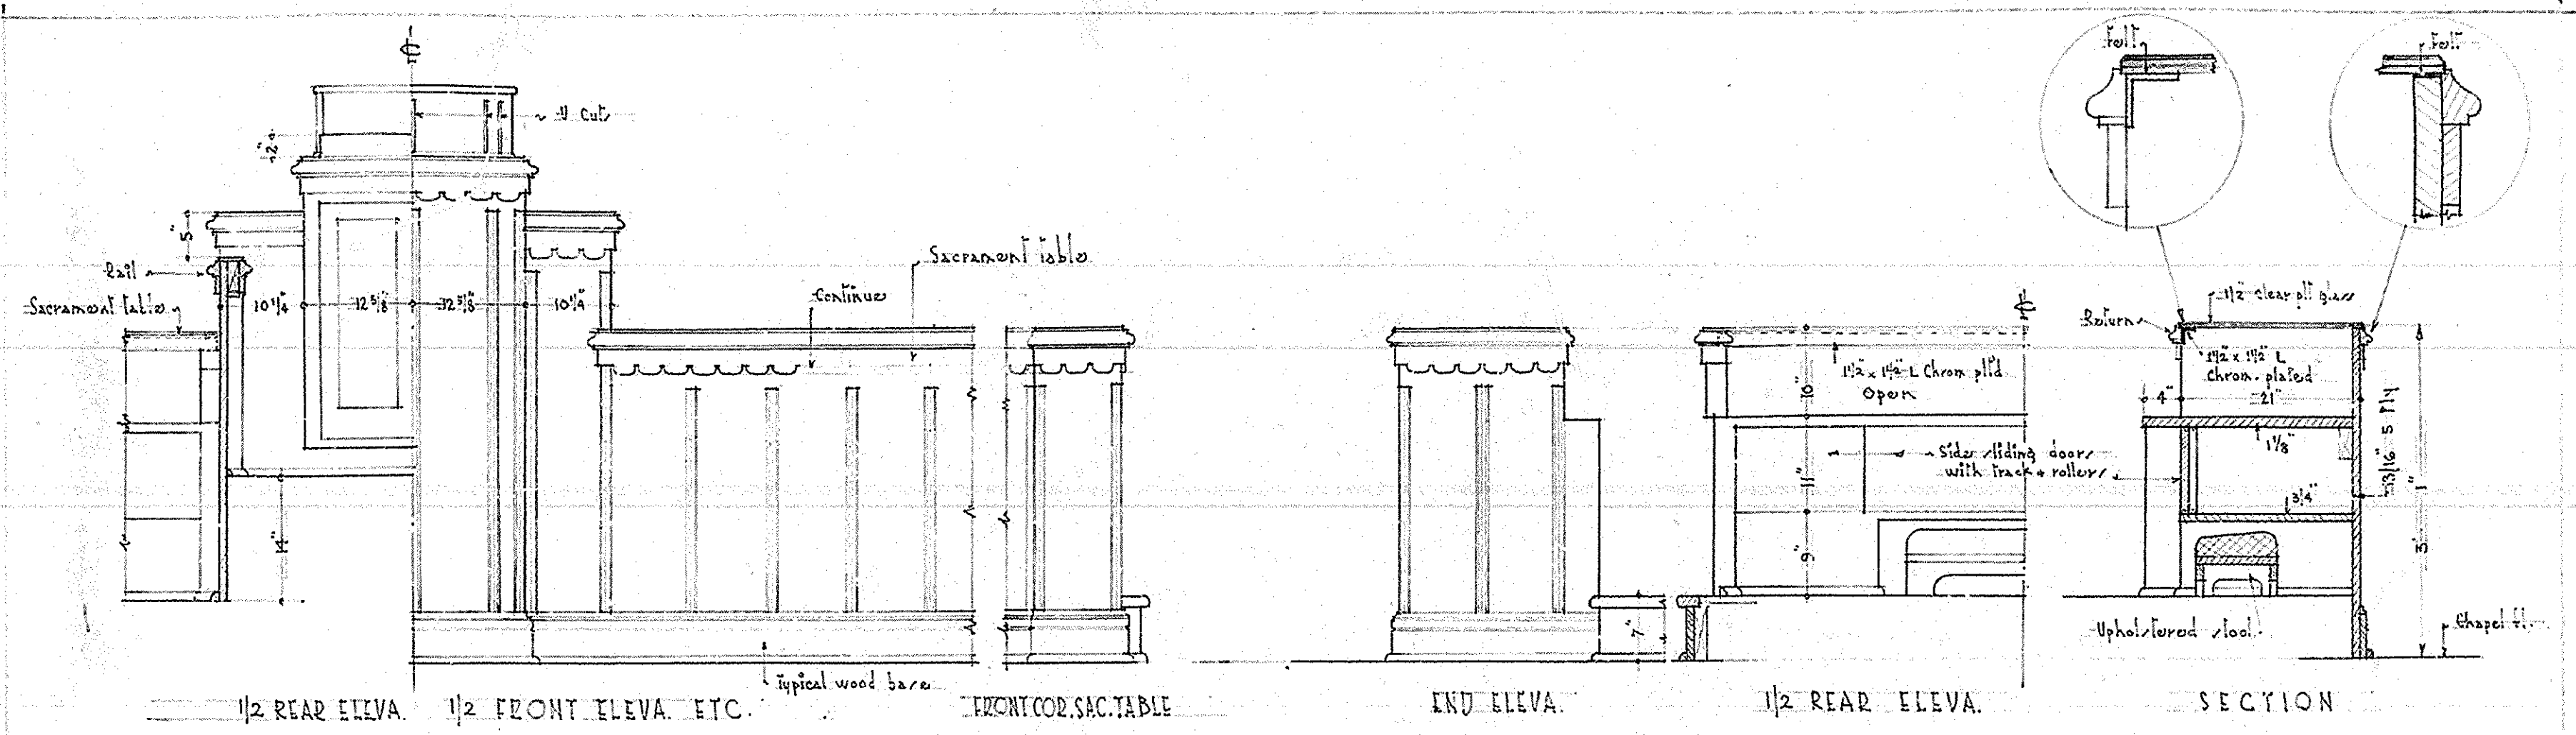

SACRAMENT TABLE DETAILS  
SCALE 3/4" = 1'-0"

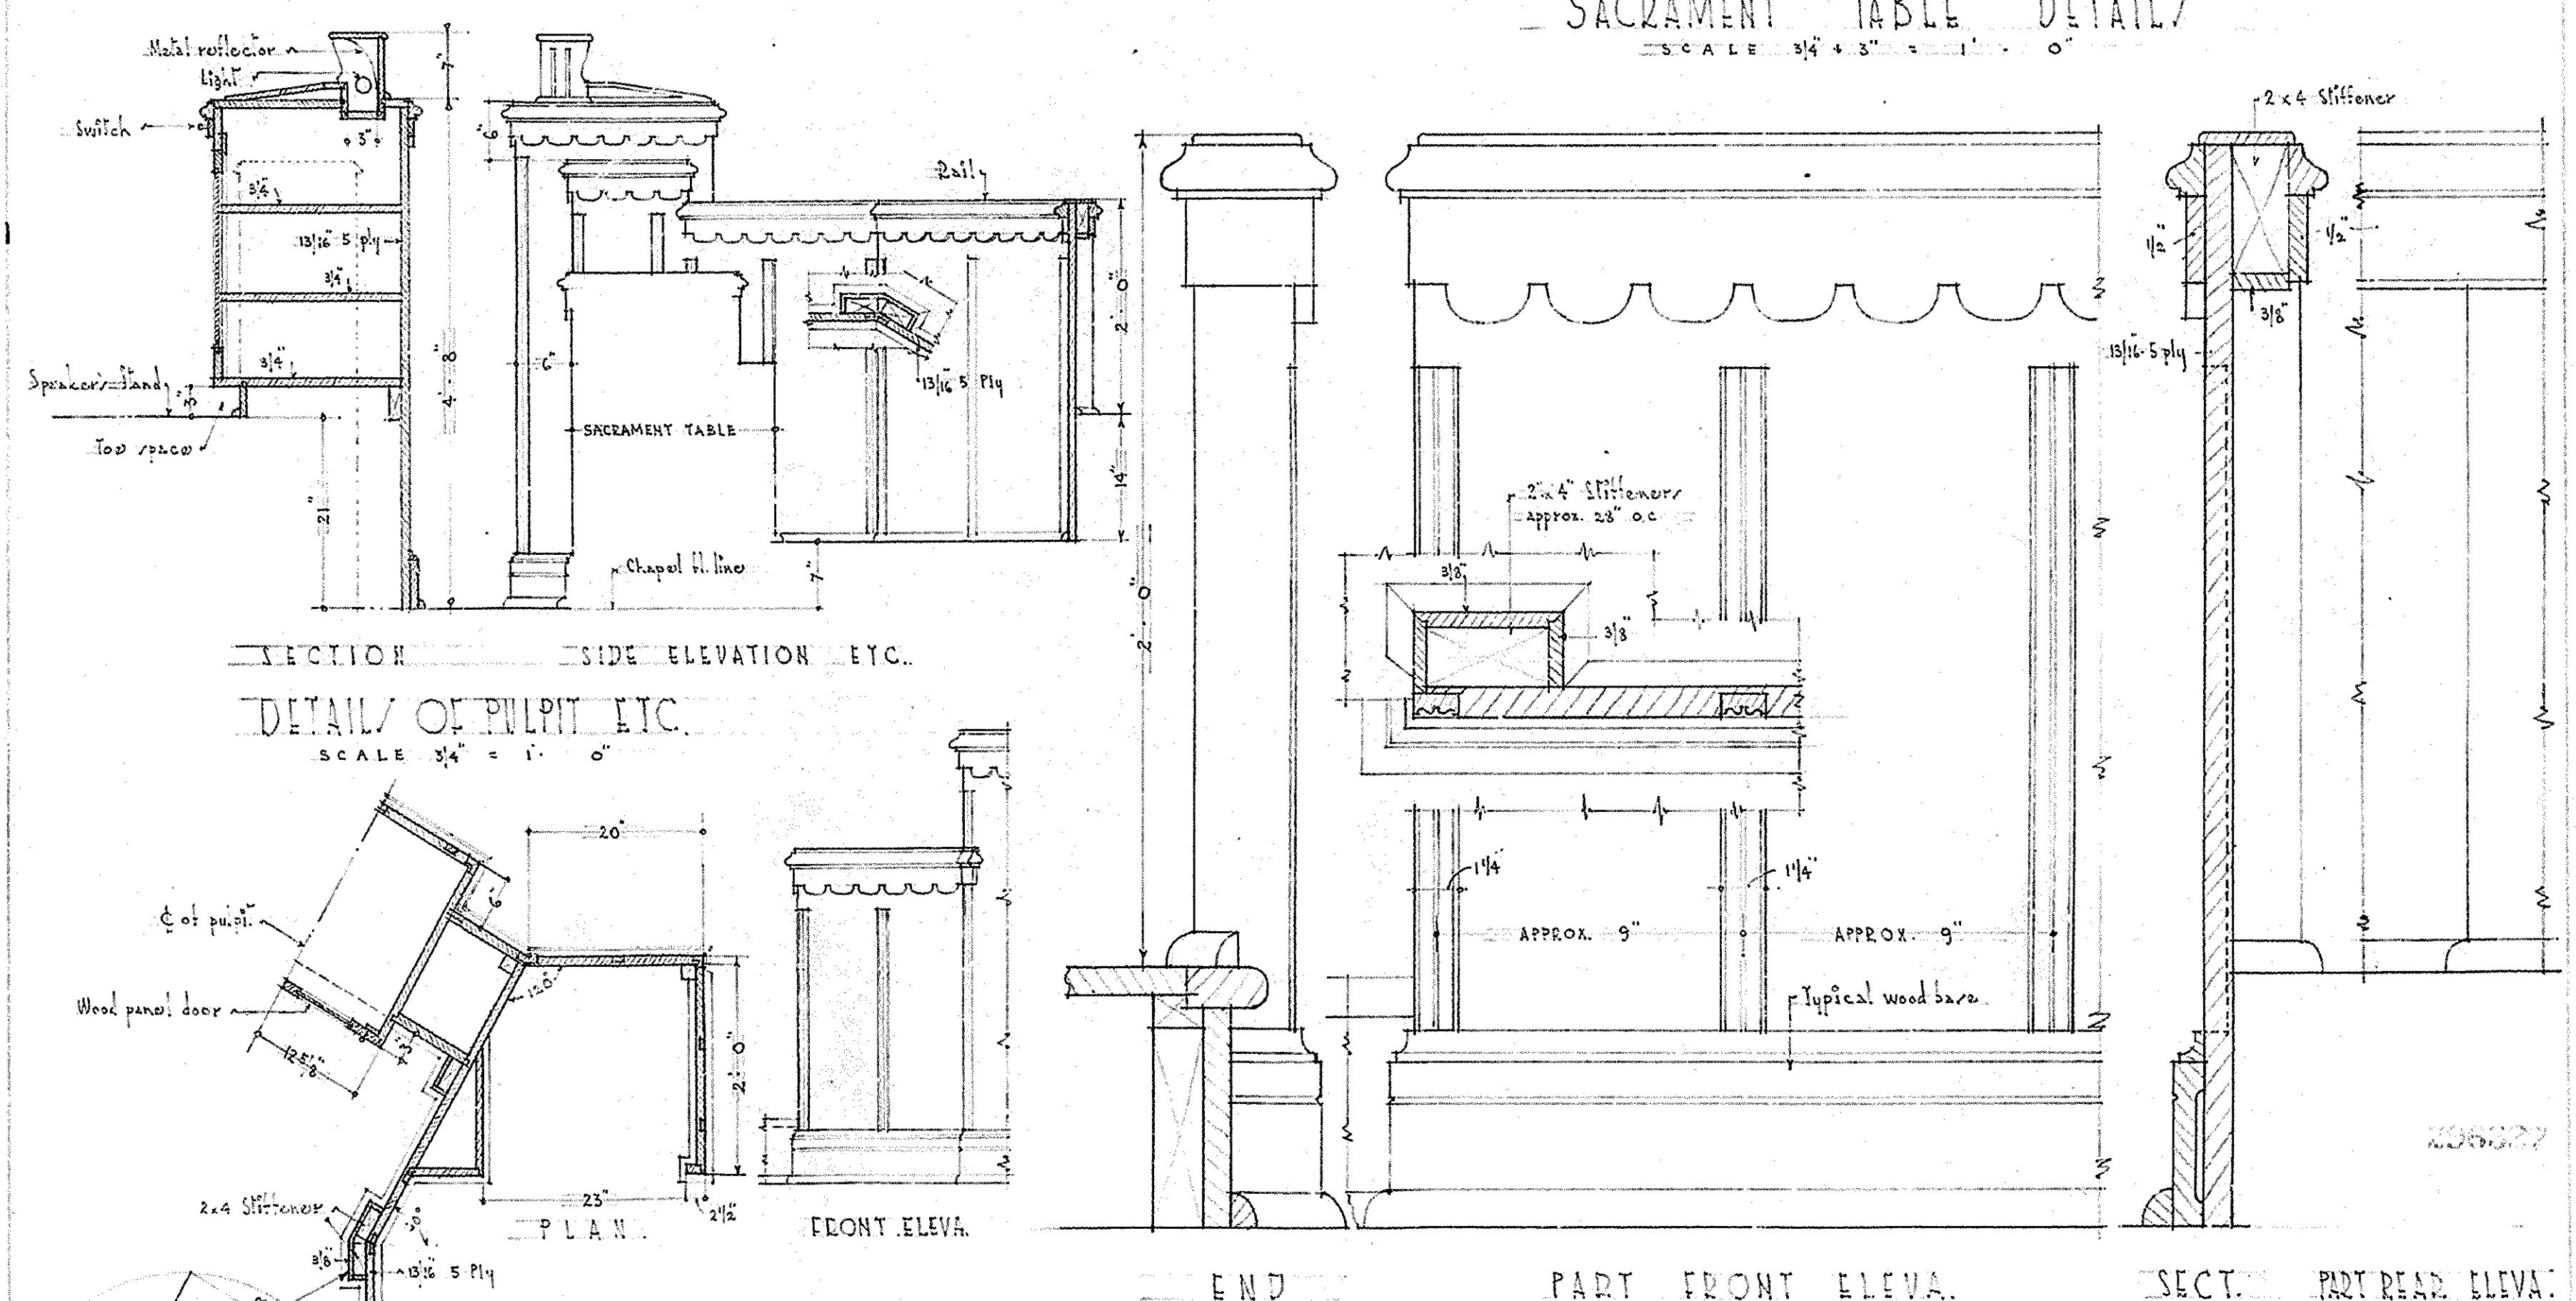

DETAILS OF CHURCH TABLE  
SCALE 3/4" = 1'-0"

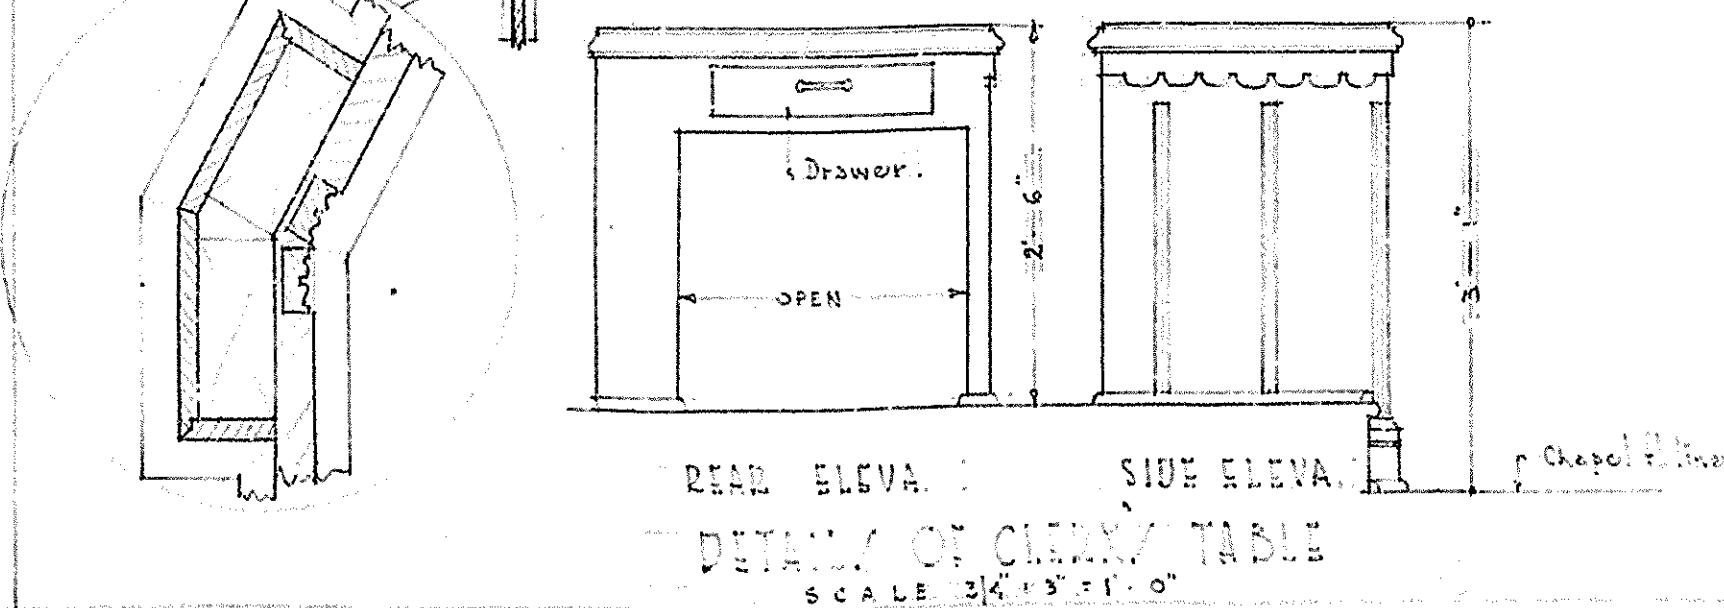

SCALE AS NOTED	JOB	DATE
	PULPIT DETAILS ETC.	12-7-33
DRAWN	MENAN	FILE
TRACED	L. D. S	IDAHO D. J.
CHECKED	CANNON & FLETZER ARCHT.	REVISED
	SALT LAKE CITY UTAH	

603

296327



16


12

12


16

20x



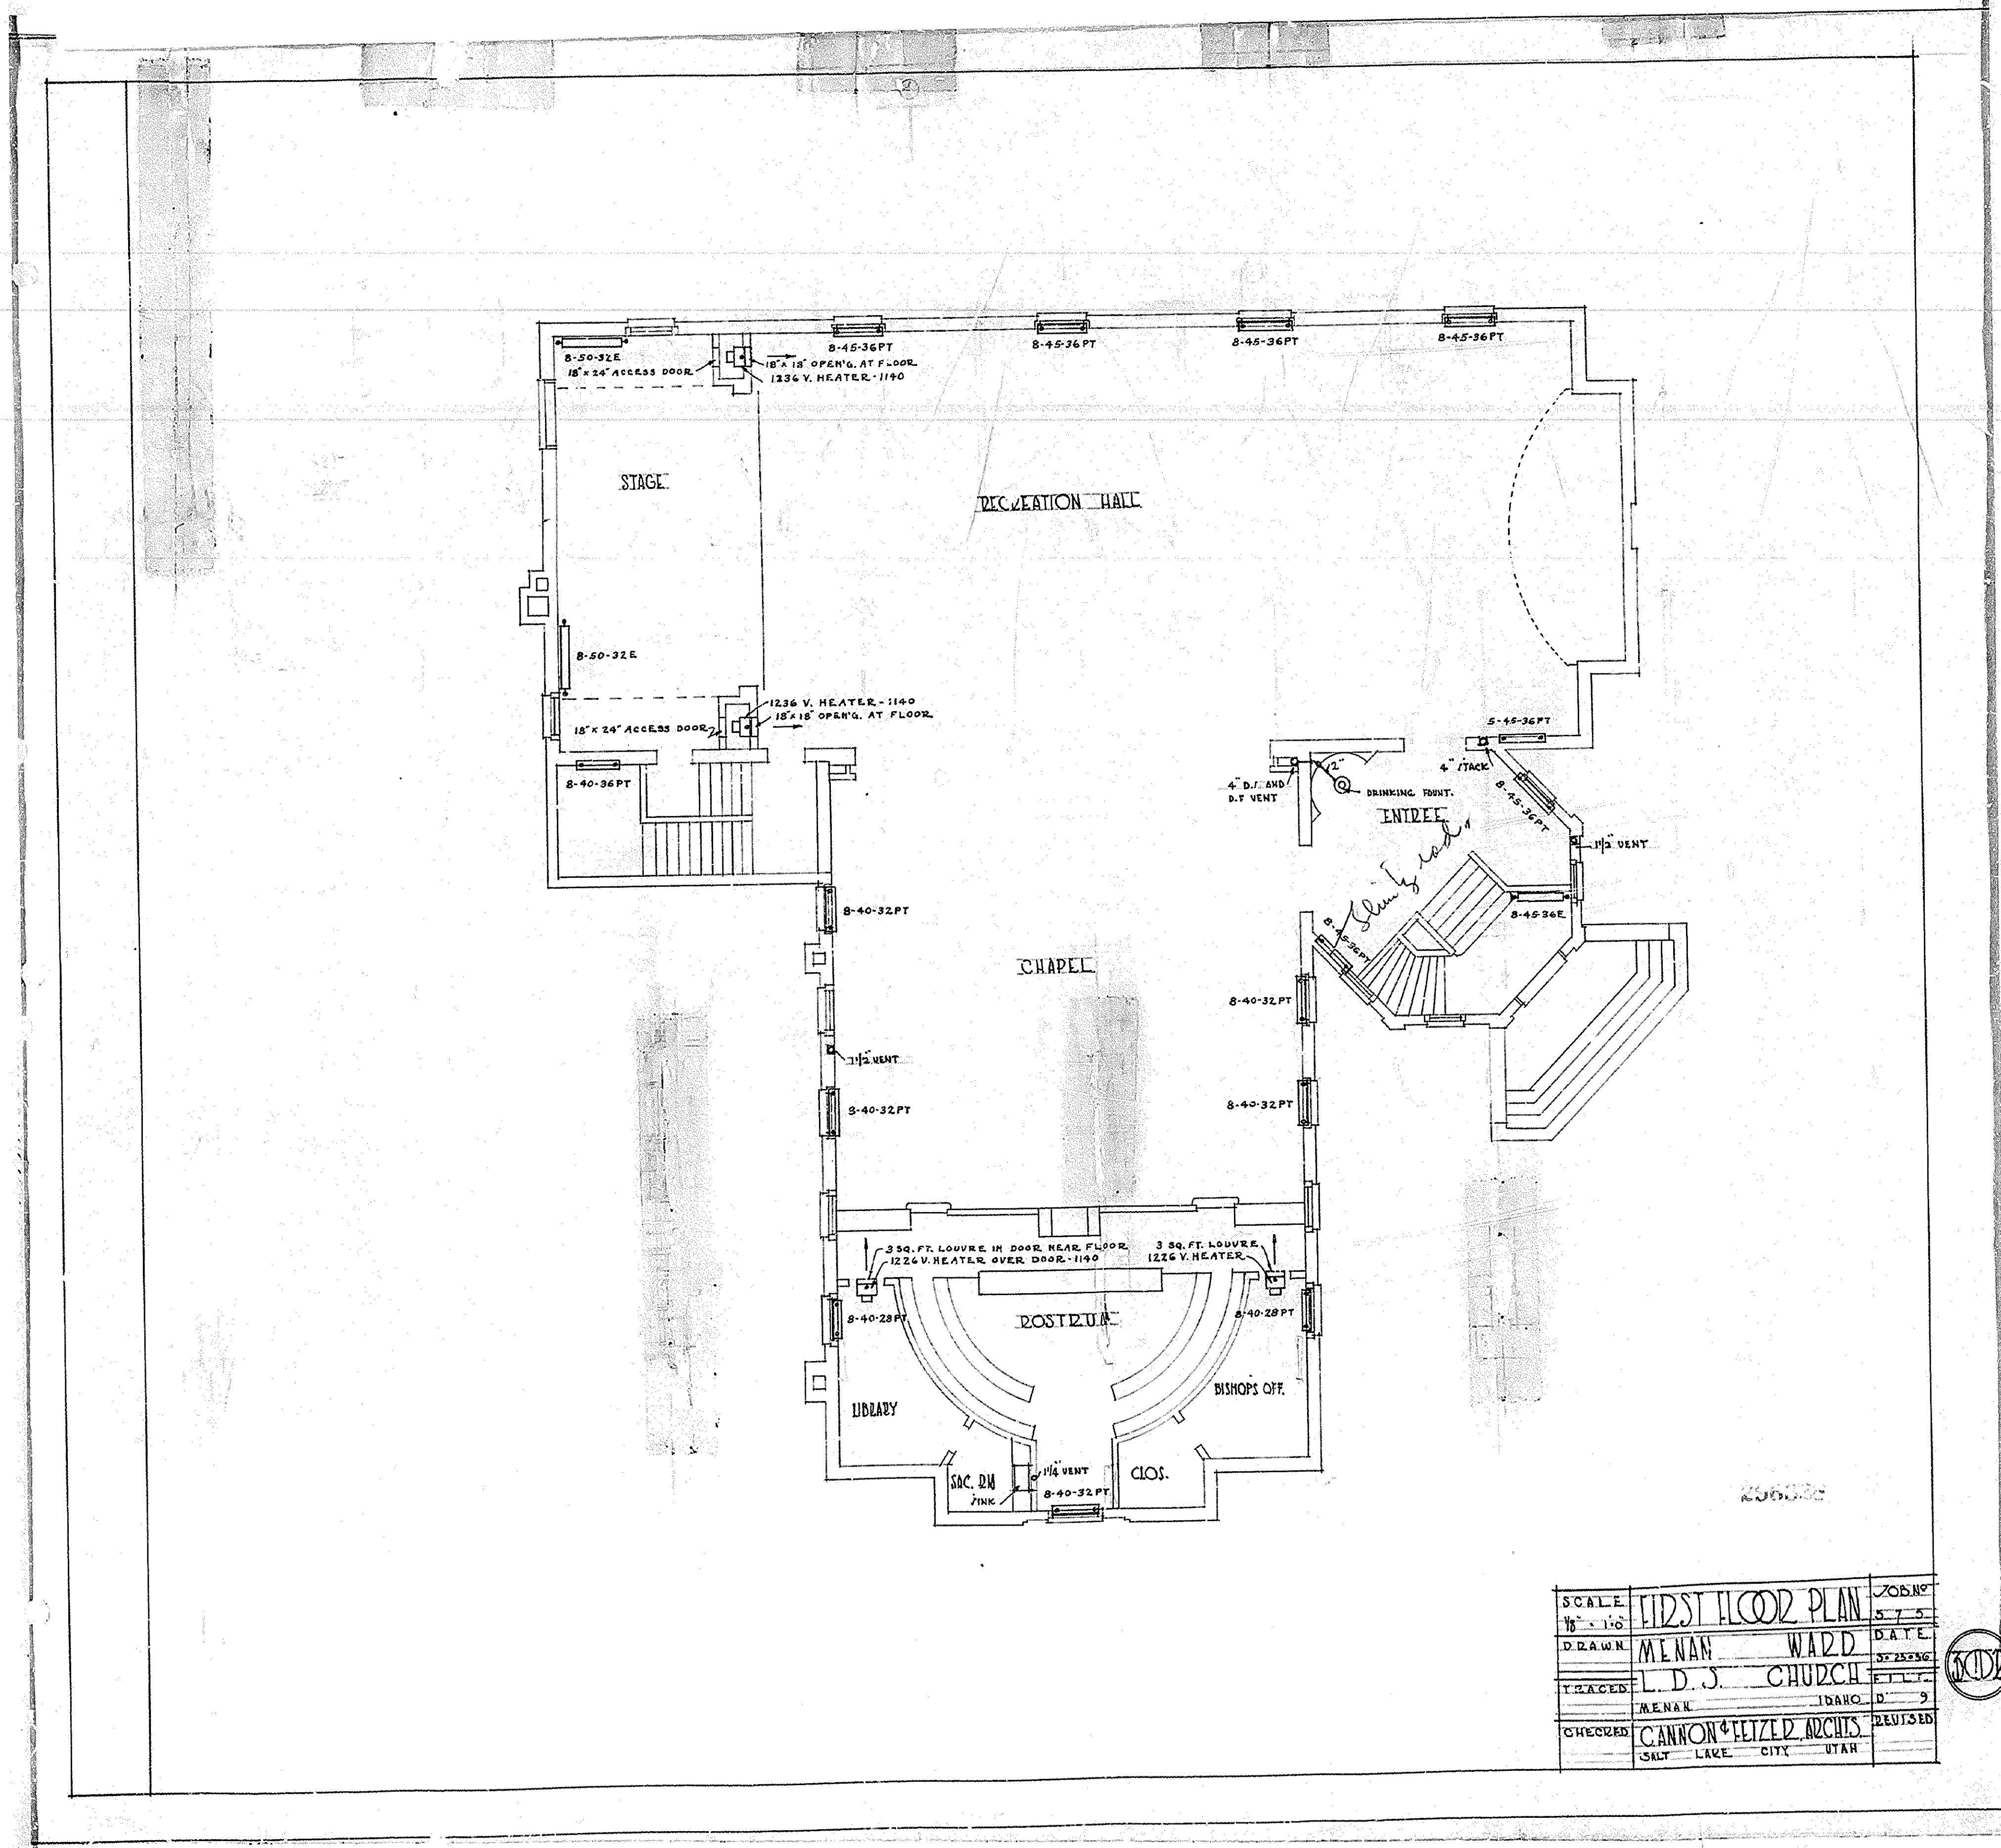

SCALE	FIRST FLOOR PLAN	JOB NO.
1/8" = 1'-0"		875
DRAWN	MENAN WARD	DATE
TRACES	L. D. J. CHURCH	BY 25296
CHECKED	MENAN IDARO	D' 9
	CANNON & FEITZ D. ARCHTS.	REVISER
	SALT LAKE CITY UTAH	

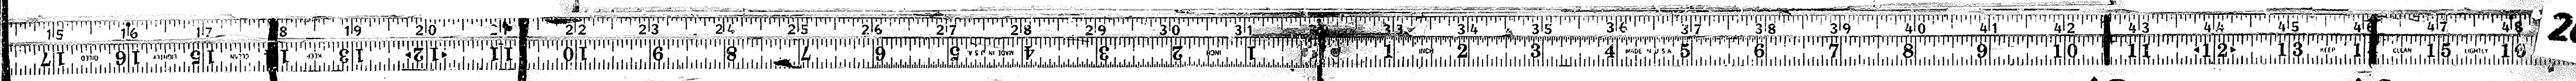

16


12

12

16

296728




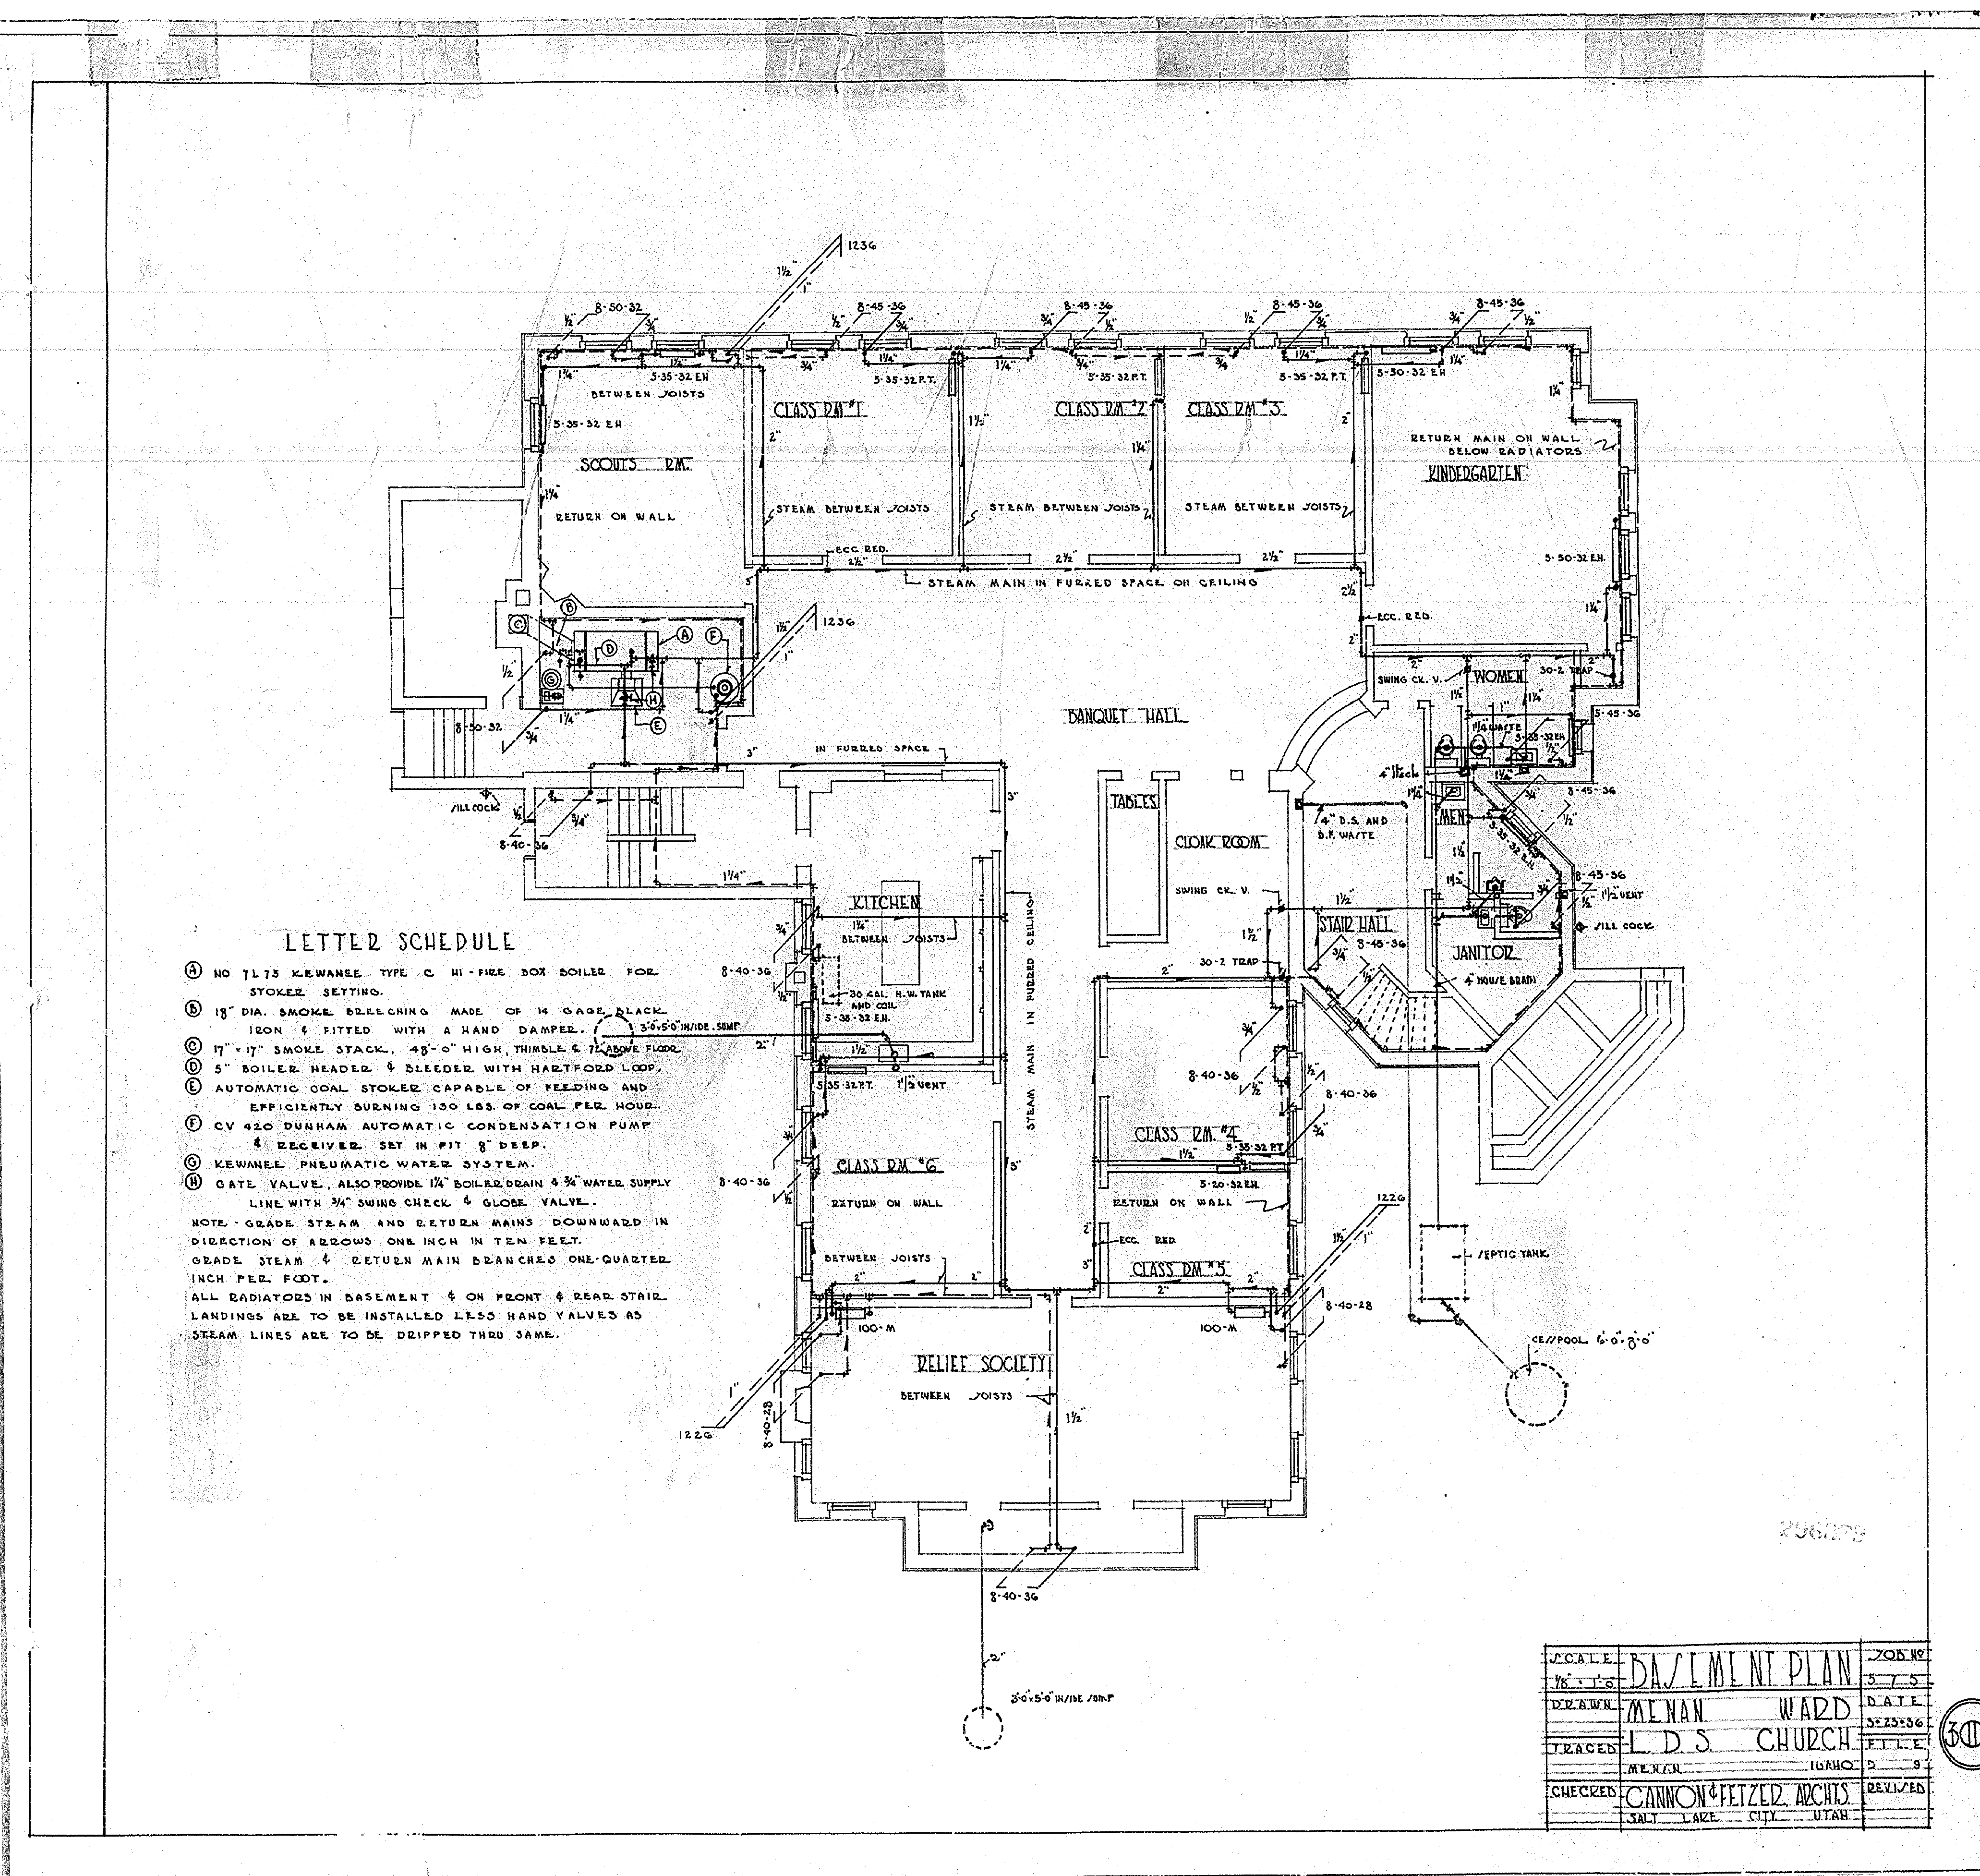


**LETTER SCHEDULE**

- (A) NO 1175 KEWANEE TYPE C HI-FIRE BOX BOILER FOR STOKER SETTING.
  - (B) 18" DIA. SMOKE BLEEDING MADE OF M GADE BLACK IRON & FITTED WITH A HAND DAMPER. 3'-5" 5/8" W/DIA. 5/8" MP.
  - (C) 17" x 17" SMOKE STACK, 48'-0" HIGH, THIMBLE & 7/8" ABOVE FLOOR.
  - (D) 5" BOILER HEADER & BLEEDER WITH HARTFORD LOOP.
  - (E) AUTOMATIC COAL STOKER CAPABLE OF FEEDING AND EFFICIENTLY BURNING 150 LBS. OF COAL PER HOUR.
  - (F) CV 420 DUNHAM AUTOMATIC CONDENSATION PUMP & RECEIVER SET IN PIT 8" DEEP.
  - (G) KEWANEE PNEUMATIC WATER SYSTEM.
  - (H) GATE VALVE, ALSO PROVIDE 1/4" BOILER DRAIN & 3/4" WATER SUPPLY LINE WITH 3/4" SWING CHECK & GLOBE VALVE.
- NOTE - GRADE STEAM AND RETURN MAINS DOWNWARD IN DIRECTION OF ARROWS ONE INCH IN TEN FEET.  
GRADE STEAM & RETURN MAIN BRANCHES ONE-QUARTER INCH PER FOOT.  
ALL RADIATORS IN BASEMENT & ON FRONT & REAR STAIR LANDINGS ARE TO BE INSTALLED LESS HAND VALVES AS STEAM LINES ARE TO BE DRIPPED THRU SAME.

SCALE	1/8" = 1'-0"	JOB NO.	575
DRAWN	MENAN	DATE	5-25-36
TITLES	L. D. S. CHURCH	FILE	
CHECKED	CANNON & FETZEL, ARCHTS.	REVIEWED	
	SALT LAKE CITY, UTAH		

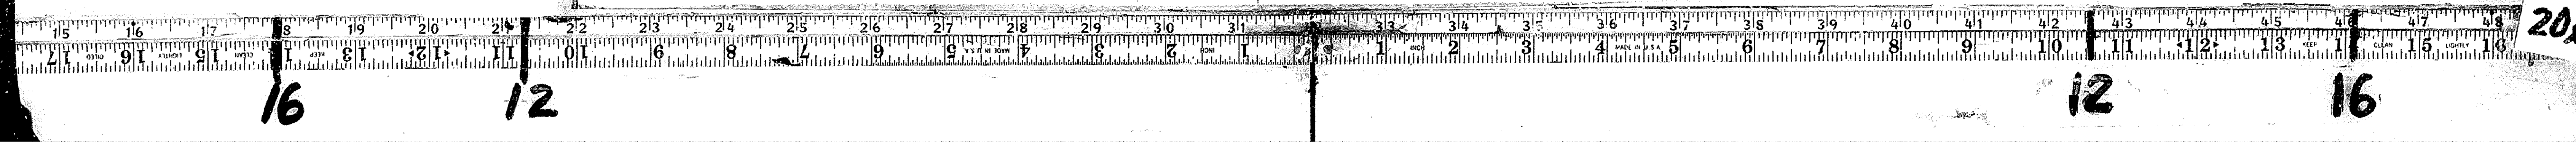




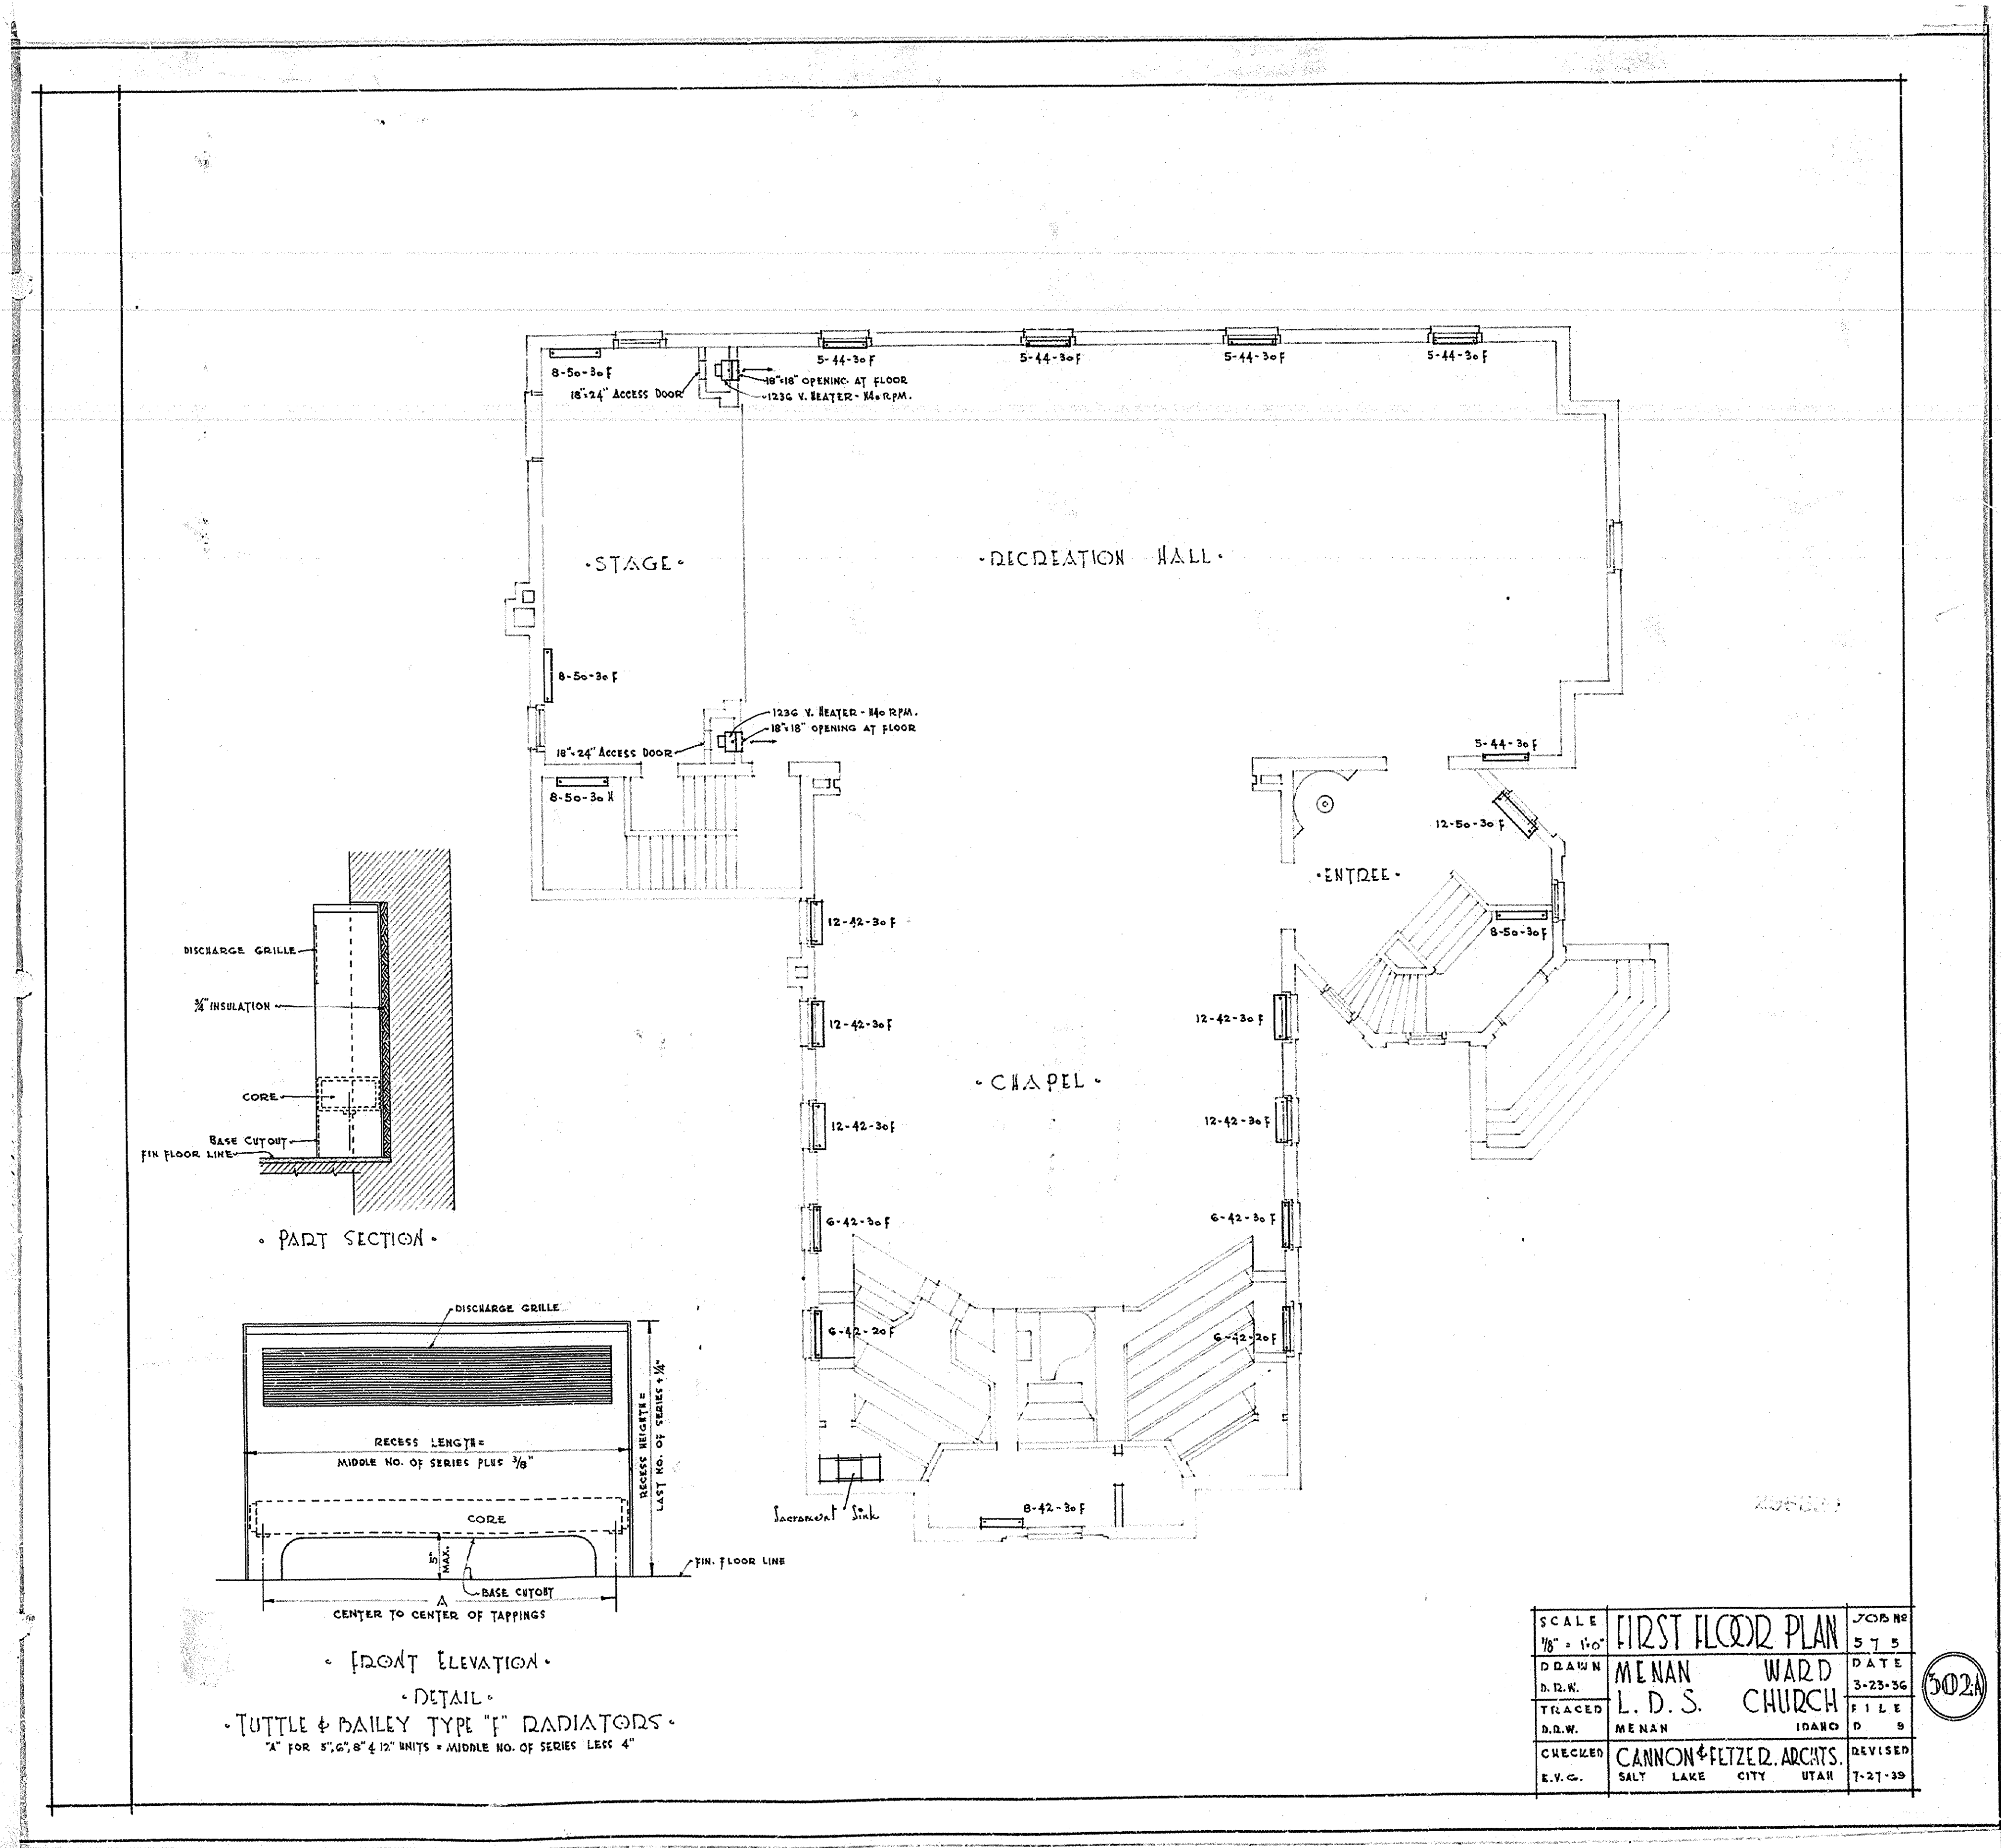

SCALE	FIRST FLOOR PLAN	JOB NO.
1/8" = 1'-0"		575
DRAWN	MENAN	DATE
D.R.W.	L. D. S.	3-23-36
TRACED	CHURCH	FILE
D.R.W.	MENAN	10ARD 0 9
CHECKED	CANNON & FETZER, ARCHTS.	REVISED
E.V.G.	SALT LAKE CITY UTAH	7-27-39

502A

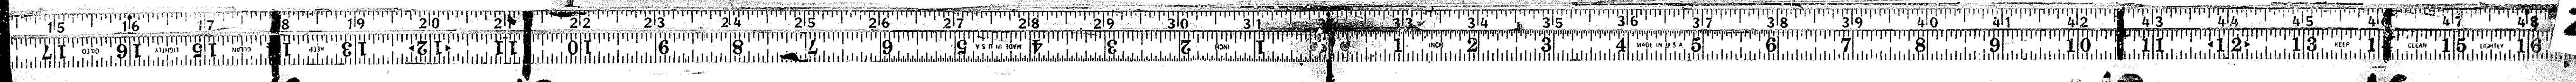


16

12

12


16



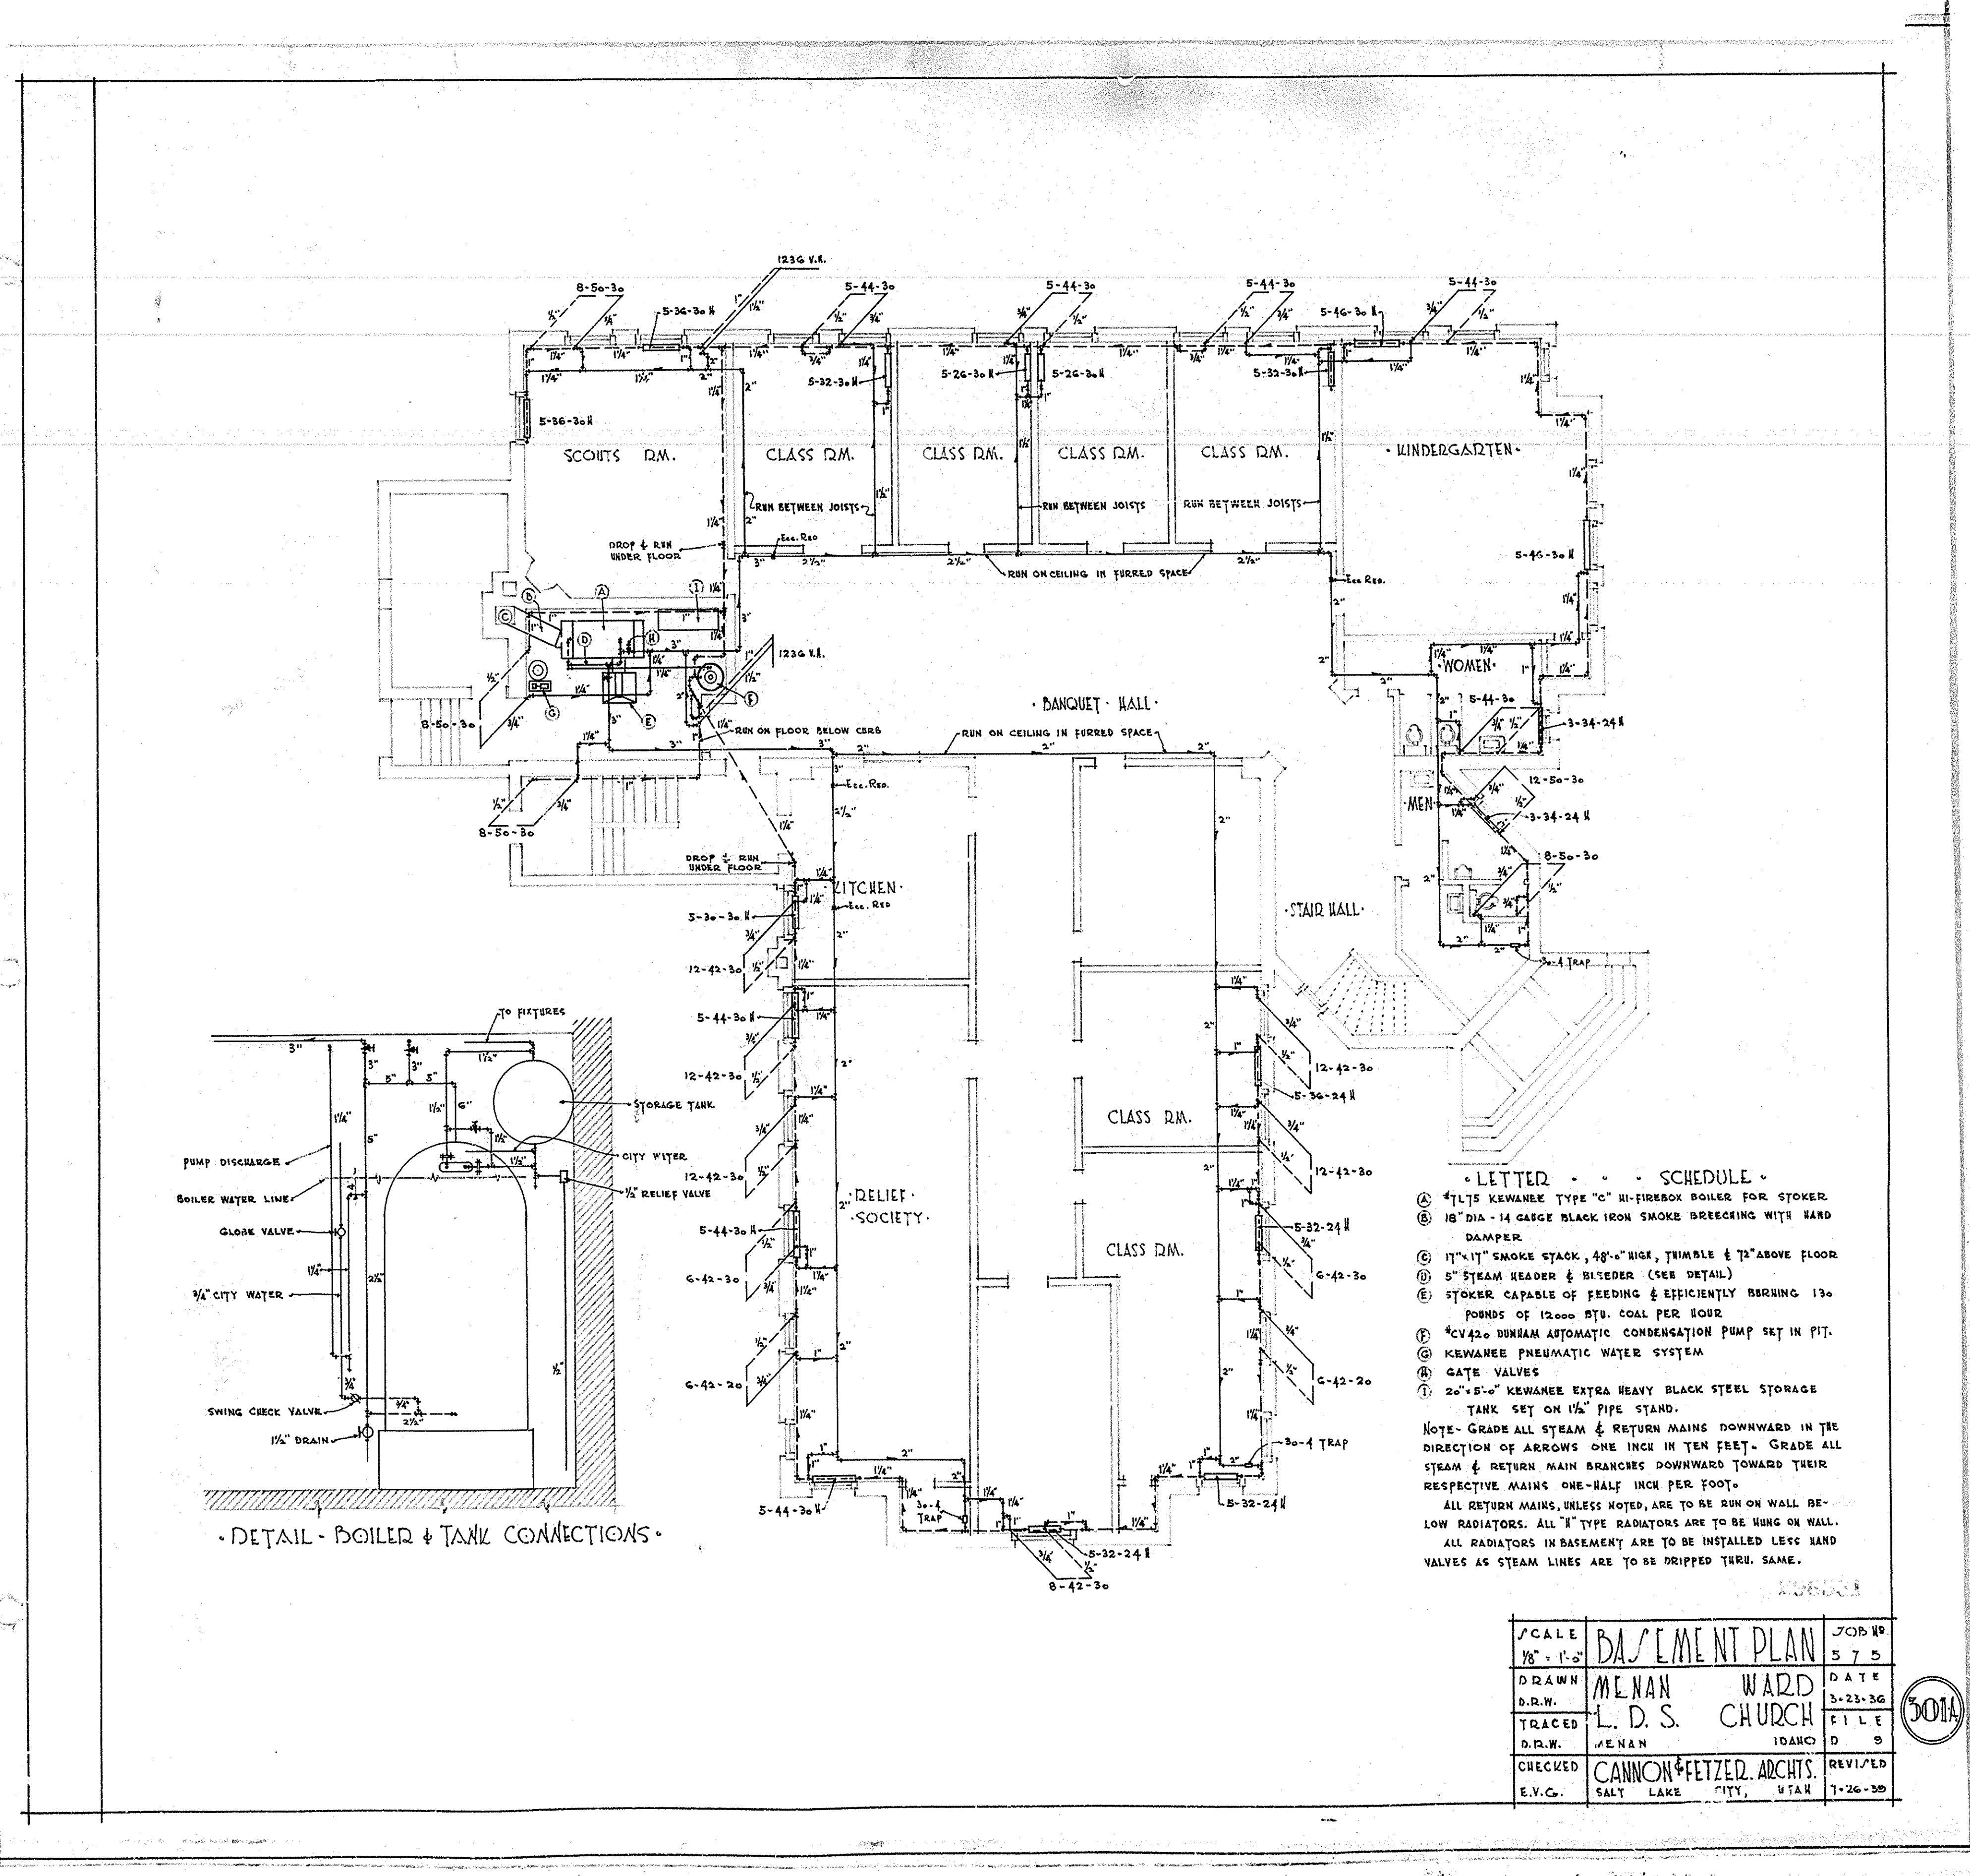

- LETTERED SCHEDULE
- (A) 47 1/2 KEWANEE TYPE "C" HI-FIREBOX BOILER FOR STOKER.
  - (B) 18" DIA - 14 GAGE BLACK IRON SMOKE BREECING WITH HAND DAMPER.
  - (C) 17" x 17" SMOKE STACK, 48'-0" HIGH, TERMINAL 6" ABOVE FLOOR.
  - (D) 6" STEAM HEADER & BRIDGER (SEE DETAIL).
  - (E) STOKER CAPABLE OF FEEDING & EFFICIENTLY BURNING 130 POUNDS OF 12000 BTU. COAL PER HOUR.
  - (F) 1/2" DIA DUNKAM AUTOMATIC CONDENSATION PUMP SET IN PIT.
  - (G) KEWANEE PNEUMATIC WATER SYSTEM.
  - (H) GATE VALVES.
  - (I) 20" x 5'-0" KEWANEE EXTRA HEAVY BLACK STEEL STORAGE TANK SET ON 1/2" PIPE STAND.
- NOTE - GRADE ALL STEAM & RETURN MAINS DOWNWARD IN THE DIRECTION OF ARROWS ONE INCH IN TEN FEET. GRADE ALL STEAM & RETURN MAIN BRANCHES DOWNWARD TOWARD THEIR RESPECTIVE MAINS ONE-HALF INCH PER FOOT.
- ALL RETURN MAINS, UNLESS NOTED, ARE TO BE RUN ON WALL BELOW RADIATORS. ALL "I" TYPE RADIATORS ARE TO BE HUNG ON WALL.
- ALL RADIATORS IN BASEMENT ARE TO BE INSTALLED LEFT HAND VALVES AS STEAM LINES ARE TO BE DRIPPED THRU. SAME.

SCALE	BASEMENT PLAN		JOB NO
1/8" = 1'-0"			575
DRAWN	MENAN	WARD	DATE
D.R.W.	L. D. S.	CHURCH	3-23-36
TRACED			FILE
D.R.W.	MENAN	IDAHO	D 9
CHECKED	CANNON & FETZED. ARCHTS.		REVISED
E.V.G.	SALT LAKE CITY, UTAH		7-26-36

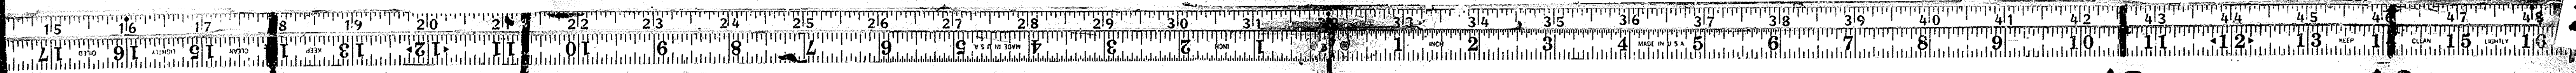

16

12


12

16

E E 9 B 2

20x



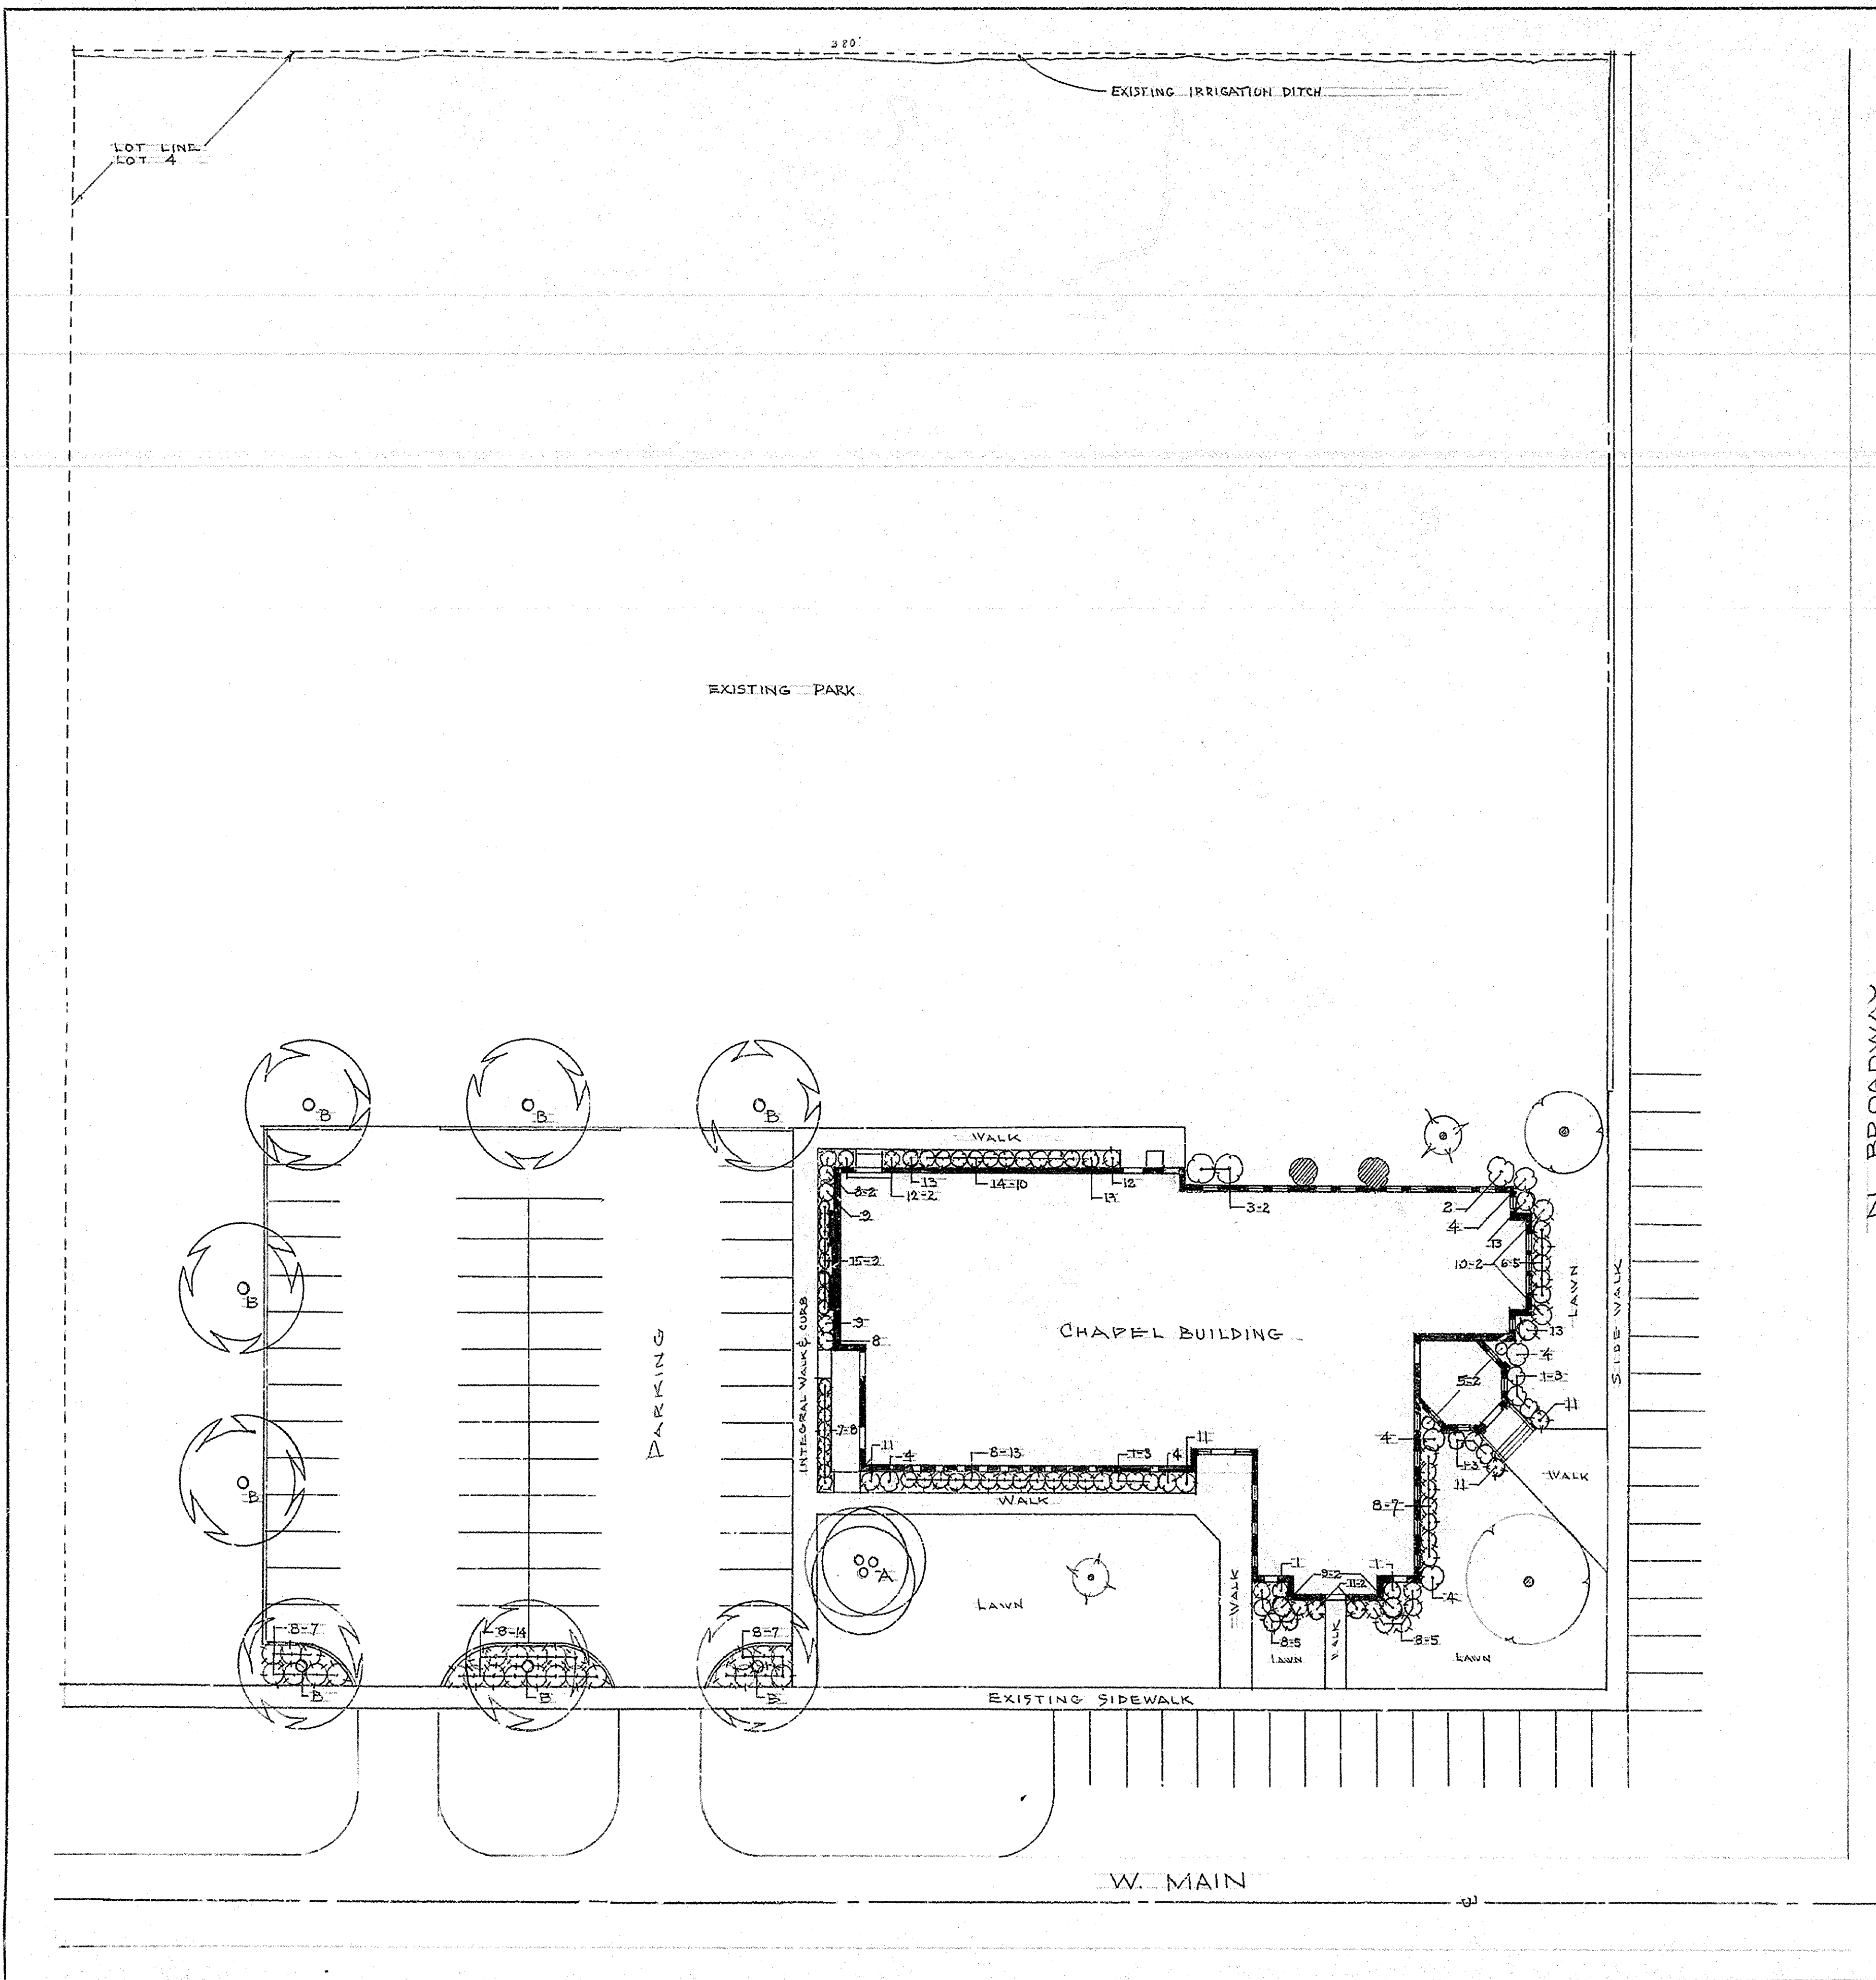


PLANT MATERIAL LIST

Key	Scientific Name	Common Name	Size	No. of Plants
<b>SHRUBS</b>				
1	<i>Berberis mentenensis</i>	Mentor Barberry	16-24"	6
2	<i>Cornus mas</i>	Cornelian Cherry	16-24"	1
3	<i>Cornus stolonifera</i>	Red Osier Dogwood	18-24"	2
4	<i>Euonymus alatus comp.</i>	Common Burningbush	6-8 ft	6
5	<i>Euonymus emeraldensis</i>	Em. Sp. Wintergreen	5-8 ft	6
6	<i>Juniperus chin. Armstrongii</i>	Armstrong Juniper	5-8 ft	5
7	<i>Juniperus horizontalis</i>	Prostrate Juniper	5-8 ft	8
8	<i>Juniperus sab. tamariscifolia</i>	Tam. mix Juniper	5-8 ft	61
9	<i>Juniperus scop. blue heaven</i>	Blue Heaven Juniper	6-8 ft	4
10	<i>Picea glauca albortiana</i>	Dwarf Albert Spruce	2-4'	2
11	<i>Pinus mugo mughus</i>	Dwarf Mugo Pine	5-8 ft	6
12	<i>Taxus media lucy</i>	Wicks Yew	5-8 ft	2
13	<i>Taxus repandens</i>	Spreading Yew	5-8 ft	4
14	<i>Symphoricarpos albus</i>	Snowberry	2-5'	10
15	<i>Ligustrum vulgatum</i>	Leucase Privet	10-24"	10
<b>TREES</b>				
A	<i>Betula pendula (clump)</i>	European White Birch	6-8'	1
B	<i>Fraxinus penn. lanceolata</i>	Mass. Shally Seedless Ash	10-12'	0

**LEGEND**

- = Deciduous Shrubs
- = Evergreen Shrubs
- ⊙ = Clump White Birch
- ⊗ = Existing Trees (In Retention)
- ⊘ = Deciduous Trees

Approx. LAWN area 10,000 sq ft

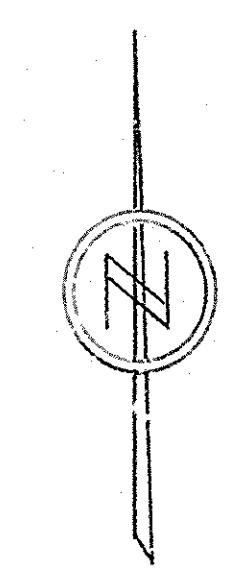

269889  
507-2688

DATE: \_\_\_\_\_

REVISIONS: \_\_\_\_\_

APPROVED: \_\_\_\_\_

DESIGNED BY: \_\_\_\_\_

CHECKED BY: \_\_\_\_\_

DATE: \_\_\_\_\_

SCALE: 1" = 20'

SHEET NO. \_\_\_\_\_

PROJECT: MENAN ST & 2ND WARD'S RIGBY STAKE

CLIENT: THE CHURCH OF JESUS CHRIST OF LATTER-DAY SAINTS  
OFFICE OF THE BUILDING COMMITTEE  
ARCHITECTURAL & ENGINEERING DEPARTMENT  
128 NORTH MAIN STREET

DRAWN BY: L.C.O. 7-10-72



PLANT MATERIAL LIST

SPRINKLING SYSTEM NOTES

1. All pipe and fittings in this system shall be prime galvanized steel. (American Made)
2. Contractor shall grade all sprinkler lines to low points and install a minimum of Mueller H11007 brass drain cocks to insure and guarantee complete drainage of entire system. The Mueller brass drain cocks should be located as close as possible to valves. The Contractor shall provide an 18" x 18" drain sump for each drain cock, the top of which is six inches below finished grade. Drain cocks shall be enclosed in a 1 1/2" pipe sleeve. Where a manual drain valve is not practical, use Thompson #442 automatic drain valve.
3. All valves should be located as close as possible to sidewalk.
4. Sprinkler lines for building perimeter are to be located six inches from the foundation wall with the sprinkler heads at ground level.
5. This system was designed for 40# P.S.I. static pressure.
6. Enclose all valves in 2" diameter pipe sleeves.
7. This drawing is a schematic only, and is intended to convey the idea of full coverage of the sprinkler system. The Contractor shall make any adjustments necessary to provide complete coverage of all areas at no additional cost to the Owner.

SPRINKLING LEGEND

SYMBOL	DESCRIPTION
X	Model: 171P Rainbird full-circle pop-up sprinkler head or approved equal. 4.0 G.P.M. 12 1/2' radius.
V	Model: 171H Rainbird half-circle pop-up sprinkler head or approved equal. 2.0 G.P.M. 12 1/2' radius.
⊙	Model: 171Q Rainbird quarter-circle pop-up sprinkler head or approved equal. 1.2 G.P.M. 17 1/2' radius.
⊖	Model: 2200F Rainbird full-circle flower bubbler or approved equal. 1.5 G.P.M. 8' diameter
⊖	Model: 2200H Rainbird half-circle flower bubbler or approved equal. 1.1 G.P.M. 4' radius.
⊕	No. 440 Thompson 3/4" brass angle valve or approved equal.
⊕	No. 440 Thompson 1" brass angle valve or approved equal.
⊕	No. 440 Thompson 1 1/4" brass angle valve or approved equal.
⊕	No. 440 Thompson 1 1/2" brass angle valve or approved equal.
⊕	No. 440 Thompson 2" brass angle valve or approved equal.
⊕	No. J227 Minnesota pattern ( ) James Jones service pipe curb stop or approved equal.

REVISIONS  
 1. 5/21/20  
 2. 5/21/20  
 3. 5/21/20  
MENAN WARDS 1ST & 2ND  
 RIGBY STAKE



THE CHURCH OF JESUS CHRIST OF LATTER-DAY SAINTS  
 OFFICE OF THE BUILDING COMMITTEE  
 125 NORTH MAIN STREET  
 SALT LAKE CITY, UTAH

DESIGNED BY  
 L. C. O.

SHEET TITLE  
 SPRINKLER SYSTEM PLAN  
 SCALE: 1/4" = 1'-0"

SHEET NO.

268709  
507-2638

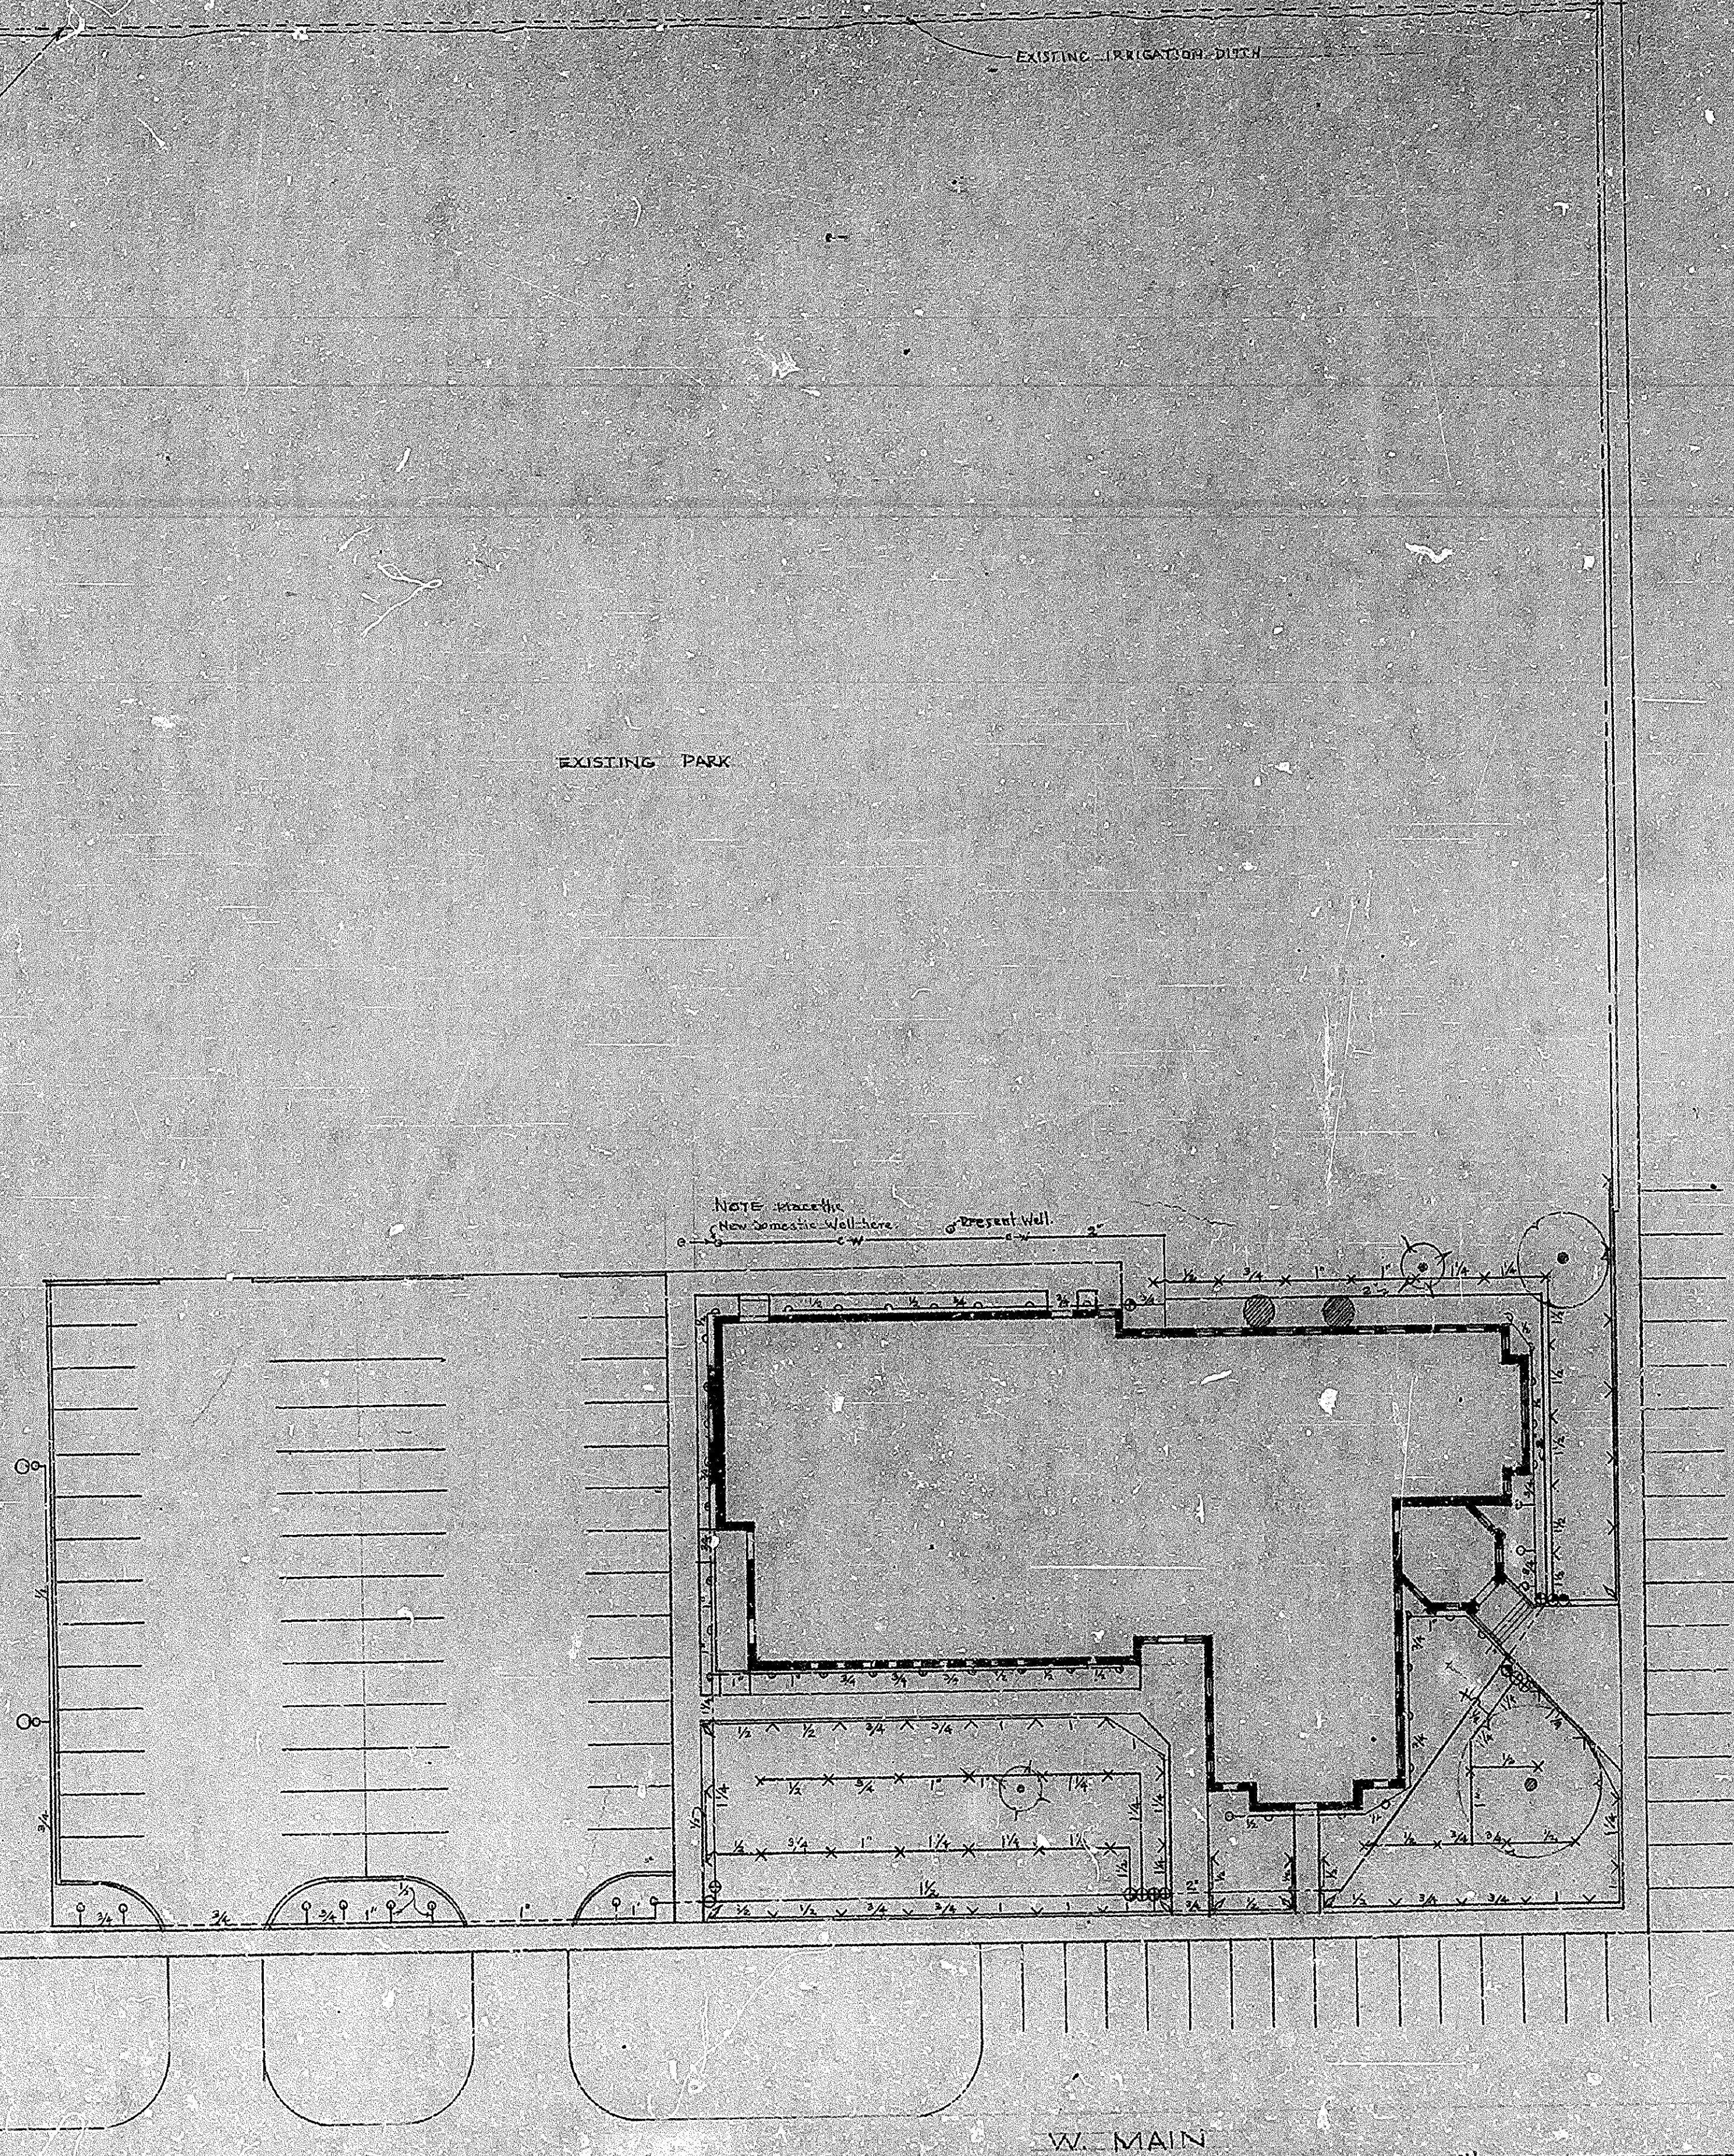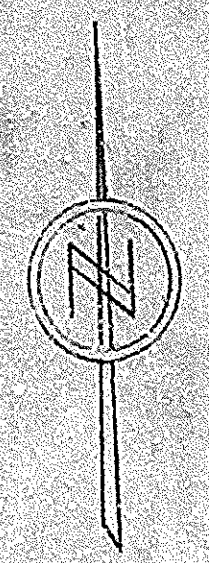



		PF-19 / AC-21 & INVOICES . . . . .
A		FINAL REPORT . . . . .
S		
B		CONSULTANT'S AGREEMENT AND . . . .
E		INSURANCE CERTIFICATE
S		
T		CONTRACTOR'S INSURANCE CERT... . .
O		
S		CONTRACTOR'S BONDS . . . . .
A		CONTRACTOR'S CONTRACT . . . . .
B		
A		BID TABULATION . . . . .
T		
E		
M		ABATEMENT SPECIFICATIONS . . . . .
E		
N		SURVEY AND ASSESSMENT . . . . .
T		
		MISCELLANEOUS . . . . .

```

*****
* STAKE: MENAN ID          PROPERTY #: 507-2638 *
*-----*
* MENAN 1, 2                *
* 205 N BROADWAY            *
* MENAN, IDAHO              *
*****

```

DATE ENTERED IN COMPUTER: 08/15/88  
(MARK IN RED)

*✓ FOR FILE READY  
(GP. PLAN APPROVALS)*



507 2638  
MENAN 1 2  
205 N BROADWAY  
MENAN JEFFERSON IDAHO  
Stake/miss MENAN ID

Sq Ft 17 112 Teaching Stations 22  
Meetinghouse type 1 MEETINGHOUSE  
Completed ??/37 Addition Comp 08/71  
Region 2 APR# 2205 Alan Palmer

\*\*\*\*\*

PLANS SECTION

Do we have a plan? Source of plan Condition of plan  
Have we made and distributed reduced copies  
\*\*\*\*\*

SURVEY SECTION

Survey Consultant Snake River Associates Is this a survey of all the building friable and non friable? yes  
Name of Surveyor Jim Farely If no explain

Survey NTP 11/11/11 Survey Received 10/20/87 Number of Samples Taken? 8 ACM Found? yes  
Date of Survey 10/10/87 Date Reviewed 08/15/88

DESCRIPTION OF ABSBESTOS FOUND TO WAS

- |  | FRIABLE? REMOVE? | TO | WAS |
|--|------------------|----|-----|
| 1 BOILER ROOM 67 FITTINGS 3 SFT DUCT CLOTH         | Y                | Y  | Y   |
| 2 NORTHEAST RM 360 SFT FLOOR TILE (2 3%)           | N                | Y  | Y   |
| 3 TUNNEL 53 JOINTS                                 | Y                | Y  | Y   |
| 4 BASEMENT ROOMS 8' AIRCELL PIPE INSULATION        | Y                | Y  | Y   |
| 5 SOUTHEAST ROOM 7 FITTINGS                        | Y                | Y  | Y   |
| 6 CLERK S OFFICE 120 SFT LINOLEUM                  | Y                | Y  | Y   |
| 7 UPPER FAN RM (SEE FINAL REPORT PG 2) 33 FITTINGS | Y                | Y  | Y   |
| 8  |                  |    |     |
| 9  |                  |    |     |
| 10   |                  |    |     |
| 11   |                  |    |     |
| 12   |                  |    |     |
| 13   |                  |    |     |

\*\*\*\*\*

PF 19 BUDGET FORM

CONSULTANT'S BUDGET		CONTRACTOR'S BUDGET	
Pf 19# 051846	SURVEY COST 779 00	CONTRACTOR COSTS	7 871 00
AC 21# 507 2638 75	BID PREP COST	CONTRACTOR CO #1	
	PROJECT SUPERVISION 1 652 00	CONTRACTOR CO #2	
	FINAL REPORT	CONTRACTOR CO #3	
SLC Code	CONSULTANT CO #1		
	CONSULTANT CO #2		
	CONSULTANT CO #3		
	TOTAL CONSULTANT 2 431 00	TOTAL CONSTRUCTION COSTS	7 871 00

\*\*\*\*\*  
CONSULTANTS' EST TO TOTAL PROJECT COSTS 10 302 00  
\*\*\*\*\*

BID AND SPECIFICATION SECTION

Project Consultant Snake River Associates Prep Bid Doc NTP 11/11/11  
Name of Bid Specs Abatement Contractor WATERS INSULATION & SUP Pre Bid Mtg Date 12/10/87  
Project Grouping Code Projected Start 10/07/88  
Projected Finish 10/10/88  
\*\*\*\*\*

FILE STORAGE SECTION

Contractors Contract Executed Checked and in file 08/15/88  
Contractors Insur Certificates & Bonds Checked and in file  
Consultants Contract & Insur Certificate Checked and in file 08/15/88  
Project Manual (Abatement Documents and Spec ) in file

Has all ACM in survey been removed? yes Has "Removed?" column in Survey Section been updated? yes

\*\*\*\*\*  
Final Report Received 12/08/87 Checked against checklist Did it Pass  
\*\*\*\*\*

SURVEY	SPECS	CONTRACT	BONDS & INSUR	CERT	CONSULTANT CONT	FINAL REPORT
10/20/87			08/15/88		08/15/88	12/08/87



THE CHURCH of  
JESUS CHRIST  
of MATTERDAY  
SAINTS

REQUEST TO THE APPROPRIATIONS COMMITTEE  
BUILDING PROJECT REVIEW FORM U S A

Request For CONSTRUCTION BUDGET      Project Number 507-7638-75      1      Page Number EC - 2  
 FN

Date 07/21/87

If Owned Present Facilities Are To Be ADDED TO

MAIN STREET

MENAN INAND STAKE

MENAN 1 & 2 WARDS

City MENAN      County      State/Country IDAHO      Membership 378/360      Meetings Attendance 159/231      5 Year Plan On File YES

Stake/Mission President LYLE DEAN TAYLOR      Address RT 1, BOX 108 WEST RIGBY ID 83442

Type of Project ABR VESTIBULES, REMODEL INTERIOR (SP-2240)      Total S F 18312      Assembly Seatings 350      Teaching Areas 22  
 Square Footage Original Bids 17112      New 1200      Contractor O K CONSTRUCTION      No of Bidders 6(6)

TOTAL PROJECT COSTING      NON-STRUCTURE ITEMS INCL IN TOTAL PROJ COST

Local Estimated	Local Actual	U S Actual	Local Estimated	Local Actual	U S Actual
Base Bid 90,368	459,449		Tot Proj Cost 610,525	Local Actual 557,766	U S Actual 557,766
On Site Impr 32,825	15,000	15,000	Non-Structure 519,887	Local Actual 470,644	U S Actual 470,644
Off Site Impr 15,000	17,250	14,011	Net Structure 90,638	Local Actual 87,122	U S Actual 87,122
Furnish by Don 17,250	373,495	333,100	Unit Cost - SF 1,200	Local Actual 1,200	U S Actual 1,200
Landscaping 17,250			Cost / SF 75 53	Local Actual 72 60	U S Actual 72 60
Repairs/Repl 373,495			L19 Damages \$150/DAY	Local Actual \$150/DAY	U S Actual \$150/DAY
			: Contract Days 450	Local Actual 170	U S Actual 170
ASBESTOS 30,000	30,000	30,000	R E Purch Acres	Local Actual Acres	U S Actual Acres
Landscap Arch 1,600	1,600	1,600	To Be Sold Acres	Local Actual Acres	U S Actual Acres
Eng /Cons Fee 10,317	10,317	10,317	Site Cost A&R Acres	Local Actual Acres	U S Actual Acres
Architects Fee 39,400	41,400	41,400	Local Use Fee %	Local Actual %	U S Actual %
TOT PROJ COST 610,525	557,766	557,766	Architects Fee 39,400	Local Actual 41,400	U S Actual 41,400
			TOT NON-STRUCT 519,887	Local Actual 470,644	U S Actual 470,644
			7 5 % Of \$ 527,977	Local Actual 7 5 % Of \$ 527,977	U S Actual 7 5 % Of \$ 527,977

Total Cost Exc Site 557,766  
 Site A&R Acres Cost 557,766  
 TOTAL COST INCL SITE 557,766  
 Site Use Fee Paid

Appropriations To Date 39,400  
 This Request 518,366  
 Project Cost 557,766  
 Contingency 10% 55,777  
 Total Proj + Cont 613,543  
 Church Share 96% 589,001  
 : Local Share 4% 24,542

APPROVED

JUL 21 1987

Monetary 01      Contingency Rate 10%      Transaction Type 400 Unit & Cost  
 Minute No 87 80641      Checked By RON LOVELAND      Reviewed for FOD by MARY HARDING

APPROPRIATIONS COMMITTEE

PRESENT FACILITIES ERECTED 1938, ADDED TO IN 1971  
 REPAIRS/REPL ATTIC INSULATION, PAINTING, REMODEL CHAPEL, WINDOWS, REROOF, OVERBUILD FLAT ROOF, WATERPROOF FOUNDATION,  
 MECHANICAL & ELECTRICAL  
 ENGINEERING FEE TOP/O/BOUNDARY \$2,300, TESTING \$2,500, PRINTING \$1,800, REVIEWS \$617, SOUND \$2,000, MISC \$1,100  
 (A) GANCE \$470,644 CONSTRUCTION \$87,122







RECEIVED

Department of Physical Facilities  
50 East North Temple Street  
Salt Lake City, Utah 84150  
Phone (801) 531-2531

051846

NOV 14 1987

Read instructions on reverse side. Do not fill in shaded areas. Print RT type information.

State/District (name in full)  
**Menan Idaho Slake**

Building (wards/branches using building)  
**Menan I & Menan II**

Mission (name in full if project is for a district)

State/District unit number  
**0513024**

Date **Oct 1 87**

Labor used for project  
 Contract  Donated

Local share of cost is on hand.  
 Yes  No

Participation ratio  
% Church  % local

Deduct local share from PF-90 check

Project information Inspection checklist code*	Repairs - Minor remodeling - Landscaping (include description of materials and labor identification - itemization, etc.)	Amount of bid or delivered price	Code	Amount
	<i>Request a Agreement</i>			
	<i>Subway</i>	<i>2638.00</i>		
	<i>Watered asbestos</i>	<i>787</i>		
		<i>10,509.00</i>		
	<i>This work is completed with chad</i>			

Physical Facilities representative  
*Clyde R. Jones*

Project completed Inspected and accepted by

State/District president  
*Fred A. Olyan*

Contractor's license number

Mission president (when required)

Contractor's Federal Employer's ID number

**For Headquarters or Area Office Use Only**

Area operations and maintenance representative  
*Keith Baker*

Risk management copy forwarded (date)

Operations and Maintenance area manager

PFAC approval Date

Minute no.


Detail (property) number  
**5072638**

**The funds approved are to be used only for the above.**

Override  Payee  Ratio

Attachments  Bids  Loss report  Other  Invoices

Check no. Amount \$

Pay to 

**APPROVED**  
*11-16-87*  
DATE  
**PHYSICAL FACILITIES**

Audited by Date Approved by



\*\*\*\*\*  
 \* PAYMENT HISTORY FOR PROPERTY # 507 2638 \*  
 \* STAKE NAME MENAN ID \*  
 \* PROPERTY NAME MENAN 1 2 \*  
 \* PF 19# 51846 AC 21# 507 2638 75 \*  
 \* SLC CODE \*  
 \*\*\*\*\*

\*\*\*\*\* REVIEW OF CONSULTANT COSTS \*\*\*\*\*

SURVEY (Acc # 10)

=====

VENDOR	DESCRIPTION	INVOICE #	INV DATE	POST DATE	INV AMOUNT	MLTPL
SNAKE RIVER & ASSOCIATES	SURVEY	SR87 161	10/30/87	08/15/88	778 20	no

SURVEY	Balance	778 20
SURVEY	Budget	779 00
	% of Budget	100%

PROJECT S (Acc # 12)

=====

VENDOR	DESCRIPTION	INVOICE #	INV DATE	POST DATE	INV AMOUNT	MLTPL
SNAKE RIVER & ASSOCIATES	SUPERVISION	SR87 162	10/30/87	08/15/88	1 651 36	no

PROJECT S	Balance	1 651 36
PROJECT S	Budget	1 652 00
	% of Budget	100%

\*\*\*\*\*  
 CONSULTANT Balance 2 429 56  
 CONSULTANT Budget 2 431 00  
 % To Budget 100%  
 \*\*\*\*\*

\*\*\*\*\* REVIEW OF CONTRACTOR COSTS \*\*\*\*\*

CONST CO (Acc # 20)

=====

VENDOR	DESCRIPTION	INVOICE #	INV DATE	POST DATE	INV AMOUNT	MLTPL
WATERS ASBESTOS & SUP	ASBESTOS REMOVAL	2503	10/29/87	08/15/88	7 871 00	no

CONST CO	Balance	7 871 00
CONST CO	Budget	7 871 00
	% of Budget	100%

\*\*\*\*\*  
 CONTRACTOR Balance 7 871 00  
 CONTRACTOR Budget 7 871 00  
 % To Budget 100%  
 \*\*\*\*\*

\*\*\*\*\*  
 Project Balance 10 300 56  
 Project Budget 10 302 00  
 % To Budget 100%  
 \*\*\*\*\*



Snake River Asbestos, Inc.  
 1310 Vista  
 Suite 1A  
 Boise, ID 83705

(208) -336-4993

Sold To LDS Building Services  
3295 Elder- Suite 350  
Boise, Idaho 83705

**Invoice**

RECEIVED  
 NOV 12 1987

North America NW

No. SR87-162

Date October 30, 1987

Shipped to \_\_\_\_\_  
 \_\_\_\_\_  
 \_\_\_\_\_

Your Order No. \_\_\_\_\_ Salesman \_\_\_\_\_  
 P.O. # \_\_\_\_\_ F.O.B. \_\_\_\_\_  
 Date Shipped \_\_\_\_\_ Terms \_\_\_\_\_

Quantity Ordered	Quantity Shipped	Stock Number/Description	Price	Per	Amount
		ASBESTOS CONSULTATION- OCTOBER 1987			
		Abatement Supervision- Menan Wards 1 & 2			
		Professional Time- 24 hr.	\$ 35.00	hr	\$ 200.00
		Mileage- 832 miles		23 mi	191.36
		Per Diem- 4 days	50.00	dy	200.00
		Sample Analysis- 21 air samples	20.00	ea	420.00
		TOTAL:			\$ 1651.36

Wilson Jones  
GRAYLINE FORM 44-401 3-PART  
 © 1983 - PRINTED IN U.S.A.

7312-01-3831-03 - (507-2638-75) *lew*

Original / Invoice 87

OK TO PAY 1651.36  
 NAME Anahe Reiser  
 PROJECT # 507-2638-75  
 DATE: 12-15-87  
 SIGNATURE *Anahe Reiser*

ORIGINAL 12/15/87  
 COPY *Steve M.*  
 SENT TO SALT LAKE CITY



Invoice

Snake River Asbestos, Inc.  
1310 Vista  
Suite 1A  
Boise, ID 83705

(208)-336-4993

RECEIVED  
10/19 1987  
North America NW

No SR87-161

Date October 30, 1987

Sold To LDS Building Services Shipped to \_\_\_\_\_

3295 Elder- Suite 350

Boise, Idaho 83705

Your Order No 778 20 Salesman \_\_\_\_\_  
P O # Snake River Asbestos

Date Shipped NOV 11-1987 Terms \_\_\_\_\_  
PROBET VIA PF 19 # 85

Quantity Ordered	Quantity Shipped	Description	Price	Per	Amount
		ASBESTOS CONSULTATION- OCTOBER 1987			
		Survey- Menan Wards 1 & 2			
		Professional Time- 9 5 hr.	\$ 50.00	hr	\$ 475.00
		Mileage- 340 miles		23 ml	78 20
		Expenses			25.00
		Sample Analysis- 8 bulk samples	25.00	ea	200.00
		TOTAL			===== \$ 778 20

Wilson Jones  
GRAYLINE FORM 24 PAR  
1983 PRINTER N.J.S.A.

7312-01-3831-03-(507-2638-25) Original / INVOICE





PHONE (208) 523-3648

# WATERS BESTOS & SUPPLY COMPANY

Heat & Frost Insulation Contractors & Suppliers

P.O. BOX 1117 - 2075 NORTH BOULEVARD - IDAHO FALLS, IDAHO 83401

LDS Physical Services  
3295 Elder Suite 350  
Boise, Idaho 83705

TO

## CONTRACT INVOICE

INVOICE DATE	TERMS	CUSTOMER ORDER NO.	PROJECT
10-29-87	Net/10	PO#	Asbestos Abatement Menan 1st & 2nd Ward

LUMP SUM . . . . . \$ 7871.00

7312-01-3831-03 - (507-2638-75) low

~~ORDER #~~ 7,871.00  
~~NAME~~ Waters Bestos  
~~PROJECT #~~ 507-2638-75  
~~DATE~~ 12-3-87  
~~SIGNATURE~~ Steve M. [Signature]

(Original Contract \$5000.00)  
(Extra \$2871.00)

WORK COMPLETED  
BY CONTRACTOR  
OCTOBER 12, 1987  
KS

ORIGINAL 12/15/87  
 COPY Steve M.  
 SENT TO SALT LAKE CITY

### No. 2503

1% SERVICE CHARGE PER MONTH CHARGED ON ACCOUNTS PAST DUE 30 DAYS.

© 1984/7

INVOICE



ASBESTOS ABATEMENT  
WORK COMPLETION RELEASE

Building Menan Wards 1 & 2  
Project Name: Menan Wards 1 & 2  
Building Location Main Street - Menan, Idaho  
Building Owner Contact: Keith Chase  
Contractor: Waters Insulation - P O Box 1117, Idaho Falls, ID 83402  
Bid Amount: \$5,000 00 Project Dates October 7-12, 1987  
Consultant(s): Tekla Hampel

This form signifies that the above referenced project was completed by the Contractor on October 12, 1987, and that the Contractor is hereby released from the project and is given the Consultant's approval for payment by the Owner

Final Sampling Date: October 12, 1987 Analyzed by: Snake River Associates, Inc  
Final Inspection Date October 10, 1987 Conducted by Tekla Hampel

Tekla Hampel by RS  
Field Consultant

Snake River Asbestos, Inc

Wayne R Dorband  
Wayne R Dorband, President  
Snake River Asbestos, Inc





Snake River Asbestos, Inc

1310 Vista Sulle 1A

Boise Idaho 83705

208/336 4993

ASBESTOS ABATEMENT

ADDITIONAL WORK VERIFICATION

Building Menan Wards 1 & 2

Project Name Menan Wards 1 & 2

Building Location: Main Street - Menan, Idaho

Building Owner Contact: Keith Chase

Contractor: Waters Insulation, P O Box 1117, Idaho Falls, ID 83402

Project Dates October 7-12, 1987

Consultant(s): Tekla Hampel

-----

-----

This is to verify that the Contractor did complete additional asbestos abatement work during the course of this project as follows

- 
- Boiler Room - 80 joints -----
- Tunnel/CrawlSpace - 38 joints -----
- Upper Fan Room - 33 joints -----
- 

-----

*Tekla Hampel*      *Wayne R Dorband*

Field Consultant      President

Snake River Asbestos, Inc      Snake River Asbestos, Inc



FINAL REPORT  
FOR  
MENAN 1 AND 2 WARDS BUILDING  
MENAN, IDAHO

ASBESTOS ABATEMENT PROJECT

by

DR. WAYNE R. DORRBAUD

RECEIVED

DEC - 1987

North America NW

November 21, 1987



## INTRODUCTION

In October, 1987, Mr Keith Chase, area physical facilities representative for the LDS Church, contacted Dr Wayne Dorband, president of Snake River Asbestos, Inc , about the possibility of our firm acting as the industrial hygiene consultants for an asbestos abatement project at the Menan 1 & 2 Wards Building, Menan, Idaho. Dr Dorband visited with Mr Chase and it was determined that a survey of the building would be initially required and that following a completion of that survey, an abatement project be completed. A survey of the building was completed on October 1, 1987, and the Church authorized us to solicit verbal bids for abatement. An award for the completion of the abatement project was made in October, 1987. Waters Insultation, Inc , of Idaho Falls, Idaho was contracted to conduct the asbestos removal under Snake River Asbestos, Inc s supervision.

Asbestos abatement in the building was completed in Mid-October, 1987, and this report summarizes the results of those abatement activities.

## ASBESTOS ABATEMENT PROGRAM ACTIVITIES

The asbestos abatement project for the Menan 1 & 2 Wards Building was directed by Dr Wayne Dorband, president of Snake River Asbestos, Inc. Dr Dorband conducted all of the correspondence with the building representatives and abatement contractor on the project. The entire abatement project was supervised throughout its course by Ms Tella Hampel, asbestos professional for Snake River Asbestos, Inc. Ms Hampel has extensive experience supervising asbestos abatement projects. The asbestos abatement activities were conducted by staff members of Waters Insulation, Inc , Idaho Falls, Idaho. All activities were conducted under strict observance of the project specifications, as well as OSHA and EPA standards regarding asbestos abatement.

The utmost caution relating to health and safety considerations was taken at all times. All areas where asbestos abatement was occurring were posted and occupants were not allowed in the facilities until after clean air samples had certified that the areas were free of asbestos contamination. Extensive air sampling was conducted throughout the abatement by Ms Hampel.



All asbestos material removed was placed in approved 6-mil plastic bags, sealed, and stored in a totally enclosed truck prior to taking it to an approved landfill for disposal. Waters Insulation, Inc., staff members remained at the disposal site and used all proper respiratory protection precautions until the asbestos material was properly buried by disposal site operators. Following the disposal of asbestos materials at the landfill, a receipt was obtained by Waters Insulation, Inc., for the load. This receipt is being held in records by Waters Insulation, Inc.

On October 7, 1987, Ms. Hampel arrived on site at the Menan Building and initiated pre-abatement air samples in the areas of the building where removal was to be conducted. This included an upstairs area where tile was present on the floor, the boiler room, and the crawlspace area. Through her pre-abatement inspection, another upper fan room was identified which had 33 fittings in it. Consultation with Mr. Chase was conducted to determine whether fittings in this room should be removed. Also, it was found that in the room where the tile removal was to occur, the remodeling contractor had constructed framework over some of the tile area. It was determined that this tile under the framing would not be removed and would be encapsulated on surface areas at the edge of the removal of the tile.

Throughout the day on October 7th, the abatement crew constructed enclosure and decontamination areas, and pre-cleaned all the work areas. Ms. Hampel completed pre-abatement air samples on the morning of October 8, and found that all fiber levels in all samples were below the detection limits of 0.01 fibers/cc (Appendix A; Samples W-103-M12-1 thru M12-3).

It was determined on the morning of October 8th, that the extra fittings found in the upper fan would be removed. Therefore, Ms. Hampel obtained a pre-abatement sample in this area. Fiber levels in this sample were well below the detection limits of 0.01 fibers/cc (Appendix A; Sample W-103-M12-6). Throughout the early part of the day on October 8th, the abatement crew continued to conduct the construction of the enclosure system. This was completed around 2:00 P.M. and removal in the area of the building with the tile was begun. This removal was completed in a very short period of time, around 3:30 in the afternoon of the same day.

Throughout this removal process, Ms. Hampel obtained air samples inside the work area and outside the work area. Fiber levels in these samples were low, being less than detection limits (Appendix A; Samples W-103-M12-4 and M12-5).



On the morning of October 9th, Ms Hampel inspected the enclosure areas for the boiler room, and soon after this time removal was initiated in that area. This removal was conducted throughout the day. Ms Hampel obtained air samples throughout the day as personal monitor samples, inside wort area samples, and outside wort area samples. Fiber levels in samples taken outside the wort area were below detection limits, and inside the wort area fiber levels were moderate to low (Appendix A, Samples W-103-M12-7 to M12-11)

Near the end of the day on October 9th, Ms Hampel inspected the tile removal area, and following her inspection initiated a post-abatement sample in the area. This sample was completed in the morning on October 10th, and was immediately sent to our Boise laboratory for analysis. It was found that this sample contained less than the clearance detection limit levels of 0.01 fibers/cc (Appendix A, sample W-103-M12-12). Following completion of this analysis, Ms Hampel released the abatement crew to tear down the enclosure system and released them from this wort area.

On the morning of October 10th, removal activities were continued in the boiler room. It was found that there were more fittings present in the boiler room than were expected from the initial survey. This removal in the boiler room continued throughout the morning, and was completed around noon. Following the completion of removal, the crew removed waste material in a load out procedure. Concurrently with the work in the boiler room, the crew completed all removal activities in the crawl-space area, which was adjacent to the boiler room. Throughout the day on October 10th, Ms Hampel obtained air samples in the boiler room wort area, crawl-space wort area, and outside the wort areas. Fiber levels in all these samples were low, indicating the relative safety of this removal process (Appendix A, Samples W-103-M12-14 thru M12-16).

Following completion of the removal in the boiler room and crawl-space, the crew moved to the upper fan room area in the afternoon on October 10th. This removal was conducted throughout the afternoon on that day. Removal was completed mid-afternoon of the same day. Ms Hampel obtained air samples in the upper fan room wort area, and as a personal monitor during this removal. Fiber levels in these samples were very low, being less than detection limits (Appendix A, Samples W-103-M12-17 and M12-18).



Late in the afternoon on October 10th, Ms Hampel inspected the boiler room, crawlspace, and upper fan rooms areas. During this inspection she counted all the fittings and determined whether the abatement activities had been conducted properly. She determined that there were 238 total fittings in the crawlspace and boiler room area, and 23 fittings in the upper fan room. Her observation was that all the area had been properly cleaned and heavily encapsulated. Around 4:00 P.M. she initiated post-abatement air sampling in the boiler room, crawlspace, and upper fan room areas. During her inspection she did find a few runs of pipe that were enclosed in a pipe chase which were now exposed. She contacted Mr. Chase and found that these pipes would be enclosed again in another chase, so they would not need to be removed.

Post-abatement air samples were run through the night and completed in the morning on October 12, 1987. These samples were immediately sent to our Boise laboratory for analysis. Fiber levels in these three samples were all well below the clearance detection limits of 0.01 fibers/cc (Appendix A, Samples W-103-M12-19 to M12-21). Following the completion of post-abatement samples, Ms Hampel released the abatement crew to tear down their enclosure setups, and notified the building owner that reoccupancy of the removal area could occur.

There were no health or safety problems encountered in this project, and there were no breaches of the work area enclosure system. This project was conducted as safely as possible under the conditions of the work site. At this time it is our observation that all friable asbestos material has been removed from exposed areas of this building, with the exception of the pipe chase areas mentioned previously which we were assured would be enclosed during the reconstruction activities. However, we cannot determine whether there may or may not be any additional asbestos materials present inside enclosed areas such as those areas between walls or above ceiling areas.



**Table I: Comparison of Various Asbestos Control Alternatives.**

Method	Advantages	Disadvantages	Appropriate applications	Inappropriate applications	General comments
Removal	Eliminates asbestos source	Replacement with substitute material may be necessary	Always	Never	Containment barriers needed
	Eliminates need for special operations and maintenance program	Porous surfaces also may require encapsulation Improper removal may raise fiber levels			Worker protection required Wet removal is required for all types of asbestos. (amovite will not absorb water or water which traditional wetting agents)
Enclosure	Reduces exposure in the area outside the enclosure	Asbestos source remains and must be removed eventually	When materials need to be isolated from building occupants (e.g. exposed paper)	Damaged or deteriorating materials causing rapid fiber release	Disposal may be a problem in some areas
	Initial costs may be lower than removal unless utilities need relocating or major changes Usually does not require replacement of material	Fiber release continues behind enclosure Special operations program required to control access to enclosure for maintenance and renovation Periodic reinspection required to check for damage Repair of damaged enclosures necessary Fibers released in dry form during construction of enclosure Long-term costs could be higher than removal	Disturbance or entry into enclosed area unlikely	Water damage evident Damage or entry into enclosure likely Ceiling to be enclosed is low	Unusual circumstances, complex surfaces, and the presence of utilities may require special removal techniques



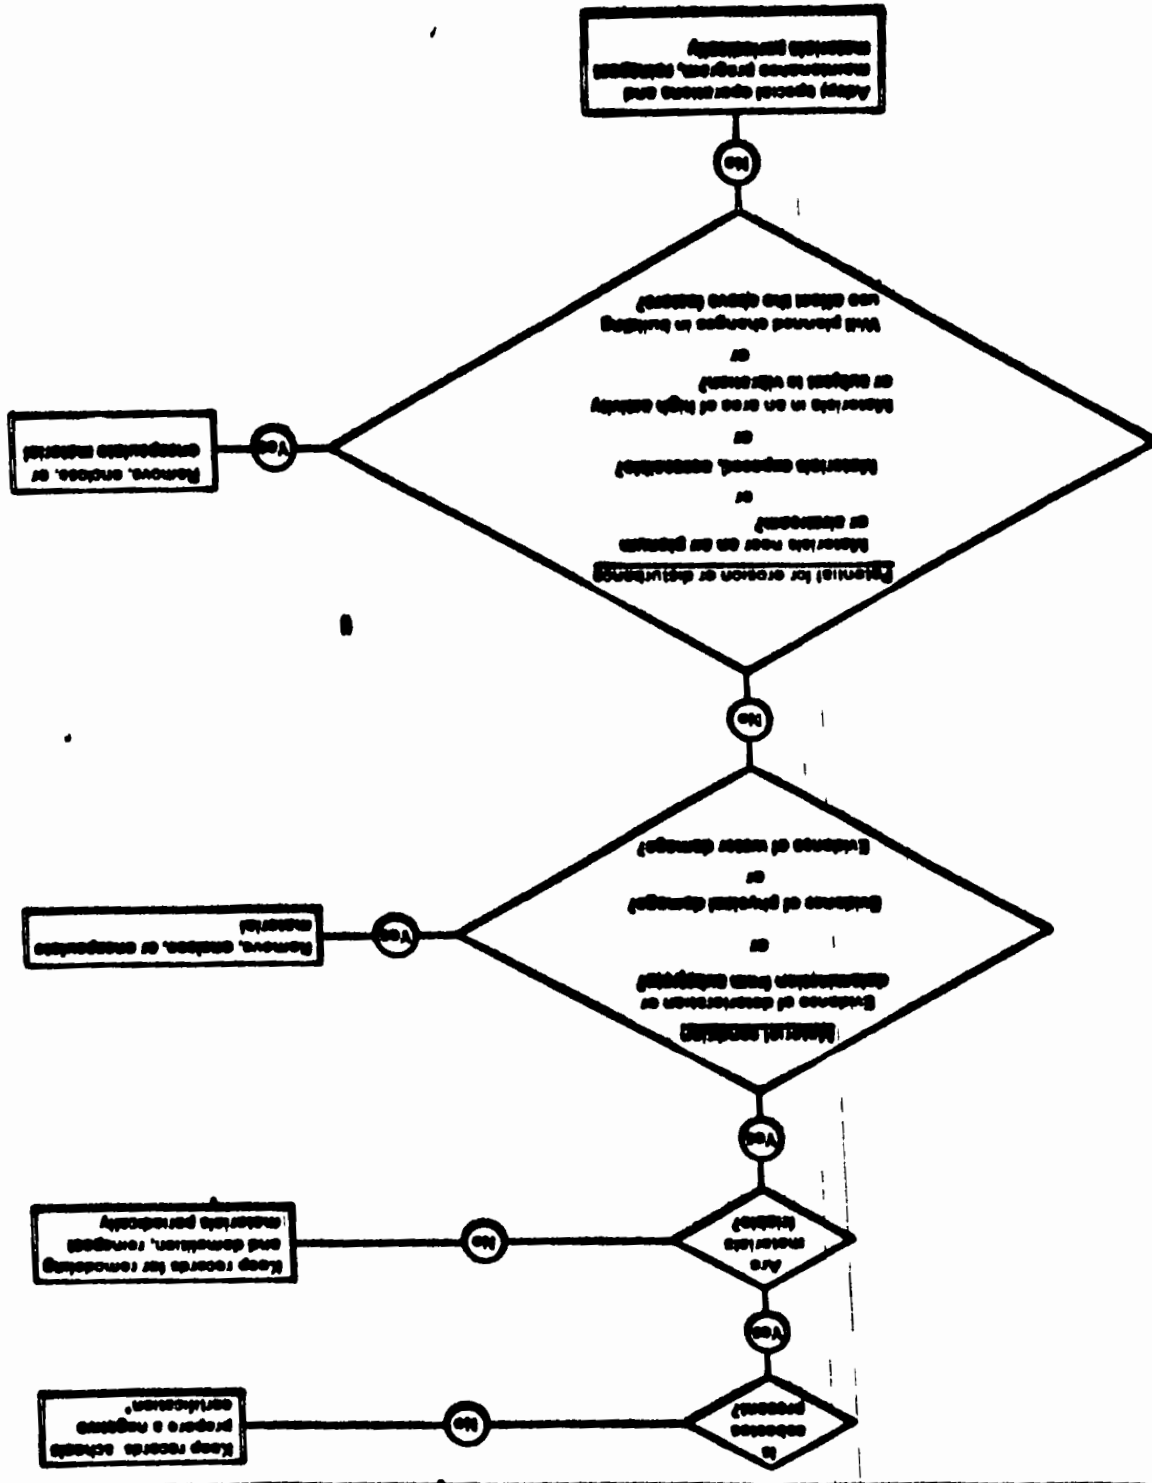


Figure 1. Steps in Selecting a Course of Action for Asbestos Abatement



APPENDIX "A"



Date Reported:

October 26, 1987  
October 12, 1987

Date Received:

W-103-M12-1 thru M12-21

Sample Code No:

Menan wards 1 & 2

Submitted By:

Sample Identification:

W-103-M12-1: Boiler room

CLIENT:

W-103-M12-2: Northeast room  
W-103-M12-3: Crawlspace

LDS Physical Services  
3295 Elder-- Suite 350  
Boise, Idaho 83705

Snake River Associates, Inc.

1310 Vista, Suite 1A  
Boise, Idaho 83705  
208/336-4993



**Sample**

**Description**

**Results**

W-103-M12-1	Pre-abatement*	< 0.005 fibers/cc
W-103-M12-2	Pre-abatement*	< 0.005 fibers/cc
W-103-M12-3	Pre-abatement*	< 0.005 fibers/cc

\* Taken during the night of October 7-8, 1987.

Analyst: Deb Dorband

A handwritten signature in dark ink, appearing to read "Wayne Dorband", is written over a horizontal line.

Authorized Signature

I certify that these results are accurate for the samples obtained and comply with accepted methods of analysis.

Wayne Dorband, Ph.D.  
President



Date Reported:


October 26, 1987  
October 12, 1987

Date Received:

Sample Code No: W-103-M12-1 thru M12-21

Submitted By:

**Snake River Associates, Inc.**  
1310 Vista, Suite 1A  
Boise, Idaho 83705  
208/336-4993

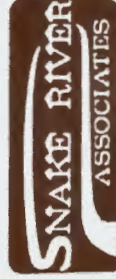

Menan Wards 1 & 2

Sample Identification:

W-103-M12-4: Outside work areas

W-103-M12-5: Personal monitor-  
Scott

CLIENT:


LDS Physical Services  
3295 Elder- Suite 350  
Boise, Idaho 83705

Sample	Description	Results
W-103-M12-4	During abatement*	< 0.005 fibers/cc
W-103-M12-5	During abatement*	0.105 fibers/cc
W-103-M12-6	Pre-abatement*	< 0.010 fibers/cc

\* Taken October 8, 1987.

Analyst: Deb Dorband

I certify that these results are accurate for the samples obtained and comply with accepted methods of analysis.

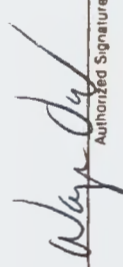  
Authorized Signature

Wayne Dorband, PhD.  
President




Date Reported:

October 26, 1987  
October 12, 1987

Date Received:

Sample Code No: W-103-M12-1 thru M12-21

Submitted By:

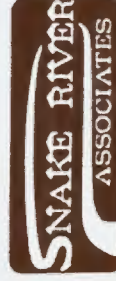

Snake River Associates, Inc.  
1310 Vista, Suite 1A  
Boise, Idaho 83705  
208/336-4993

Menan Wards 1 & 2

Sample Identification:

W-103-M12-7: Outside work area

CLIENT:

LDS Physical Services  
3295 Elder- Suite 350  
Boise, Idaho 83705

W-103-M12-8: Boiler room- in  
work area

W-103-M12-9: Boiler room-personal  
monitor (Bret)

W-103-M12-10:Boiler room- in  
work area

W-103-M12-11:Boiler room-  
personal monitor

Sample	Description	Results
W-103-M12-7	During abatement*	< 0.015 fibers/cc
W-103-M12-8	During abatement*	0.127 fibers/cc
W-103-M12-9	During abatement*	0.111 fibers/cc
W-103-M12-10	During abatement*	0.071 fibers/cc
W-103-M12-11	During abatement*	1.678 fibers/cc

\* Taken October 9, 1987.

Analyst: Deb Dorband

A handwritten signature in dark ink, appearing to read "Wayne Dorband".

Authorized Signature

I certify that these results are accurate for the samples obtained and comply with accepted methods of analysis.


Wayne Dorband, PhD.  
President



Date Reported:

October 26, 1987  
October 12, 1987

**Snake River Associates, Inc.**  
1310 Vista, Suite 1A  
Boise, Idaho 83705  
208/336-4993

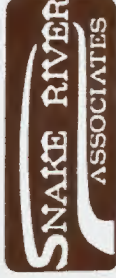

Sample Code No:

W-103-M12-1 thru M12-21

Submitted By:

Menan wards 1 & 2

Sample Identification:

W-103-M12-12: Personal monitor-  
Scott

W-103-M12-13: Room with tile

CLIENT:  
LDS Physical Services  
3295 Elder- Suite 350  
Boise, Idaho 83705

W-103-M12-14: Outside work areas


W-103-M12-15: Boiler room- in  
work area

W-103-M12-16: Boiler room-  
personal monitor (Bret)

<u>Sample</u>	<u>Description</u>	<u>Results</u>
W-103-M12-12	During load-out*	< 0.389 fibers/cc
W-103-M12-13	Post abatement*	< 0.010 fibers/cc
W-103-M12-14	During abatement*	< 0.017 fibers/cc
W-103-M12-15	During abatement*	0.046 fibers/cc
W-103-M12-16	During abatement*	0.123 fibers/cc

\* Taken October 10, 1987.

Analyst: Deb Dorband

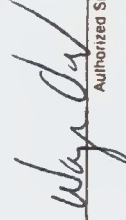  
Authorized Signature

Wayne Dorband, PhD.  
President


I certify that these results are accurate for the samples obtained and comply with accepted methods of analysis.



Date Reported:  
Date Received:  
Sample Code No:  
Submitted By:

October 26, 1987  
October 12, 1987  
W-103-M12-1 thru M12-21

**Snake River Associates, Inc.**  
1310 Vista, Suite 1A  
Boise, Idaho 83705  
208/336-4993

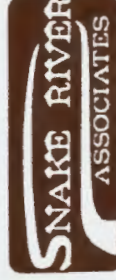

Menan Wards 1 & 2

Sample Identification:


W-103-M12-17: Upper fan room-  
work area  
W-103-M12-18: Upper fan room-  
personal monitor  
W-103-M12-19: Boiler room  
W-103-M12-20: Crawlspace  
W-103-M12-21: Upper fan room

CLIENT:  
LDS Physical Services  
3295 Elder- Suite 350  
Boise, Idaho 83705

Sample	Description	Results
W-103-M12-17	During abatement (10-10)	< 0.093 fibers/cc
W-103-M12-18	During abatement (10-10)	< 0.111 fibers/cc
W-103-M12-19	Post abatement*	< 0.005 fibers/cc
W-103-M12-20	Post abatement*	< 0.005 fibers/cc
W-103-M12-21	Post abatement*	< 0.005 fibers/cc

\* Taken over the days of October 10-12, 1987.

Analyst: Deb Dorband

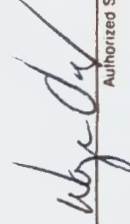  
Authorized Signature

Wayne Dorband, PhD.  
President

I certify that these results are accurate for the samples obtained and comply with accepted methods of analysis.





PHONE (208) 523-3648

# WATER INSULATION & SUPPLY INC.

*Heat & Frost Insulation Contractors & Suppliers*

2075 N. BLVD. - REAR  
10-8-87

IDAHO FALLS, IDAHO 83402

P.O. BOX 1117

## ASBESTOS REMOVAL NOTIFICATION FORM

**Contractor:**

Name: Waters Insulation & Supply Co., Inc.  
Address: P. O. Box 1117

Verbal by Telephone 10-7-87  
as per Mark Masarik

Idaho Falls, Idaho 83405

Phone: (208)-523-3648

**Building Owner/Operator:**

Name: Menan 1st & 2nd Wards  
Address: Main Street  
Menan, Idaho

**Building Description:**

Size: N/A  
Age: 30 Yrs old  
Prior (or present) use: Church

**Approx. Amount of Asbestos Material to be removed:**

Linear Feet: 120 Joints Average Thickness: \_\_\_\_\_  
Average  
Square Feet: 360 Floor Tile Thickness: \_\_\_\_\_

**Location of work site:**

Menan 1st & 2nd Wards  
Menan, Idaho

**Starting and Completion Dates:**

From: 10-12-87 To: 10-16-87

**Type of Renovation or Demolition Operation:**

Remove asbestos from Joints and Remove  
Asbestos floor Tile

**Exact Methods to be used to Comply with Federal Regulations:**

Removing Asbestos: Total containment  
and glove bags

Mail To:

EPA  
422 Washington Street  
Boise, Idaho 83702

Attention: Al Odmark

State Health Dept.  
Asbestos Removal Dept.  
Boise, Idaho 83702

Transporting: Closed Van - Plastic lined

Disposing: 6 mil Ply Bags Doubled

Disposal Site:

Name: Idaho Falls Land Fill  
Address: Idaho Falls, Idaho

RECEIVED

011

Site Operator: City of Idaho Falls

City of Idaho Falls





PHONE (208) 523-3648

# WATER INSULATION & SUPPLY INC.

*Heat & Frost Insulation Contractors & Suppliers*

2075 N. BLVD. - REAR

IDAHO FALLS, IDAHO 83402

P.O. BOX 1117

December 10, 1987

LDS Physical Services  
3295 Elder - Suite 350  
Boise, Idaho 83705

Ref: Asbestos Abatement - Menan 1st & 2nd Wards  
Menan, Idaho

Gentlemen:

Enclosed, please find the following records for your file for the above referenced project:

1. Asbestos Removal Notification Form (1 Copy) EPA
2. Asbestos Analytical Report (5 Copies) Snake River Associates
3. Asbestos Waste Disposal Form (2 Copies) Waters

If further assistance is needed, please contact the undersigned.  
Thank You.

Sincerely,

Pattie G. Wilson  
Asbestos Abatement Coordinator

cc: file

RECEIVED

1 1

1



Date Reported: October 26, 1987

Date Received: October 12, 1987

Sample Code No: W-103-M12-1 thru M12-21

Submitted By:

**Snake River Associates, Inc.**  
1310 Vista, Suite 1A  
Boise, Idaho 83705  
208/336-4993



Menan Wards 1 & 2

Sample Identification:

W-103-M12-1: Boiler room

W-103-M12-2: Northeast room

W-103-M12-3: Crawlspace

CLIENT:

LDS Physical Services  
3295 Elder- Suite 350  
Boise, Idaho 83705

Sample	Description	Results
W-103-M12-1	Pre-abatement*	< 0.005 fibers/cc.
W-103-M12-2	Pre-abatement*	< 0.005 fibers/cc
W-103-M12-3	Pre-abatement*	< 0.005 fibers/cc

\* Taken during the night of October 7-8, 1987.

Analyst: Deb Dorband

I certify that these results are accurate for the samples obtained and comply with accepted methods of analysis.

REC 11 F  
D 1

A handwritten signature in black ink, appearing to read "Wayne Dorband".

Authorized Signature

Wayne Dorband, PhD.  
President



Date Reported:

October 26, 1987  
October 12, 1987

Date Received:

Sample Code No:

W-103-M12-1 thru M12-21

Submitted By:

Menan Wards 1 & 2

Sample Identification:

W-103-M12-4: Outside work areas

CLIENT:

LDS Physical Services  
3295 Elder- Suite 350  
Boise, Idaho 83705

W-103-M12-5: Personal monitor-

Scott

W-103-M12-6: Upper fan room

**Snake River Associates, Inc.**  
1310 Vista, Suite 1A  
Boise, Idaho 83705  
208/336-4993



**Sample**

W-103-M12-4

**Description**

During abatement\*

**Results**

< 0.005 fibers/cc'

W-103-M12-5

During abatement\*

0.105 fibers/cc

W-103-M12-6

Pre-abatement\*

< 0.010 fibers/cc

\* Taken October 8, 1987.

Analyst: Deb Dorband

I certify that these results are accurate for the samples obtained and comply with accepted methods of analysis.

  
Authorized Signature

Wayne Dorband, PhD.  
President



Date Reported  
Date Received  
Sample Code No  
Submitted By

October 26, 1987  
October 12, 1987  
W-103-M12-1 thru M12-21

**Snake River Associates, Inc**  
1310 Vista Suite 1A  
Boise Idaho 83705  
208/336-4993



Menan Wards 1 & 2

Sample Identification

W-103-M12-7: Outside work area

CLIENT

LDS Physical Services  
3295 Elder- Suite 350  
Boise, Idaho 83705

W-103-M12-8: Boiler room- in  
work area  
W-103-M12-9: Boiler room-personal  
monitor (Bret)  
W-103-M12-10: Boiler room- in  
work area  
W-103-M12-11: Boiler room-  
personal monitor

Sample	Description	Results
W-103-M12-7	During abatement*	0 015 fibers/cc
W-103-M12-8	During abatement*	0 127 fibers/cc
W-103-M12-9	During abatement*	0 111 fibers/cc
W-103-M12-10	During abatement*	0 071 fibers/cc
W-103-M12-11	During abatement*	1 678 fibers/cc

\* Taken October 9, 1987

Analyst: Deb Dorband

I certify that these results are accurate for the samples obtained and comply  
with accepted methods of analysis

RECEIVED

DECEMBER 1987

North / Central

Authorized Signature

Wayne Dorband, PhD  
President



Date Reported  
Date Received

October 26, 1987  
October 12, 1987

Sample Code No

W-103-M12-1 thru M12-21

Submitted By



Snake River Associates, Inc  
1310 Vista Suite 1A  
Boise Idaho 83705  
208/336-4993

Menan Wards 1 & 2

Sample Identification

W-103-M12-12: Personal monitor--  
Scott

W-103-M12-13: Room with tile

CLIENT  
LDS Physical Services  
3295 Elder- Suite 350  
Boise, Idaho 83705

W-103-M12-14: Outside work areas

W-103-M12-15: Boiler room- in  
work area

W-103-M12-16: Boiler room--  
personal monitor (Bret)

SAMPLE	DESCRIPTION	RESULTS
W-103-M12-12	During load-out*	< 0 389 fibers/cc
W-103-M12-13	Post abatement*	< 0.010 fibers/cc
W-103-M12-14	During abatement*	< 0.017 fibers/cc
W-103-M12-15	During abatement*	0 046 fibers/cc
W-103-M12-16	During abatement*	0.123 fibers/cc

\* Taken October 10, 1987

Analyst: Deb Dorband

I certify that these results are accurate for the samples obtained and comply  
with accepted methods of analysis

RECEIVED  
DLU

Authorized Signature

Wayne Dorband, PhD  
President



Date Reported  
Date Received  
Sample Code No  
Submitted By

October 26, 1987  
October 12, 1987  
W-103-M12-1 thru M12-21



Snake River Associates, Inc  
1310 Vista Suite 1A  
Boise Idaho 83705  
208/336-4993

Menan Wards 1 & 2

Sample Identification

W-103-M12-17: Upper fan room-  
work area  
W-103-M12-18: Upper fan room-  
personal monitor  
W-103-M12-19: Boiler room  
W-103-M12-20: Crawlspace  
W-103-M12-21: Upper fan room

CLIENT

LDS Physical Services  
3295 Elder- Suite 350  
Boise, Idaho 83705

SAMPLE

DESCRIPTION

RESULTS

W-103-M12-17	During abatement (10-10)	( 0 093 fibers/cc
W-103-M12-18	During abatement (10-10)	( 0 111 fibers/cc
W-103-M12-19	Post abatement*	( 0 005 fibers/cc
W-103-M12-20	Post abatement*	( 0 005 fibers/cc
W-103-M12-21	Post abatement*	( 0 005 fibers/cc

\* Taken over the days of October 10-12, 1987

Analyst: Deb Dorband

I certify that these results are accurate for the samples obtained and comply  
with accepted methods of analysis

RECEIVED

DLU 1)

North

Authorized Signature

Wayne Dorband, PhD.  
President





PHONE (208) 333-3648

# WATER INSULATION & SUPPLY INC.

Heat & Frost Insulation Contractors & Suppliers

2075 N BLVD - REAR

IDAHO FALLS, IDAHO 83402

P.O. BOX 1117

## WASTE DISPOSITION

DATE: 1/5/87  
 LANDFILL: Idaho Falls  
 MATERIAL: Asbestos  
 MATERIALS REMOVED FROM: Magnetics

THE BELOW SIGNED LANDFILL OPERATOR RECEIVED ALL WASTE IN  
 PROPERLY CONTAINED LEAK-TIGHT CONTAINERS APPROPRIATELY  
 LABELED AS ASBESTOS WASTE. ALL LANDFILLING AS RECOMMENDED  
 BY FEDERAL, STATE AND LOCAL LAWS.

LAND FILL OPERATOR  
 SIGNED Mark Beth

RECEIVED  
 D161  
 1/11/87





PHONE (208) 513-3648

# WATER INSULATION & SUPPLY INC.

Heat & Frost Insulation Contractors & Suppliers

2075 N. DELV. - REAR

IDAHO FALLS, IDAHO 83402

P.O. BOX 1117

## WASTE DISPOSITION

DATE: 11/5/87  
 LANDFILL: Idaho Falls  
 MATERIAL: Asbestos  
 MATERIALS REMOVED FROM: Mesa - L.D.S.

THE BELOW SIGNED LANDFILL OPERATOR RECEIVED ALL WASTE IN  
 PROPERLY CONTAINED LEAK-TIGHT CONTAINERS APPROPRIATELY  
 LABELED AS ASBESTOS WASTE. ALL LANDFILLING AS RECOMMENDED  
 BY FEDERAL, STATE AND LOCAL LAWS.

LAND FILL OPERATOR  
 SIGNED Mike Roth

RECEIVED

NOV 12 1987

North America NW

PROFESSIONAL CONSULTANT'S AGREEMENT

This Agreement made and entered into by and between Corporation of the Presiding Bishop of The Church of Jesus Christ of Latter-day Saints, a Utah corporation sole, hereinafter referred to as Owner, and SNAKE RIVER ASBESTOS, INC. of Boise, Idaho hereinafter referred to as Professional Consultant.

WITNESSETH:

WHEREAS, Owner proposes to have Professional Consultant provide supervisory and inspection services for the removal of asbestos from the MENAN 1 & 2 WARDS BUILDING, building; located at Main Street, Menan, Idaho and referred to hereinafter as Project; and

WHEREAS, Professional Consultant agrees to provide said services; NOW, THEREFORE, BASED UPON THE CONSIDERATION HEREINAFTER ENUMERATED, Owner and Professional Consultant covenant, promise, and agree as follows:

ARTICLE I  
Compensation

- A. Owner shall compensate Professional Consultant for his services to be rendered as hereinafter described, the fixed fee of (\$2,638.20).
- B. The figure in "A" above may fluctuate according to the actual costs of the work involved, but in no event will it exceed twenty percent (20%) of the actual costs to remove and replace the asbestos on the project.
- C. Professional Consultant will provide written inspection reports of his site visits and make site visits on an average of once per day.
- D. Professional Consultant will maintain project expenses for change orders resulting from Professional Consultant's errors and omissions to less than five percent of original contract cost.

GDagrPRO



E. Professional Consultant will satisfy Owner that project conforms to the approved Contract Documents.

F. Fee payments as contained in Article I above shall be made in proportion to services completed by Professional Consultant and approved by Owner, in accordance with incremental periods during the project based upon a percentage of the work completed, but not in excess of 95 percent of the total anticipated fee until the work has been satisfactorily accomplished.

G. Expenses for transportation, communications and living expenses related to the work shall be included as part of Professional Consultant's fee.

H. Owner shall compensate Professional Consultant for additional services under Article VIII hereof at the rate of SIX percent (6 %) of the cost of the extra construction or work requiring the additional services.

ARTICLE II  
Changes in Scope:

A. Changes shall be approved in writing by Owner before Professional Consultant proceeds.

B. Prior to construction, compensation adjustment will be negotiated for change in scope requiring additional professional service from Professional Consultant.

ARTICLE III  
Professional Consultant's Services

A. General

Professional Consultant shall:

1. Provide a complete set of Construction Documents to meet requirements of local conditions, site, utilities, climate, code, zoning, regulatory agencies, and to meet Owner's directives, policies and instructions.

2. Affix Professional Consultant's seal with signatures to respective portions of Construction Documents in accordance with local laws and ordinances. Professional Consultant is responsible to take whatever steps are necessary to ensure that Construction Documents are properly prepared to comply with applicable state laws.

3. Keep Owner informed of project development and assist Owner in review.
4. Provide submittals to Owner where required by fastest means available.
5. In business dealings, act ethically and in best interest of Owner.
- B. Pre-Construction Phase Documents
  1. Prepare and submit specifications and Owner required documents incorporating necessary local code and use permit requirements.
- C. Construction Phase:  
Professional Consultant shall:
  1. Assist Owner in obtaining bonds, insurance and signed agreement from Contractor and forward to Owner.
  2. Provide Professional Consultant administrative services as listed in Contract Documents.
  3. Act as official office of record for Contractor's Agreement. Conduct all correspondence with Contractor. Provide sole point of instructions and orders to Contractor for Owner. Keep Owner informed by furnishing copies of correspondence.
  4. Review progress schedule and submittal schedule submitted by Contractor and advise Owner.
  5. Certify Contractor's payment request, Form PFB-31 furnished by Owner, based on Professional Consultant's approval that work conforms to Contract Documents as represented by Contractor.
  6. Weekly progress meetings:
    - a. Arrange a fixed date, time, and place to meet each week.
    - b. Conduct.



**c. Forward a copy of minutes to all parties.**

**D. Inspection:**

1. Make appropriate site visits as necessary to insure the project is progressing steadily, safely and legally.
2. Forward to Owner consultant's written inspection reports of site visits within seven (7) days.

**E. Change Orders:**

1. Determine justification for change order, with Contractor and submit to Owner for approval before proceeding.
2. If necessary make specification changes required to portray approved changes in work for Contractor.
3. Review Contractor's breakdown of quantities, material unit prices, labor unit prices, and application of overhead and profit allowed by specifications for fairness and accuracy. Advise and assist Owner with negotiations.
4. Prepare application and obtain signatures on Change Order Form FMBD 0227 furnished by Owner. Forward to Owner for approval.

**F. Completion Phase:**

Professional Consultant shall:

1. Provide administration of Construction Documents as set forth in General Conditions, Supplementary Conditions and Specifications.
2. Conduct pre-substantial completion inspection with Contractor. Conduct substantial completion inspection with Owner, Church officials, and Contractor. Coordinate follow-up inspections and forward final Construction Project Progress Reports and inspection punch list to Owner and Contractor.

**ARTICLE IV  
Owner's Responsibilities**

**A. Owner shall provide:**

1. Number of calendar days for construction from date of notice to proceed to completion date.
2. Liquidated damage amount for construction phase.
3. Project budget limitations.

**ARTICLE V  
Successors and Assigns**

Owner and Professional Consultant each binds himself, his partners, successors, assigns and legal representatives to the other party to this agreement and to partners, successors, assigns and legal representatives of such other party in respect of all covenants of this Agreement. Neither Owner nor Professional Consultant shall assign, sublet, or transfer his interest in this Agreement without written consent of other.

**ARTICLE VI  
Termination of Agreement**

This Agreement may be terminated at any phase of the work by either party upon seven (7) days written notice. Professional Consultant shall be compensated for services performed under this agreement to date of this notice. He will also be liable to Owner for any damage or loss suffered by Owner as a result of said service.

**ARTICLE VII  
Applicable Law**

This Agreement shall be governed by law of principle place of business of Professional Consultant and may be amended only by written instrument signed by both Owner and Professional Consultant.



**ARTICLE VIII**  
**Additional Services**

A. Additional Services not included in basic services of this Agreement, which shall be provided if authorized or confirmed in writing by Owner and shall be compensated by Owner as provided in this Agreement in addition to compensation for basic services, are as follows:


1. Providing consultation concerning replacement of any work damaged by fire or other cause during construction.
2. Providing services made necessary by the default of the Contractor by defects or deficiencies in the work of the Contractor, or performance of the Contractor under the Contract for Construction.

The effective date of this Agreement shall be date that the Owner signs.

**Professional Consultant:**

SNAKE RIVER ASBESTOS, INC.

**By:**

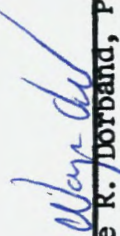  
Wayne R. Dorband, PhD, President

**Owner:**

**CORPORATION OF THE PRESIDING  
BISHOP OF THE CHURCH OF JESUS  
CHRIST OF LATTER-DAY SAINTS, a  
Utah corporation sole,**

**By:**

  
Authorized Agent, Fred A. Baker

## CONTRACT

THIS CONTRACT AND AGREEMENT, made and entered into this \_\_\_\_\_ day of \_\_\_\_\_, in the year Nineteen Hundred and Eighty-Seven by and between the CORPORATION OF THE PRESIDING BISHOP OF THE CHURCH OF JESUS CHRIST OF LATTER-DAY SAINTS, A Utah Corporation sole, hereinafter called "Owner," and WATERS INSULATION & SUPPLY, INC., of IDAHO FALLS, IDAHO, hereinafter called "Contractor."

### WITNESSETH:

WHEREAS: Owner intends to have certain work performed as outlined below, and

WHEREAS: Contractor is able and willing to perform such work,

NOW THEREFORE: Owner and Contractor for the consideration hereinafter provided agree as follows:

### ARTICLE I - SCOPE OF WORK

Contractor shall furnish all of the materials and equipment and perform all of the labor necessary to complete all of the work for the Menan 1 and 2 Wards, Menan Idaho Stake, required in the Contract Documents entitled "Asbestos Survey Report for Menan 1 and 2 Ward Building, Menan, Idaho," as prepared by Snake River Associates, Inc., Boise, Idaho, hereinafter referred to as "Professional Consultant."

### ARTICLE II - THE CONTRACT DOCUMENTS

The General Conditions of the Contract, Supplementary Conditions, the Specifications entitled "Asbestos Survey Report for Menan 1 and 2 Ward Building, Menan, Idaho," prepared by Snake River Associates, Inc., Boise, Idaho, any addenda issued and numbered, together with this Agreement, form the Contract and are as fully a part thereof as if attached hereto or repeated herein.

### ARTICLE III - THE CONTRACT SUM

Owner shall pay and Contractor shall accept as a guaranteed maximum price as payment of this Contract, the sum of Seven Thousand Eight Hundred Seventy-one and no/100 Dollars (\$7,871.00), subject to additions and deductions provided in the Contract. In the event there are any savings in manhours on items 1 and 3 of the specifications, these savings shall be passed on to Owner and the contract sum reduced accordingly.

### ARTICLE IV - TIME OF COMMENCEMENT AND COMPLETION

Work under this Contract shall commence upon written notice to proceed from Owner, and be completed and ready for Owner's final inspection within \_\_\_\_\_ working days from the date of such notice. Time is of the essence. Working days are defined as days when Contractor is permitted to perform work by Owner. It is understood and agreed that there may be days when Contractor will not be permitted to work. For these days, Contractor waives any claim for delay, damages or any damages related thereto.

### ARTICLE V - INSPECTION

The fact that any particular work has been inspected shall not be considered a waiver of the requirements of strict compliance with the Contract Documents.





**ARTICLE VI - CONTRACTOR NOT AGENT OF OWNER**

It is expressly agreed that Contractor is not the agent or employee of Owner, but that he is an independent Contractor.

**ARTICLE VII - PROGRESS PAYMENTS, FINAL ACCEPTANCE, AND FINAL PAYMENT**

Payments shall be made in accordance with the applicable Sections of the Contract Documents.

**ARTICLE VIII - ASSIGNS**

Neither party to the Contract shall assign the Contract or sublet it as a whole without the written consent of the other. Contractor shall not assign any monies due or to become due to him hereunder nor shall he pledge or attempt to pledge the credit of Owner or bind the Owner to any third party.

**ARTICLE IX - ACCEPTANCE**

The work shall be inspected for acceptance by Owner promptly upon receipt of notice from Contractor and the Professional Consultant that all work is complete and ready for inspection. All work and materials connected therewith shall be at Contractor's risk until accepted by Owner in writing.

**ARTICLE X - DEFAULT AND ATTORNEY'S FEES**


Should any dispute arise between the parties hereto with regard to the performance of their respective obligations under the Contract Documents, which dispute cannot be settled between the parties and litigation is commenced, then the losing party in the litigation agrees to pay all costs and reasonable attorney's fees of the prevailing party.

IN WITNESS WHEREOF, the parties hereto have executed this Agreement, the day and year first above written, binding themselves, their heirs, successors, executors, administrators and representatives to the full performance of the contract.

REVIEWED & APPROVED:

ACCEPTED

OWNER: CORPORATION OF THE  
PRESIDING BISHOP OF THE CHURCH OF  
JESUS CHRIST OF LATTER-DAY SAINTS,  
A Utah Corporation Sole,

by   
Authorized Agent

CONTRACTOR: WATERS INSULATION & SUPPLY

by   
Name and Title *Ronald L. Hayward*  
License # *5432-AAA-4 (24)*  
State where issued: *Idaho*



ASBESTOS SURVEY REPORT

FOR

MENAN 1 AND 2 WARD BUILDING

MENAN, IDAHO

*Menan, ID State*

by

WAYNE R. DORRANCE, PH.D.

October 20, 1987







Snake River Asbestos, Inc

1310 Vista Suite 1A

Boise Idaho 83705

208/336 4993

RECEIVED

JUL 10 1988

Porter America NW/

June 7, 1988

Mr Scott Satterfield  
LDS Physical Facilities Office  
P O Box 15309  
Boise, Idaho 83715

Dear Mr Satterfield

Upon reviewing our survey protocol for the Menan 1 and 2 Ward Building, we have verified that our survey actually has identified all friable and non-friable asbestos-containing materials present inside the building in exposed areas. Our earlier report only indicated that we had identified friable materials

Sincerely yours,

A handwritten signature in cursive script, appearing to read "Wayne Dorband".

Wayne Dorband, PhD, President  
Snake River Asbestos, Inc

WD/djh

507 2638  
MENAN 1, 2  
MENAN ID

## INTRODUCTION

At the request of Mr. Keith Chase, field coordinator for the LDS Church, Salt Lake City, Utah, Snake River Asbestos, Inc. conducted an asbestos monitoring survey for the Menan Ward Building, Menan, Idaho. The survey was conducted on October 10, 1987. This survey was conducted to determine the possible presence and location of friable asbestos in the Ward Building. If asbestos was present, it was intended that Snake River Asbestos, Inc. would prepare recommendations for an asbestos control program, and specifications for a removal. see ATTACHED 4/27/02

This report summarizes work conducted to date by Snake River Asbestos, Inc., for the Menan Ward Building, including results of a survey conducted by Mr. James Farley.

## PROJECT PERSONNEL

The Project Director for the Menan 1 & 2 Wards Building is Dr. Wayne Dorband. Dr. Dorband has extensive experience in the asbestos abatement industry and has an excellent reputation with regulatory agency officials. Project microscopist is Ms. Debra Dorband, who also has extensive microscopy experience working with asbestos-containing materials.

## ASBESTOS SURVEY RESULTS

### Methodology

On October 10, 1987, Mr. James Farley, asbestos professional for Snake River Asbestos, Inc., conducted a walk-thru inspection of the Menan 1 & 2 Wards Building, as directed by Keith Chase, representative for the building. All areas of the building were inspected at this time.

Careful notes were taken detailing any materials which appeared friable and could possibly contain asbestos. Eight bulk samples were collected from suspicious materials in the building. All sampling locations for bulk samples were selected discriminately to represent all possible friable asbestos sources in the facility. Presence of asbestos in one given type of insulation was assumed to represent a similar presence in visually similar insulation in any part of the building.

Following collection, all bulk samples of insulation material were returned to Snake River's laboratory for microscopic analysis. The EPA methods for analysis of bulk asbestos samples using polarizing light microscopy were used.



Initially, samples were characterized visually by the microscopist, and if multiple layers were present, these layers were separated and analyzed individually. If samples were not layered, but were also not homogeneous, they were ground with a porcelain mortar and pestal until homogeneous. Microscope slides were prepared with 1.550 refractive index fluid and analyzed using an Olympus BH-2 polarizing light microscope by the method outlined in the Federal Register and endorsed by the EPA and NIOSH. All samples are maintained at our Boise laboratory for at least one year following project completion.

#### Survey Observations and Sample Analysis Results

Survey results and observations will be reported by area for each of the Menan 1 & 2 Wards Building areas which contained suspicious materials. Sample analysis report forms for the materials analyzed are included in the Appendix and are referred to in the text for each area.

#### Boiler Room

Straight runs of pipe in the boiler room area are insulated with fiberglass materials. However, fittings in the boiler room are insulated with a suspicious material which was sampled by Mr. Farley. Sample analysis indicated that the fittings materials did contain asbestos materials (Appendix A; Samples W-103-MEN1 & MEN2). There are approximately 67 fittings in the boiler room which are insulated with asbestos materials. These fittings are in good condition, but have high accessibility and exposure.

There is also a duct cloth which connects the boiler to the ducting leaving it. This material was sampled and found to contain asbestos (Appendix A; Sample W-103-MEN3). There were approximately 3 square feet of this material. This material was in good condition, but had high exposure and accessibility.

Finally, there are approximately 340 square feet of tile in the boiler room which appears suspicious in its composition. However, sample analysis of this tile indicated that it was completely free of asbestos (Appendix A; Sample W-103-MEN4). There were no other sources of friable asbestos material identified in the boiler room area.

#### Northeast Room

The Northeast Room in the basement area has a tile flooring which appeared suspicious during Mr. Farley's inspection. Sample analysis of this flooring indicated that it did contain asbestos materials (Appendix A; Sample W-103-MEN5). There are approximately 360 square feet of this tile present in the room. It has very low friability, but it is highly exposed and accessible. There were no other sources of friable asbestos material present in the Northeast Room.

## Tunnel

All of the straight runs of pipe in the tunnel area are insulated with fiberglass, but the joints in the area were suspicious and therefore sampled by Mr. Farley. Sample analysis indicated that they do contain asbestos materials (Appendix A; Sample W-103-MEN6). There are approximately 53 of these joints present in the tunnel. These joints are in moderate condition and have low exposure and accessibility. There were no other sources of friable asbestos identified in the tunnel area.

## Basement Rooms

These rooms are located throughout the basement, and there are short sections of air-cell type asbestos pipe insulation present in several of them. There is a total of approximately 8 linear feet of these short sections present. These insulation sections are in moderate condition, but have high exposure and accessibility. There were no other sources of friable asbestos identified in this room.

## Southeast Room

There are approximately 7 fittings present in this room which are insulated with asbestos-containing materials. These fittings are in good condition, they have high exposure and accessibility. However, they will be enclosed in a chase in the upcoming major remodel of the building. There were no other sources of friable asbestos material present in this room.

## Clerk's Office

There is a linoleum flooring in this room which appeared suspicious when surveyed by Mr. Farley. Sample analysis of this flooring indicated that it did contain asbestos material (Appendix A; Sample W-103-MEN3).

There were approximately 120 square feet of this linoleum present in the room. This material is in good condition, but has high exposure and accessibility. There were no other sources of friable asbestos identified in the Clerk's office area.

## All Other Building Areas

The only other source of potential suspicious material throughout the rest of the building was where ceiling tiles were found in the building. However, sample analysis of these tiles (Appendix A; Sample W-103-MEN7) indicated that they were completely free of asbestos materials. There were no other sources of friable asbestos identified throughout the rest of the building during our survey.



## ASBESTOS - MAINTENANCE CONTROL PROGRAM RECOMMENDATIONS

Concern over exposure to asbestos fibers has increased dramatically in recent years. Direct links between asbestos exposure and the occurrence of asbestos- and mesothelioma have been established. Also, a clear relationship between the age at first exposure to asbestos and the probability of developing cancer has been determined. Consequently, the Environmental Protection Agency and OSHA have recommended that, in addition to owners of public and private buildings survey their buildings to determine if asbestos is present. If friable asbestos-containing materials are found in buildings, the building owner should take the following actions:

1. Inform all employees who might disturb the material of its presence.
2. Provide each custodial or maintenance employee with a copy of a Guide for Reducing Asbestos Exposure.
3. Maintain accurate records related to asbestos location, sampling, analysis, amount, and exposure.

Because friable asbestos is present in the Menan 12 - Ward - Building, it is recommended to take all of the following actions. I will provide all the needed documentation materials to the regulatory agencies and will also prepare all of the paperwork which the Church should maintain in the Ward's files. I will provide the Church with enough copies of A Guide to Reducing Asbestos Exposure to distribute to its maintenance personnel. If the Church desires, I will also assist it in making notification of the asbestos presence to any labor groups, should that become necessary.

The Environmental Protection Agency lists a number of factors which must be considered when assessing the need for corrective action related to friable asbestos-containing materials. These factors concern the condition of the material and the potential for disturbance or erosion. The condition of the material is evaluated for deterioration, delamination, physical damage or water damage. The potential for disturbance or erosion of asbestos-containing materials is affected by its proximity to air plenum or direct activity, new or old material, and possible change in a building's use. Following visual inspection of a building and completion of laboratory analysis, occurrence of action is detected. The course of action to be presented as a decision making tree (Figure 1), the suitability of various control alternatives (Table 1) can then be evaluated.

There are four possible alternative courses for handling the abatement of friable asbestos in public and private buildings:

- encapsulation
- enclosure
- removal and reconstruction
- deferred action and maintenance

The advantage and disadvantages of each action are presented in Table 1. Removal and encapsulation is the most permanent alternative, but it is also the most expensive. Removal of asbestos containing insulation requires sealing off the area where the removal is occurring and reconstructing a clean room. Encapsulation is a lower cost alternative to removal. Encapsulation involves applying a penetrating liquid to the asbestos-containing material to seal it and prevent fiber release. Encapsulation also requires construction of containment barriers. Unfortunately, encapsulation does not solve the asbestos problem completely, because if the building is ever renovated or demolished the asbestos-containing material must first be removed using the appropriate safety procedures. Enclosure is an alternative which involves building air-tight barriers around a be for-containing insulation material to protect against fiber release. Enclosure is often a more expensive alternative than removal but life encapsulation it is not a permanent control method should renovation or demolition occur. Deferred action involves a program of maintenance personnel cleaning and implementing proper asbestos insulation maintenance, coupled with an air quality monitoring program. Deferred action is only recommended when asbestos containing materials are inaccessible, in good condition, and relatively small in coverage area.

The areas in the Main 1 & 2 Warus Building where asbestos was found were found (evaluated) in relation to the criteria discussed above (Table 1). The EPA algorithm for asbestos containment evaluation was used to determine a recommended course of action for each area of the building.

#### Boiler Room

Because this building will be undergoing a major remodel, the friable asbestos identified in the building will need to be carefully removed. In the boiler room, the fittings and duct connecting cloth will need to be removed by a competent asbestos abatement contractor. These fittings and ducting material should be removed in a 1-day period for an estimated cost of \$2,000.

#### Northwest Corridor

The floor tile in the boiler room will also need to be removed prior to the major remodel which is soon to be conducted. There are approximately 200 square feet of floor tile which should be removed for approximately \$15,000, and be completed in approximately 1 day.

Since there is an existing new framing for the interior walls on top of the tile it may pose some problem in the removal process. That issue will need to be dealt with at the time of removal.



## Summary

Again, because of the major remodel plans of the building, all the joint insulation present in the tunnel should be removed at the same time as other removal is completed throughout the building. These fittings should be removed using a modified glove-bag or total enclosure system. It should be removed for approximately 1000 to 11,000 in a 1-2 day period.

## Basement Foams

The hot sections of air-cell insulation going into the basement should also be removed during a complete removal project for the building. This is a fairly simple removal which can be conducted using glove bags. This process should be completed for approximately \$100 in a couple of hours.

## Southeast Room

Because the fittings in this area will be enclosed in a chase, they will not be required to be removed, but should probably be removed for future considerations, since they are enclosed. This is a fairly simple removal when combined with the removal in the other rooms in the basement and still cost less than \$100 to complete.

## Client's Office

The linoleum in this room which contains asbestos should also be removed during the complete removal project for the building prior to the major remodel. This insulation is in good condition, but will be required to be removed along with everything else in the building. This is a fairly simple process which should cost approximately \$500 and take approximately 1 day to complete.

Any other asbestos materials present in the building which were not accessible during our survey should also be removed during a removal project prior to the major remodel which will be conducted in the building.

### STATEMENT OF WORK ACTIVITIES

We are prepared to complete project descriptions for the removal work recommended for this building. We will distribute the information to appropriate abatement contractors and with the Church's approval, will award a contract to the qualified low bidder for the project.

Following project award, we will coordinate the project activities with the selected abatement contractor and will supervise all removal activities. This supervision will include extensive air monitoring and taking actions required to assure compliance with project specifications. At the completion of the project, we will certify the contractor, proper completion and release him/her from the project. We will provide a comprehensive project report to the Ward for filing purposes.

### ESTIMATED PROJECT TIMELINE

- 1 Project survey and report October, 1987
- 2 Preparation of project descriptions October, 1987
- 4 Distribution of project description to contractor October 1987
- 3 Selection of project contractor October, 1987
- 5 Project initiation October, 1987
- 6 Project completion November, 1987



ESTIMATED PROJECT BUDGET


I	Professional Consulting Costs		
	A Preliminary survey		
	Professional time @ 1.00/hr	\$475.00	
	Mileage - 40 miles @ .20	78.20	
	Expenses	5.00	
	Sample analysis		
	Rull samples - 8 @ \$25/ea	200.00	
	Total	<u>\$778.20</u>	
	B Bid Specification	\$200.00	
	C Project supervision and testing		
	Professional time - 4 hrs @ \$25/hr	\$100.00	
	Sample analysis		
	Air samples 21 @ \$20/ea	420.00	
	Travel costs	400.00	
	Total	<u>\$1,660.00</u>	
	TOTAL CONSULTING COSTS	\$2,638.20	
	D removal costs		
	A Boiler Room	\$ 1,500.00	
	B Refrigerant Room	1,000.00	
	C Furnace	1,000.00	
	D Forms	100.00	
	E Client's Office	500.00	
	TOTAL REMOVAL COSTS (CONTRACTOR)	<u>\$4,100.00</u>	
			<u>\$6,600.00</u>

**Table 1: Comparison of Various Asbestos Control Alternatives**

Method	Advantages	Disadvantages	Appropriate applications	Inappropriate applications	General comments
Removal	<p>Eliminates asbestos source</p> <p>Eliminates need for special operations and maintenance program</p>	<p>Replacement with substitute material may be necessary</p> <p>Porous surfaces also may require encapsulation</p> <p>Improper removal may raise fiber levels</p>	Always	Never	<p>Containment barriers needed</p> <p>Worker protection required</p> <p>Wet removal is required for all types of asbestos. (amcots will not absorb water or water with traditional wetting agents)</p> <p>Disposal may be a problem in some areas</p> <p>Unusual circumstances, complex surfaces, and the presence of utilities may require special removal techniques</p>
Enclosure	<p>Reduces exposure in the area outside the enclosure</p> <p>Initial costs may be lower than removal unless utilities need relocating or major changes</p> <p>Usually does not require replacement of material</p>	<p>Asbestos source remains and must be removed eventually</p> <p>Fiber release continues behind enclosure</p> <p>Special operations program required to control access to enclosure for maintenance and renovation</p> <p>Periodic reinspection required to check for damage</p> <p>Repair of damaged enclosure necessary</p> <p>Fibers released in dry form during construction of enclosure</p> <p>Long-term costs could be higher than removal</p>	<p>When materials need to be isolated from building occupants (e.g. exposed pipe)</p> <p>Disturbance or entry into enclosed area unlikely</p>	<p>Damaged or deteriorating materials causing rapid fiber release</p> <p>Water damage evident</p> <p>Damage or entry into enclosure likely</p> <p>Ceiling to be enclosed is low</p>	<p>Containment barriers needed</p> <p>Use of tools with HEPA-attached vacuum attachments advisable</p> <p>Worker protection needed</p>



**Figure 1 Steps in Selecting a Course of Action for Asbestos Abatement**

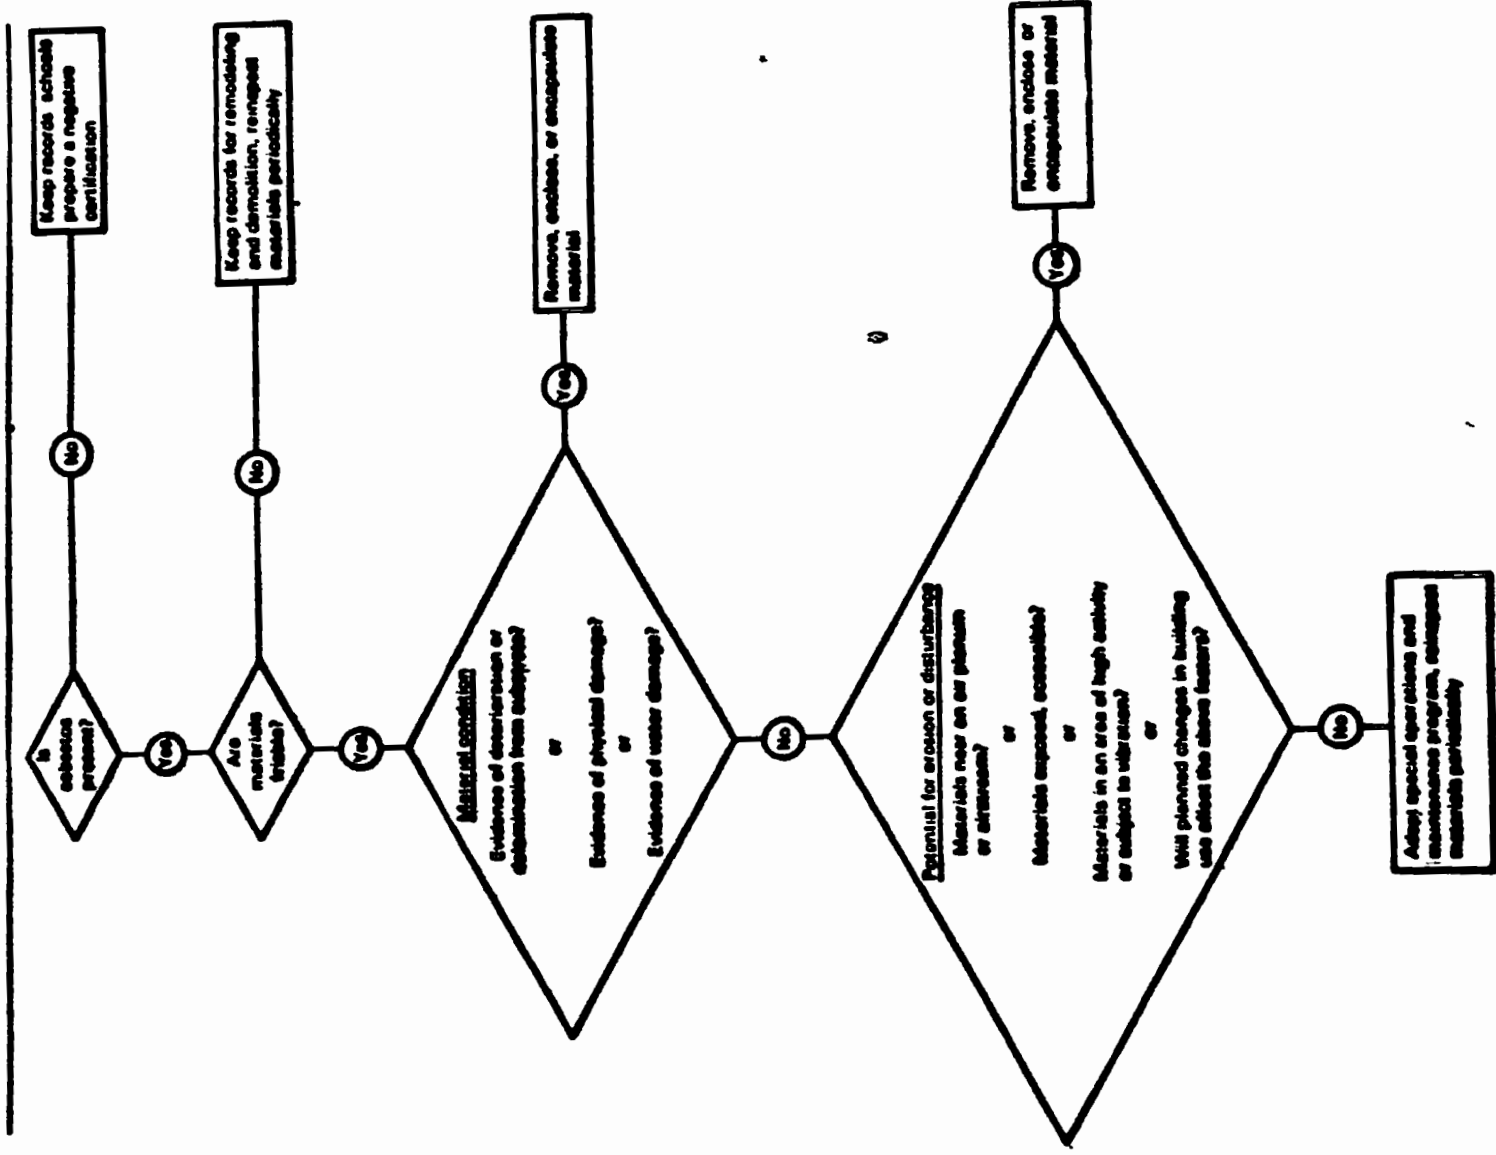

**\*A statement certifying that friable asbestos-containing materials are not present.**

APPENDIX "A"



Date Reported:

October 9, 1987

Date Received:


October 2, 1987

Sample Code No:

W-103-MEN1 thru MEN8

Submitted By:

Menan Wards 1 & 2

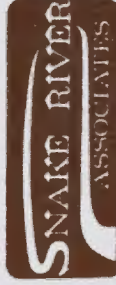

Snake River Associates, Inc.

1310 Vista, Suite 1A  
Boise, Idaho 83705  
208/336-4993

Sample Identification:

W-103-MEN1: Boiler room fitting

W-103-MEN2: Boiler room fitting

CLIENT:  LDS Building Services

3295 Elder- Suite 350

W-103-MEN3: Boiler room duct cloth

Boise, Idaho 83705

W-103-MEN4: Boiler room floor tile

Sample Identification Number	Percent & Type of Asbestos Present	Percent & Type of Other Fibrous Materials	Sample Appearance
W-103-MEN1	11% ± 3% Chrysotile	Mineral wool, fiberglass	Fiberglass w/mudded lagging
W-103-MEN2	6% ± 2% Amosite	Fiberglass, mineral wool	Off-white, powdery
W-103-MEN3	94% ± 2% Chrysotile	Wood fiber	Grey cloth
W-103-MEN4	None detected	Cellulose	Beige tile

Was sample homogenized:  Yes  No

Method of Analysis: Polarized Light Microscopy (Olympus BH2 polarizing light microscope)

Analyst: Deb Dorband


I certify that these results are accurate for the samples obtained and comply with accepted methods of analysis

*Wayne Dorband*  
Authorized Signature

Wayne Dorband, PhD.  
President

Date Reported:  
ate Received:  
Sample Code No:  
Submitted By:

October 9, 1987  
October 2, 1987  
W-103-MEN1 thru MEN8

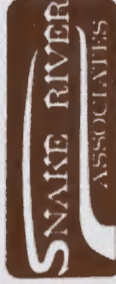

Snake River Associates, Inc.  
1310 Vista, Suite 1A  
Boise, Idaho 83705  
208/336-4993

Merian Wards 1 & 2

Sample Identification.

W-103-MEN5: Basement classroom floor tile  
W-103-MEN6: Tunnel fitting  
W-103-MEN7: All areas- ceiling tile  
W-103-MEN8: Clerks Office- floor tile

CLIENT: [ LDS Building Services  
3295 Elder- Suite 350  
Boise, Idaho 83705 ]

Sample Identification Number	Percent & Type of		Sample Appearance
	Asbestos Present	Other Fibrous Materials	
W-103-MEN5	3% ± 2% Chrysotile	None	Grey tile
W-103-MEN6	1% ± 1% Amosite	Fiberglass	Off-white, powdery
W-103-MEN7	None detected	Wood fiber	Tan, pressed fibrous
W-103-MEN8	83% ± 3% Chrysotile	Cellulose	Mosaic tile w/white paper back

Was sample homogenized:  Yes  No

Method of Analysis: Polarized Light Microscopy (Olympus BH2 polarizing light microscope)

Analyst: Deb Dorband

I certify that these results are accurate for the samples obtained and comply with accepted methods of analysis

Authorized Signature

Wayne Dorband, PhD.  
President



THE CHURCH OF  
JESUS CHRIST  
OF LATTER-DAY  
SAINTS

PHYSICAL FACILITIES DEPARTMENT  
North America—Northwest  
P O Box 15309  
Boise Idaho 83715

23 September 1987

Wayne Dorband  
Snake River Associates, Inc  
1310 Vista, Suite 1A  
Boise, Idaho 83705

Re Menan 1 and 2 Wards  
Menan Idaho Stake  
507-2638-75

Dear Wayne

Your firm has been selected to provide professional services for identifying asbestos at the referenced building. Accordingly, this letter is your authorization to begin that work.

In order to have access to the building located Main Street, Menan, Idaho, you will need to contact the Stake Physical Facilities Representative (PFR). The PFR will be responsible to see that you have access to the building. A custodian will have keys to every area of the building, including mechanical rooms, attics, and crawl space. The PFR is

Clyde R Jones  
Rt #1, Box 45  
Rigby, Idaho 83442  
208-754-4782

If you are unable to contact the PFR, please call our Area Field Representative, Keith Chase, at (208) 529-4316 for assistance, or you may call the contract architect, Dixon-Watson Associates, P O Box 1101, Idaho Falls Idaho, 83403, (208) 522-4764

If you have any questions, please call me at (208) 342-2735

Sincerely,




Kent L Brough  
Area Architect

KLB cm







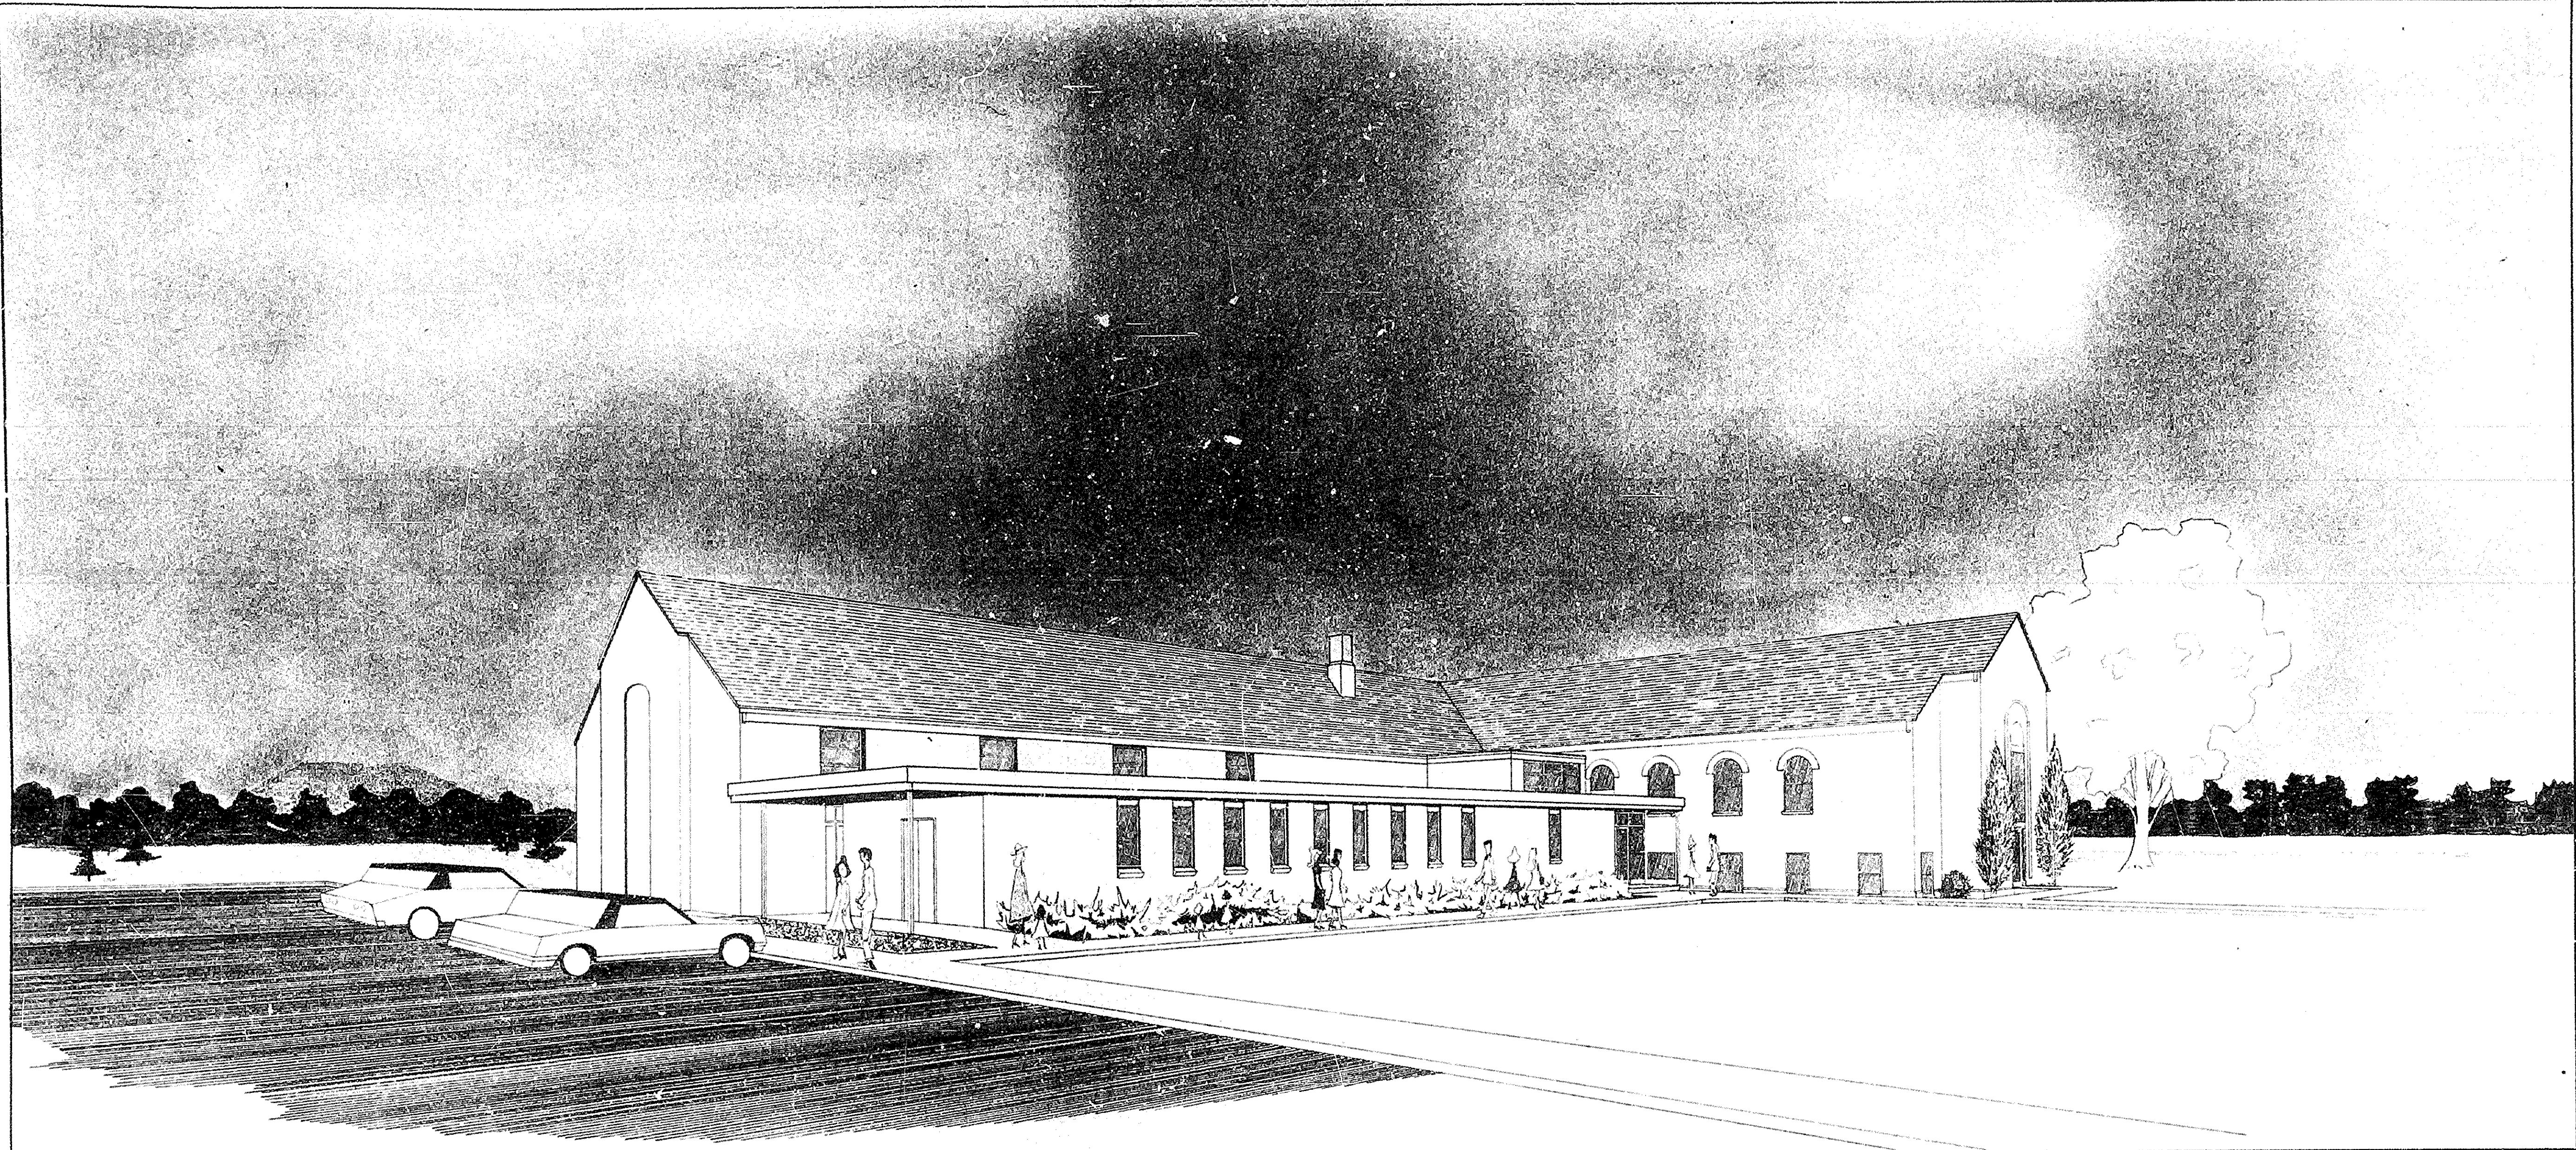

REFERENCE MARKS		KEY TO MATERIALS		ABBREVIATIONS		INDEX TO DRAWINGS																																																																																			
<p><b>DETAIL REFERENCE</b></p> <p>AD - DETAIL MARK AD - SHEET NUMBER</p> <p><b>SECTION REFERENCE</b></p> <p>AD - DIRECTION AD - SECTION MARK AD - SHEET NUMBER</p> <p><b>ELEVATION REFERENCE</b></p> <p>AD - DIRECTION AD - ELEVATION MARK AD - SHEET NUMBER</p> <p><b>DOOR REFERENCE</b></p> <p>AD - DOOR NUMBER</p> <p><b>FOLDING PARTITION REFERENCE</b></p> <p>AD - FOLDING PARTITION NUMBER</p> <p><b>WINDOW REFERENCE</b></p> <p>AD - WINDOW MARK</p> <p><b>ROOM NUMBER REFERENCE</b></p> <p>AD - ROOM NUMBER</p> <p><b>ELEVATION MARK</b></p> <p>AD - ELEVATION MARK AD - FLOOR</p>	<p><b>STRUCTURAL REFERENCE</b></p> <p>FR - NO. OF UNIT &amp; DESCRIPTION (SEE ABBREVIATIONS) S-2 - STRUCTURAL SCHEDULE SHEET NO.</p> <p><b>STRUCTURAL SCHEDULE ABBREVIATIONS</b></p> <p>F-1 - FOOTING F-2 - FOUNDATION WALL REINFORCING F-3 - REINFORCING BOWEL F-4 - CONCRETE SLAB F-5 - WALL BEARING PLATE F-6 - LEDGER PLATE F-7 - BEAM F-8 - MASONRY BOND BEAM F-9 - LINTEL</p>	<p><b>KEY OF SYMBOLS</b></p> <p>— E — POWER LINE — S — ELECTRICAL SERVICE — W — SEWER-WASTE LINE — HW — HOT WATER LINE — CW — COLD WATER LINE — PL — PROPERTY LINE — CL — CENTER LINE — EX — EXISTING ELEVATION LOCATION — F — FINISH ELEVATION LOCATION</p>	<p>EA - EARTH GR - GRAVEL CO - CONCRETE MA - MASONRY TR - TRAVERTINE FW - FRAME WALL RW - ROUGH WOOD PL - PLYWOOD</p> <p>FW - FINISH WOOD ME - METAL PL - PLASTER GB - GYPSUM BOARD AT - ACOUSTIC TILE CT - CERAMIC TILE RI - RIGID INSULATION BI - BATT INSULATION GL - GLASS</p>	<p>BM - BENCH MARK CB - CHALK BOARD CC - CENTER TO CENTER CI - CAST IRON CO - CLEAN OUT DF - DRINKING FOUNTAIN FD - FLOOR DRAIN GI - GALVANIZED IRON HB - HOSE BIB MO - MASONRY OPENING N.C. - NOT IN CONTACT O.C. - ON CENTER O.D. - OUTSIDE DIAMETER T.B. - TACK BOARD W.D. - WINDOW DIMENSION CL - CENTER LINE REG. - REGLET GYP. B. - GYPSUM BOARD N.T.S. - NOT TO SCALE E.W.C. - ELECTRIC WATER COOLER I.D. - INSIDE DIAMETER F.E.C. - FIRE EXTINGUISHER CABINET D.S. - DOWNSPOUT</p>	<p><b>INDEX TO DRAWINGS</b></p> <table border="1"> <thead> <tr> <th>SHEET</th> <th>TITLE</th> <th>SHEET</th> <th>TITLE</th> </tr> </thead> <tbody> <tr><td>A1</td><td>PLOT PLAN</td><td>S1</td><td>FOOTING &amp; FOUNDATION PLAN &amp; SCHEDULE</td></tr> <tr><td>A2</td><td>BASEMENT FLOOR PLAN</td><td>S2</td><td>ROOF FRAMING PLAN &amp; SCHEDULE</td></tr> <tr><td>A3</td><td>MAIN FLOOR PLAN</td><td>S3</td><td>STRUCTURAL DETAILS</td></tr> <tr><td>A4</td><td>CLEBBESTORY PLAN &amp; DETAILS</td><td>S4</td><td>STRUCTURAL DETAILS &amp; SCHEDULE</td></tr> <tr><td>A5</td><td>ELEVATIONS - BUILDING LETTERS DETAILS</td><td>S5</td><td>WOOD-LAM. ARCH. &amp; TRUSSES DETAIL DETAILS</td></tr> <tr><td>A6</td><td>DOOR SCHEDULE &amp; DETAILS</td><td>S6</td><td>MASONRY WALL REINFORCING &amp; BOND BEAM LAYOUT</td></tr> <tr><td>A7</td><td>WINDOW SCHEDULE &amp; DETAILS</td><td>S7</td><td>SUSPENDED CEILING DRAWING PLAN &amp; DETAILS</td></tr> <tr><td>A8</td><td>3/4" SECTIONS</td><td>M1</td><td>PLOT PLAN &amp; SCHEDULE</td></tr> <tr><td>A9</td><td>3/4" SECTIONS</td><td>M2</td><td>BASEMENT MECHANICAL PLAN</td></tr> <tr><td>A10</td><td>3/4" SECTIONS</td><td>M3</td><td>MAIN FLOOR MECHANICAL PLAN</td></tr> <tr><td>A11</td><td>3/4" SECTIONS &amp; DETAILS</td><td>M4</td><td>FAN ROOM AND BOILER ROOM PLAN</td></tr> <tr><td>A12</td><td>1/2" BUILDING SECTIONS</td><td>E1</td><td>PLOT PLAN &amp; SCHEDULE</td></tr> <tr><td>A13</td><td>REFLECTED CEILING PLAN &amp; DETAILS</td><td>E2</td><td>MAIN LEVEL ELECTRICAL PLAN</td></tr> <tr><td>A14</td><td>ENLARGED KITCHEN &amp; REST ROOM PLANS &amp; DETAILS</td><td>E3</td><td>BASEMENT LEVEL ELECTRICAL PLAN</td></tr> <tr><td>A15</td><td>INTERIOR ELEVATIONS &amp; MILLWORK DETAILS</td><td>C1</td><td>SOUND PLAN</td></tr> <tr><td>A16</td><td>ENLARGED LIBRARY PLAN &amp; ELEVATIONS &amp; DETAILS</td><td></td><td></td></tr> <tr><td>A17</td><td>LIBRARY MILLWORK DETAILS</td><td></td><td></td></tr> <tr><td>A18</td><td>CULTURAL HALL INTERIOR ELEVATIONS</td><td></td><td></td></tr> <tr><td>A19</td><td>BASEMENT FINISH &amp; FURNISHING PLAN</td><td></td><td></td></tr> <tr><td>A20</td><td>MAIN FLOOR FINISH &amp; FURNISHING PLAN</td><td></td><td></td></tr> </tbody> </table>	SHEET	TITLE	SHEET	TITLE	A1	PLOT PLAN	S1	FOOTING & FOUNDATION PLAN & SCHEDULE	A2	BASEMENT FLOOR PLAN	S2	ROOF FRAMING PLAN & SCHEDULE	A3	MAIN FLOOR PLAN	S3	STRUCTURAL DETAILS	A4	CLEBBESTORY PLAN & DETAILS	S4	STRUCTURAL DETAILS & SCHEDULE	A5	ELEVATIONS - BUILDING LETTERS DETAILS	S5	WOOD-LAM. ARCH. & TRUSSES DETAIL DETAILS	A6	DOOR SCHEDULE & DETAILS	S6	MASONRY WALL REINFORCING & BOND BEAM LAYOUT	A7	WINDOW SCHEDULE & DETAILS	S7	SUSPENDED CEILING DRAWING PLAN & DETAILS	A8	3/4" SECTIONS	M1	PLOT PLAN & SCHEDULE	A9	3/4" SECTIONS	M2	BASEMENT MECHANICAL PLAN	A10	3/4" SECTIONS	M3	MAIN FLOOR MECHANICAL PLAN	A11	3/4" SECTIONS & DETAILS	M4	FAN ROOM AND BOILER ROOM PLAN	A12	1/2" BUILDING SECTIONS	E1	PLOT PLAN & SCHEDULE	A13	REFLECTED CEILING PLAN & DETAILS	E2	MAIN LEVEL ELECTRICAL PLAN	A14	ENLARGED KITCHEN & REST ROOM PLANS & DETAILS	E3	BASEMENT LEVEL ELECTRICAL PLAN	A15	INTERIOR ELEVATIONS & MILLWORK DETAILS	C1	SOUND PLAN	A16	ENLARGED LIBRARY PLAN & ELEVATIONS & DETAILS			A17	LIBRARY MILLWORK DETAILS			A18	CULTURAL HALL INTERIOR ELEVATIONS			A19	BASEMENT FINISH & FURNISHING PLAN			A20	MAIN FLOOR FINISH & FURNISHING PLAN		
SHEET	TITLE	SHEET	TITLE																																																																																						
A1	PLOT PLAN	S1	FOOTING & FOUNDATION PLAN & SCHEDULE																																																																																						
A2	BASEMENT FLOOR PLAN	S2	ROOF FRAMING PLAN & SCHEDULE																																																																																						
A3	MAIN FLOOR PLAN	S3	STRUCTURAL DETAILS																																																																																						
A4	CLEBBESTORY PLAN & DETAILS	S4	STRUCTURAL DETAILS & SCHEDULE																																																																																						
A5	ELEVATIONS - BUILDING LETTERS DETAILS	S5	WOOD-LAM. ARCH. & TRUSSES DETAIL DETAILS																																																																																						
A6	DOOR SCHEDULE & DETAILS	S6	MASONRY WALL REINFORCING & BOND BEAM LAYOUT																																																																																						
A7	WINDOW SCHEDULE & DETAILS	S7	SUSPENDED CEILING DRAWING PLAN & DETAILS																																																																																						
A8	3/4" SECTIONS	M1	PLOT PLAN & SCHEDULE																																																																																						
A9	3/4" SECTIONS	M2	BASEMENT MECHANICAL PLAN																																																																																						
A10	3/4" SECTIONS	M3	MAIN FLOOR MECHANICAL PLAN																																																																																						
A11	3/4" SECTIONS & DETAILS	M4	FAN ROOM AND BOILER ROOM PLAN																																																																																						
A12	1/2" BUILDING SECTIONS	E1	PLOT PLAN & SCHEDULE																																																																																						
A13	REFLECTED CEILING PLAN & DETAILS	E2	MAIN LEVEL ELECTRICAL PLAN																																																																																						
A14	ENLARGED KITCHEN & REST ROOM PLANS & DETAILS	E3	BASEMENT LEVEL ELECTRICAL PLAN																																																																																						
A15	INTERIOR ELEVATIONS & MILLWORK DETAILS	C1	SOUND PLAN																																																																																						
A16	ENLARGED LIBRARY PLAN & ELEVATIONS & DETAILS																																																																																								
A17	LIBRARY MILLWORK DETAILS																																																																																								
A18	CULTURAL HALL INTERIOR ELEVATIONS																																																																																								
A19	BASEMENT FINISH & FURNISHING PLAN																																																																																								
A20	MAIN FLOOR FINISH & FURNISHING PLAN																																																																																								
CLASS C CONSTRUCTION FOR FIRE INSURANCE ONLY						136C6S																																																																																			
						<p>APPROVED: _____</p> <p>CHECKED: _____</p> <p>DRAWN: _____</p> <p>ADDITION &amp; REMOVAL OF MENNON TO A MENNON TWO WALKS MEETINGHOUSE. RUBY STAKE THE CHURCH OF JESUS CHRIST OF LATTER DAY SAINTS MENNON</p> <p><b>HAROLD E. COLLARD</b> ARCHITECT A.I.A. IDAHO FALLS, IDAHO</p> <p>PROJECT NUMBER: _____</p> <p>05-507-2638-A</p> <p>SHEET NUMBER: _____</p> <p>TITLE: _____</p>																																																																																			






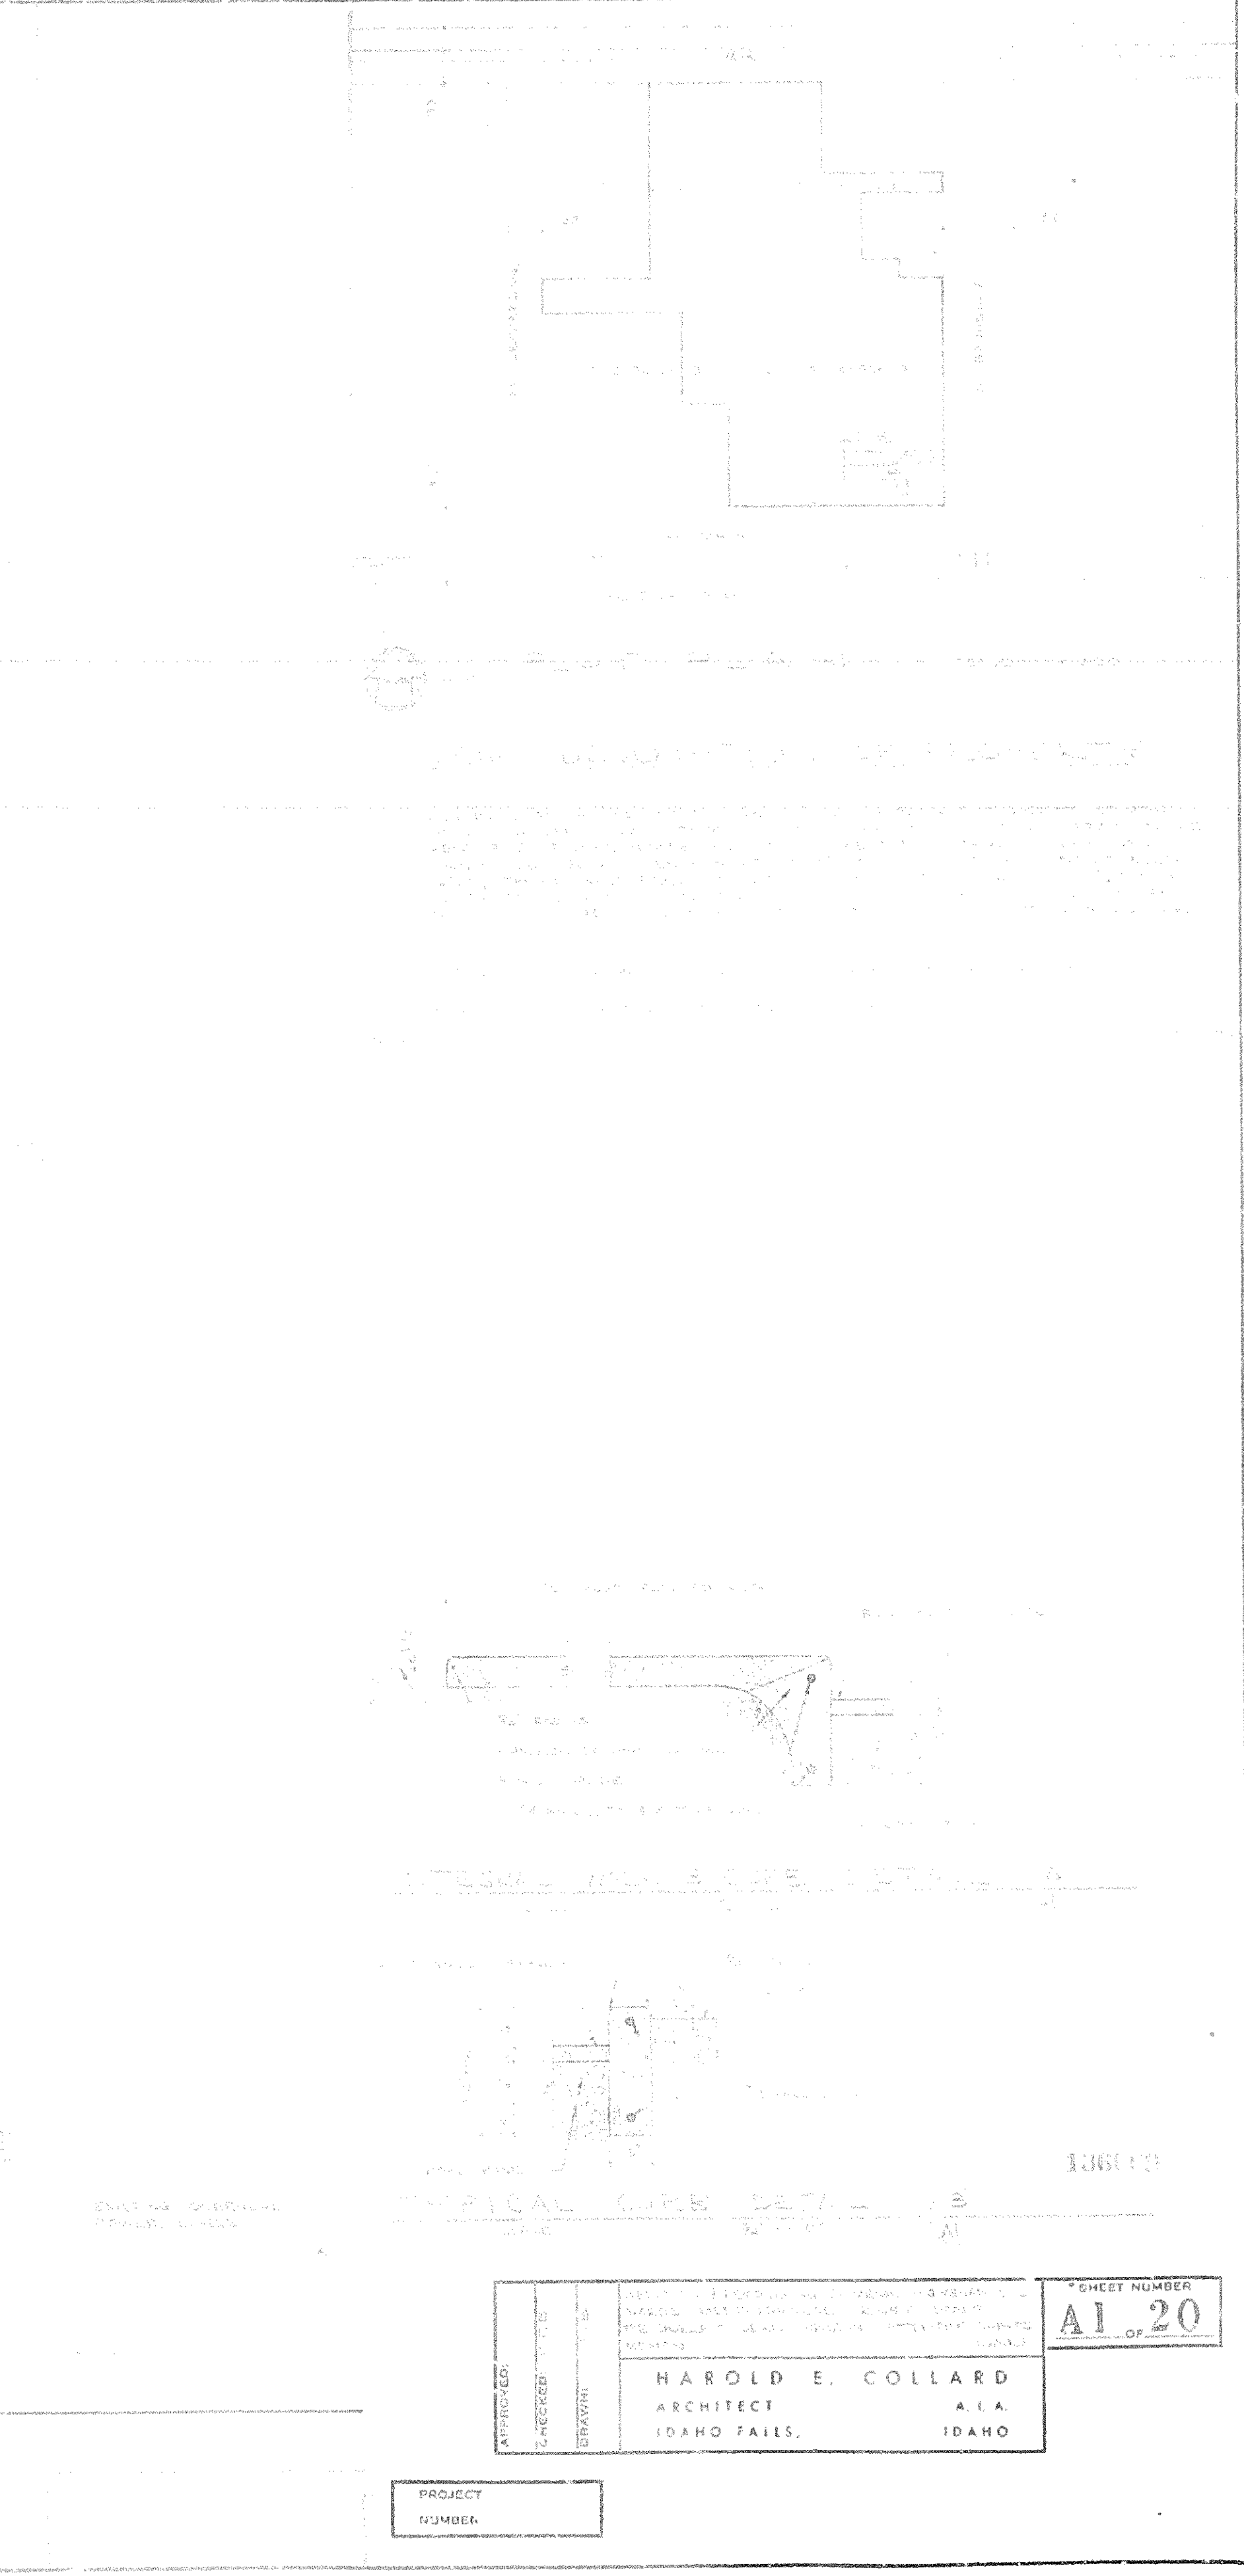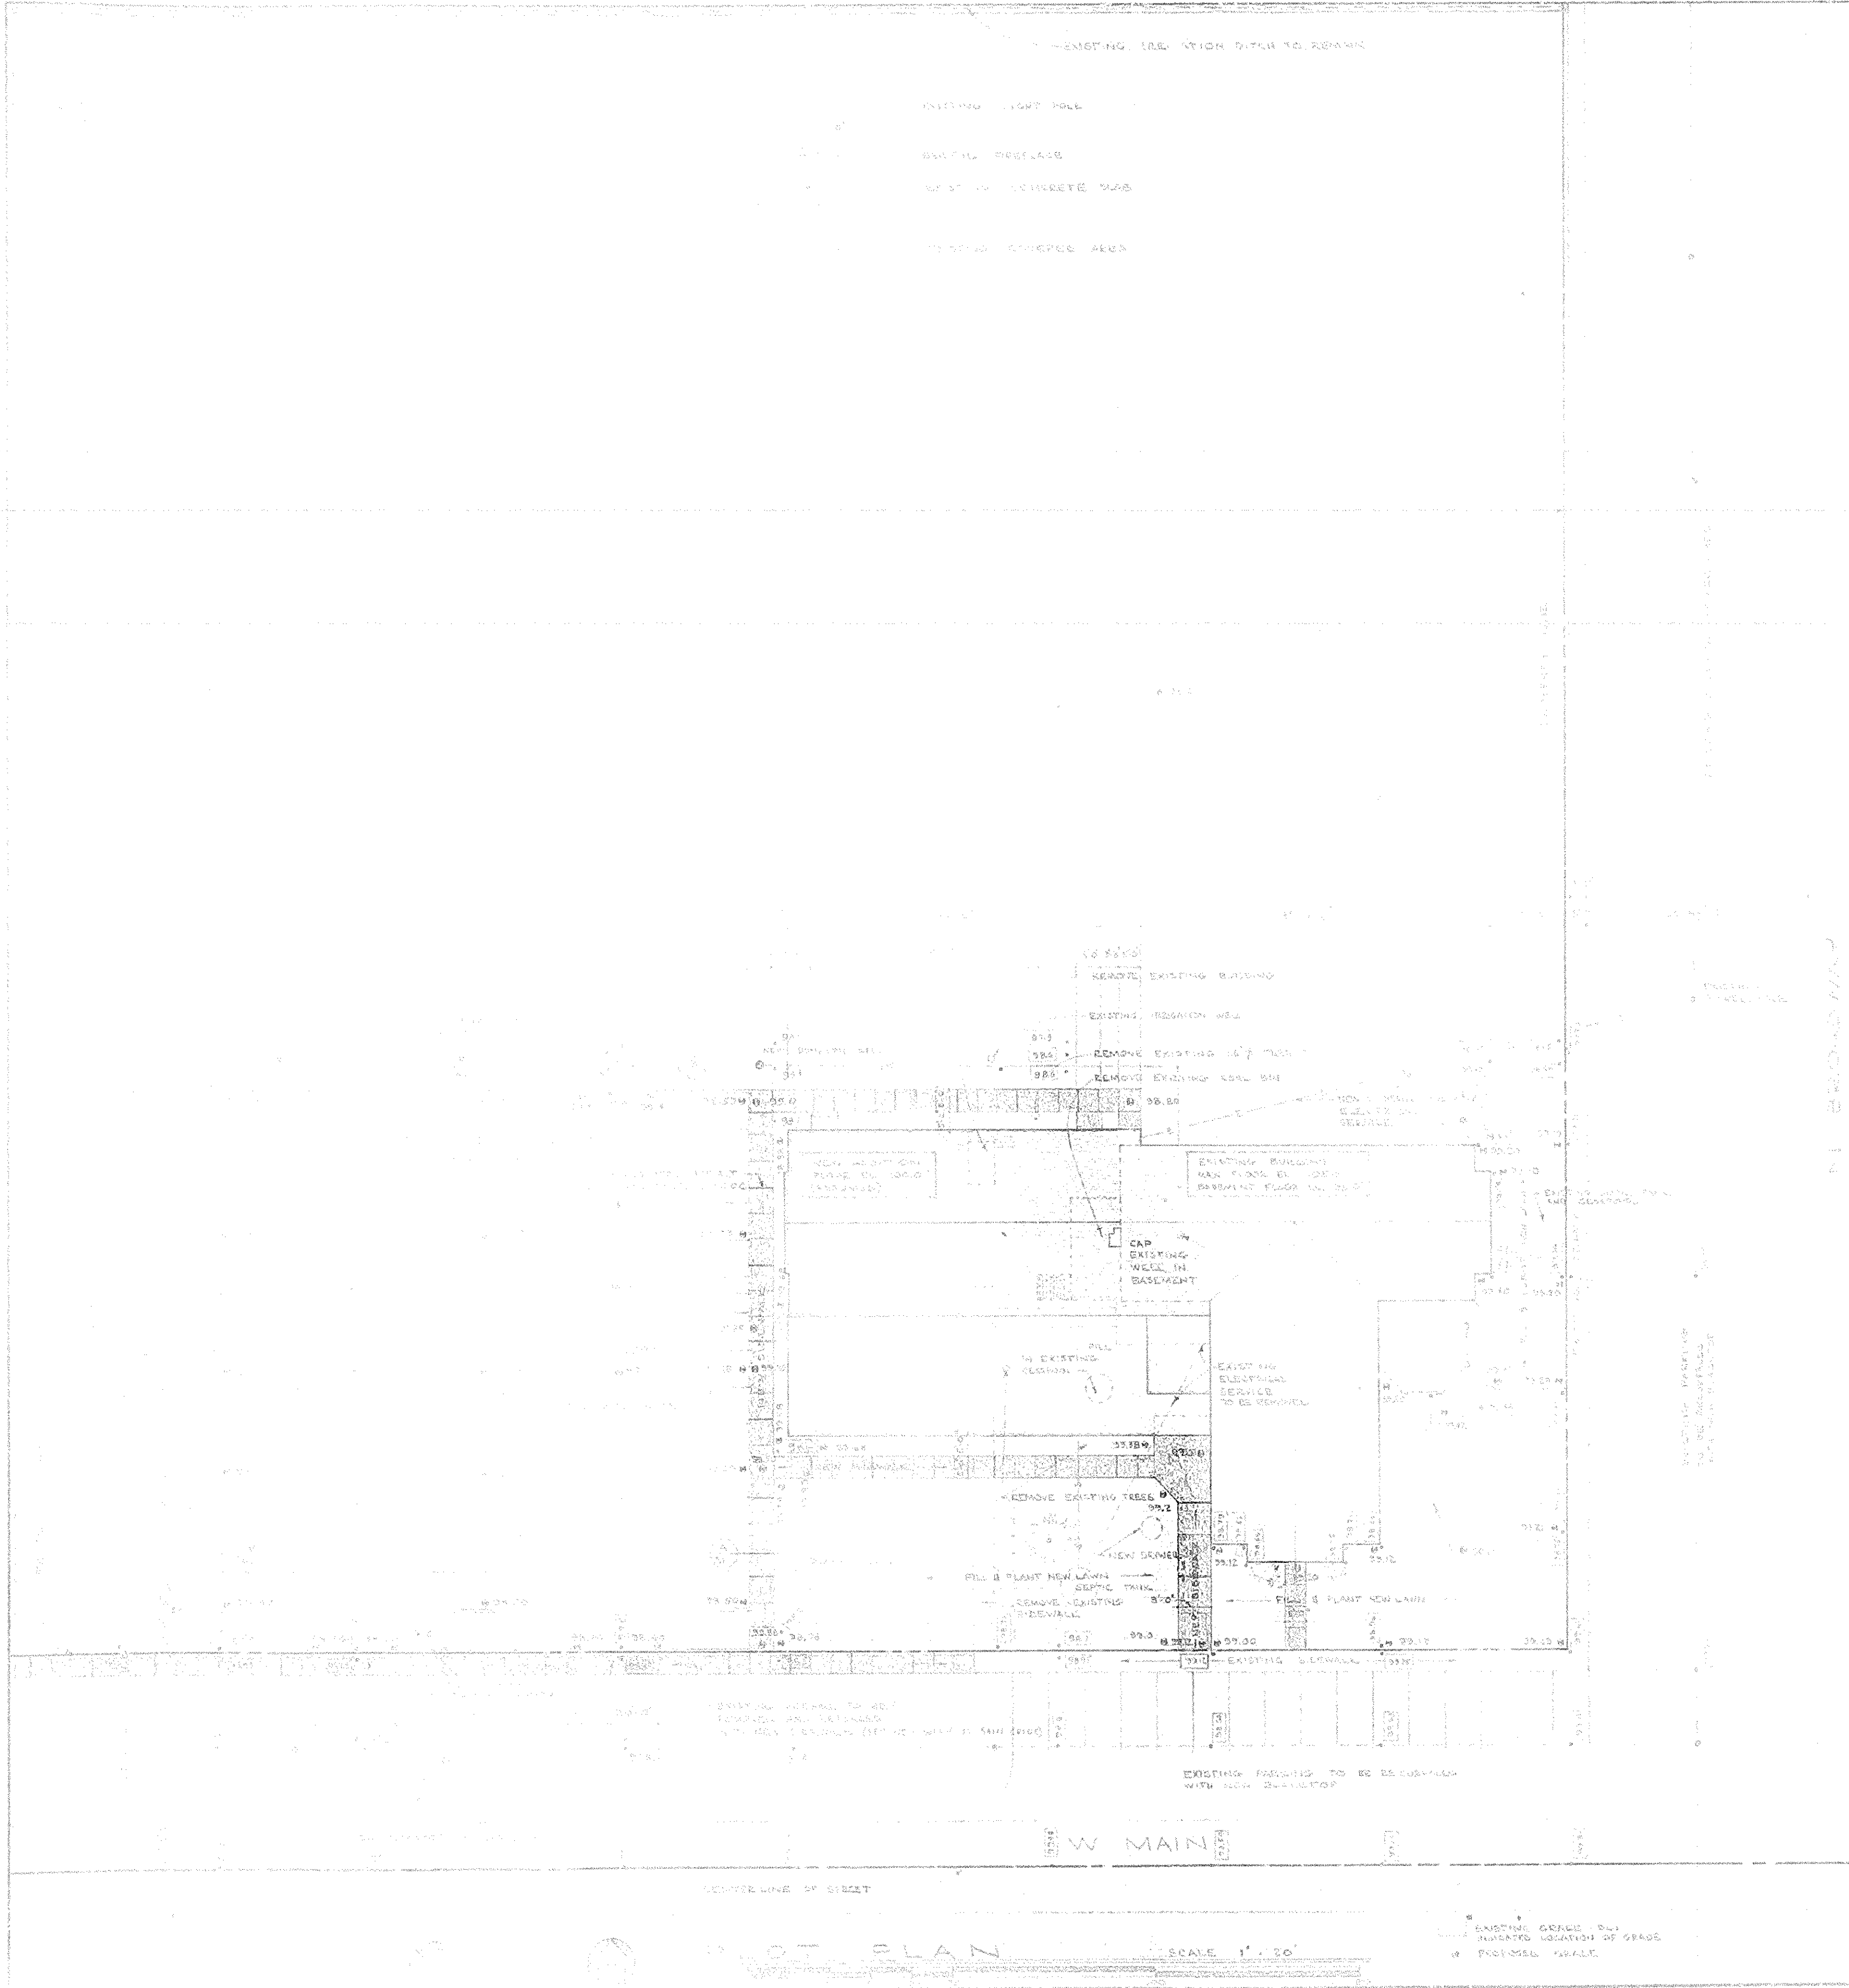


REMOVING EXISTING WALL TO REPAIR  
 EXISTING LIGHT POLE  
 EXISTING WALL  
 NEW PARTITION WALL  
 REMOVE EXISTING WALL  
 REMOVE EXISTING CEILING

SHEET NUMBER  
**A1 of 20**  
**HAROLD E. COLLARD**  
 ARCHITECT A.I.A.  
 IDAHO FALLS, IDAHO

**FLOOR PLAN**  
 SCALE 1" = 20'  
 EXISTING GRADE SHOWN  
 PROPOSED GRADE SHOWN

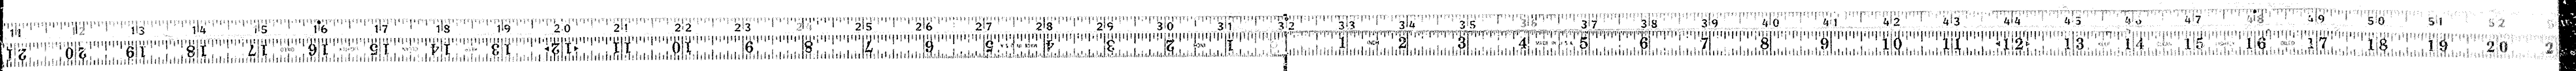

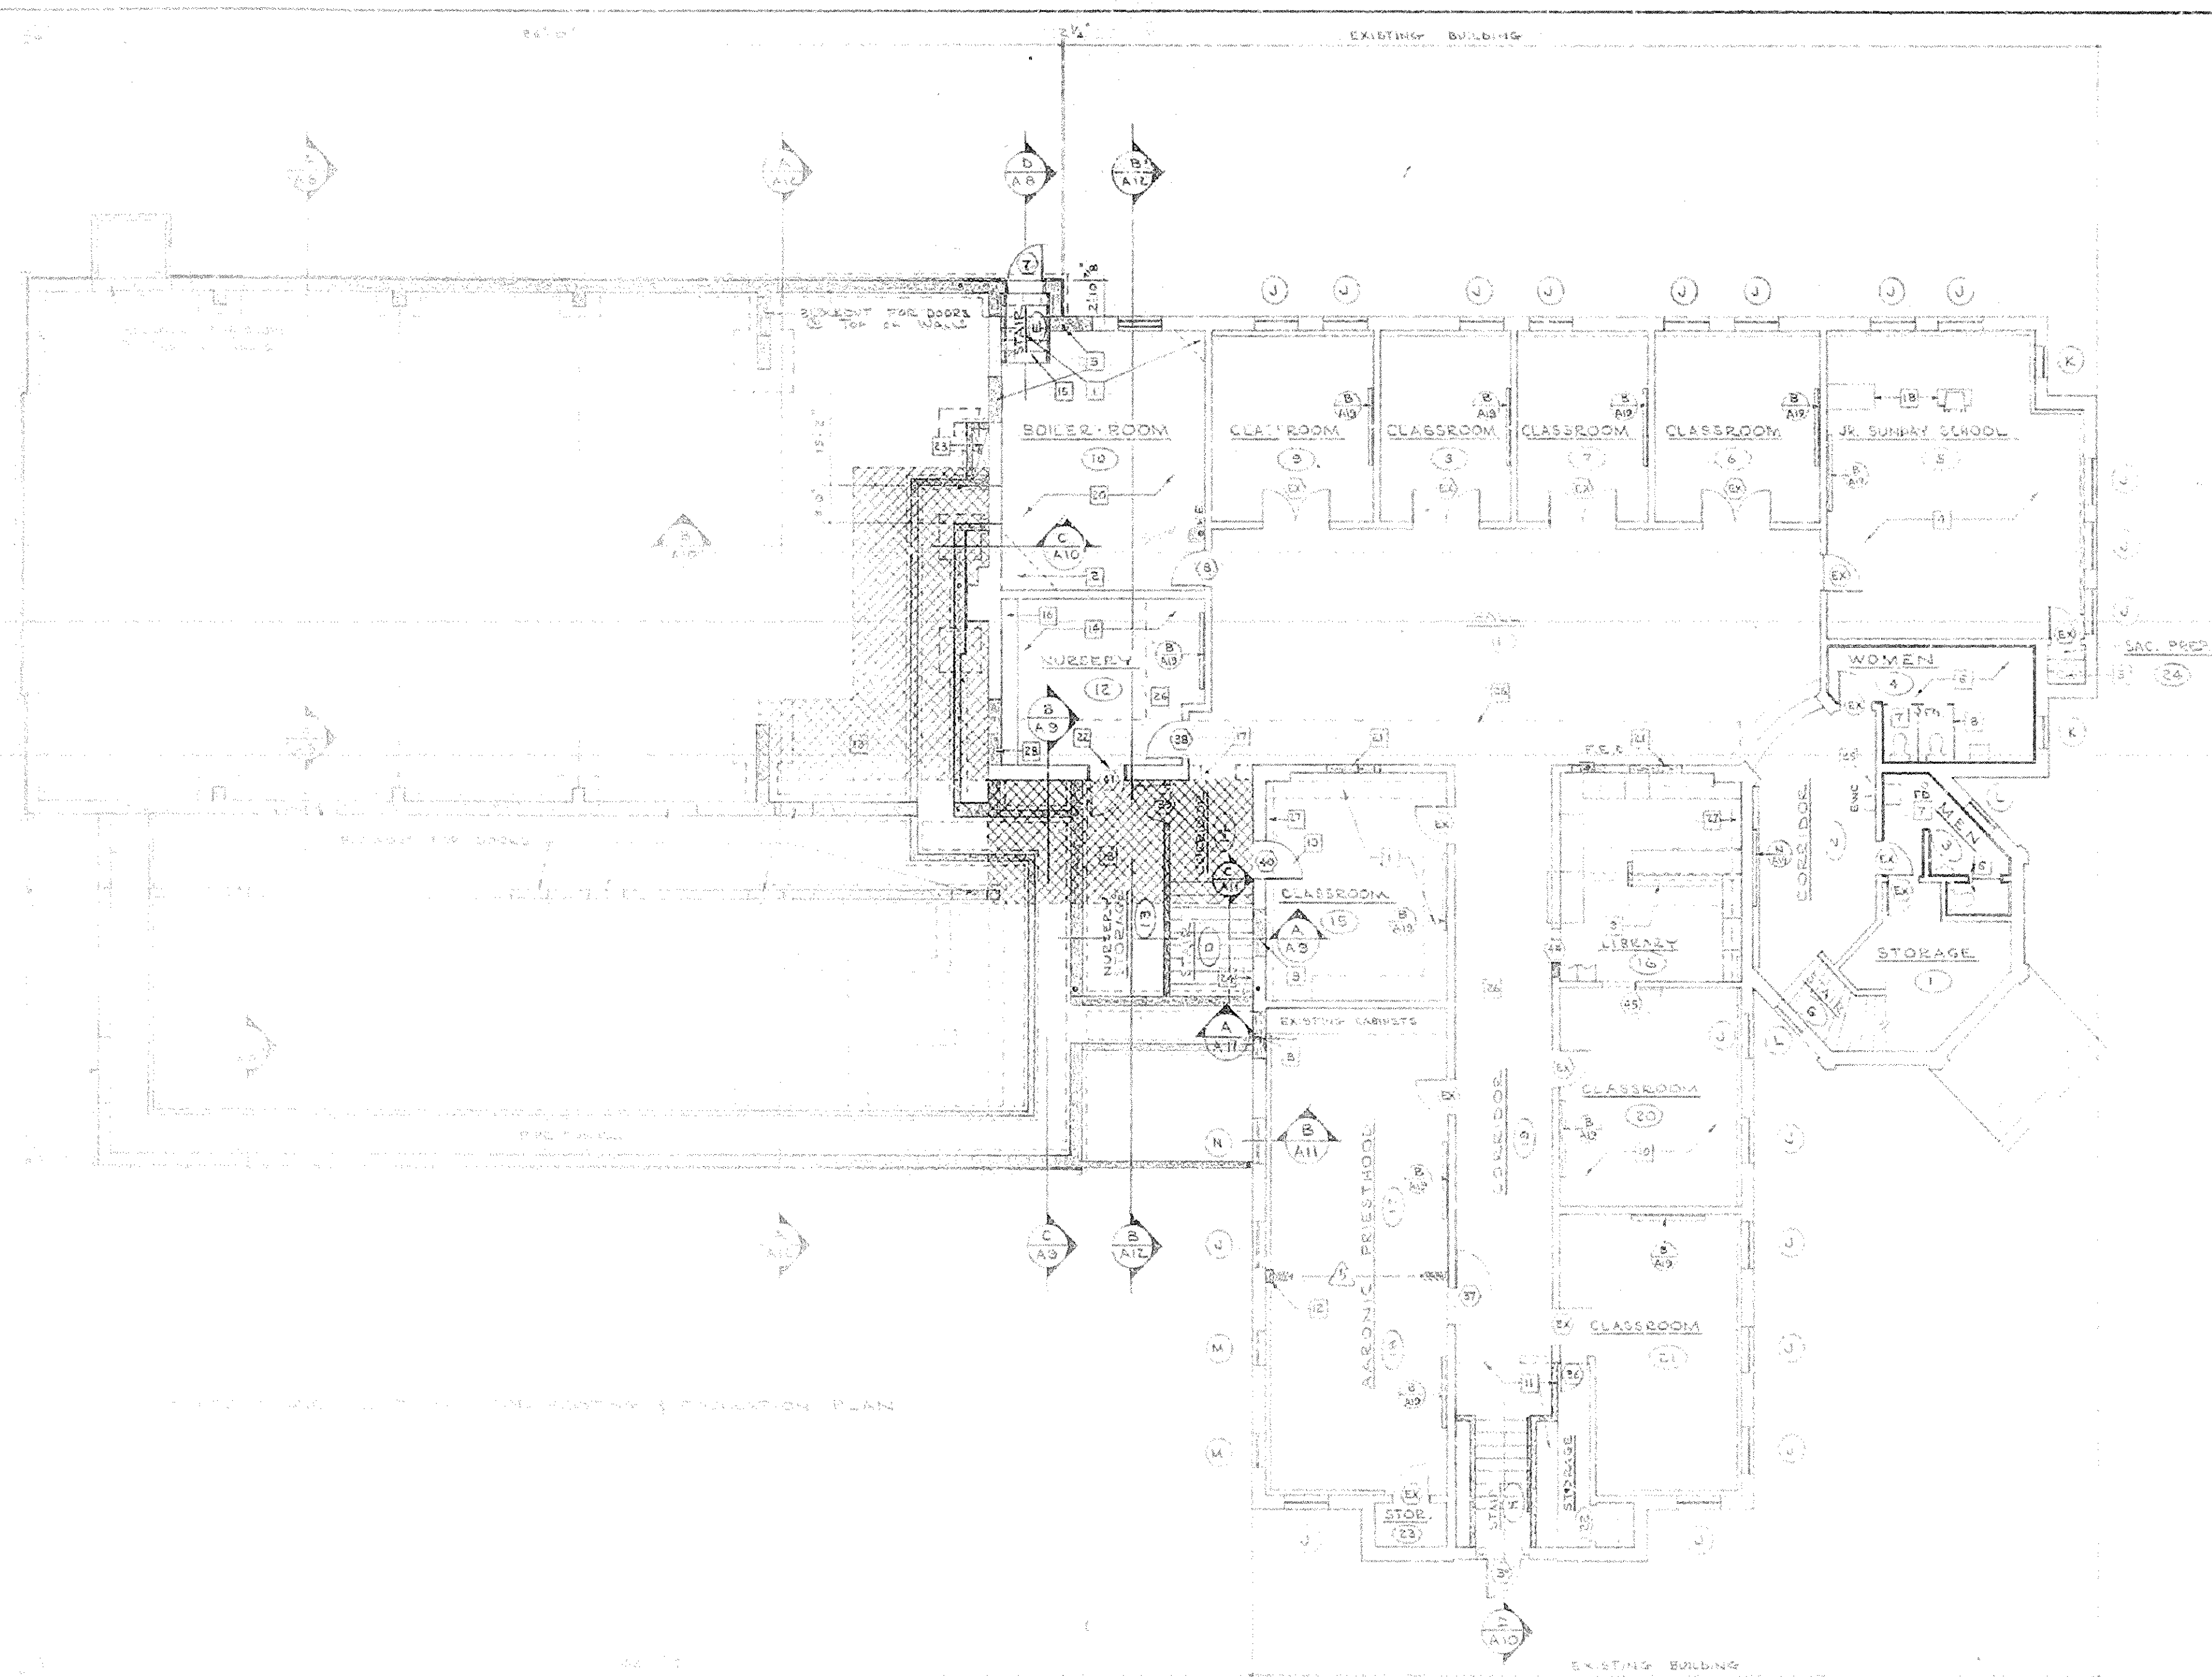

**BASEMENT FLOOR PLAN**  
 SCALE: 1/4" = 1'-0"

**NOTES (BASEMENT.)**

- 1 REMOVE EXISTING CABINETS
- 2 REMOVE EXISTING FIREPLACE & PATCH AS REQUIRED FOR NEW BRICKING TO ENTER CHIMNEY FLUE.
- 3 REMOVE EXISTING WINDOW AND FILL VOID WITH CONCRETE AND/OR CONCRETE BLOCK AS REQUIRED TO MATCH EXISTING CONSTRUCTION
- 4 REMOVE EXISTING, ADD GYPSUM & PLASTER ceiling and provide new acoustic tile ceiling. FLOOR OF TRUSS BOARDS TO BE LEFT BETWEEN EXISTING JOISTS FOR WALL ABOVE 1/2" FULL DEPTH BLOCKING @ 2' O.C.
- 5 REMOVE EXISTING MILLWORK AND PROVIDE NEW DRAPERY TREATMENT FOR WINDOW SINE & CABINET AS PER DETAILS SHEET A-4 & SHEET A-5
- REMOVE EXISTING WALL PARTITION, TILE AND PROVIDE NEW PARTITION TYPICAL FLOOR, CEILING, BASE AND 2" X 4" CEILING TILE IN HALLS. FOR EXISTING PLASTER AND PROVIDE PLASTER OVER GYPSUM AND AS PER FOR NEW WIRESET PROVIDE NEW FLOOR SLAB & CONDUIT TO NEW WASTE LINE AS SHOWN ON SHEET A-5
- 7 PROVIDE NEW METAL TOILET PARTITIONS-TSEE SPECIFICATIONS
- 8 REMOVE EXISTING LINEN CABINETS AND PROVIDE NEW LINEN CABINETS AS DETAILLED ON SHEET A-4 AND A-7
- 9 REMOVE EXISTING FLOOR SLAB & PROVIDE NEW 4" CONCRETE SLAB W/ 2" BARS @ 12" O.C. EACH WAY. SEE NOTE 8 & 29
- 10 REMOVE EXISTING DOOR, WALLS & WINDOW AND PROVIDE NEW EXT. FINISH AS DETAILLED ON SHEET A-10. PROVIDE NEW LOCK TO STORAGE DOOR AND NEW STORAGE CABINET AS DETAILLED ON SHEET A-7. REMOVE DOOR TO EXISTING STORAGE ROOM, REMOVE JAMB & PATCH WITH NEW PLASTER.
- 11 PROVIDE NEW FOLDING PARTITION - SEE SPECIFICATIONS FOR HEIGHT & ST.
- 12 REMOVE PORTION OF EXISTING BUILDING PARTITION BY REMOVING WALLS FROM - SEE NOTES ON SHEET C-1 FOR FINISH OF FOOTING, ON INSIDE OF WALL
- 13 REMOVE EXISTING BOILER ROOM FLOOR SLAB AND PROVIDE FLOOR SLAB OVER GYPSUM BOARD W/ 2" BARS @ 12" O.C. EACH WAY. PROVIDE WALLS WITH AS NOTED (SEE NOTE 8 PLAN). STOP EXISTING CEILING WITH 1 1/2" X 4" P.C. & INSTALL NEW ABOVE THE NEW FLOOR SLAB. FINISH EXISTING WALLS.
- 14 REMOVE EXISTING WALL AND PROVIDE NEW EXT. FINISH AS DETAILLED ON SHEET A-10. PROVIDE 1/2" STEEL PIPE HANGERS FROM TOP OF FOOTING.
- 15 SEE SHEET A-10 FOR STORAGE CABINET DETAILS.
- 16 REMOVE EXISTING DOOR AND WINDOW TO PROVIDE NEW OPENING. (SEE NOTE 3 PLAN)
- 17 SEE SHEET A-3 FOR WINDOW SCHEDULING, FINISH & SCHEDULE THESE DETAILS.
- 18 REMOVE EXISTING LOCK & FRAME WITH NEW LOCK TO CORRESPOND EXISTING DOOR TO MATCH EXISTING DOOR ON PLAN.
- 19 PLACE 1" REBAR IN WALL SCHEDULED UNDER NEW FLOOR EXISTING CEILING & REBAR WITH #6 CONCRETE PLASTER.
- 20 REMOVE EXISTING FLOOR TRUSS WINDOW, TILE AND WITH CONCRETE SLAB & PLASTER.
- 21 REMOVE EXISTING WALL AND PROVIDE NEW LOCK WITH FINISH.
- 22 RETURN AIR EXHAUST BOX TO 14" X 14" NEW DIMENSIONS.
- 23 REMOVE EXISTING LINEN CABINETS & FILL VOID WITH SOLID MASSWORK.
- 24 NEW ELECTRICAL WIRING - SEE SHEET M-1 & M-2
- 25 PAUSE DOWN EXISTING NEW EXT. WALL OVER STAIR GYPSUM BOARD & PATCH AS DETAILLED TO MATCH EXISTING TO THIS SPECIFICATIONS.
- 26 FILL DOWN EXISTING NEW FLOOR TO FINISH SPECIFICATIONS.
- 27 FILL UP OPENING IN EXHAUSTION & REFRIGERATOR WALL WITH CONCRETE.


**GENERAL REMODELING NOTES (BASEMENT)**

- 1 ALL EXISTING CLASSROOMS, HALLS, BOILER ROOM AND WOMEN'S RESTROOM ROOMS ARE TO BE FINISHED WITH NEW ACUSTIC TILE CEILING.
- 2 IN ALL ROOMS WHERE REMODELING INDICATED, PARTITION, PLASTER WALLS, GYPSUM BOARD OR NEW WALLS TO BE FINISHED WITH PLASTER WALLS. REMOVAL OF PARTITION OR MILLWORK, ETC., ALL WALLS IN THE ROOM SHALL BE PATCHED TO MATCH EXISTING OR REPAIRED, AS DIRECTED BY THE ARCHITECT, TO GIVE FINISHED APPEARANCE USING THE FOLLOWING SPECIFICATIONS: FINE & REFINISHED GYPSUM BOARD OVER EXISTING WALL & CONCRETE WITH #6 FINISH.
- 3 THE GENERAL CONTRACTOR SHALL CHECK THE CONDITION AND ORIENTATION OF ALL EXISTING DOORS & WINDOW DOORS. REPAIRS SHALL BE SUPPLIED & ANY REPAIRS SHALL BE PROVIDED BY CONTRACTOR. ANY DOORS AND/OR WINDOWS NOT SUPPLIED SHALL BE DELIVERED WITH NEW TO MATCH EXISTING OR AS ADDITIONAL COST TO OWNER. INSTALL NEW DOORS WITH FOR ALL EXISTING DOORS.
- 4 ALL EXISTING DOOR WINDOWS ARE TO BE REMOVED AND REPLACED WITH NEW ALUMINUM WINDOWS AS DETAILLED & SCHEDULED ON SHEET A-10.
- 5 REMOVE ALL EXISTING CHAIRBOARDS AND REPLACE WITH NEW CONCRETE CHAIR & FLOOR BOARD AS SHOWN ON THE PLAN.
- 6 REMOVE EXISTING W/ CONDUCTORS, SUPPLY AND PATCH WIRE, AND PATCH WALL TO MATCH EXISTING.
- 7 CONTRACTOR SHALL CHECK THE CONDITION OF EXISTING BASES AND MAKE SURE FLOOR ALL ROOMS UNDER EXISTING MILLWORK AND REFINISHED TO MATCH EXISTING.
- 8 NOTE: ANTI-MOLD I DOORSE FLOOR OR AGAINST EXISTING CONCRETE OR PREVIOUS FLOOR JOINT SHALL BE TYPICALLY CLEAN AND SOUND, THEN TREATED WITH AN ANTI-MOLD PREVENTATIVE SOLUTION IN ACCORDANCE WITH MANUFACTURER'S RECOMMENDATIONS AND UNDER THE SUPERVISION OF THE CONTRACTOR AS REQUIRED BY THE ARCHITECT.
- 9 REMOVE EXISTING MAIN WALL & PATCH WALL TO MATCH EXISTING. NOTABLE NEW WALL FROM AT HEIGHT TO 10'1" UNDER USED IN ROOM AS DETAILLED ON SHEET A-10. ALSO SCHEDULED ON SHEET A-10.


136070

APPROVED	CHECKED	DATE	BY
HAROLD E. COLLARD ARCHITECT A.I.A. IDAHO FALLS, IDAHO			SHEET NUMBER <b>A2</b> OF <b>20</b>

PROJECT NUMBER

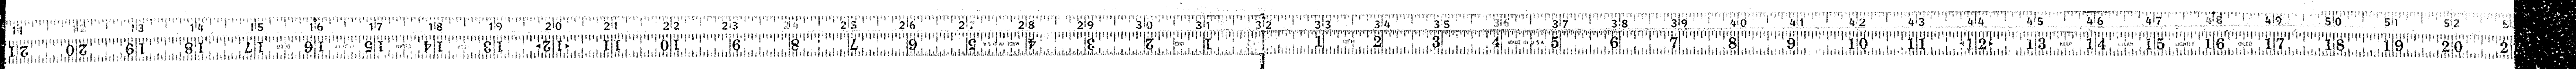



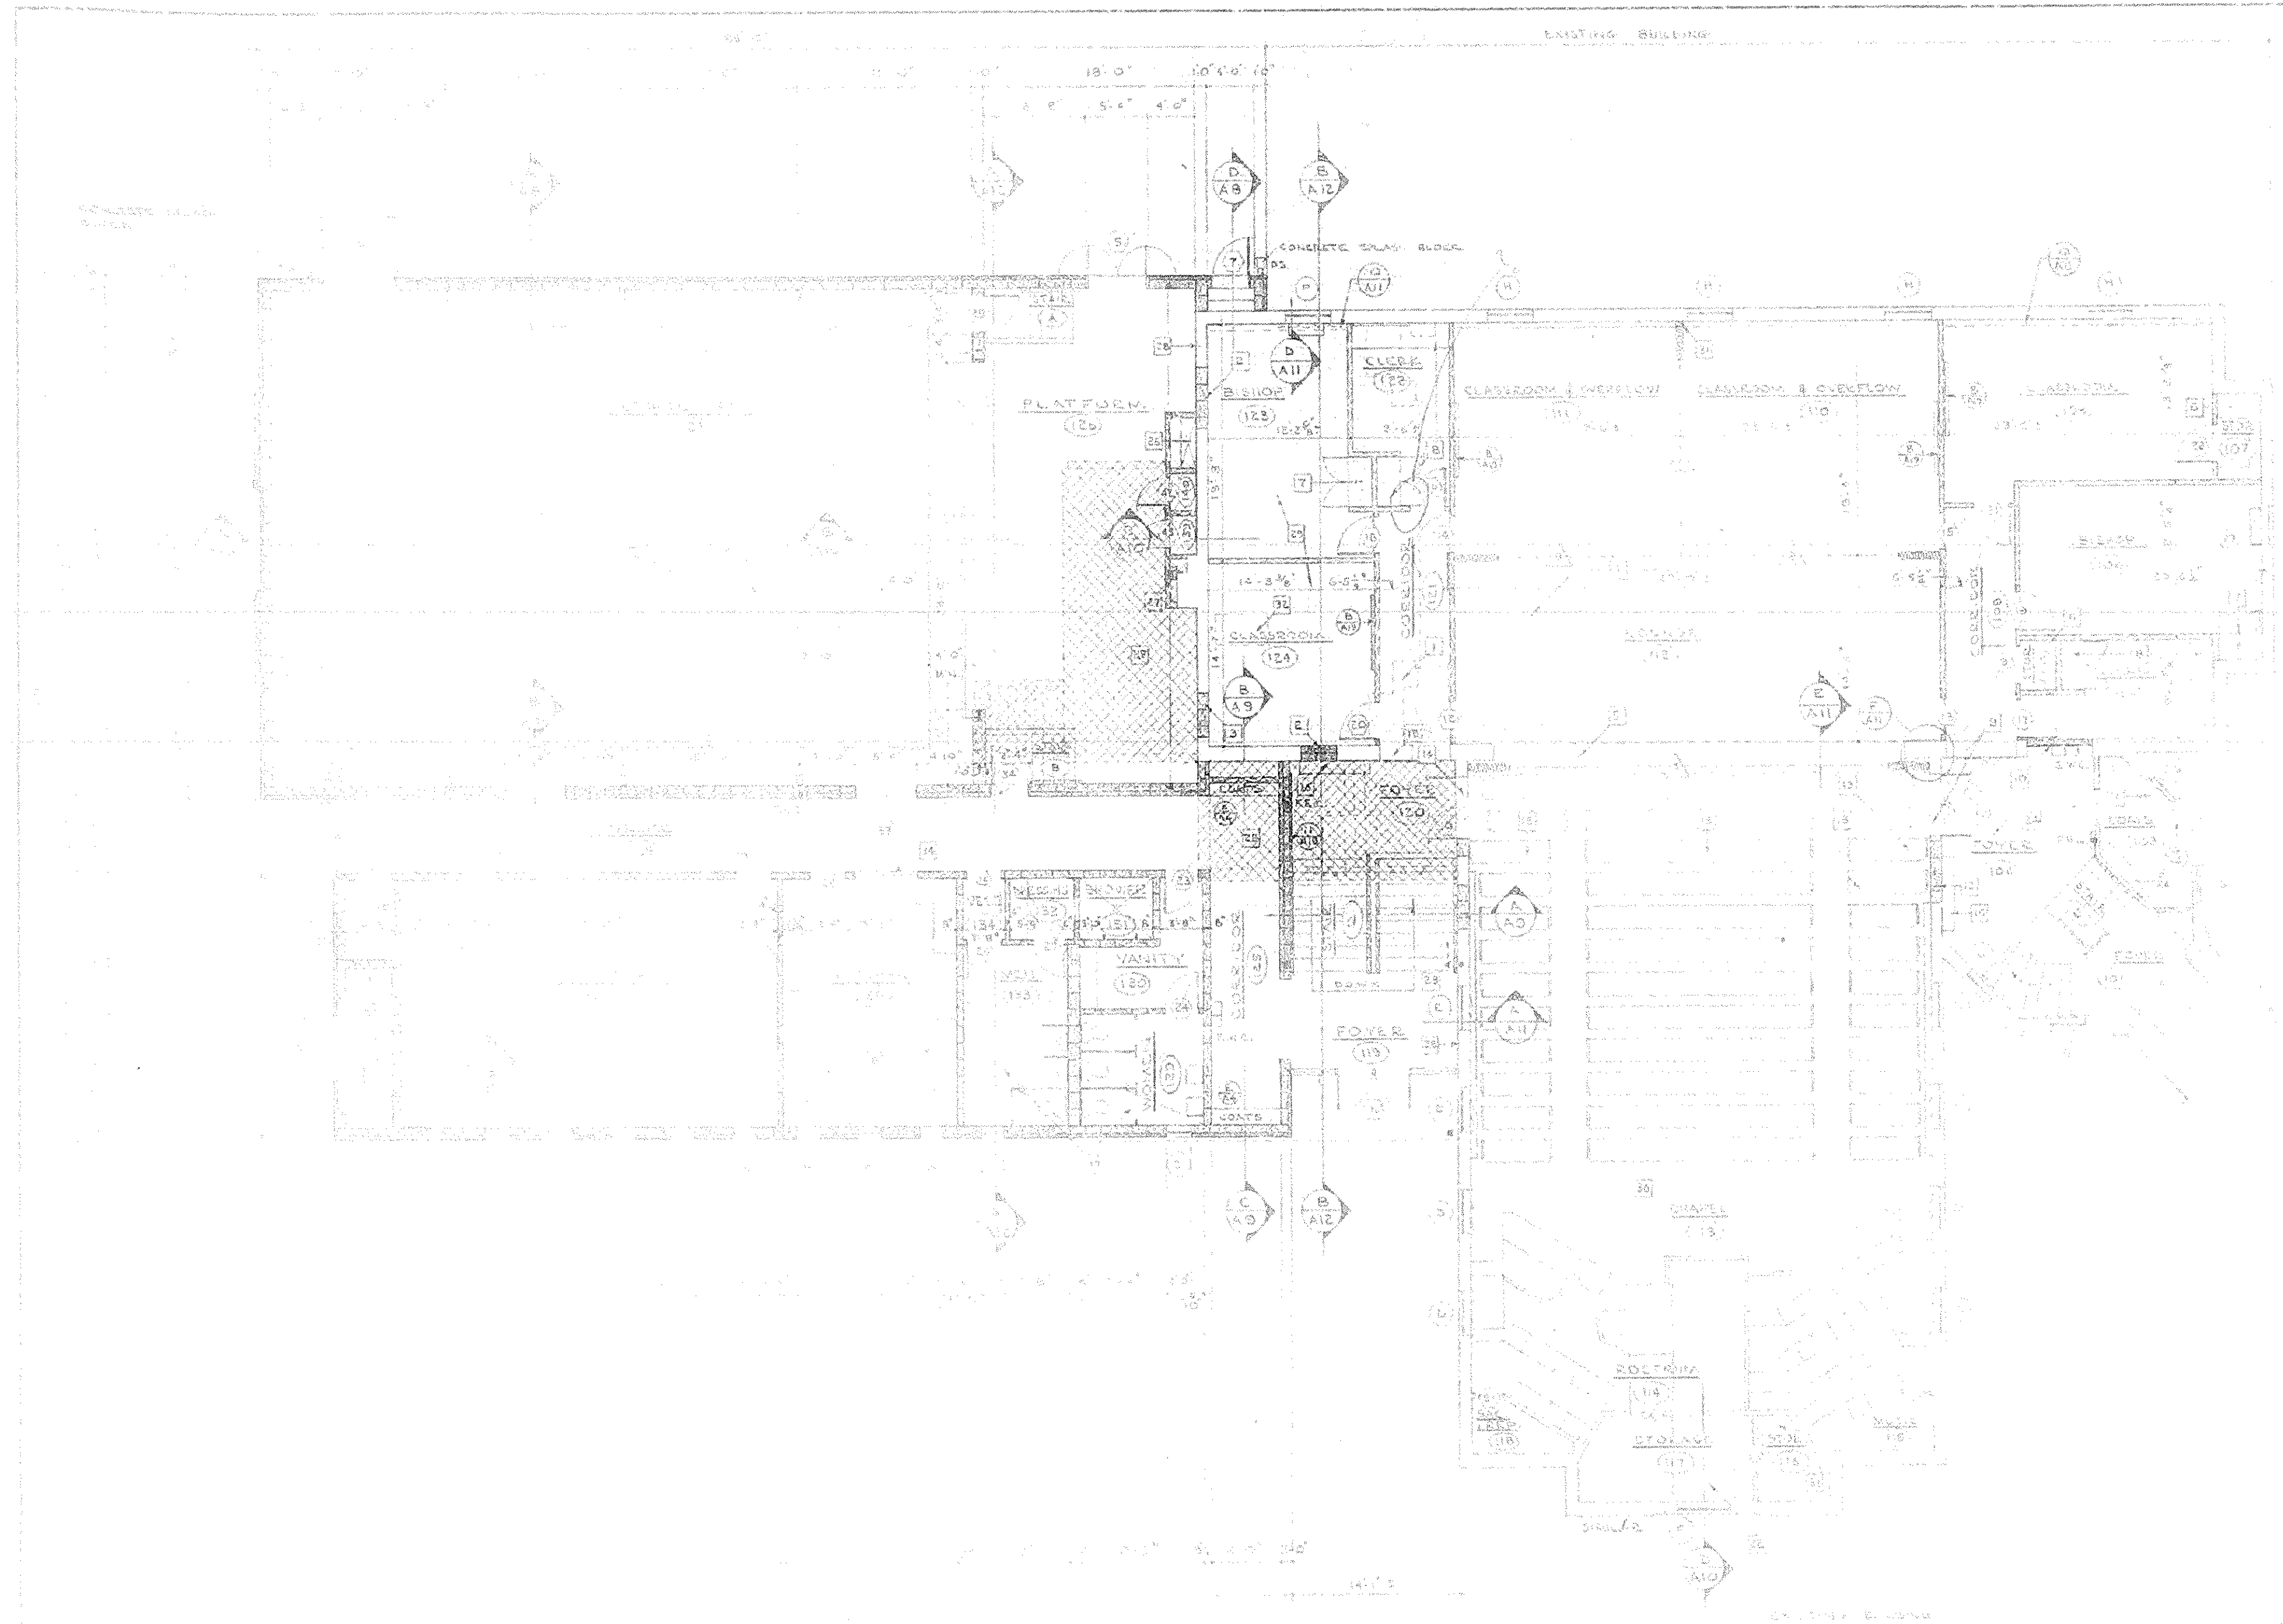

### NOTES (MAIN FLOOR)

- 1) REMOVE EXISTING PLATFORM WALLS, CEILING AND FLOOR STRUCTURE FROM PLATFORM. SEE SHEETS A3, A4, A5, A6, A7, A8, A9, A10, A11, A12, A13, A14, A15, A16, A17, A18, A19, A20.
- 2) REMOVE EXISTING PLATFORM WALLS AND FLOOR STRUCTURE FROM PLATFORM. SEE SHEETS A3, A4, A5, A6, A7, A8, A9, A10, A11, A12, A13, A14, A15, A16, A17, A18, A19, A20.
- 3) REMOVE EXISTING PLATFORM WALLS AND FLOOR STRUCTURE FROM PLATFORM. SEE SHEETS A3, A4, A5, A6, A7, A8, A9, A10, A11, A12, A13, A14, A15, A16, A17, A18, A19, A20.
### MAIN FLOOR PLAN

SCALE 1/8" = 1'-0"

SEATING	
ROOSTEUM	36
CHAPEL	300
LOUNGE	90
OVERFLOW	114
CUSTOMER HALL	142

- EXISTING WALL
- NEW 4" x 8" WALL CONSTRUCTION
- NEW CONCRETE BLOCK WALL CONSTRUCTION
- NEW BRICK WITH CONCRETE BLOCK BACKFILL WALL CONSTRUCTION

FLOOR LEVEL	TEACHING AREAS	WARD OR BRANCH		WARD OR BRANCH		WARD OR BRANCH		WARD OR BRANCH	
		MEMBER	NON-MEMBER	MEMBER	NON-MEMBER	MEMBER	NON-MEMBER	MEMBER	NON-MEMBER
BASMENT									
MAIN FLOOR									
2ND FLOOR									
SUB TOTAL									
EXIST FLOOR									


136674

SHEET NUMBER **A3** OF **20**





HAROLD E. COLLARD  
ARCHITECT  
IDAHO FALLS, IDAHO

PROJECT NUMBER




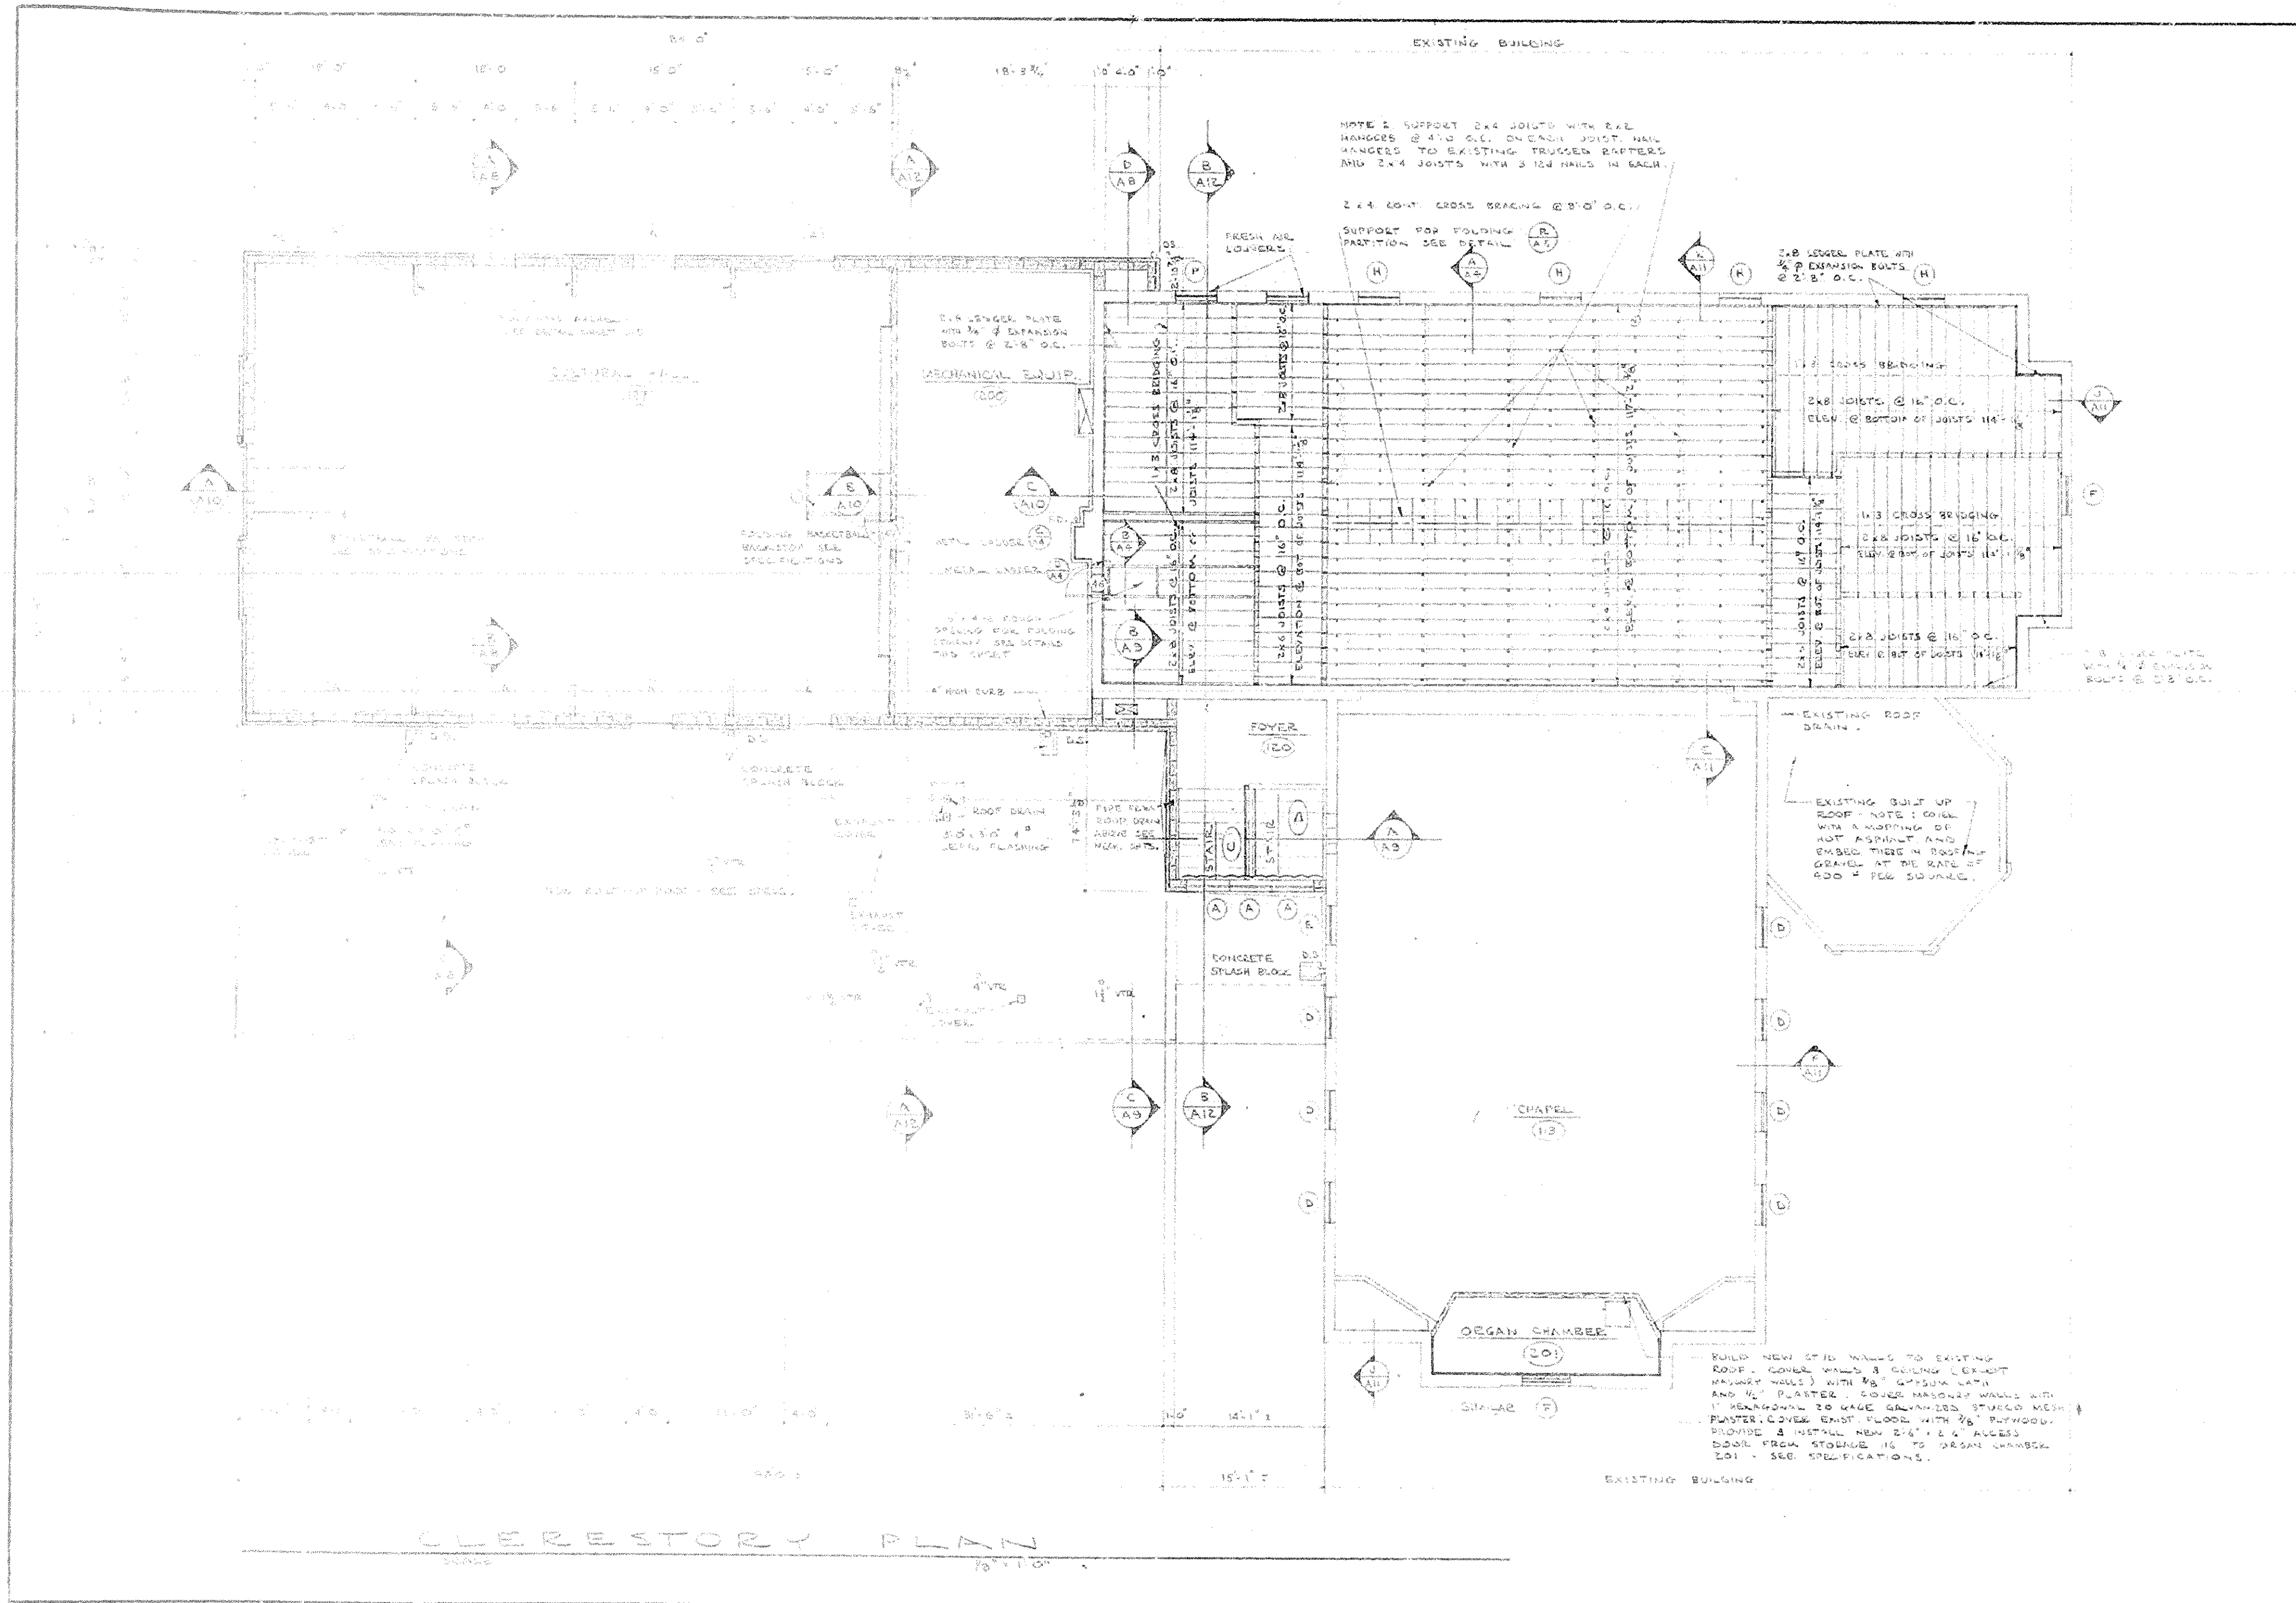

CLERESTORY PLAN

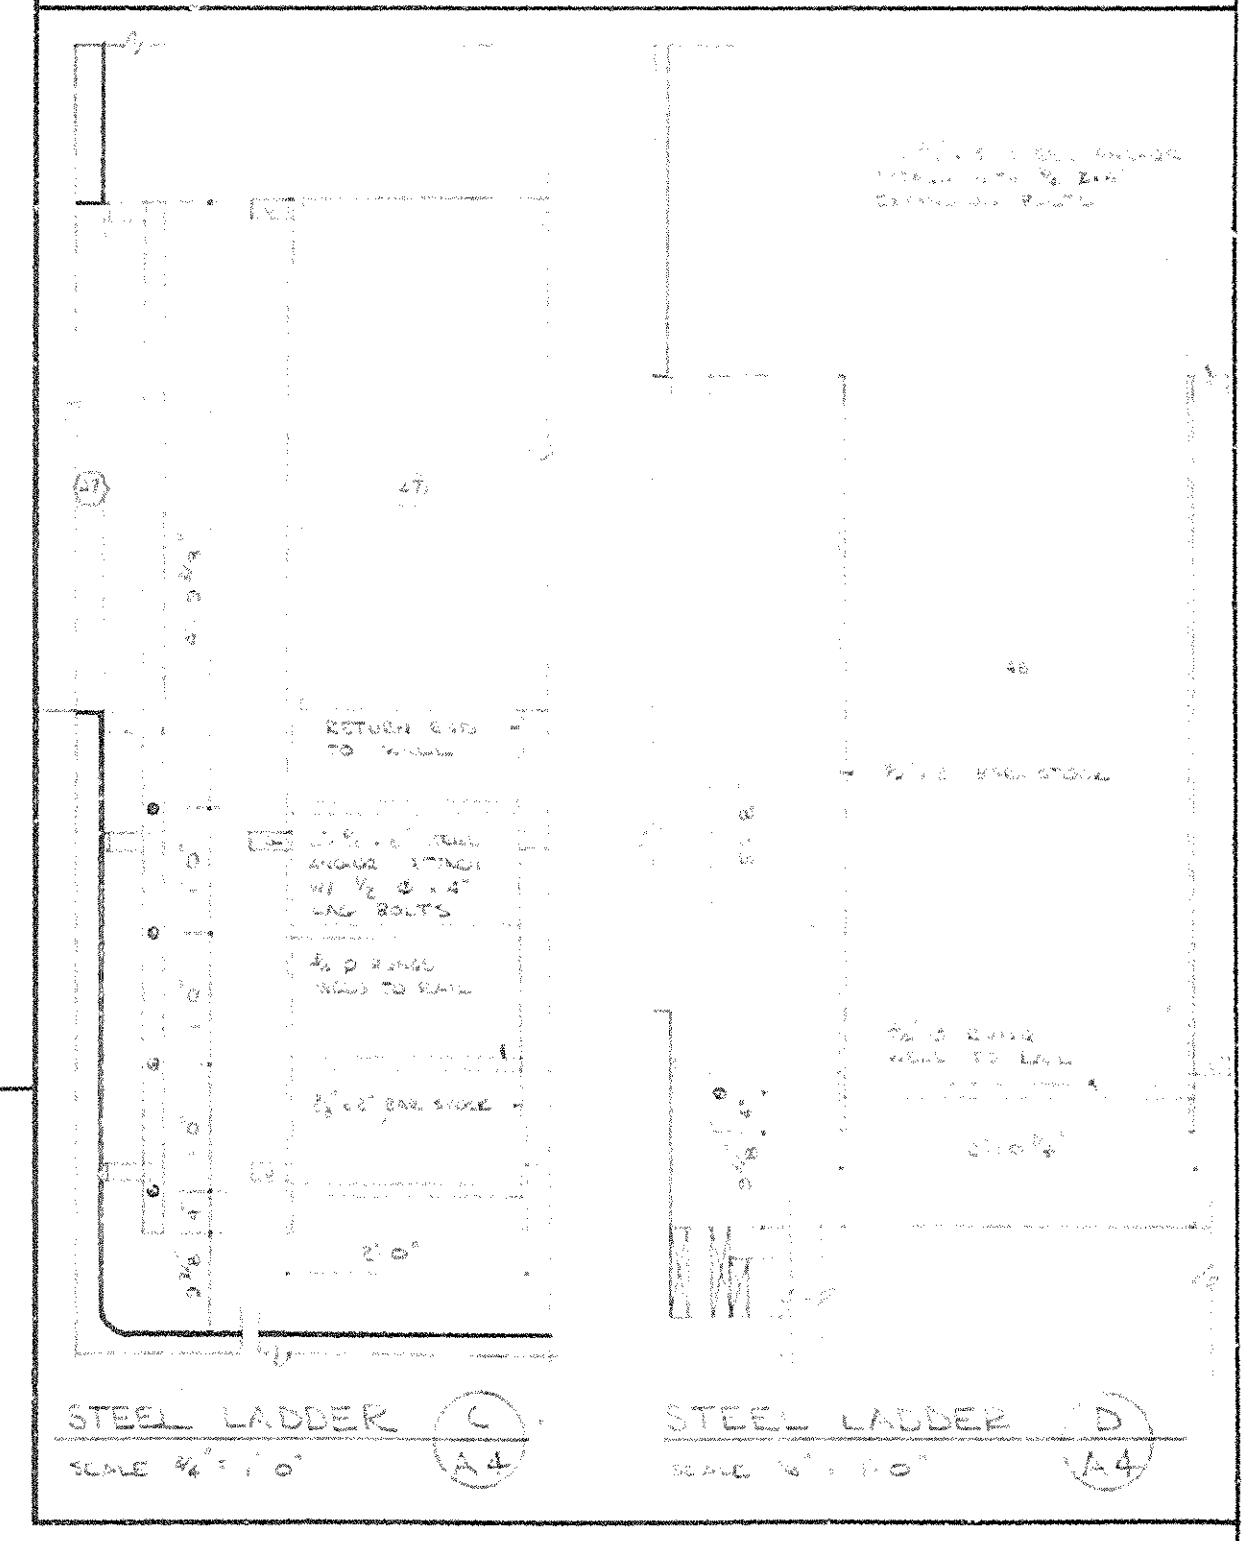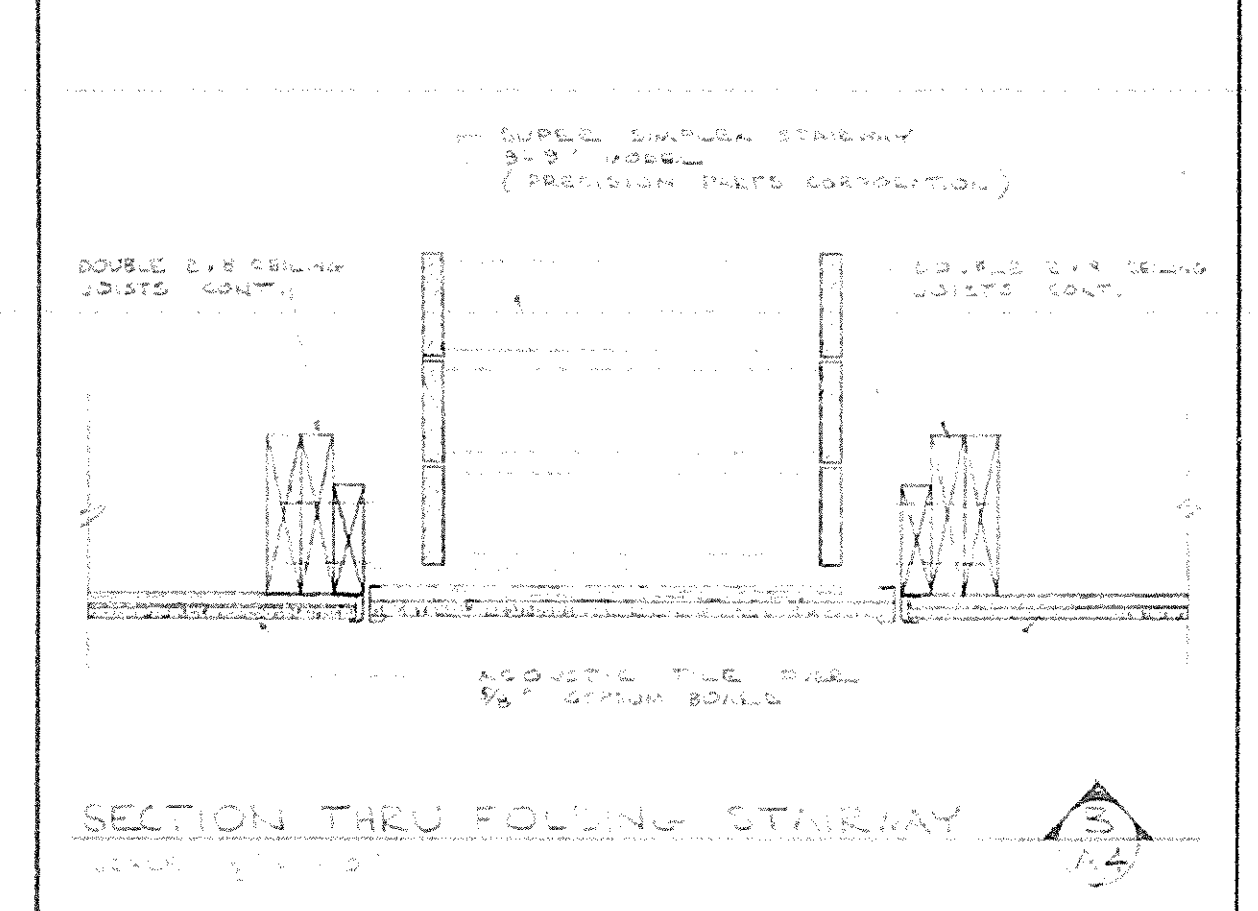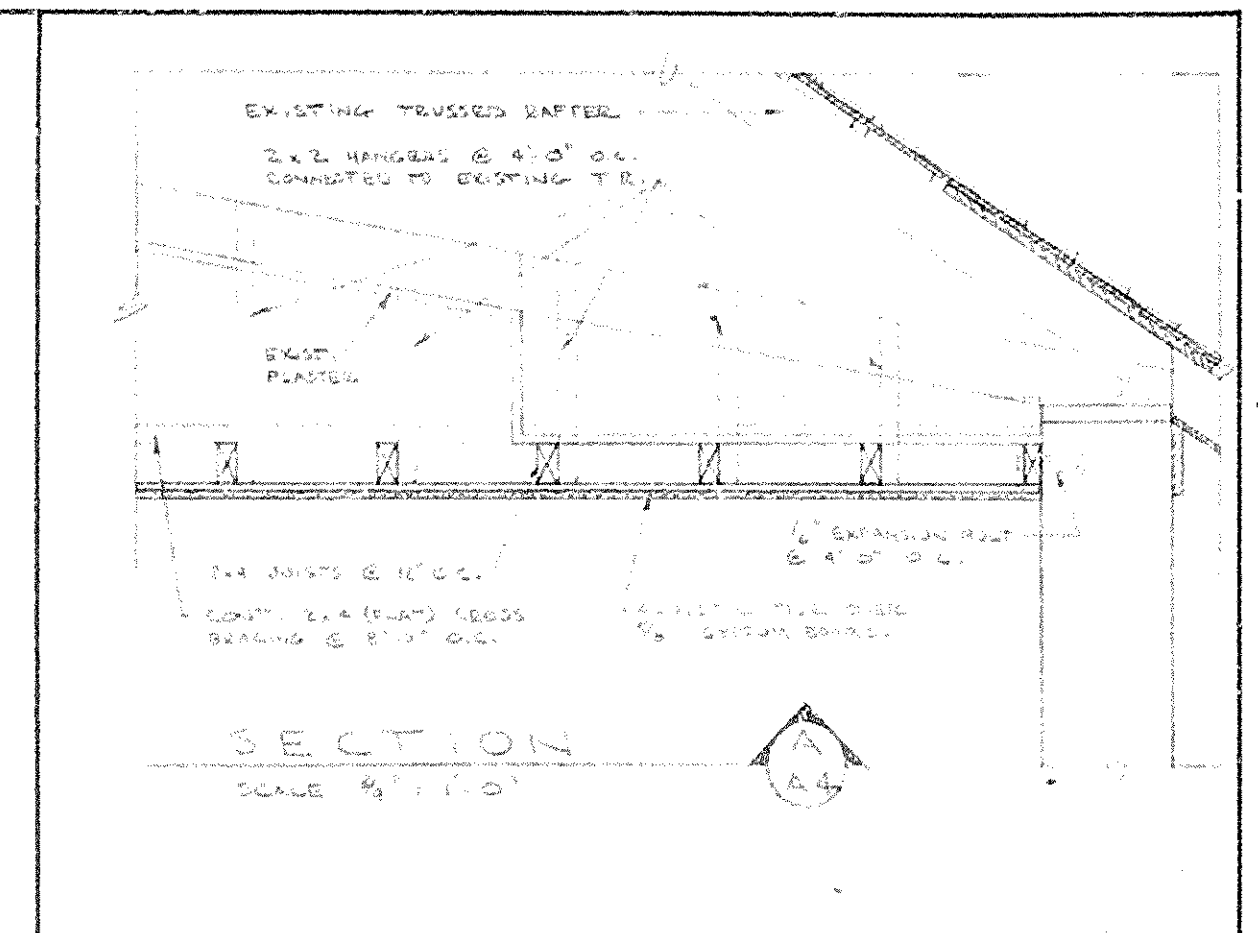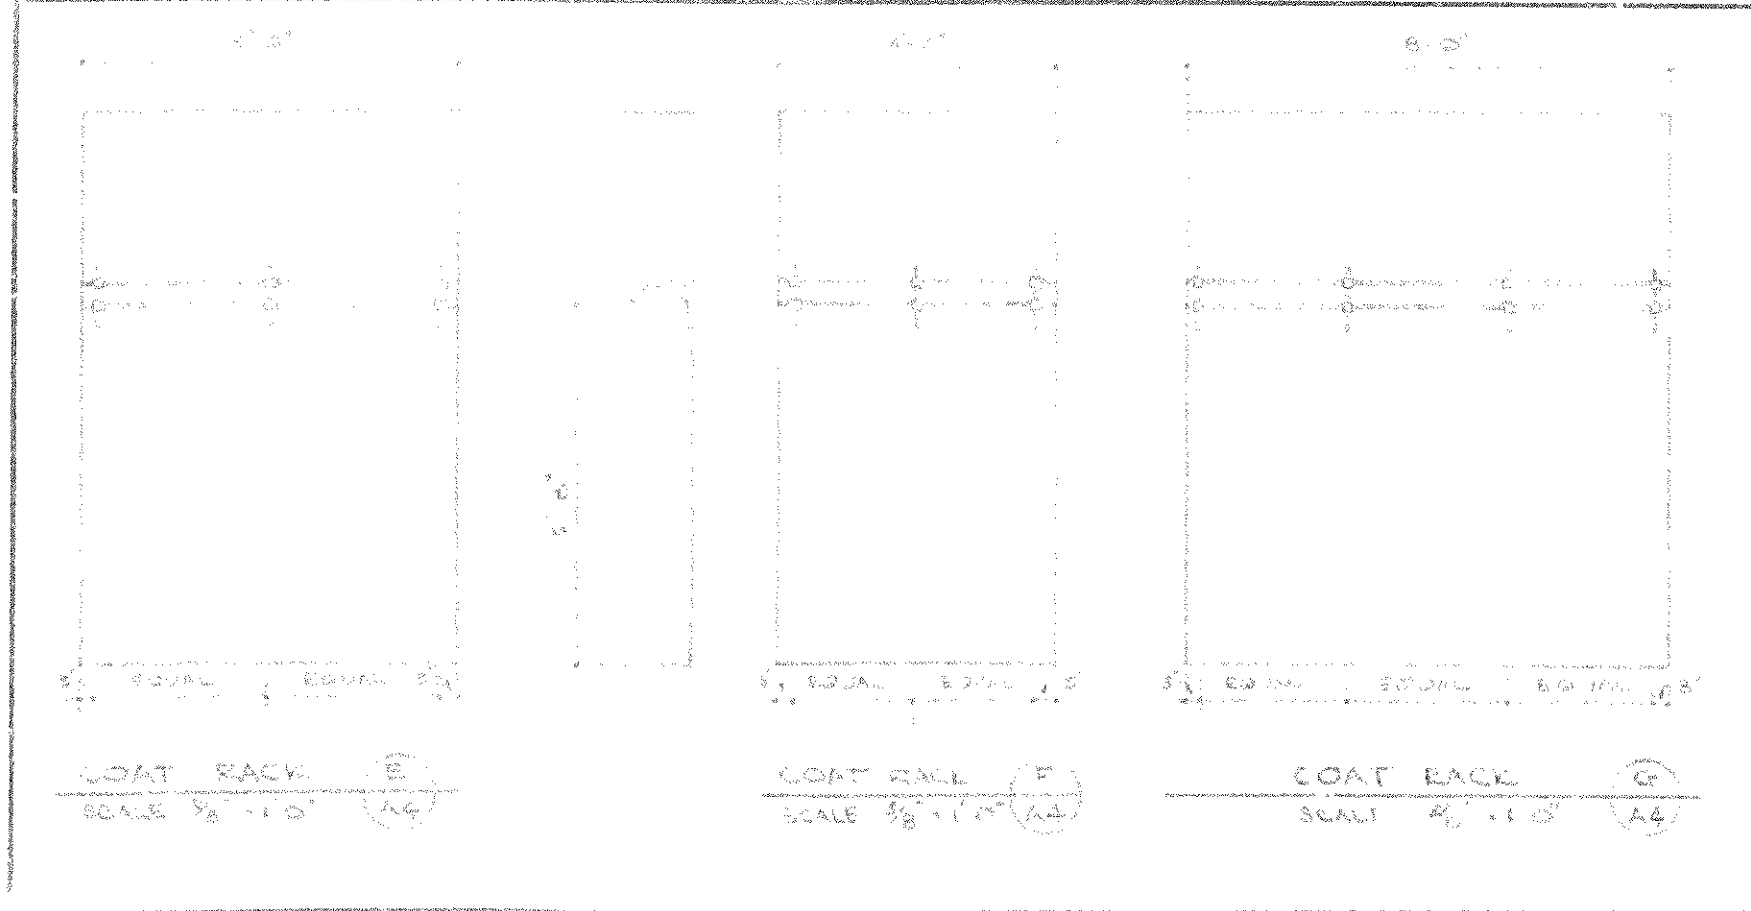


APPROVED	SECTION & REMODELING OF MEANS OF EGRESS TO MAKE MEANS OF EGRESS TO CHAPEL AND ORGAN CHAMBER FROM EXISTING MEANS OF EGRESS <b>HAROLD E. COLLARD</b> ARCHITECT J. I. A. IDAHO FALLS, IDAHO	<b>SHEET NUMBER</b> <b>A4.20</b>
CHECKED		

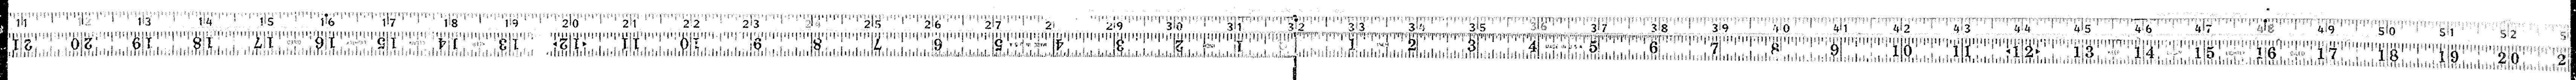





NOTE 1 REPAIR EXISTING BRICK WALLS - SEE  
NOTE 2 GENERAL REVISIONS NOTES SHEET A-2

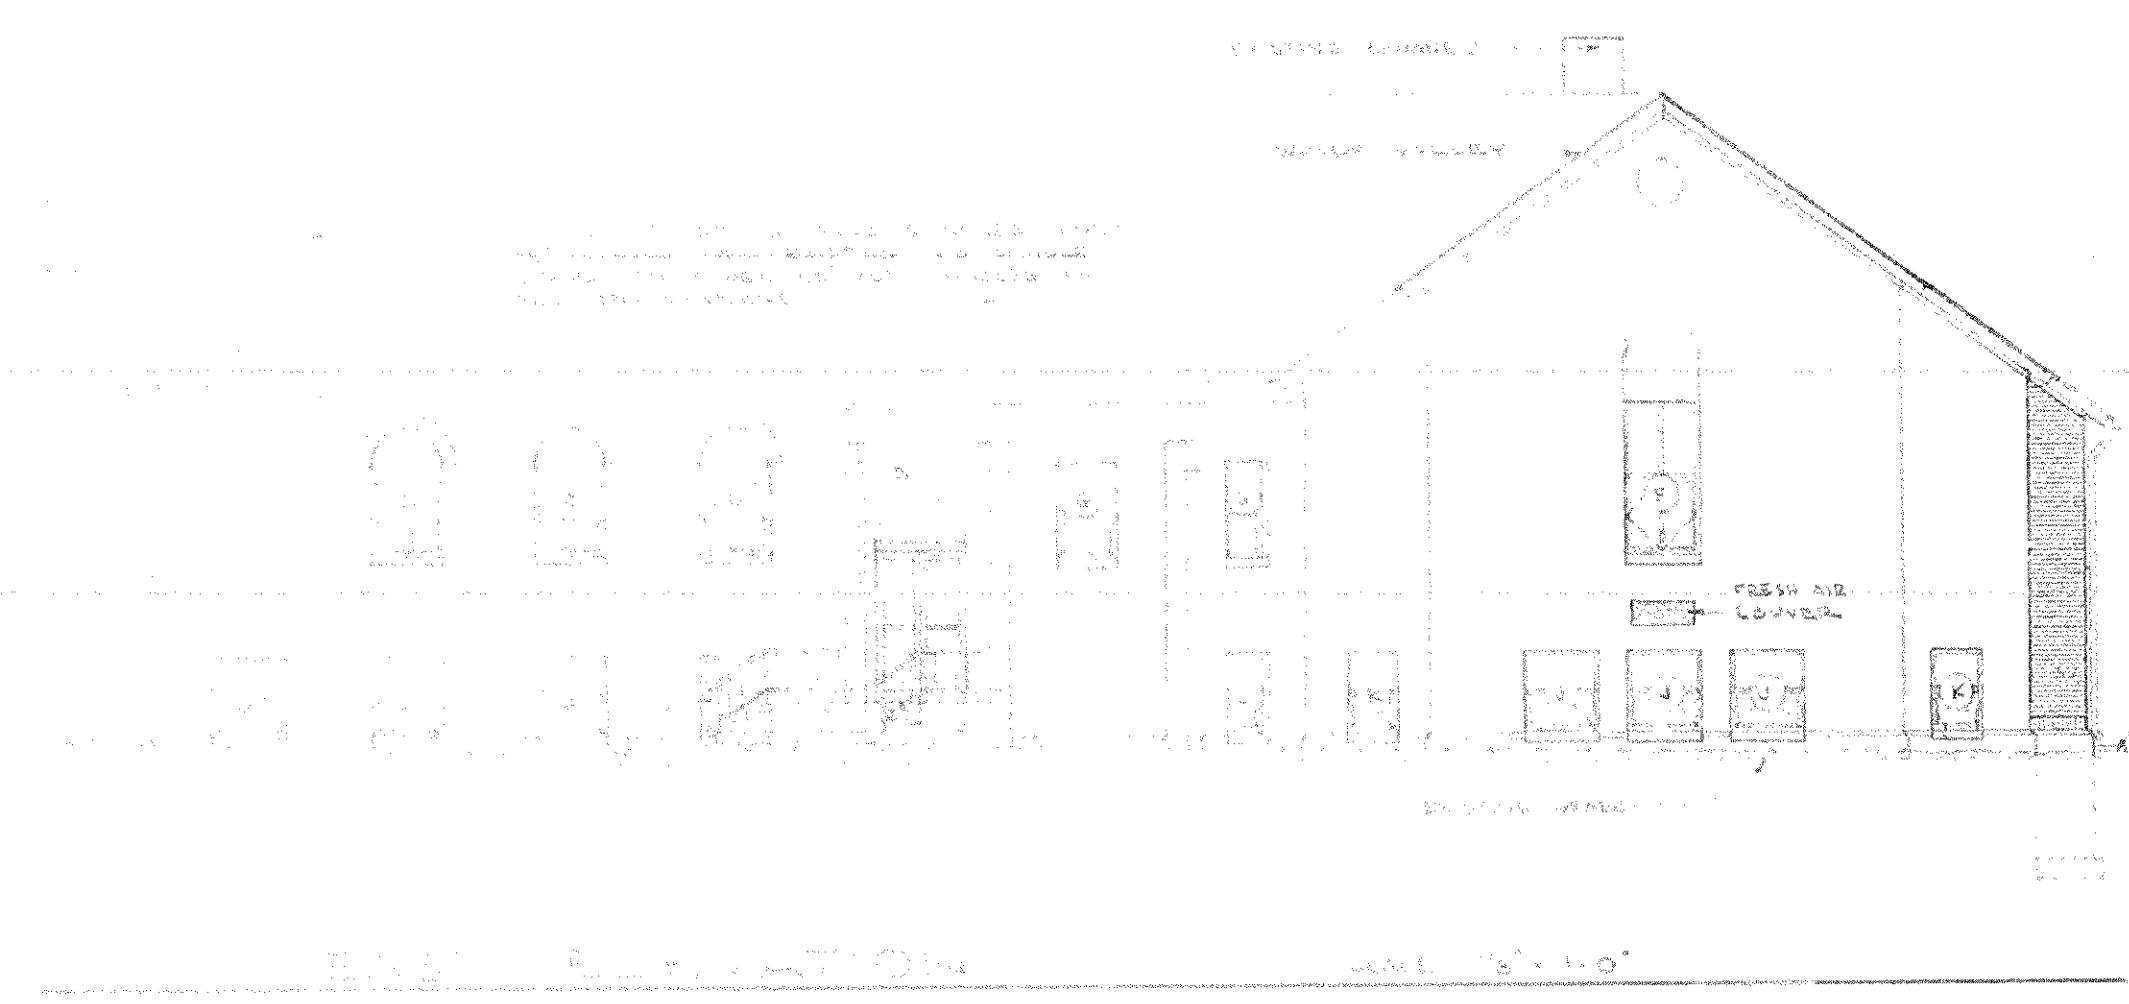


EAST ELEVATION SCALE 1/8" = 1'-0"

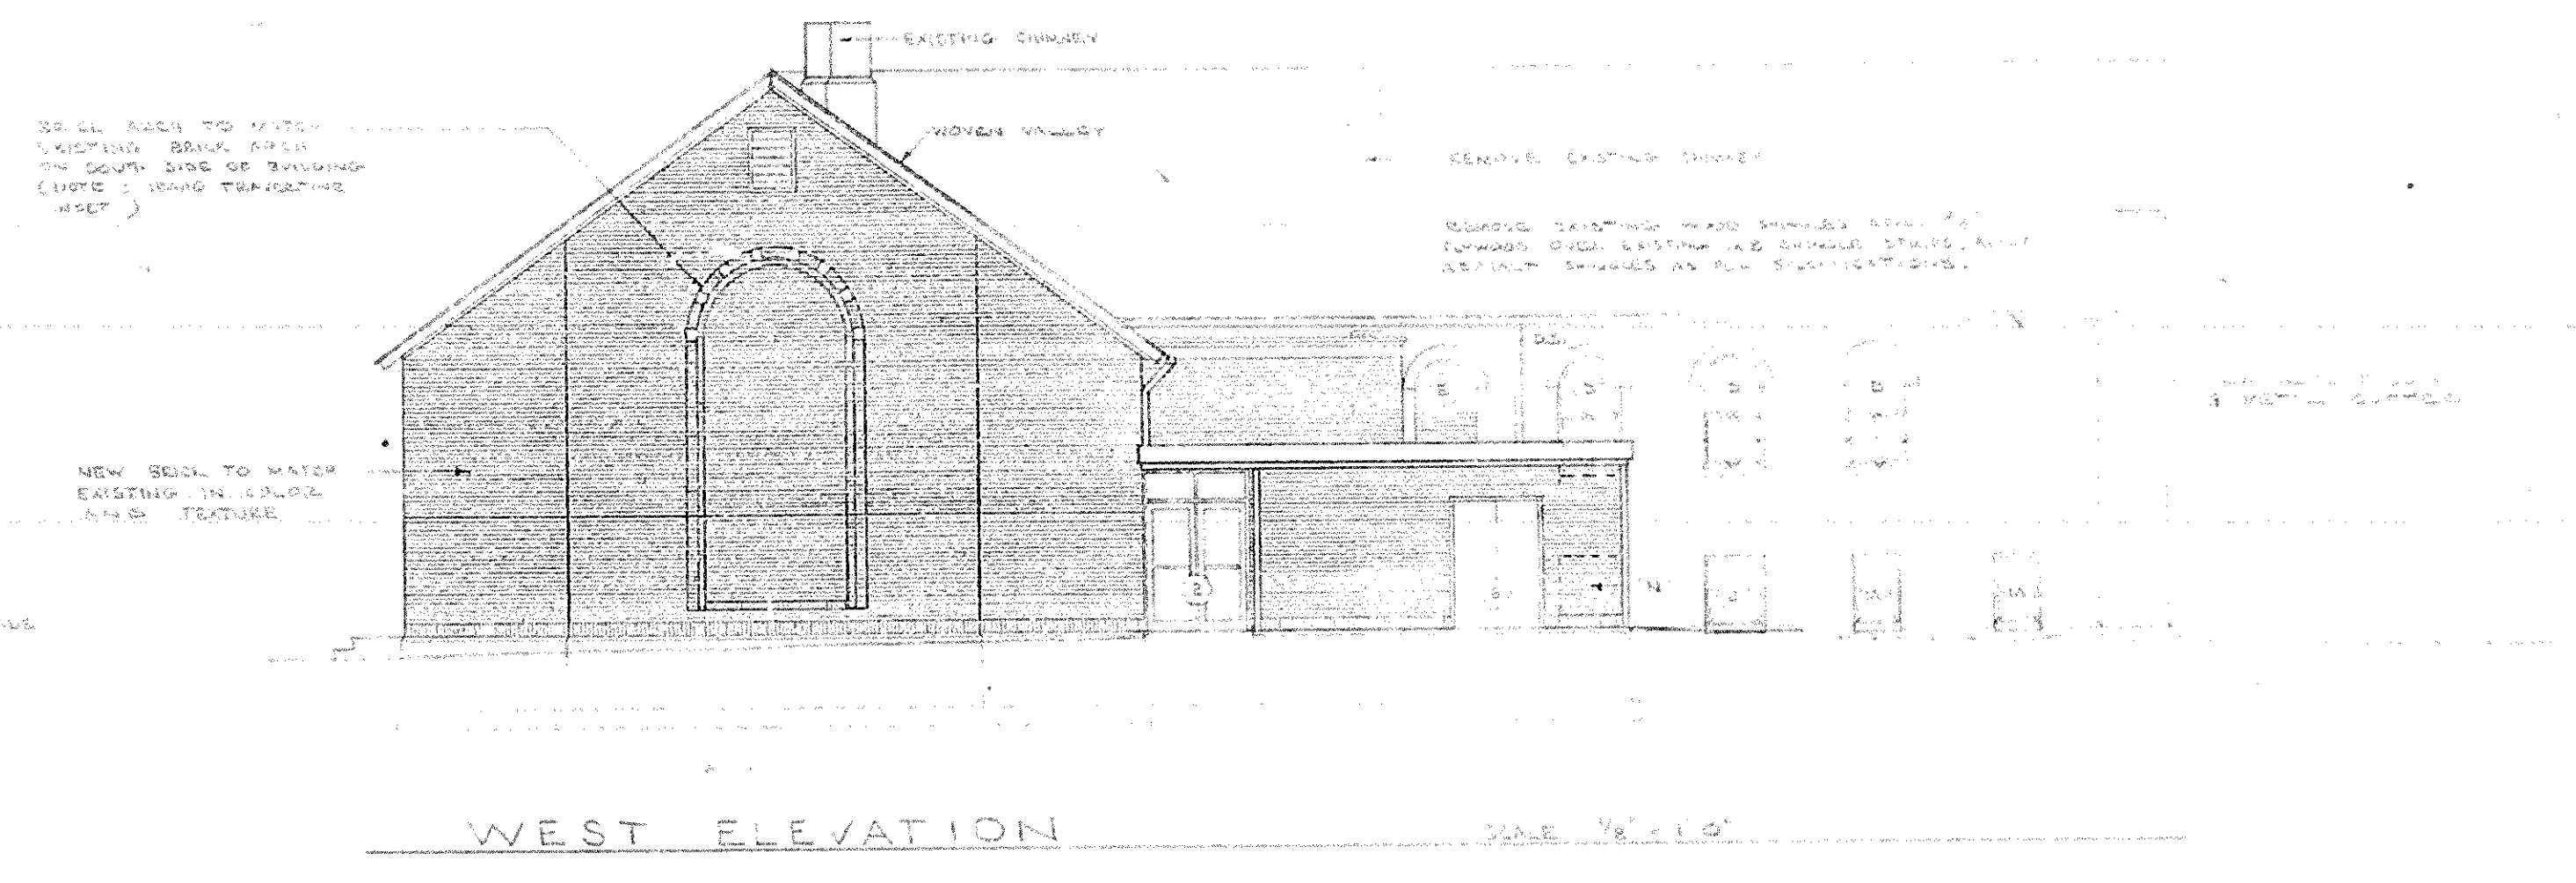

WEST ELEVATION SCALE 1/8" = 1'-0"

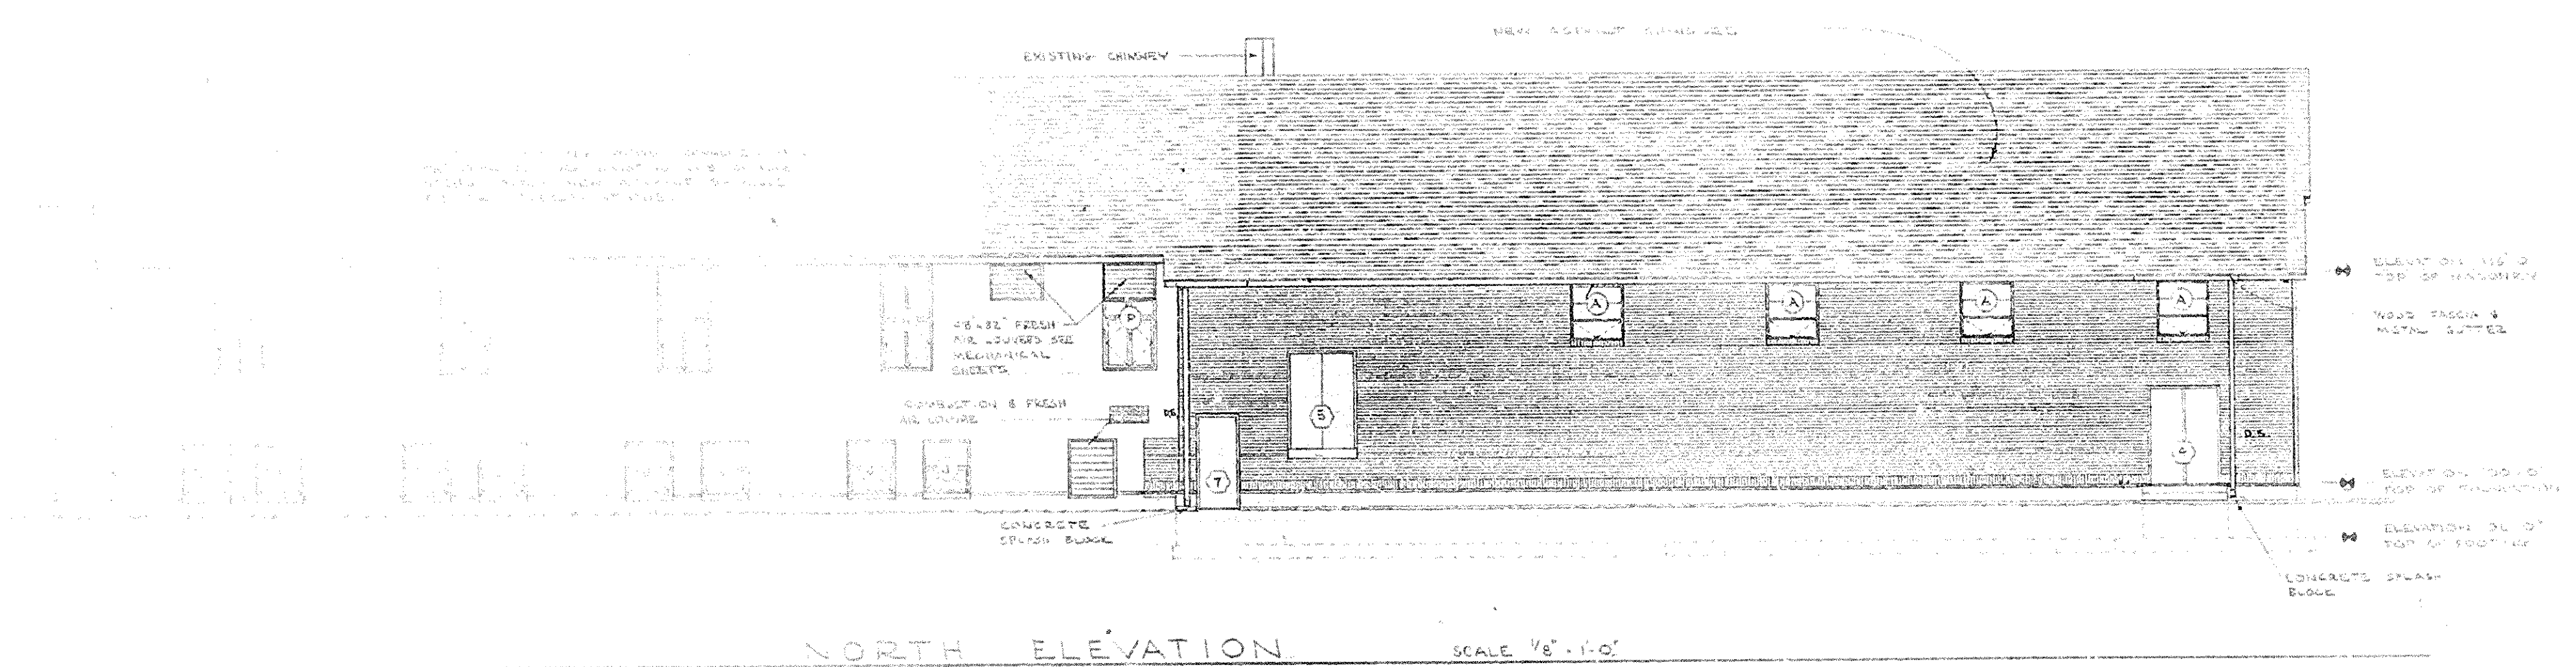

NORTH ELEVATION SCALE 1/8" = 1'-0"

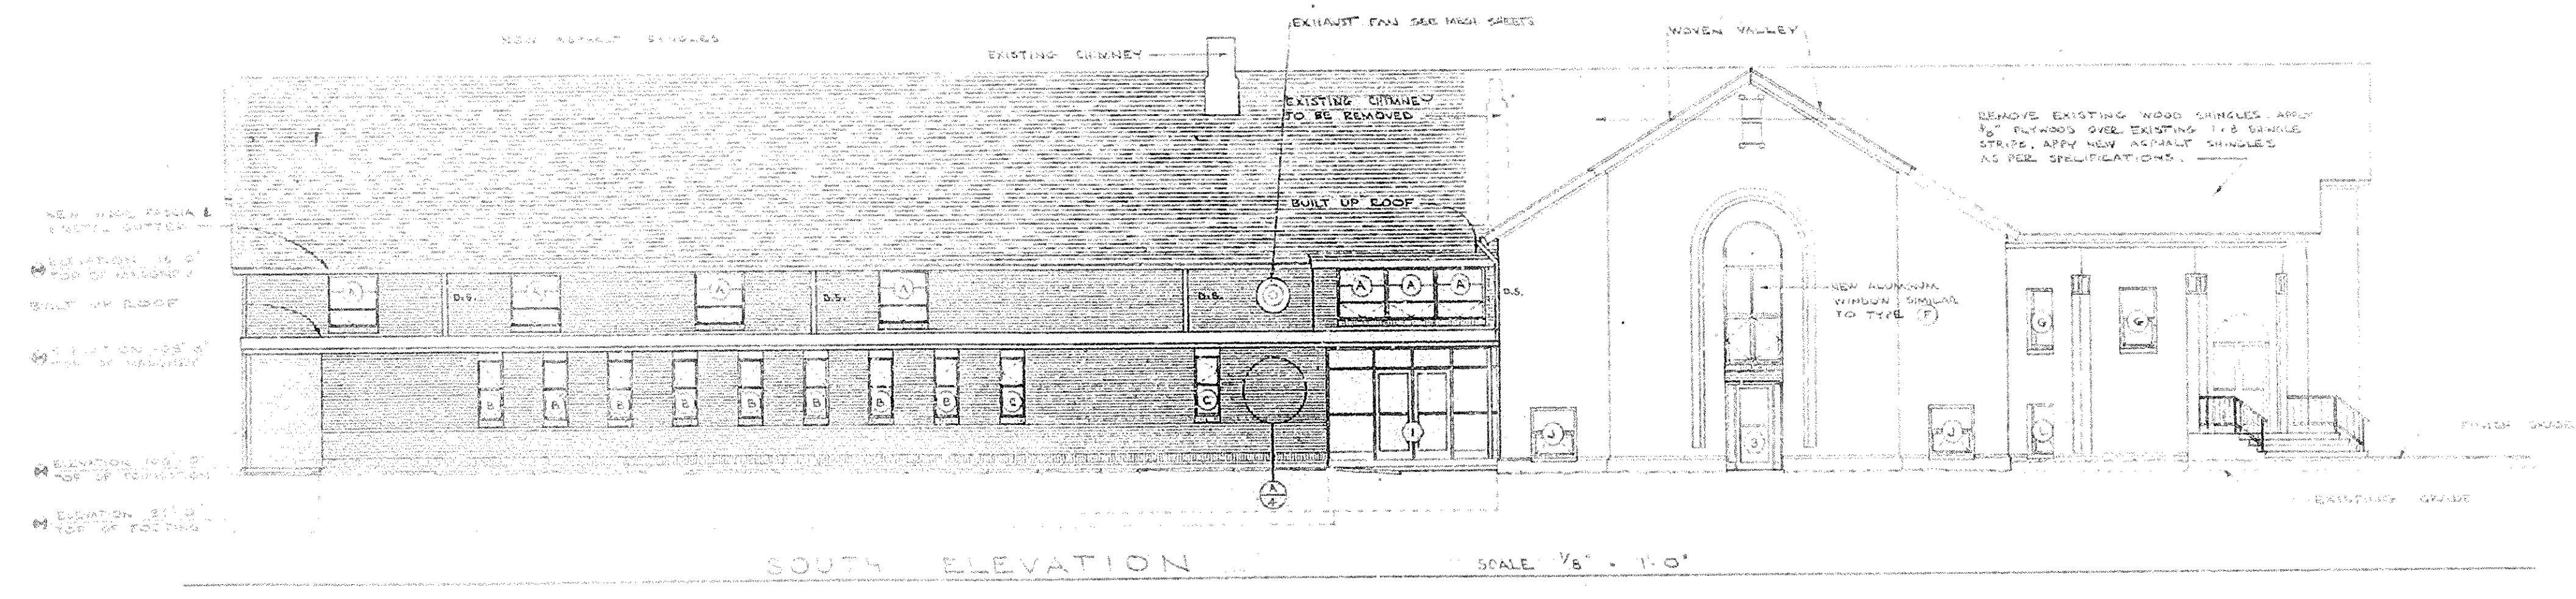


SOUTH ELEVATION SCALE 1/8" = 1'-0"

NOTE 1 REMOVE ALL EXISTING WOOD WINDOWS AND REPLACE WITH NEW ALUMINUM WINDOWS

THE CHURCH OF  
JESUS CHRIST  
OF  
LATTER DAY SAINTS  
MEMORIAL CHURCH

BRASS LETTERS - 1/2" X 1/4"  
MOUNTING DETAIL  
NOT TO SCALE

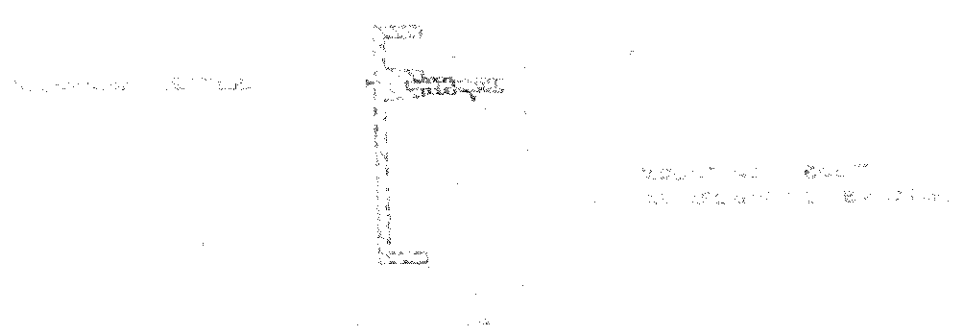

136073

APPROVED	CHECKED	DATE	PROJECT NUMBER

ADDITION & REMODELING OF MEMORIAL CHURCH  
BY HAROLD E. COLLARD ARCHITECT  
THE CHURCH OF JESUS CHRIST OF LATTER DAY SAINTS  
IDAHO FALLS, IDAHO



HAROLD E. COLLARD  
ARCHITECT  
A.I.A.  
IDAHO FALLS, IDAHO

SCALE 1/8" = 1'-0"





SHEET NUMBER  
**A5.20**





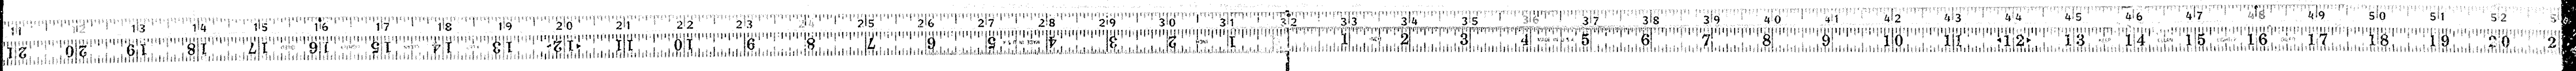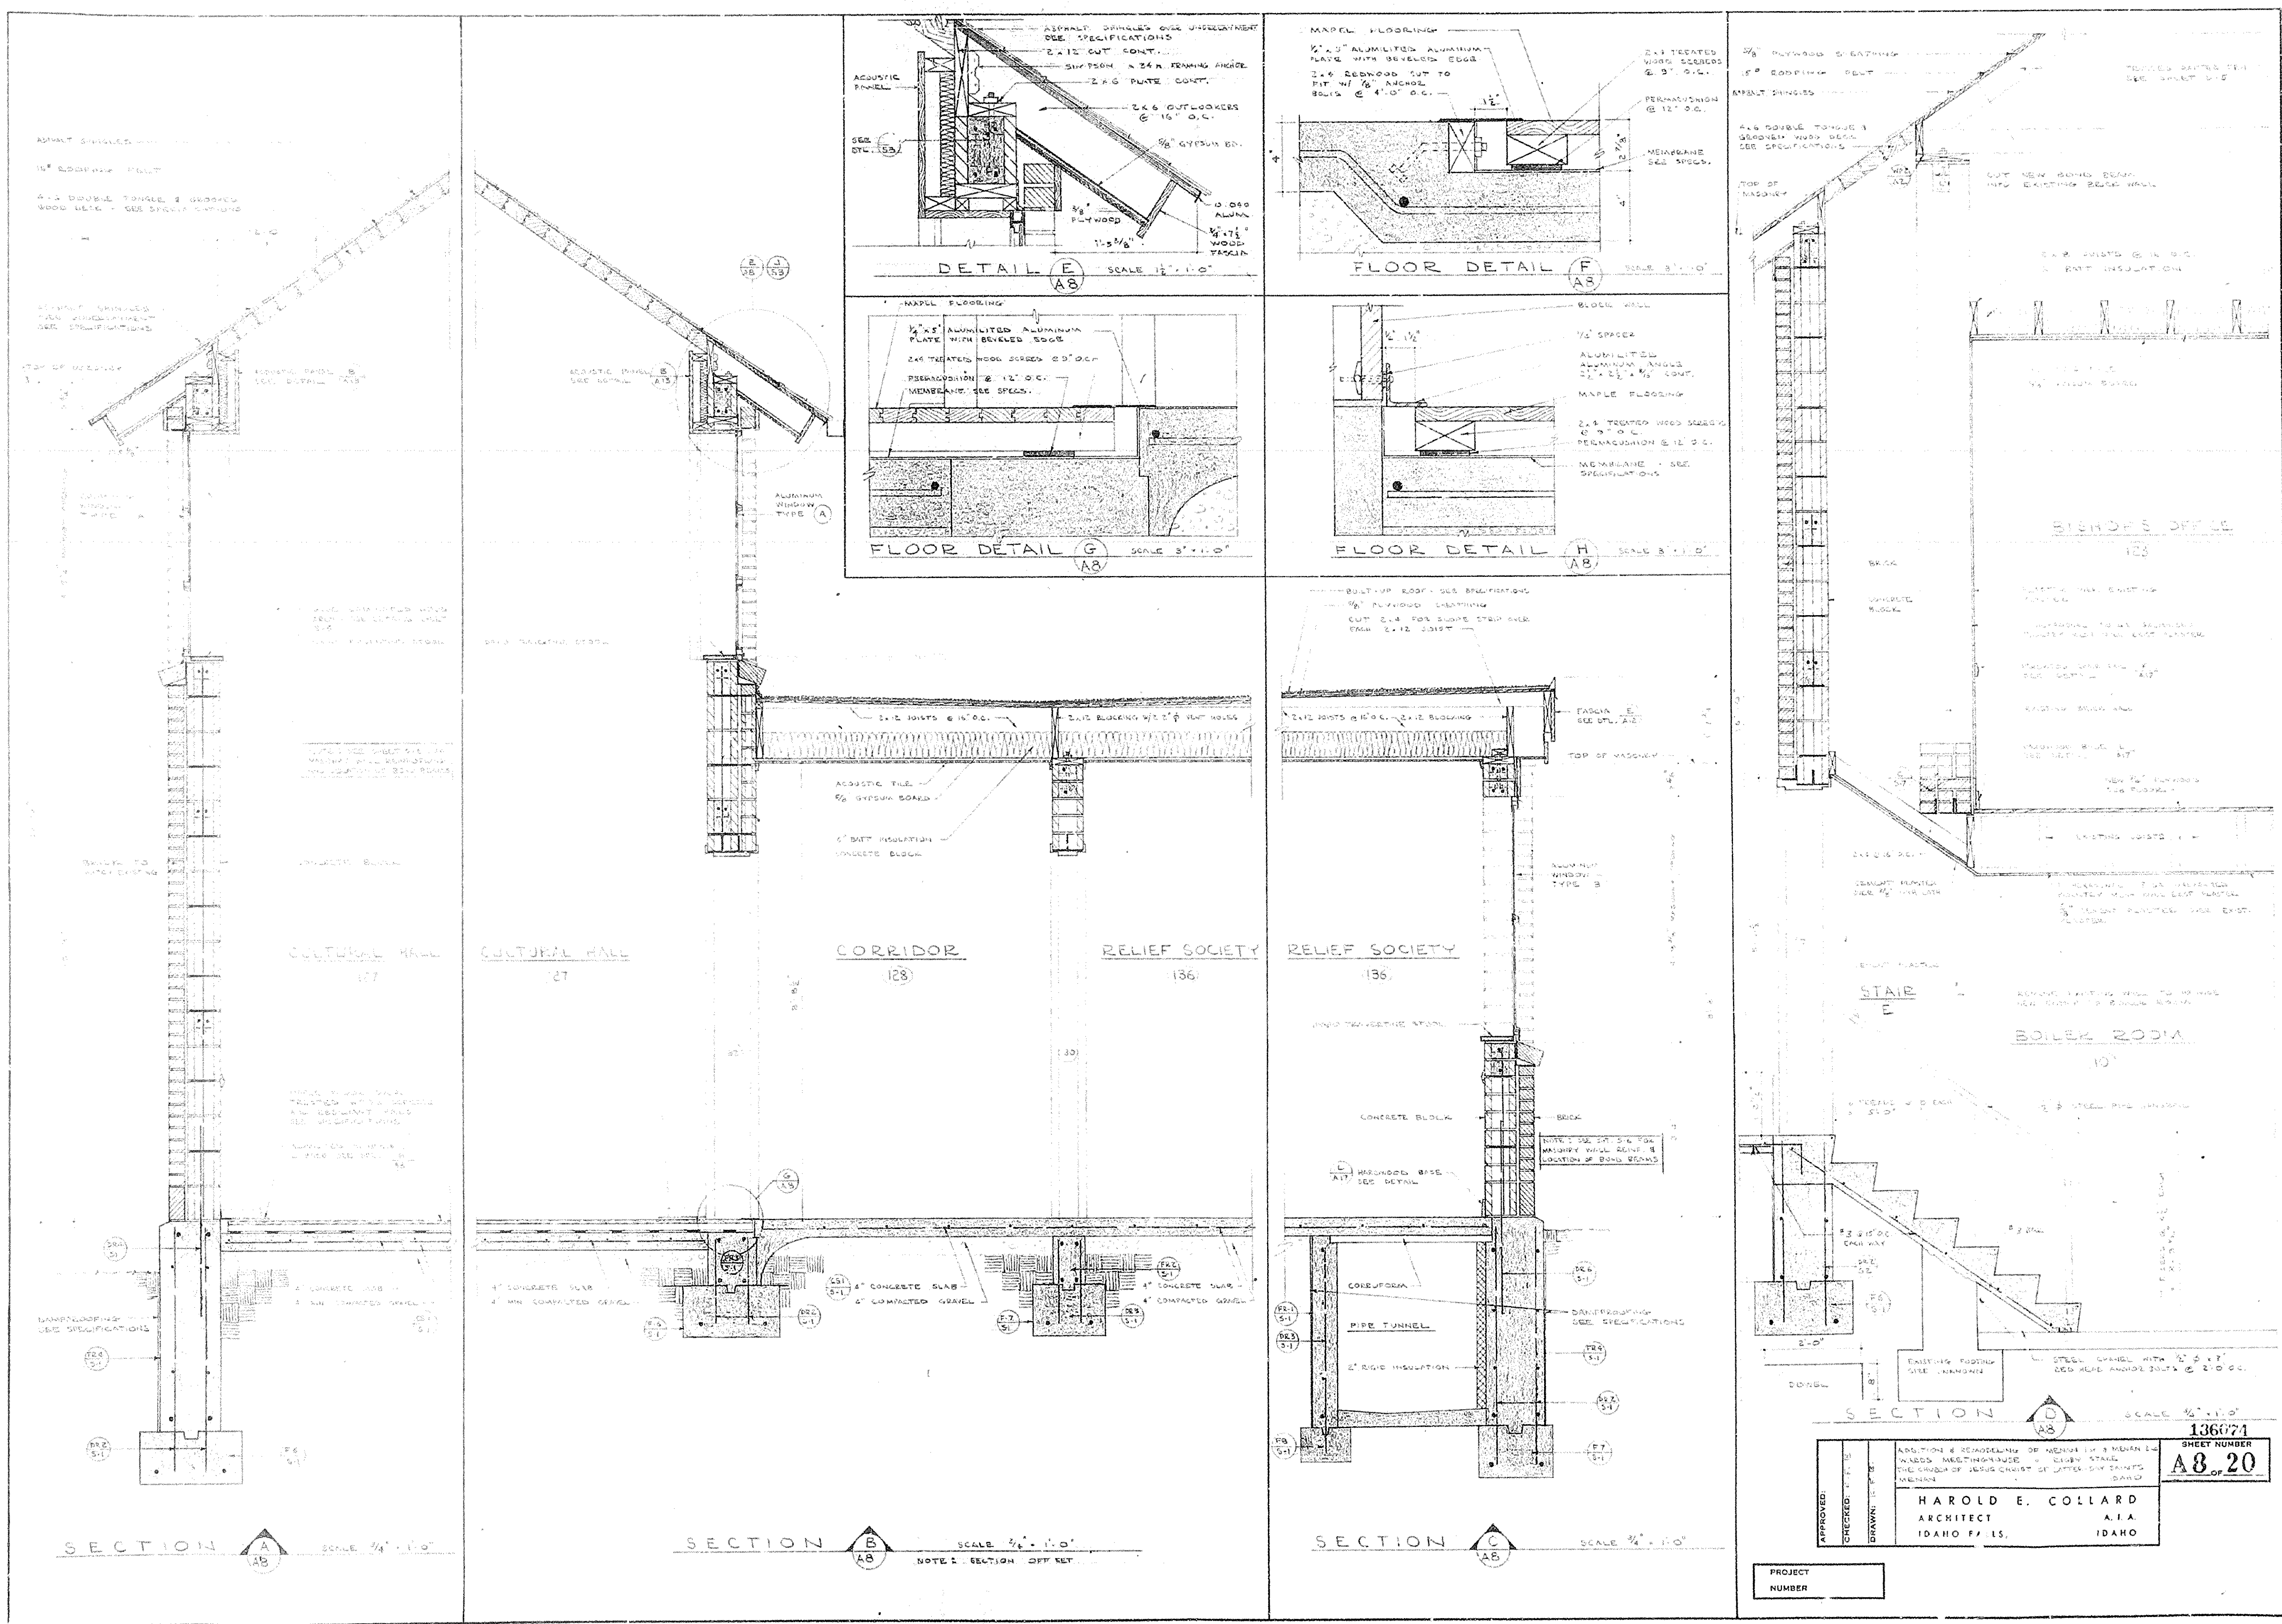





















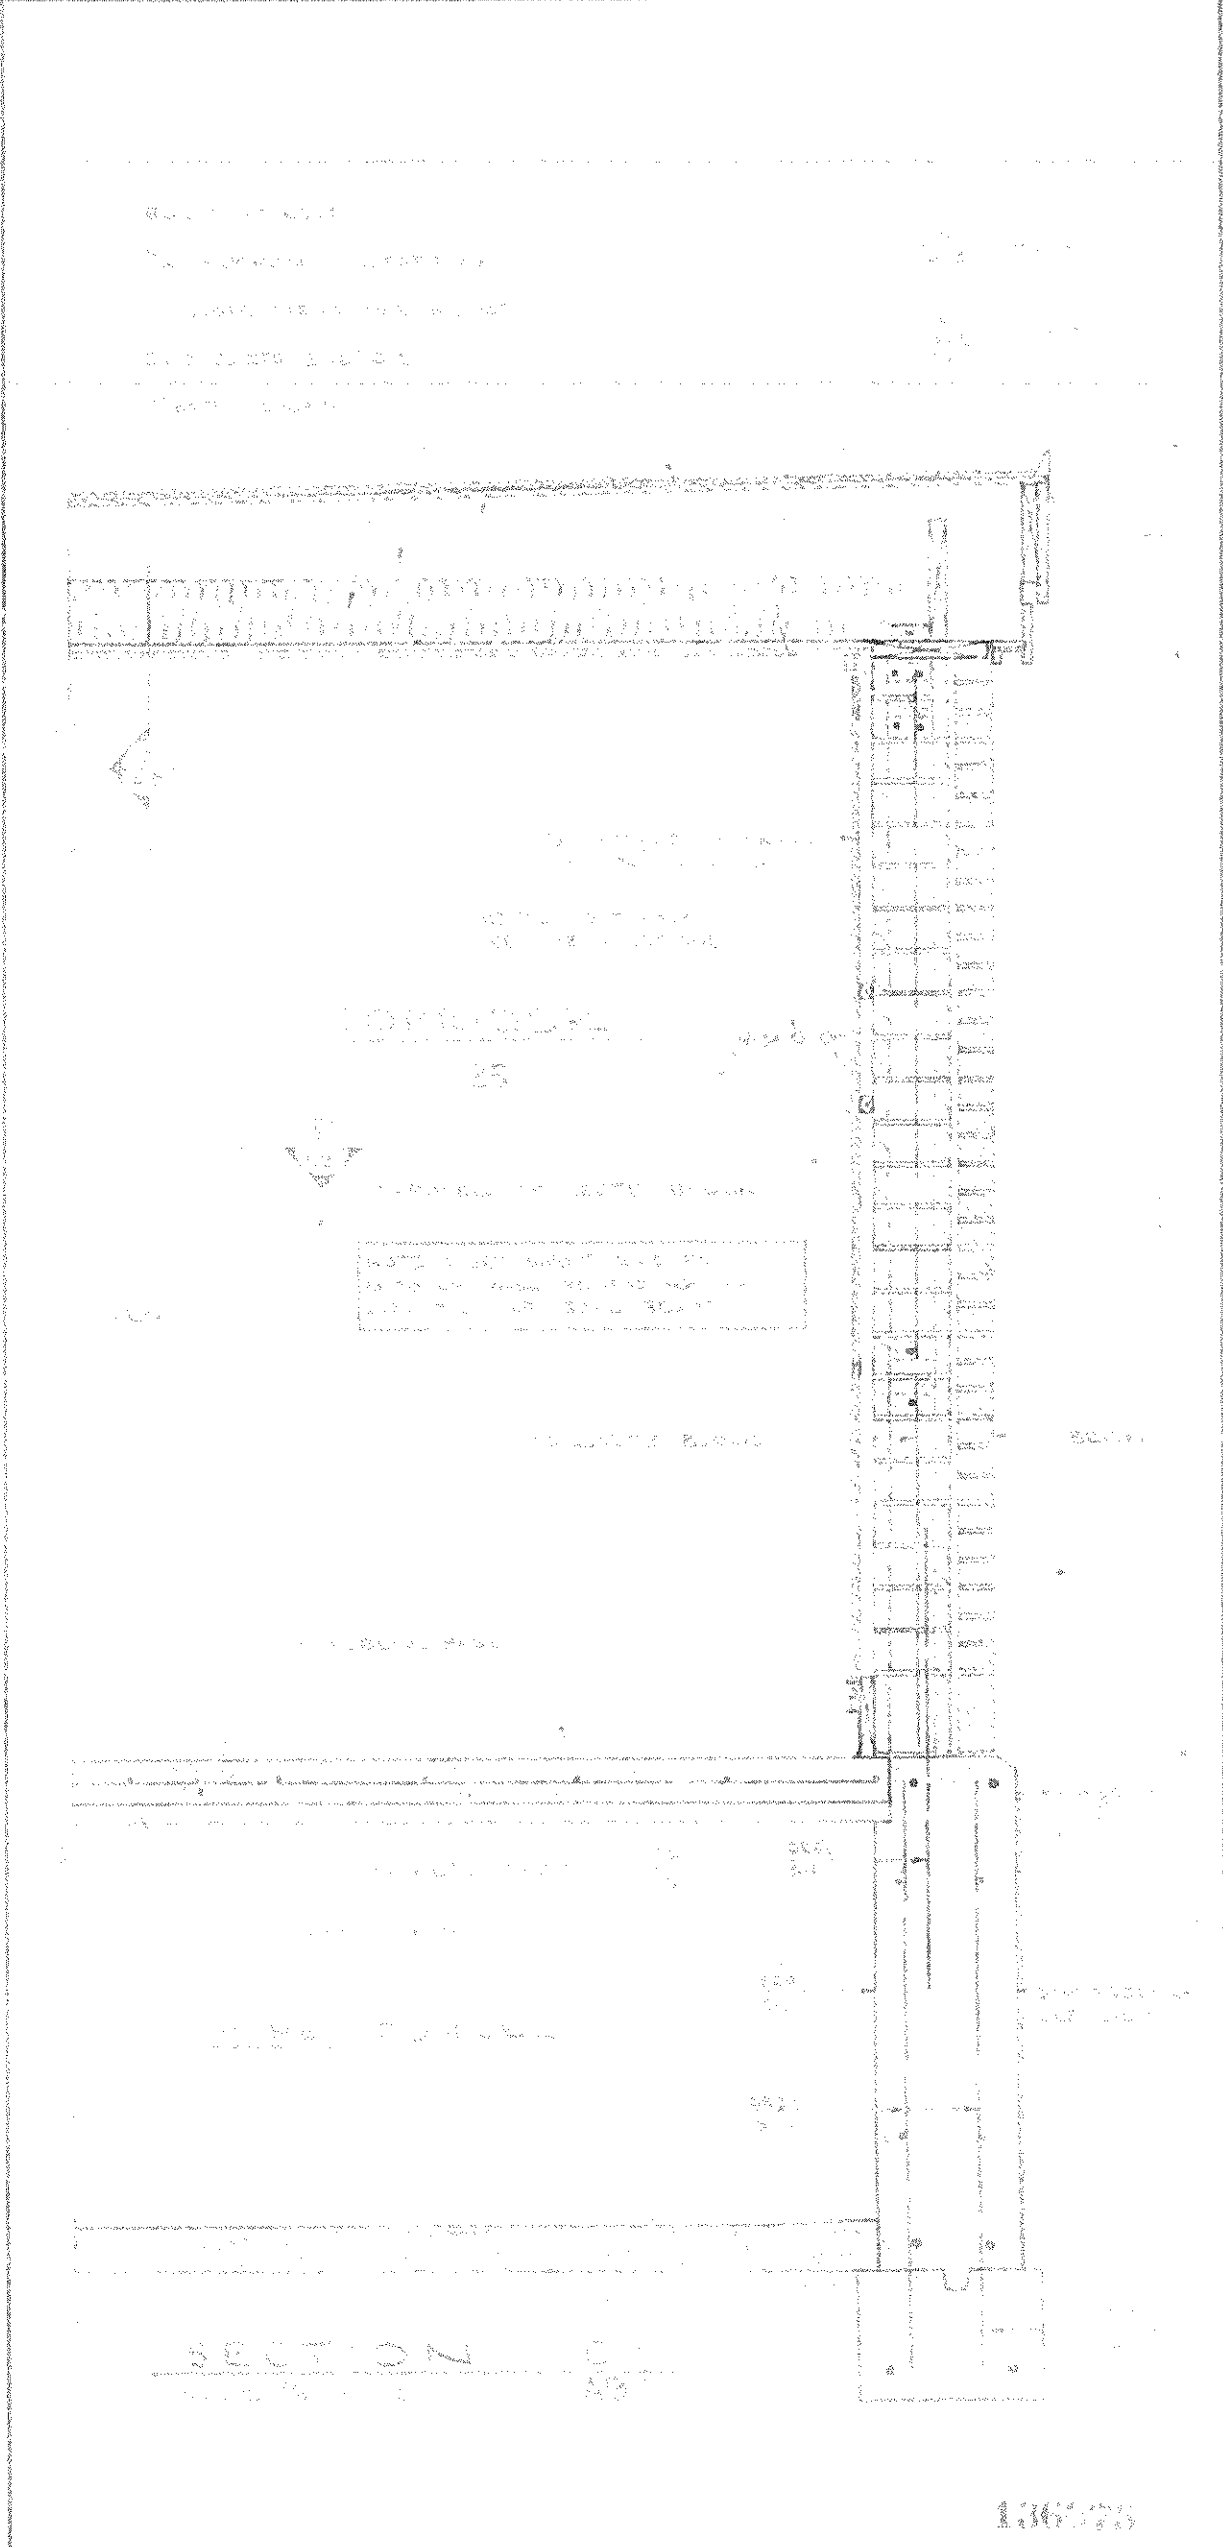
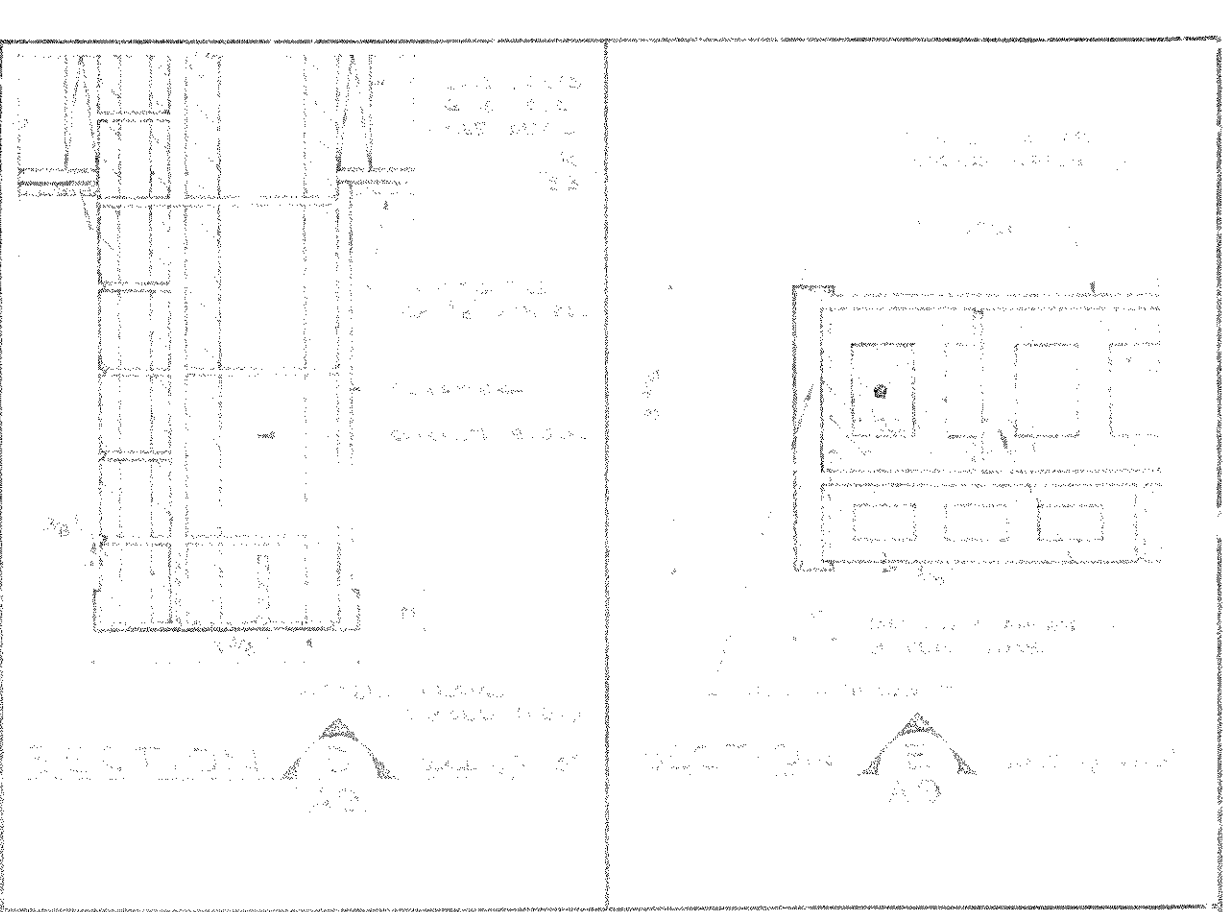
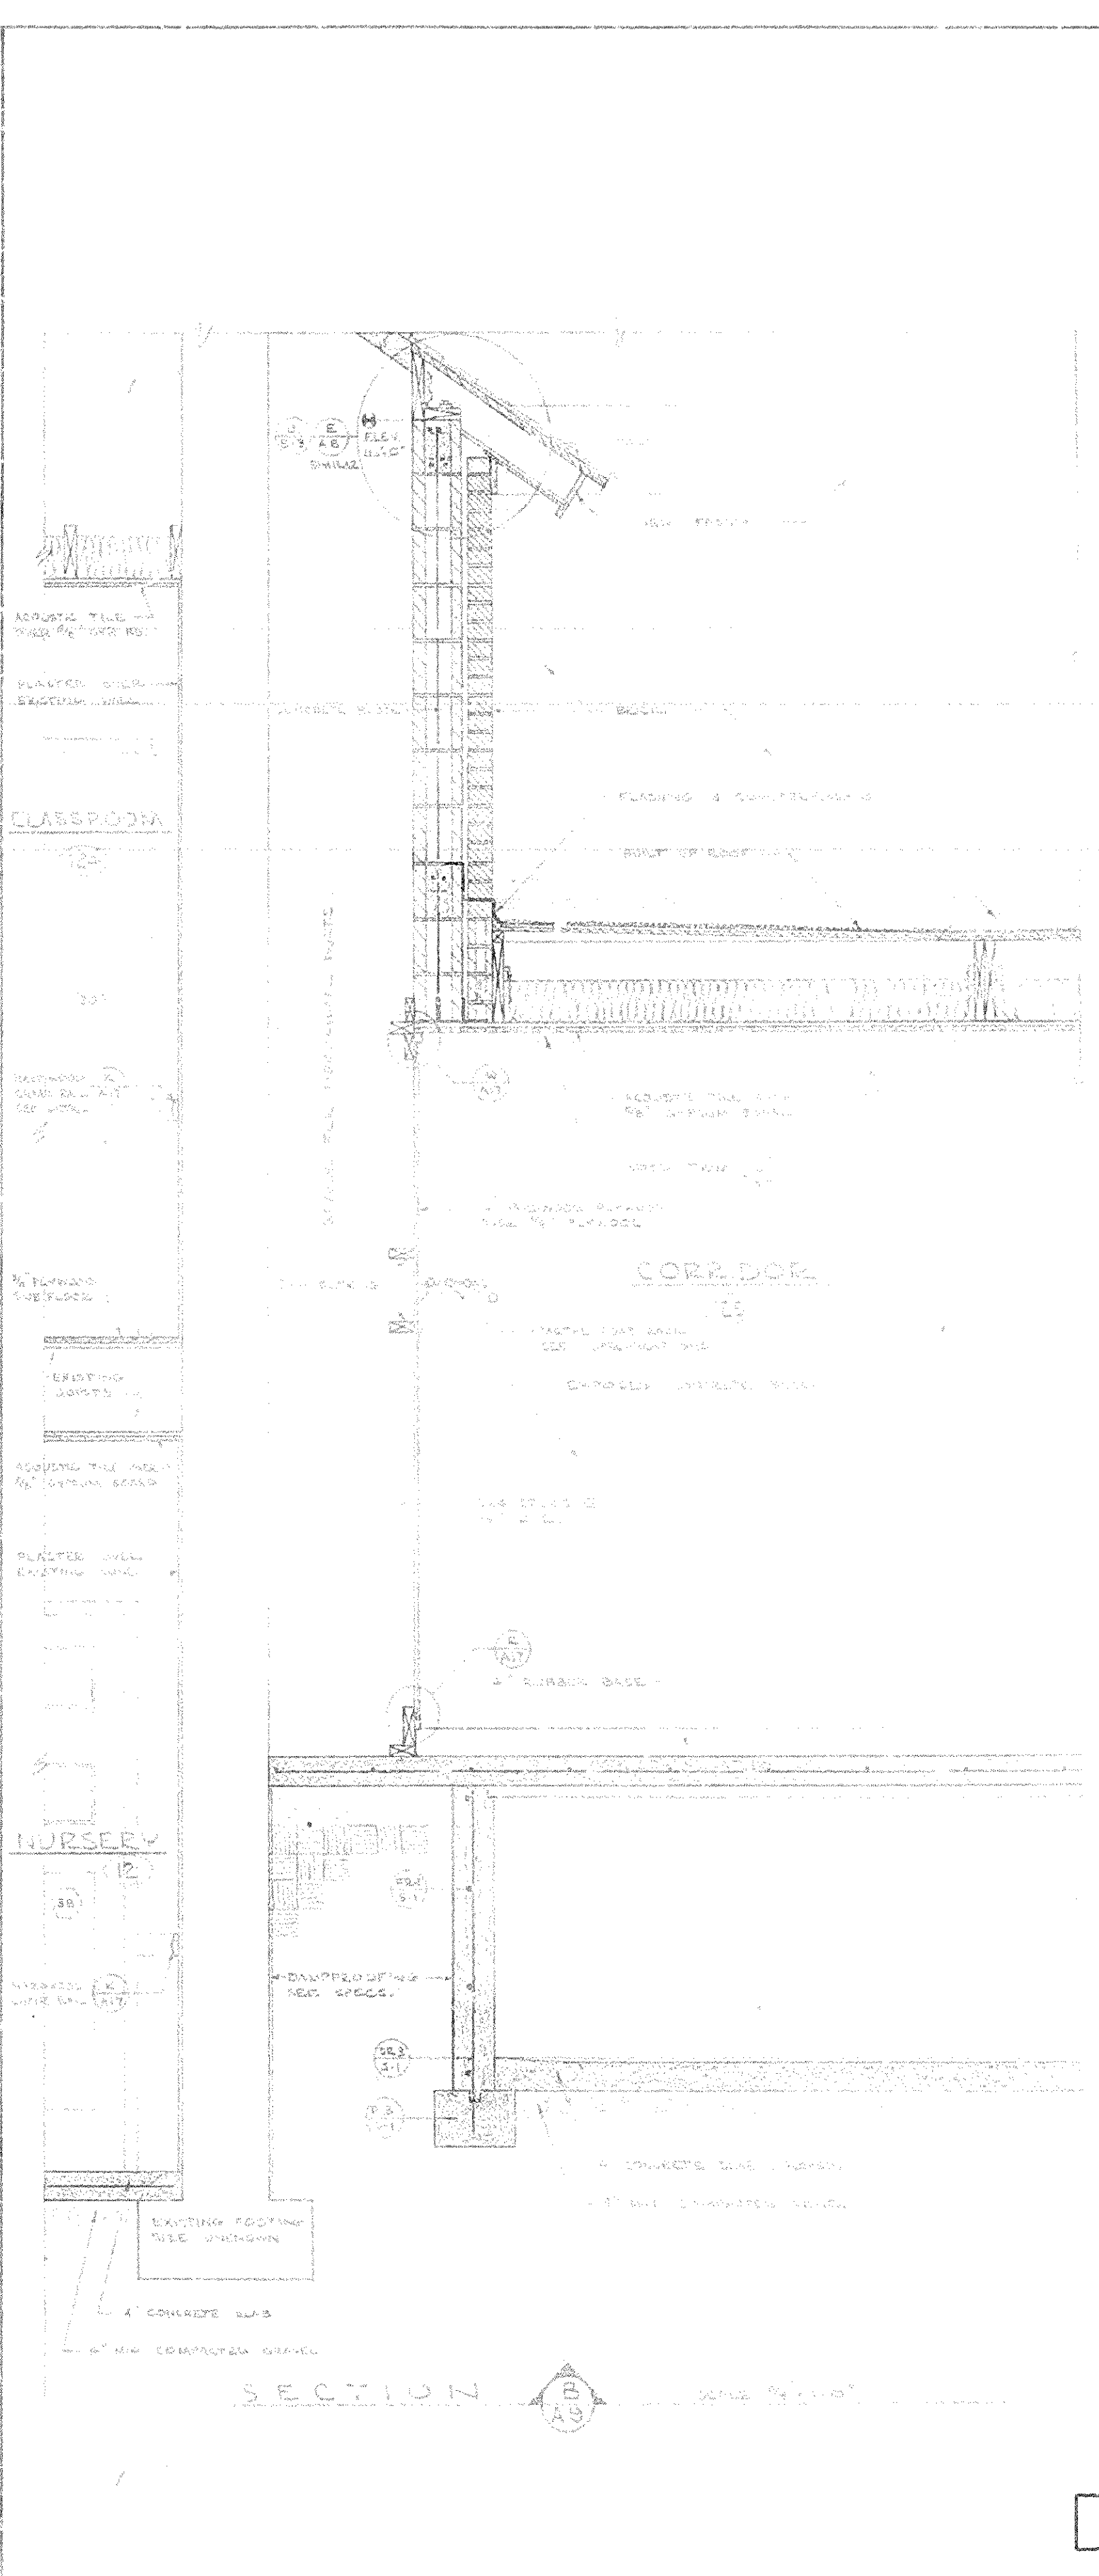
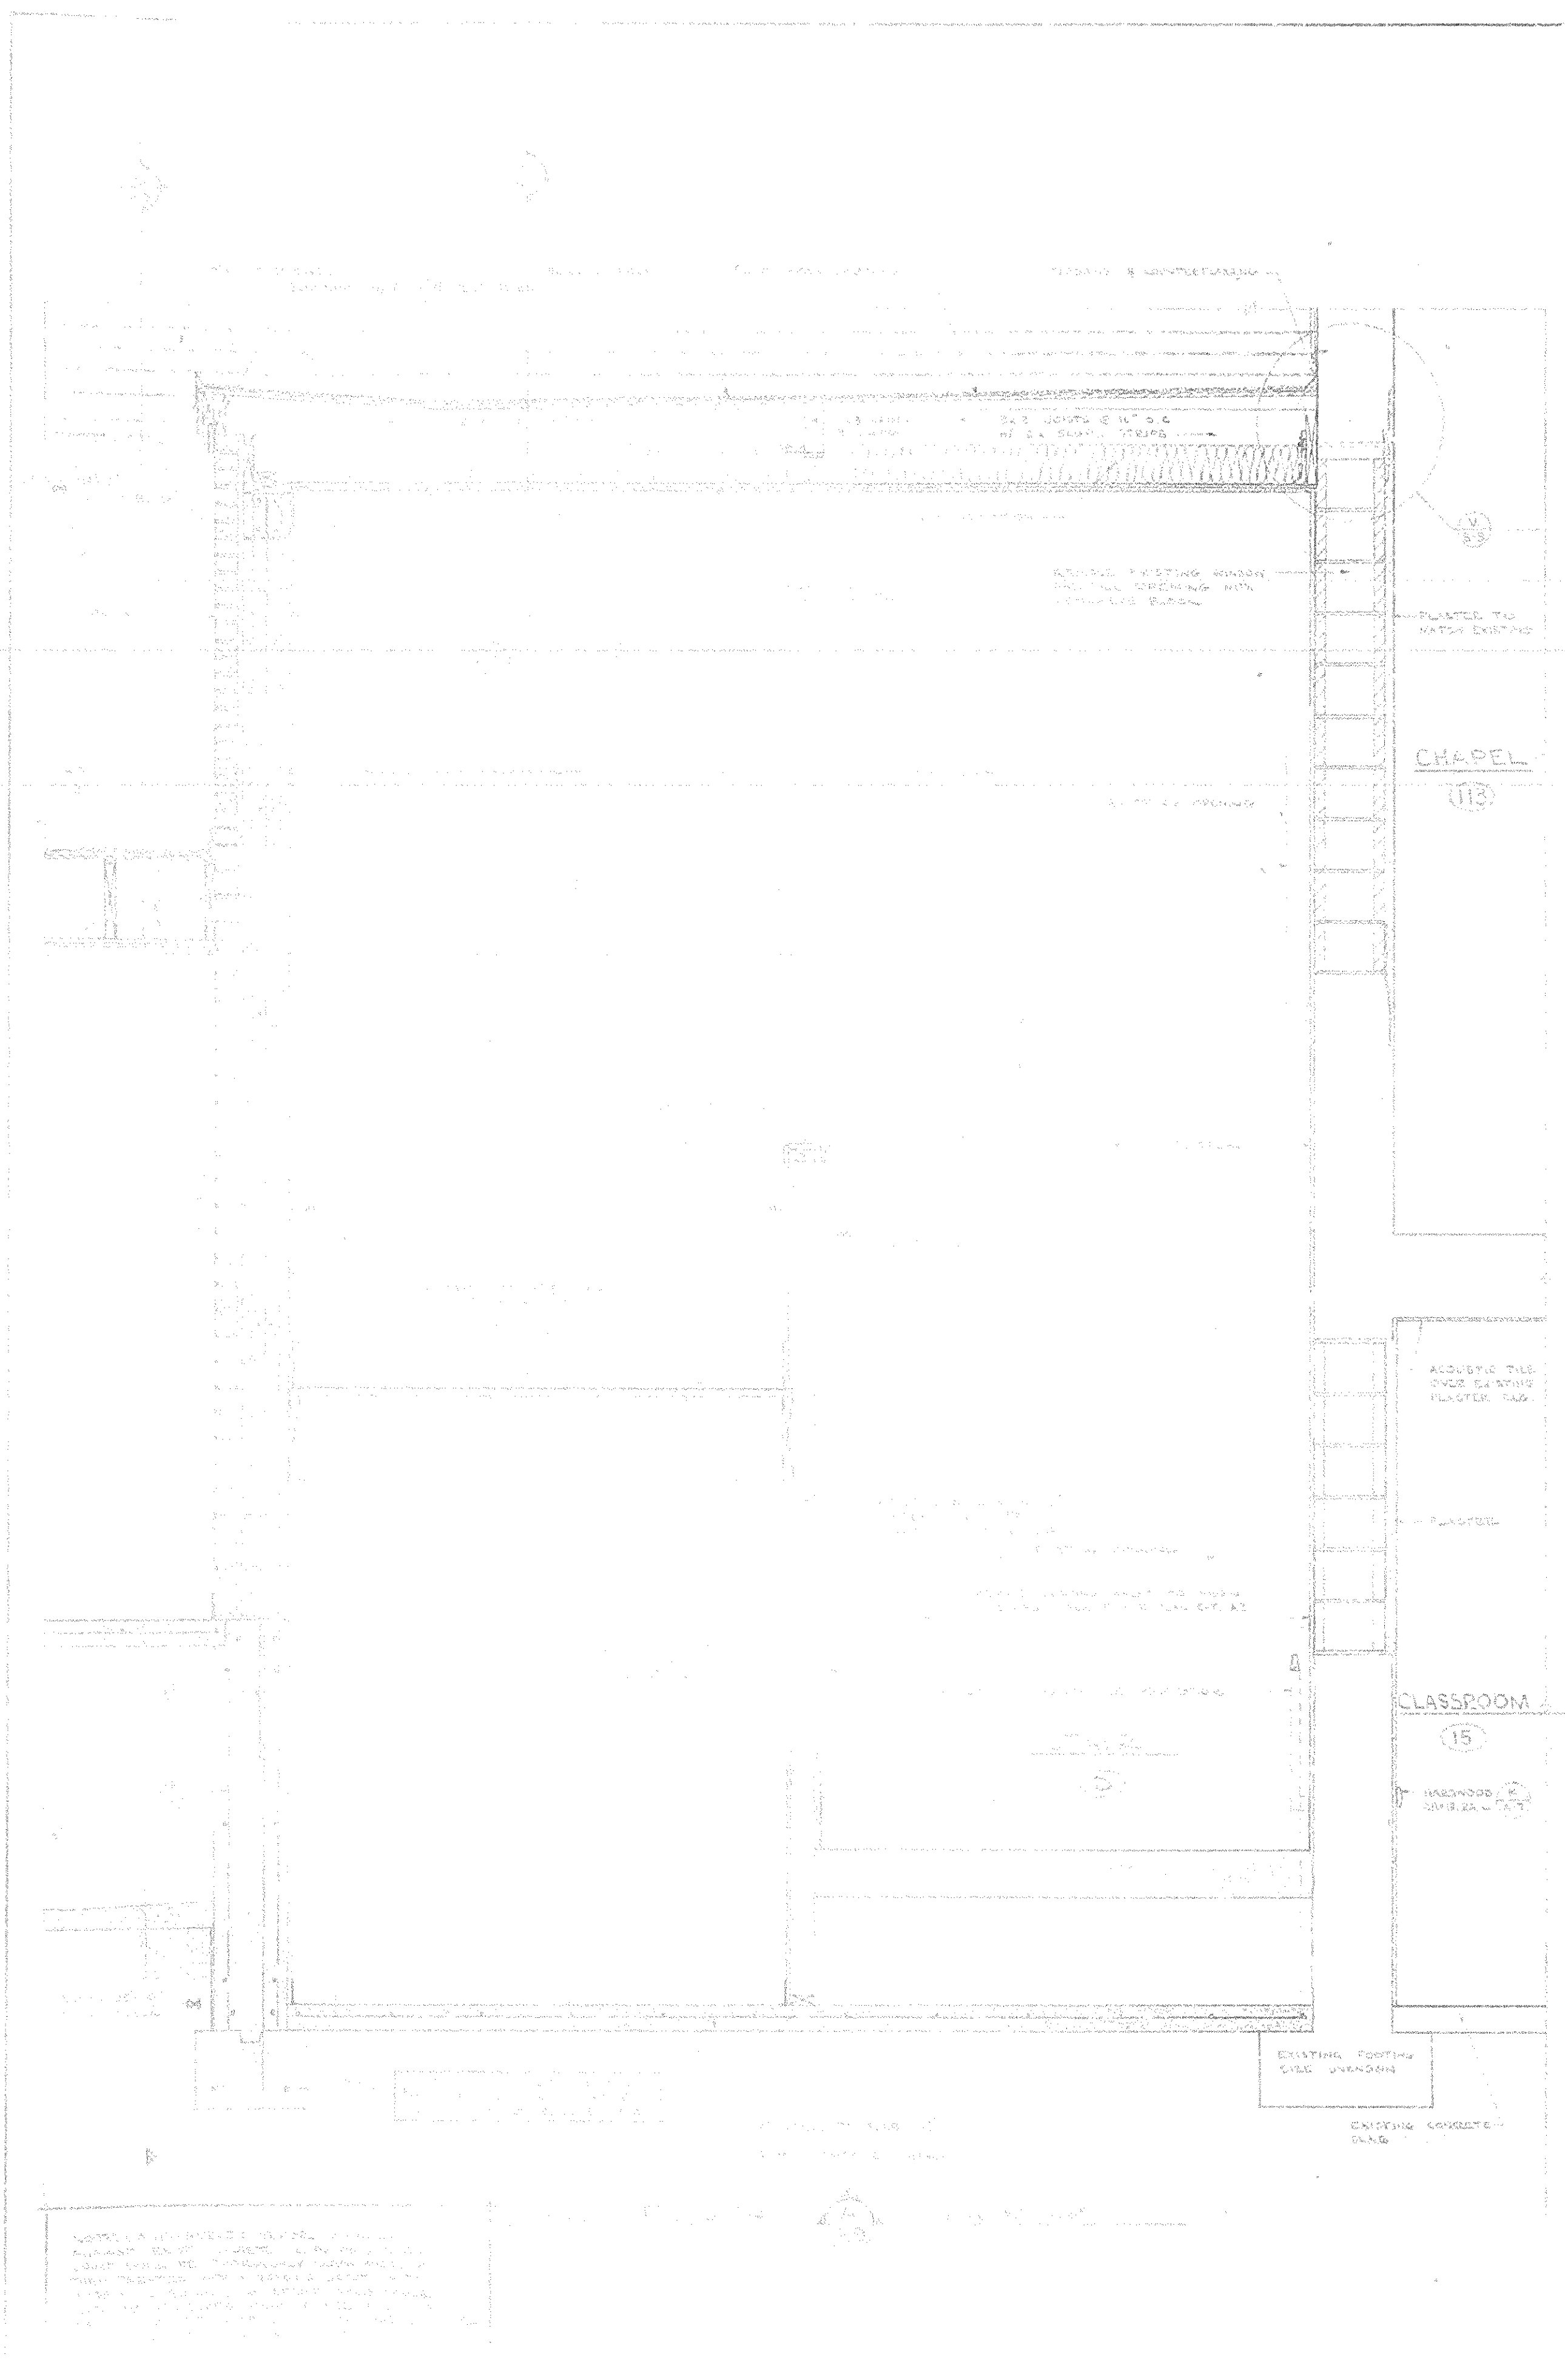


NOTES: 1. ALL DIMENSIONS ARE IN FEET AND INCHES. 2. ALL WALLS ARE 8\"/>

136575  
 SHEET NUMBER  
**A9 20**  
 HAROLD E. COLLARD  
 ARCHITECT A. I. A.  
 IDAHO FALLS, IDAHO

PROJECT NUMBER

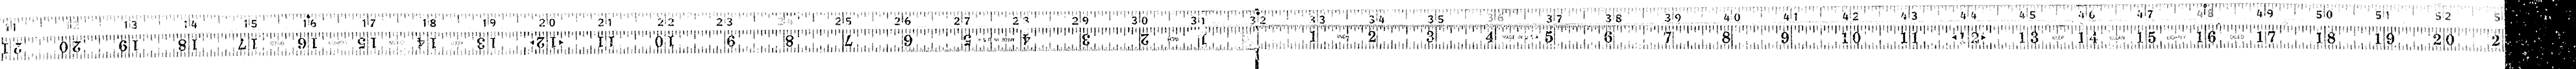

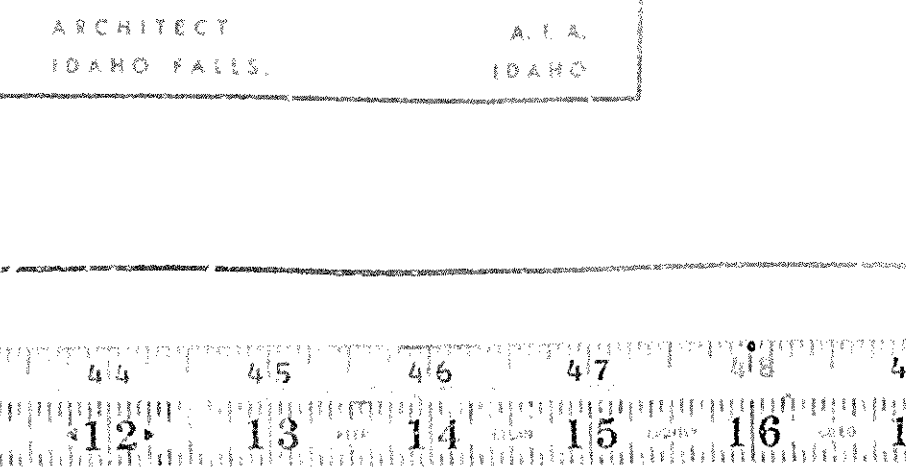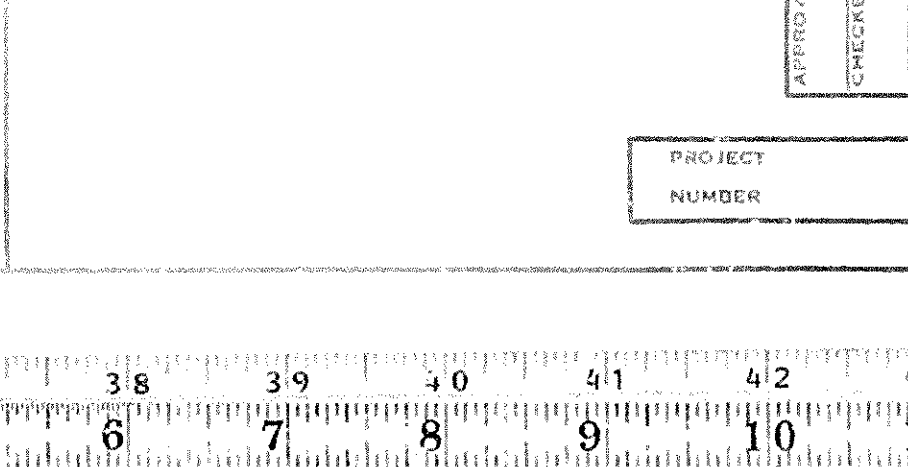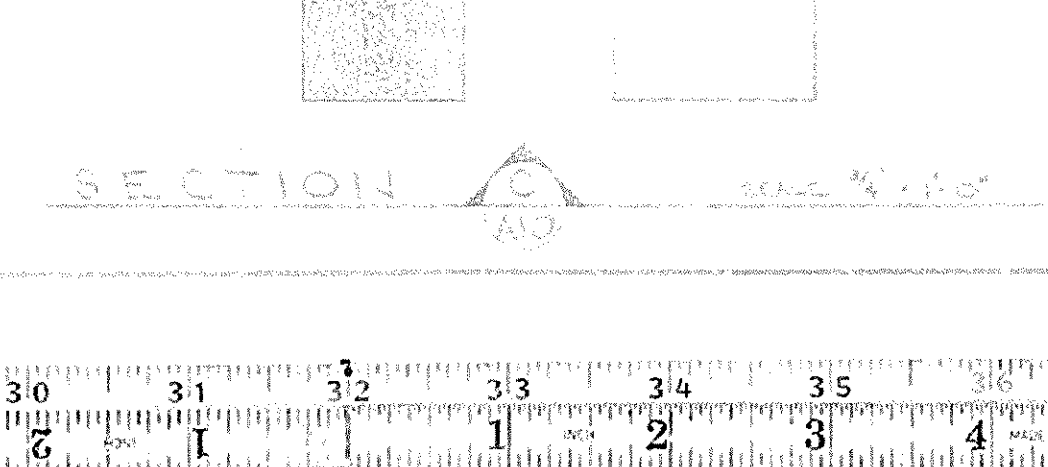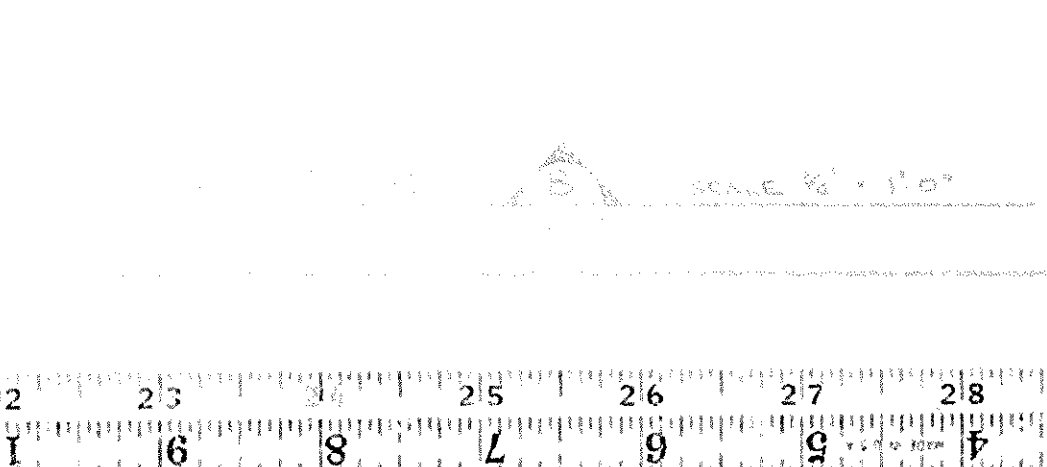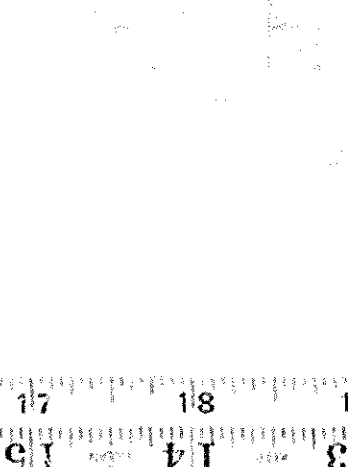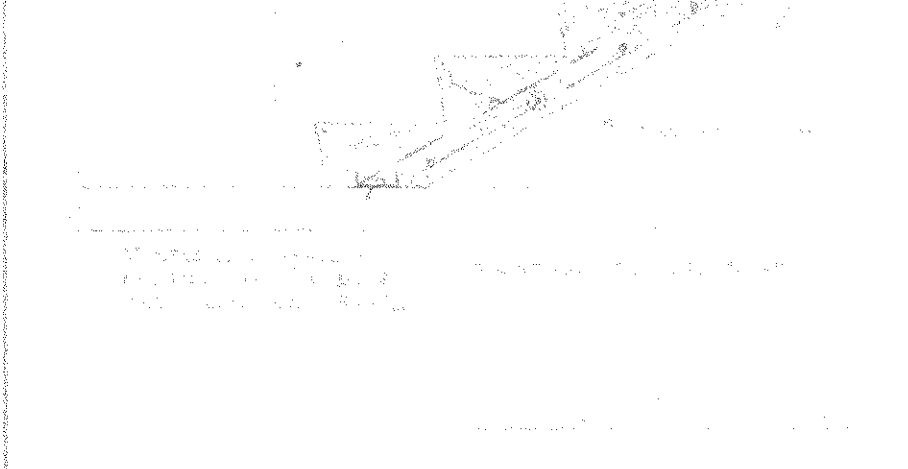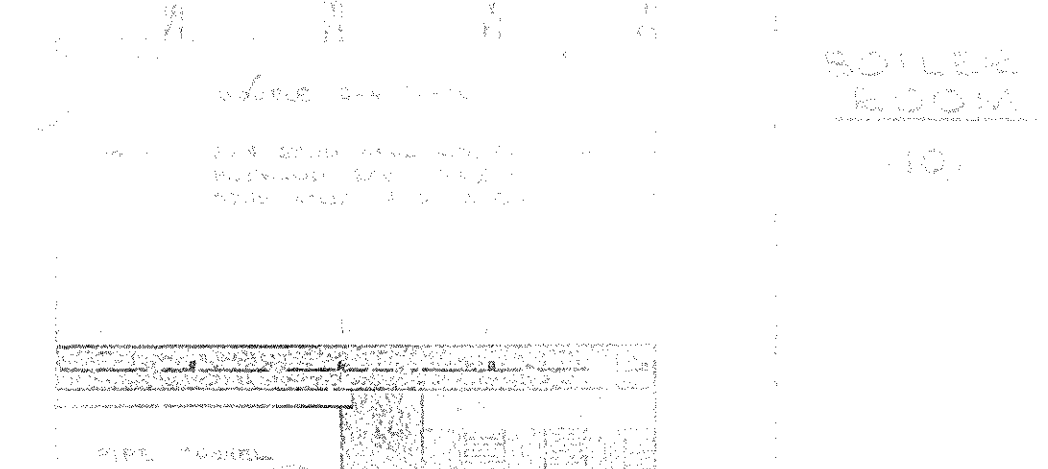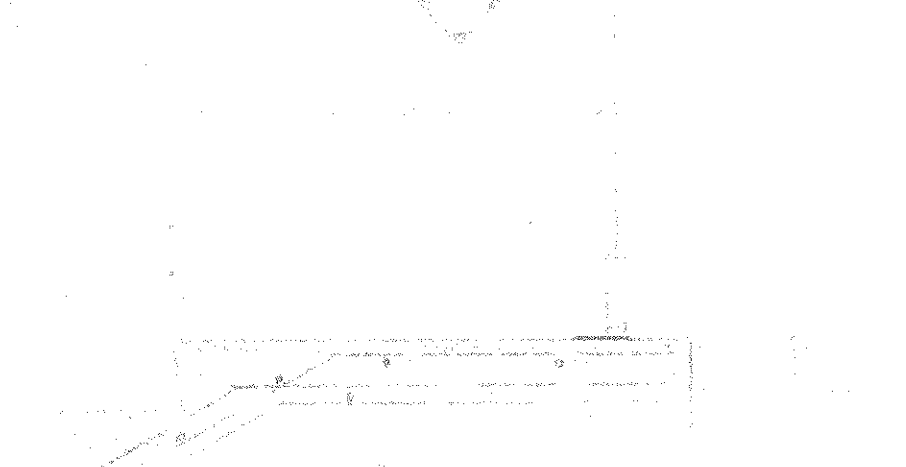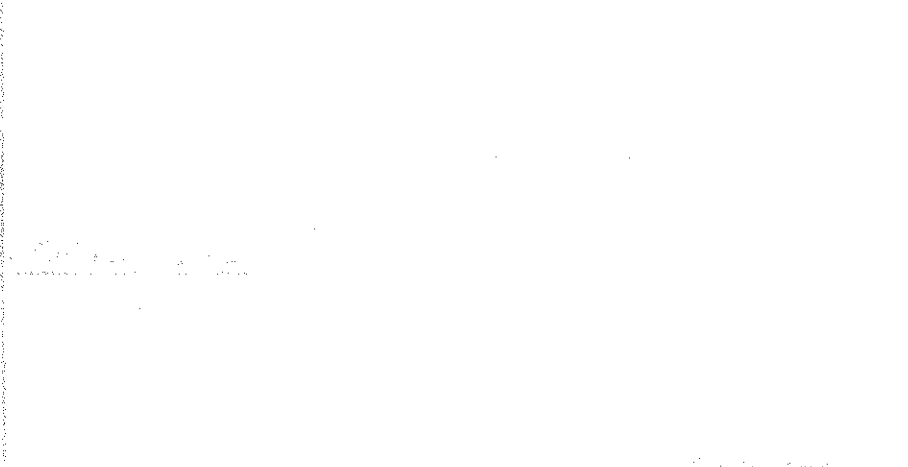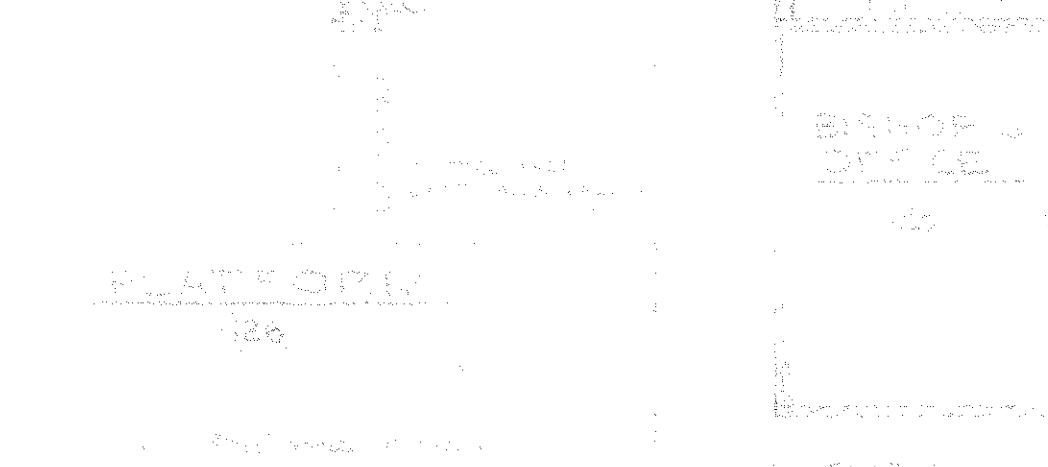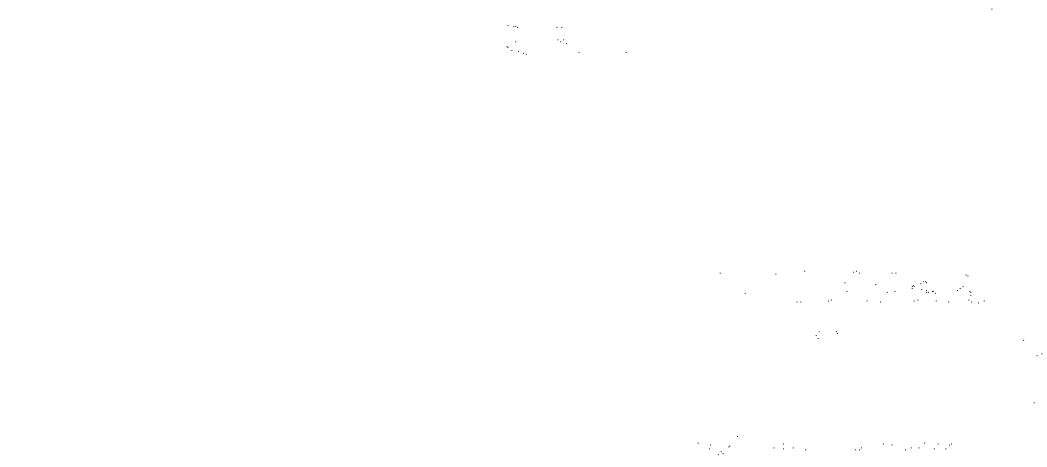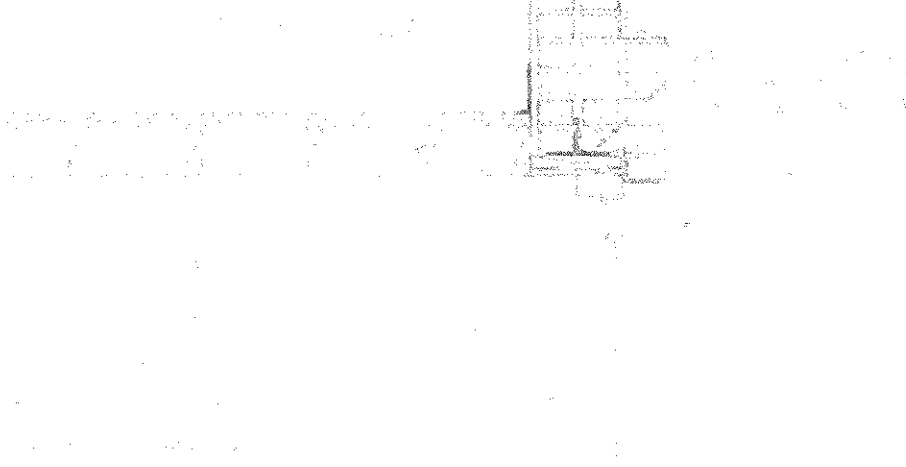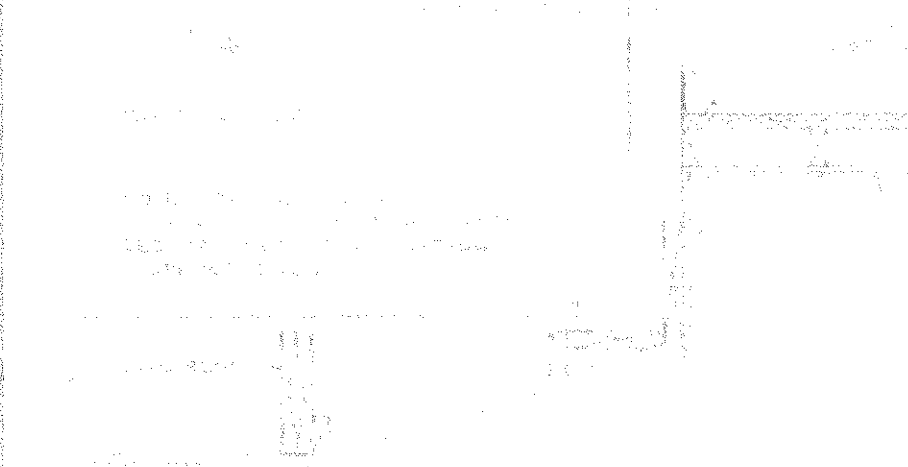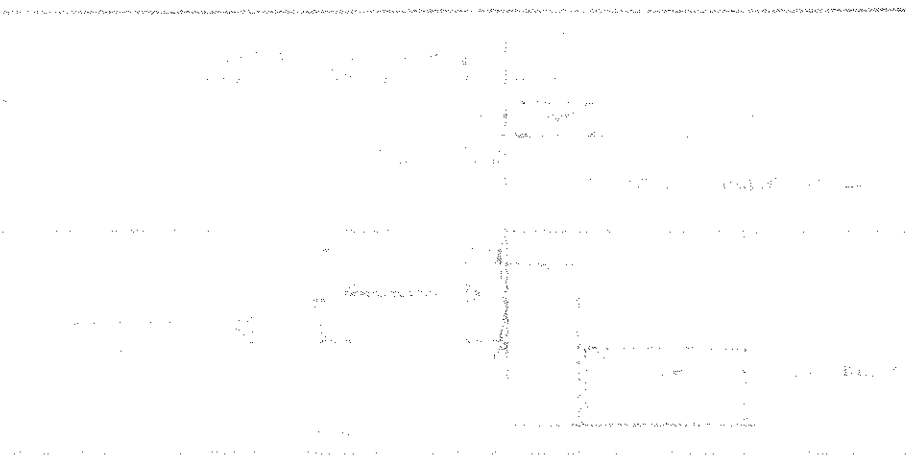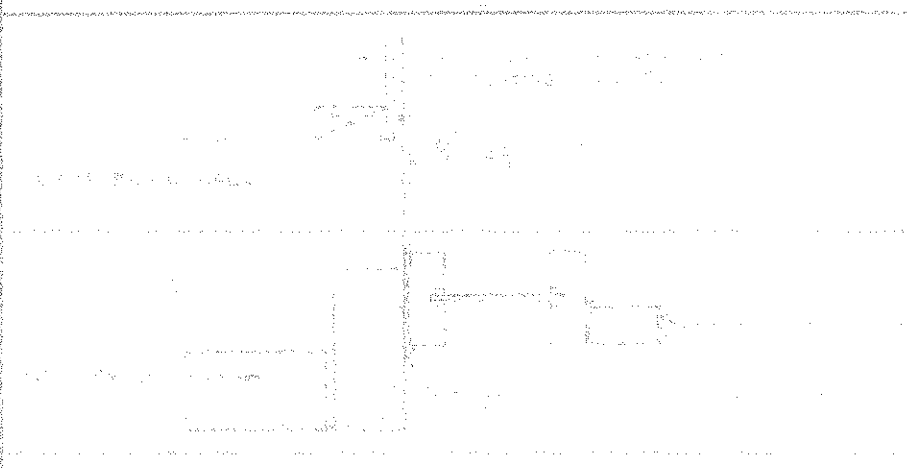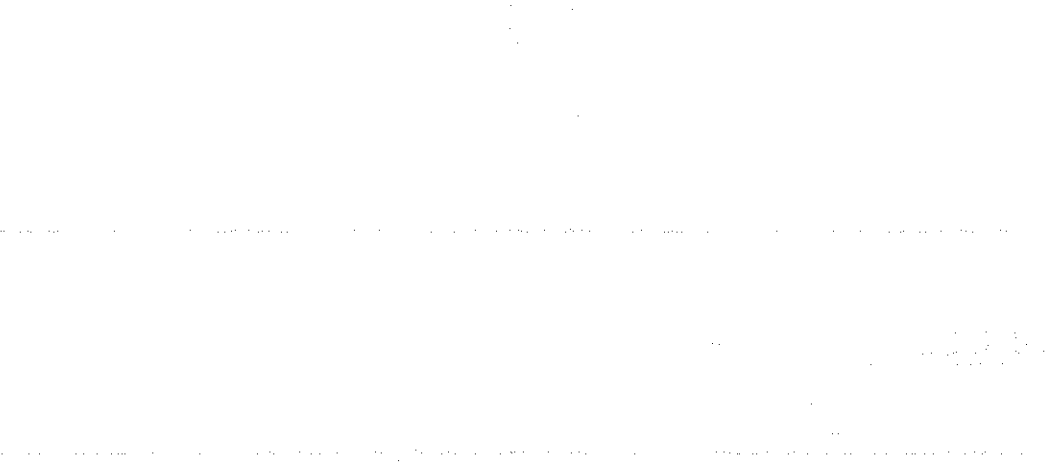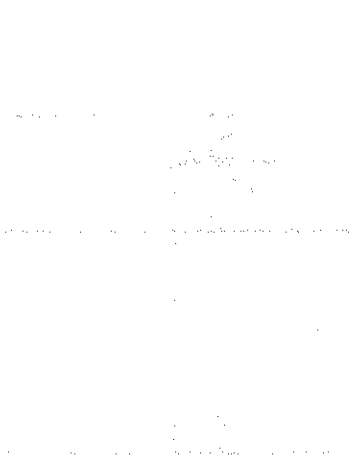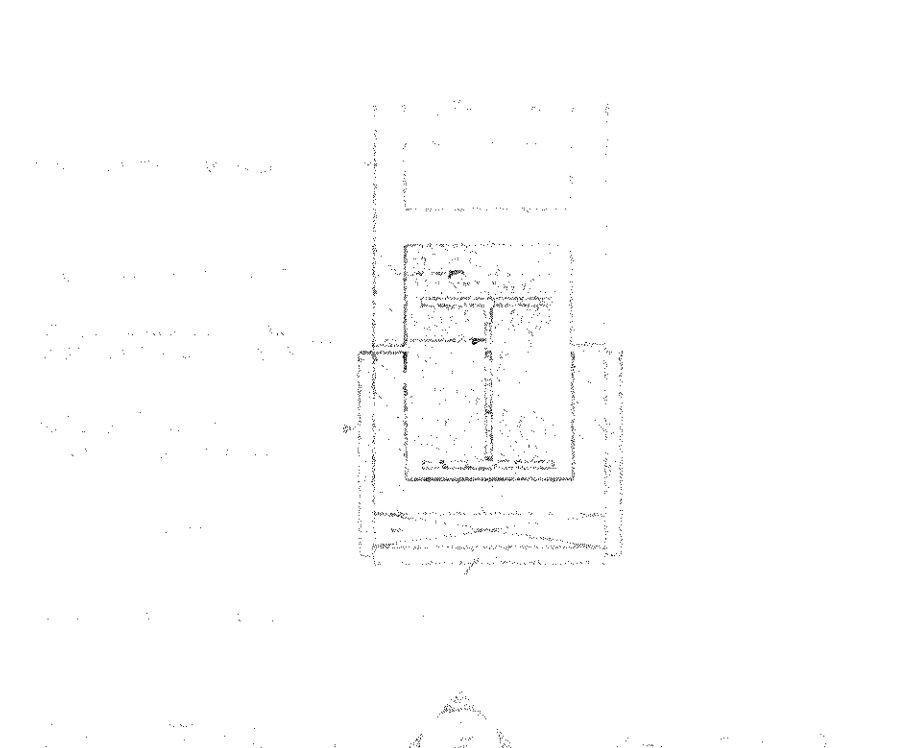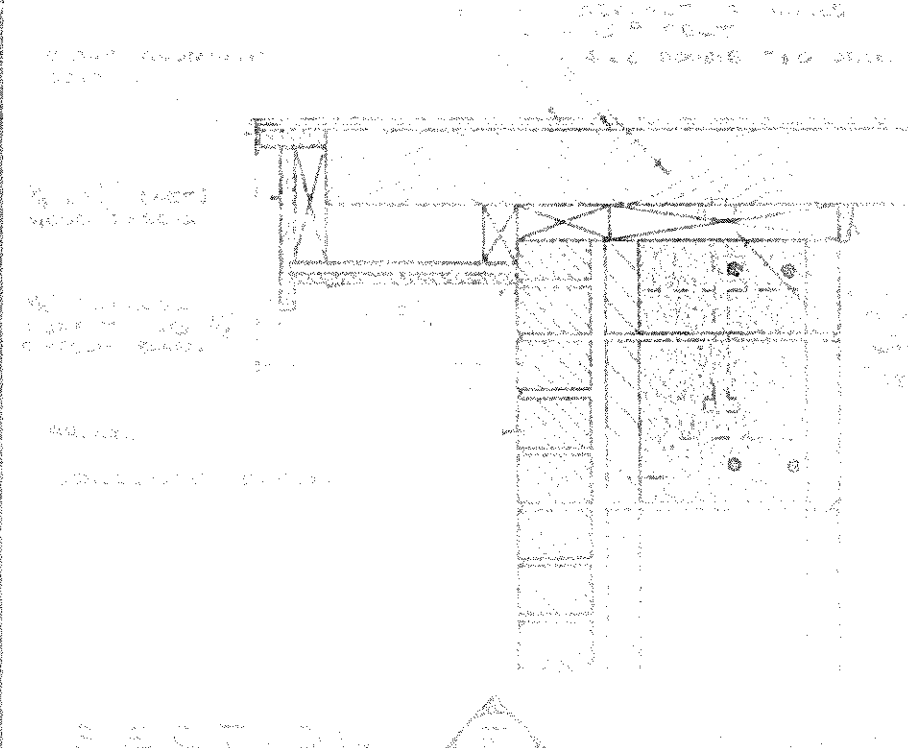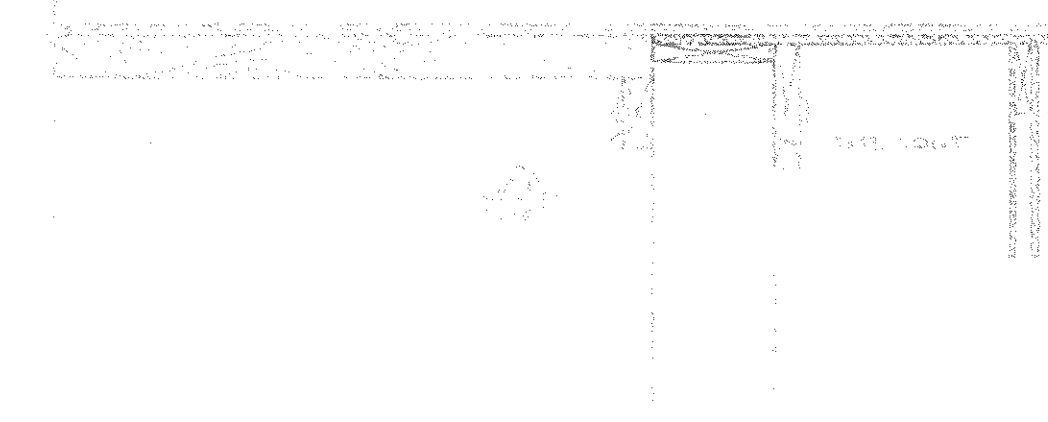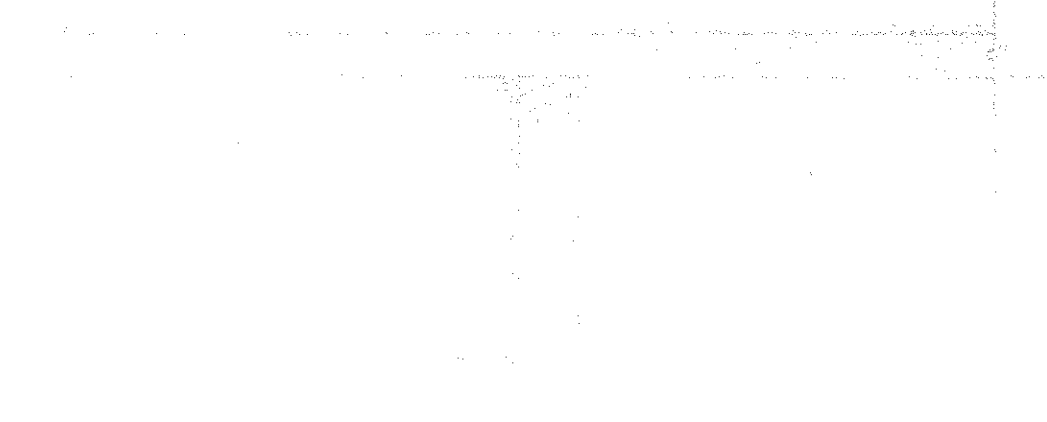

1. ALL WALLS TO BE CONCRETE  
 2. ALL FLOORS TO BE CONCRETE  
 3. ALL CEILING TO BE PLASTER  
 4. ALL ROOFING TO BE ASBESTOS  
 5. ALL DOORS TO BE SOLID WOOD  
 6. ALL WINDOWS TO BE DOUBLE HUNG  
 7. ALL LIGHT FIXTURES TO BE  
 8. ALL ELECTRICAL TO BE  
 9. ALL PIPING TO BE  
 10. ALL FINISHES TO BE

PLATFORM  
 126  
 1. ALL WALLS TO BE CONCRETE  
 2. ALL FLOORS TO BE CONCRETE  
 3. ALL CEILING TO BE PLASTER  
 4. ALL ROOFING TO BE ASBESTOS  
 5. ALL DOORS TO BE SOLID WOOD  
 6. ALL WINDOWS TO BE DOUBLE HUNG  
 7. ALL LIGHT FIXTURES TO BE  
 8. ALL ELECTRICAL TO BE  
 9. ALL PIPING TO BE  
 10. ALL FINISHES TO BE

BISHOP  
 127  
 1. ALL WALLS TO BE CONCRETE  
 2. ALL FLOORS TO BE CONCRETE  
 3. ALL CEILING TO BE PLASTER  
 4. ALL ROOFING TO BE ASBESTOS  
 5. ALL DOORS TO BE SOLID WOOD  
 6. ALL WINDOWS TO BE DOUBLE HUNG  
 7. ALL LIGHT FIXTURES TO BE  
 8. ALL ELECTRICAL TO BE  
 9. ALL PIPING TO BE  
 10. ALL FINISHES TO BE

SOILER  
 ROOM  
 10  
 1. ALL WALLS TO BE CONCRETE  
 2. ALL FLOORS TO BE CONCRETE  
 3. ALL CEILING TO BE PLASTER  
 4. ALL ROOFING TO BE ASBESTOS  
 5. ALL DOORS TO BE SOLID WOOD  
 6. ALL WINDOWS TO BE DOUBLE HUNG  
 7. ALL LIGHT FIXTURES TO BE  
 8. ALL ELECTRICAL TO BE  
 9. ALL PIPING TO BE  
 10. ALL FINISHES TO BE


SECTION C SCALE 1/2" = 1'-0"














HAROLD E. COLLARD  
 ARCHITECT  
 A. I. A.  
 IDAHO FALLS, IDAHO

SHEET NUMBER  
 A 10 OF 20

PROJECT  
 NUMBER

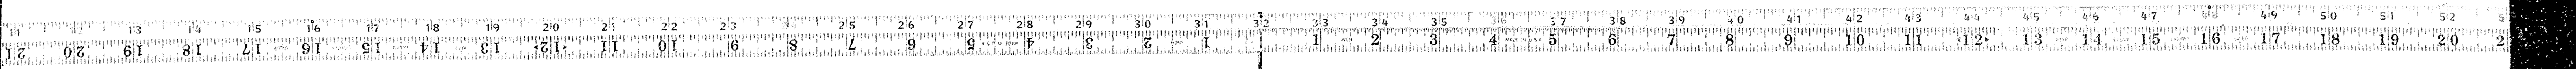






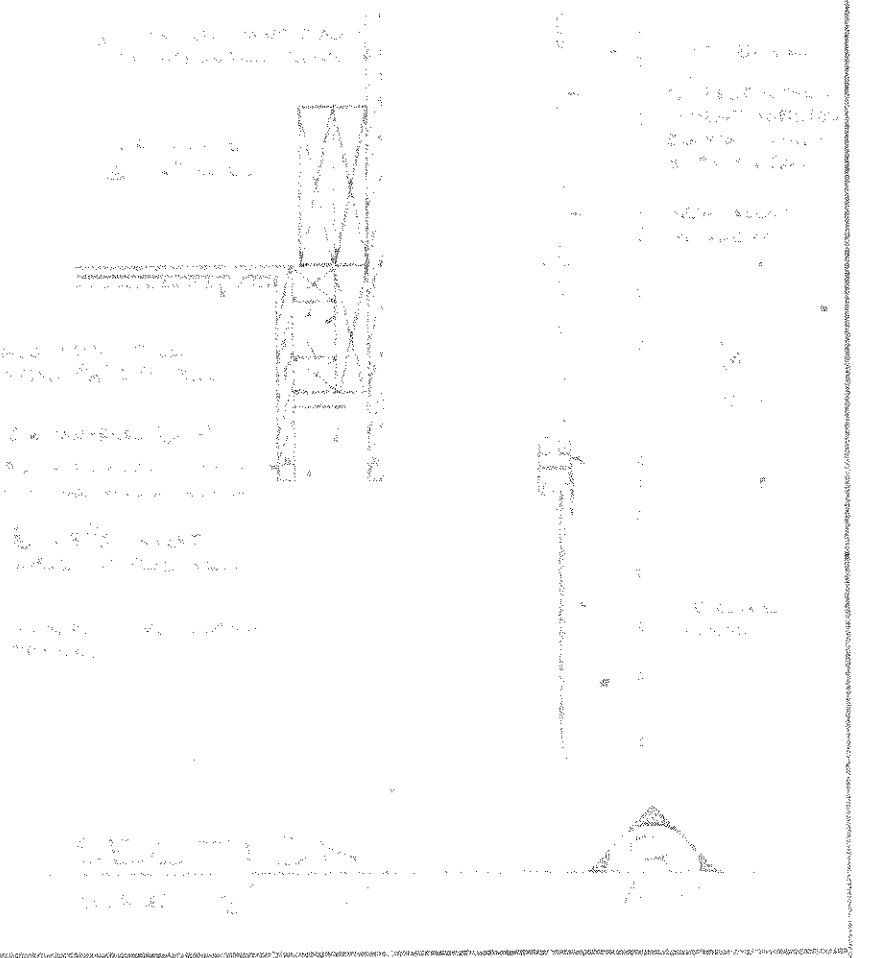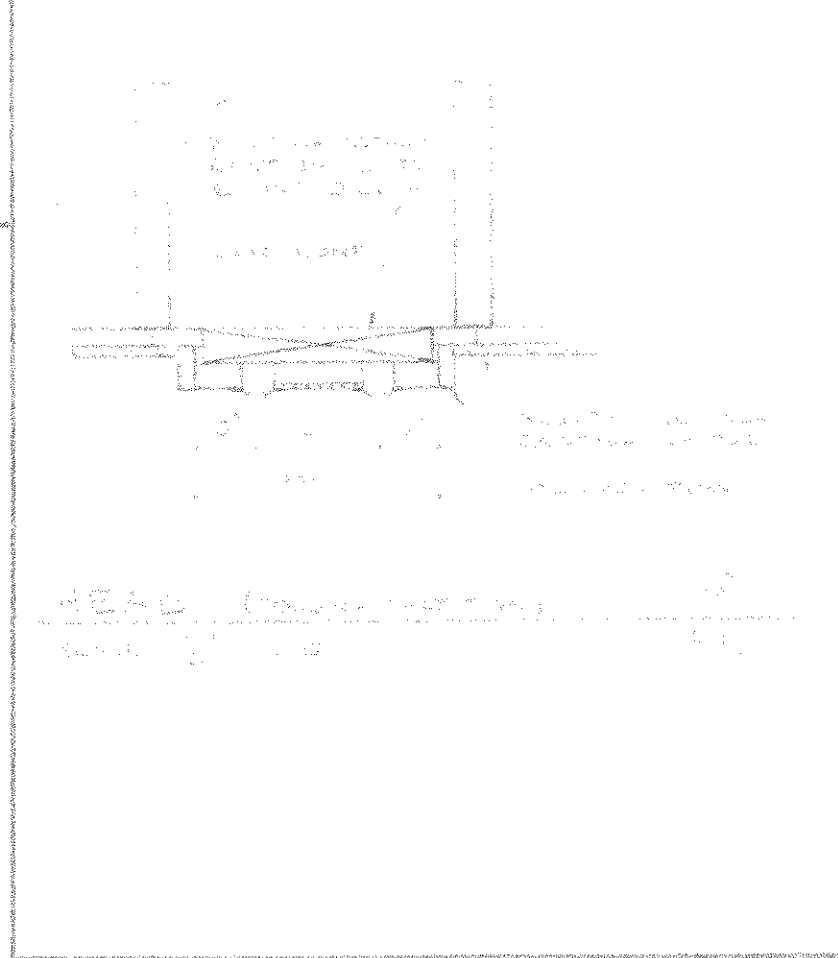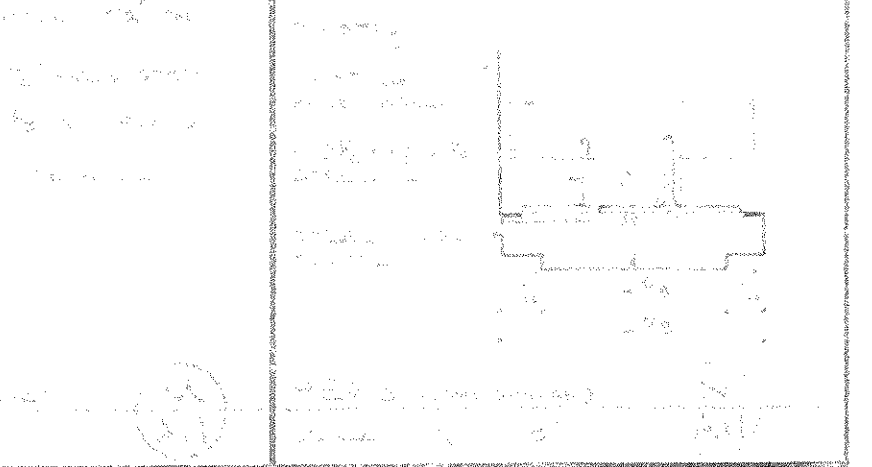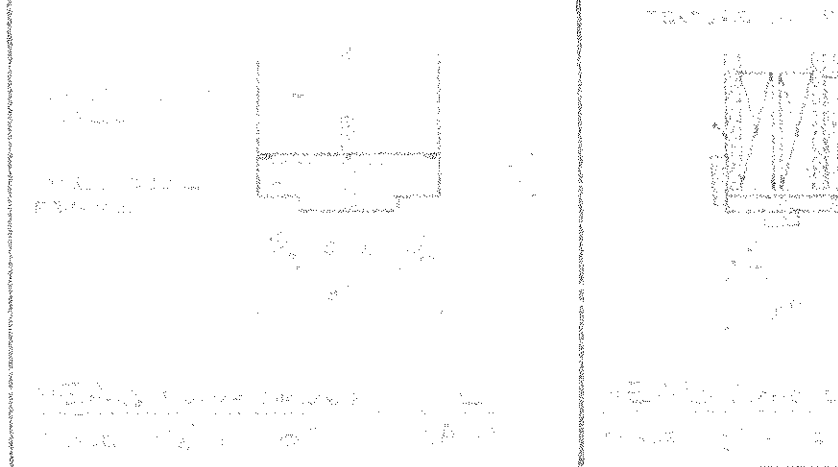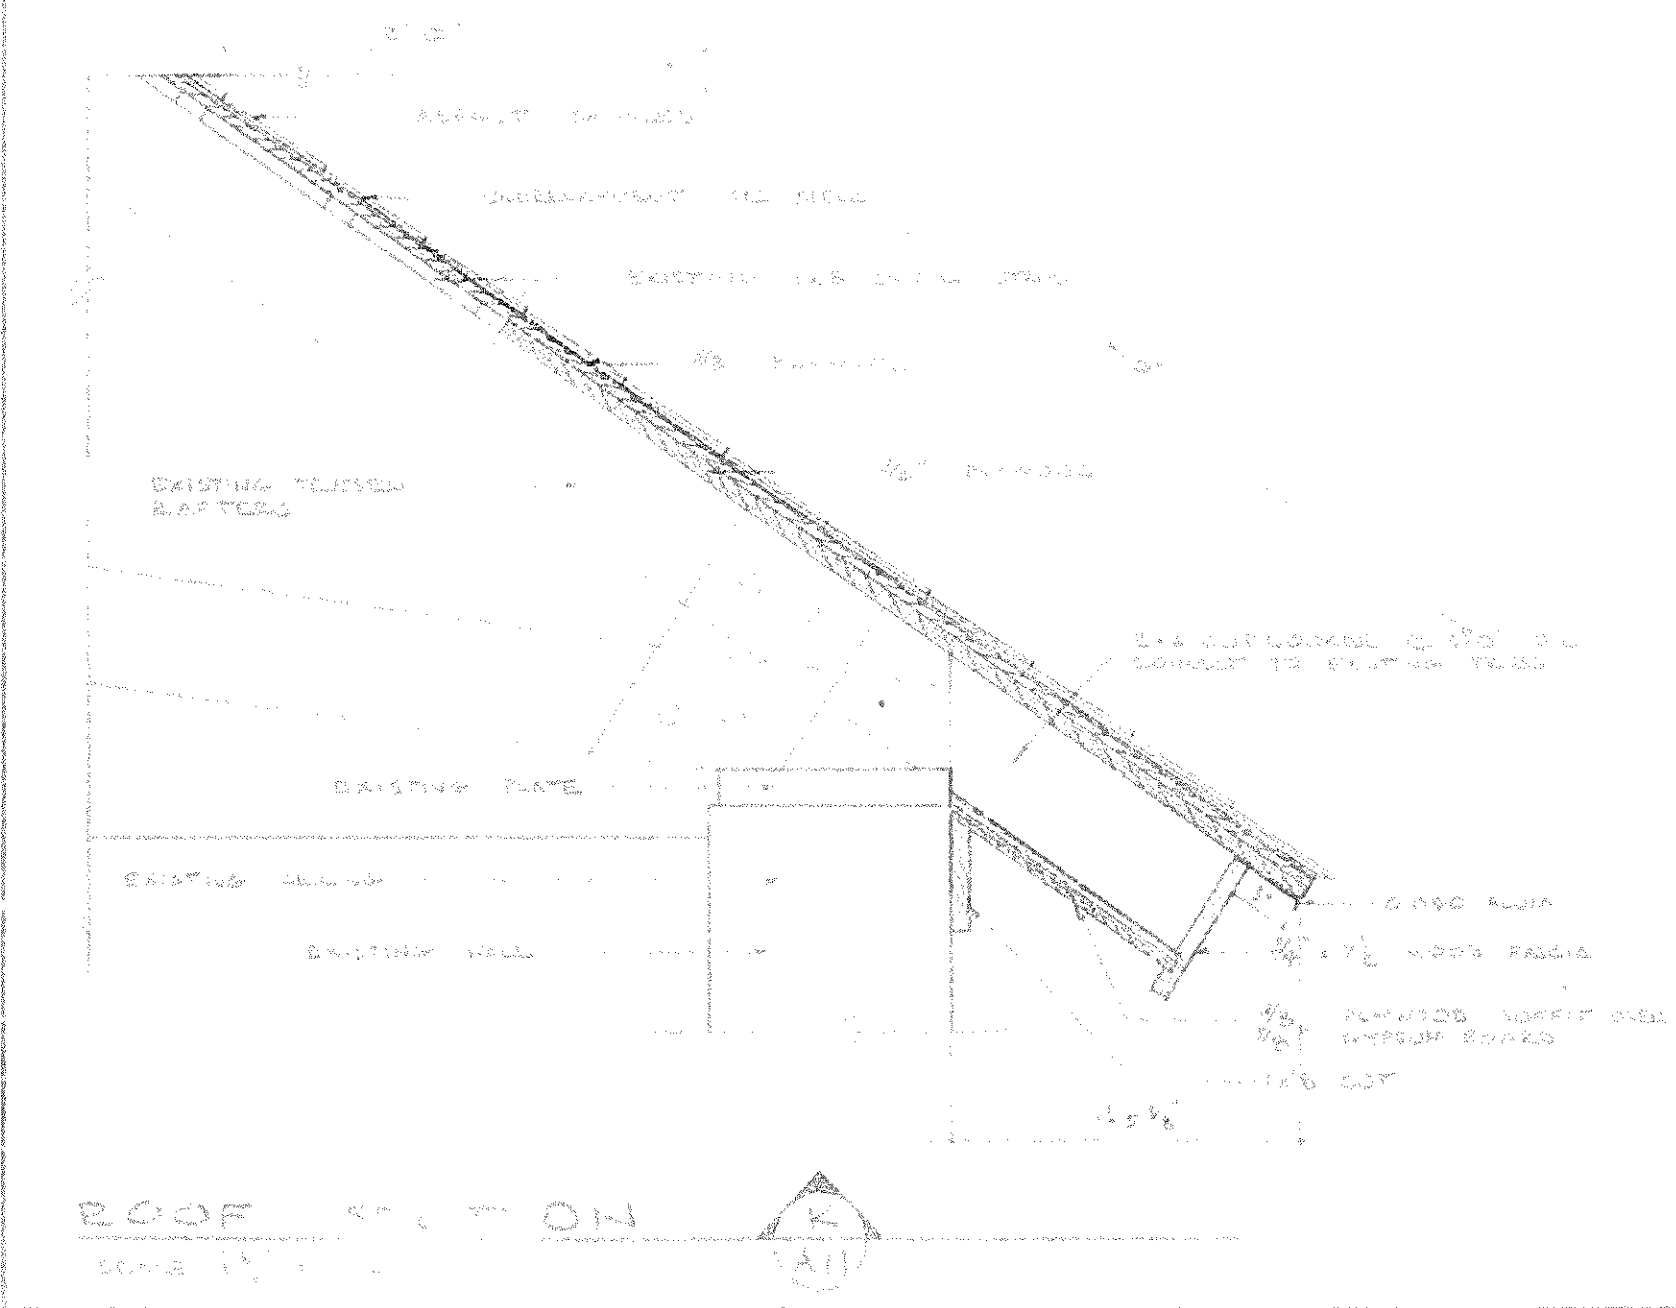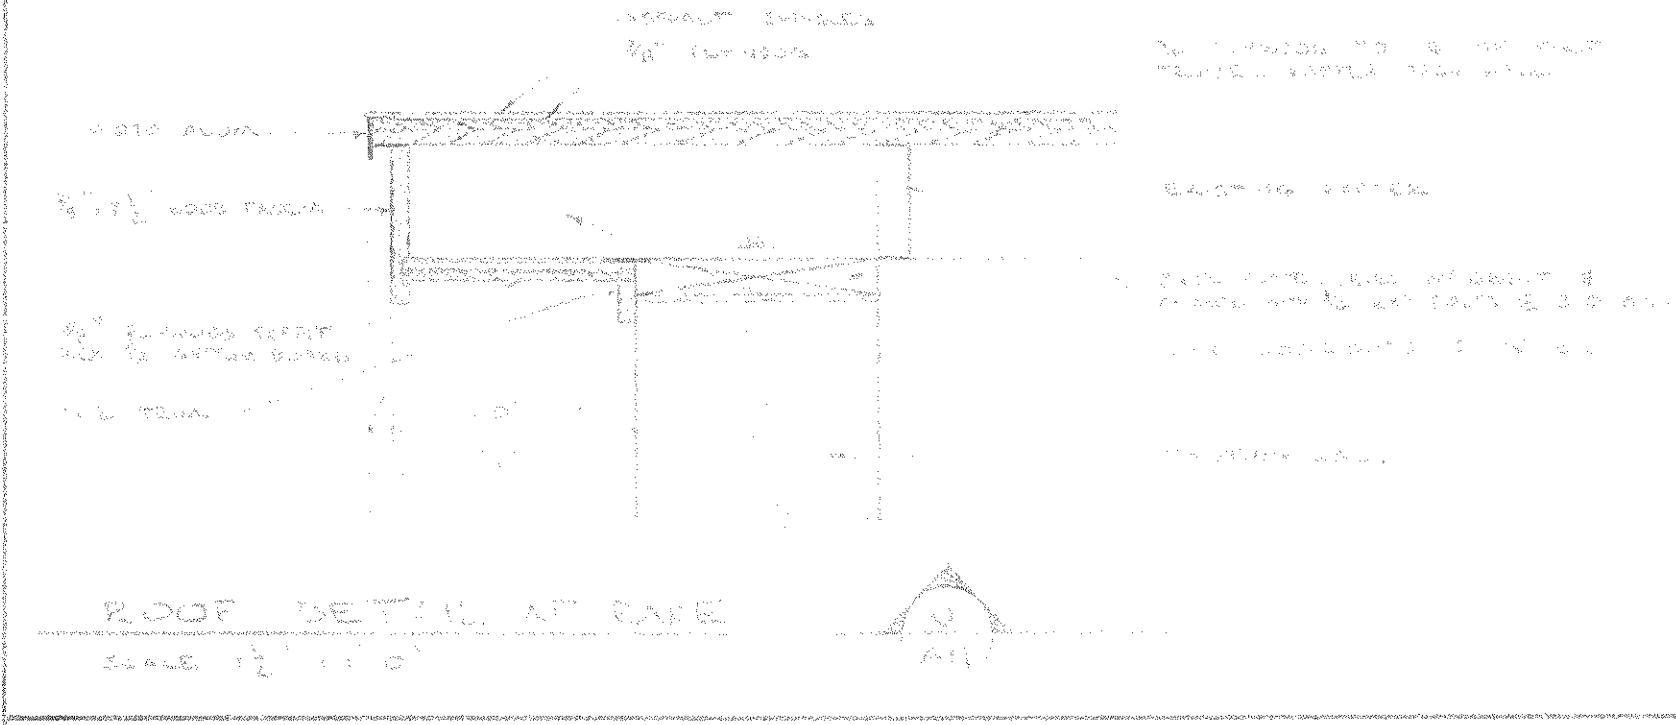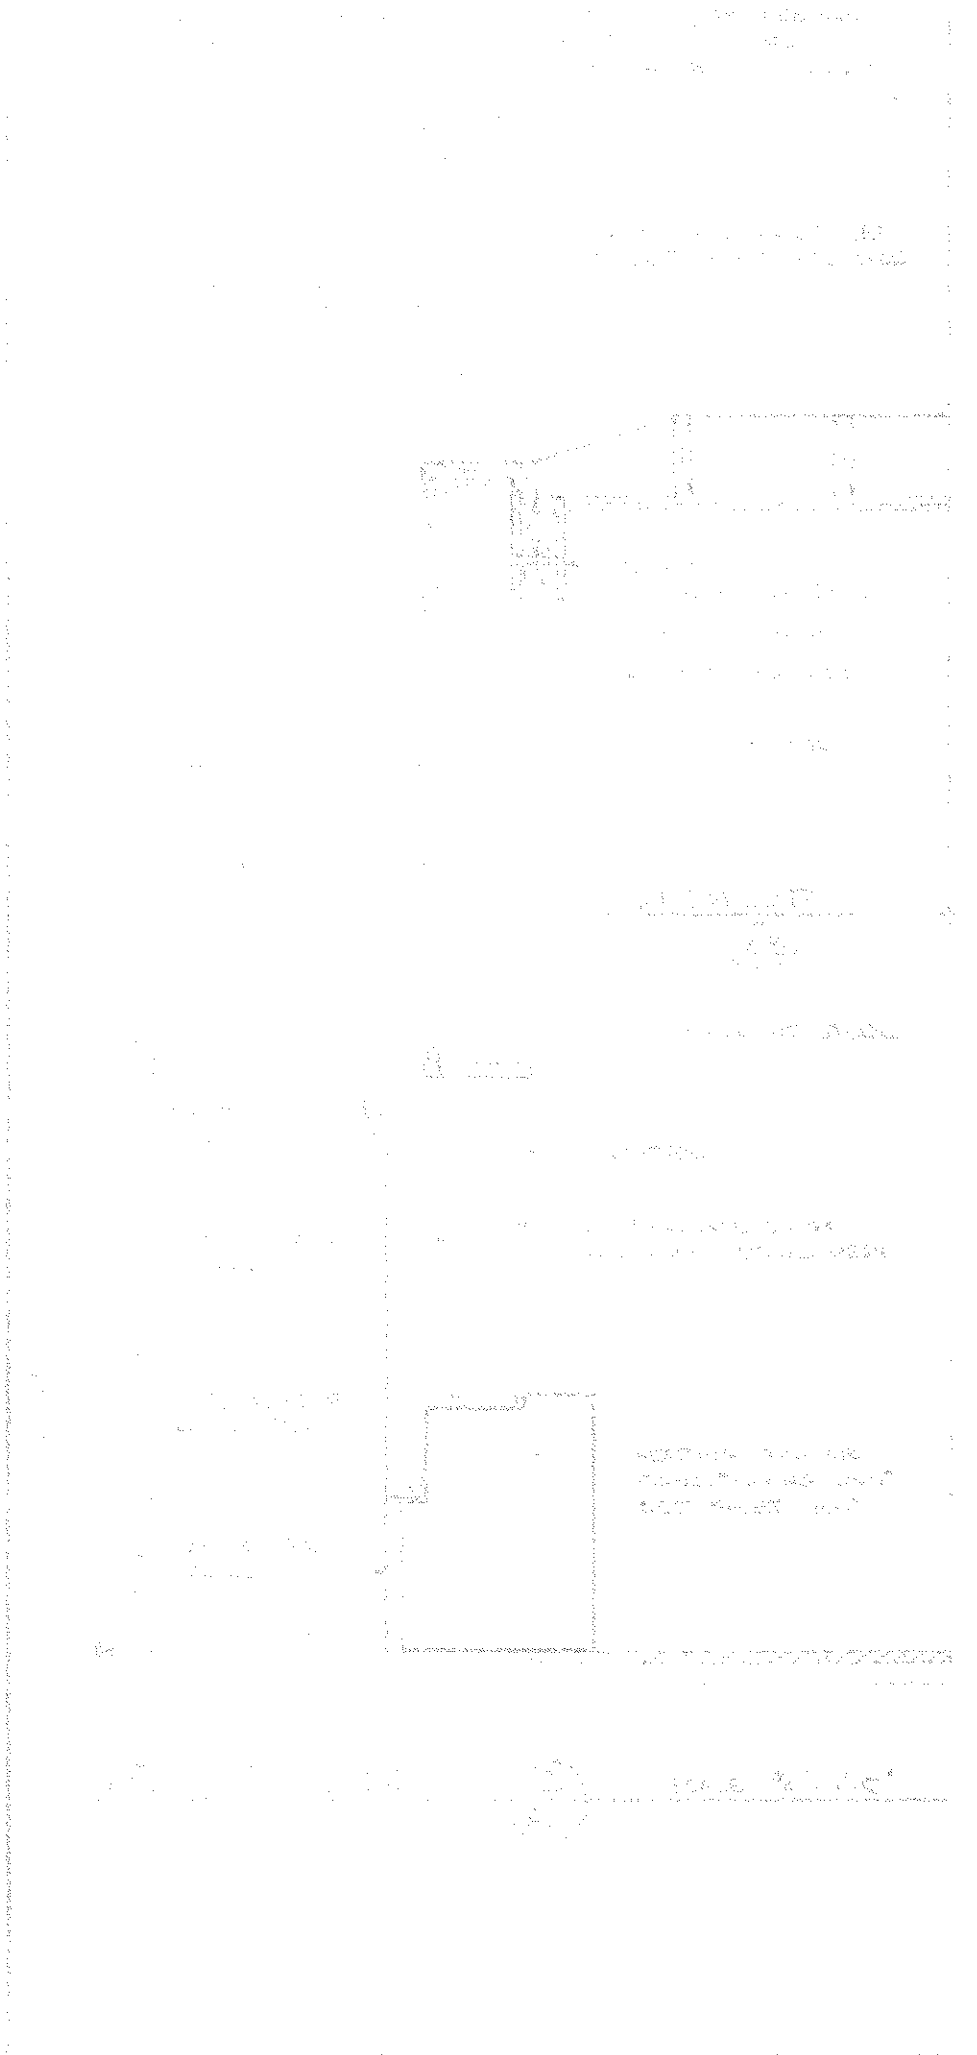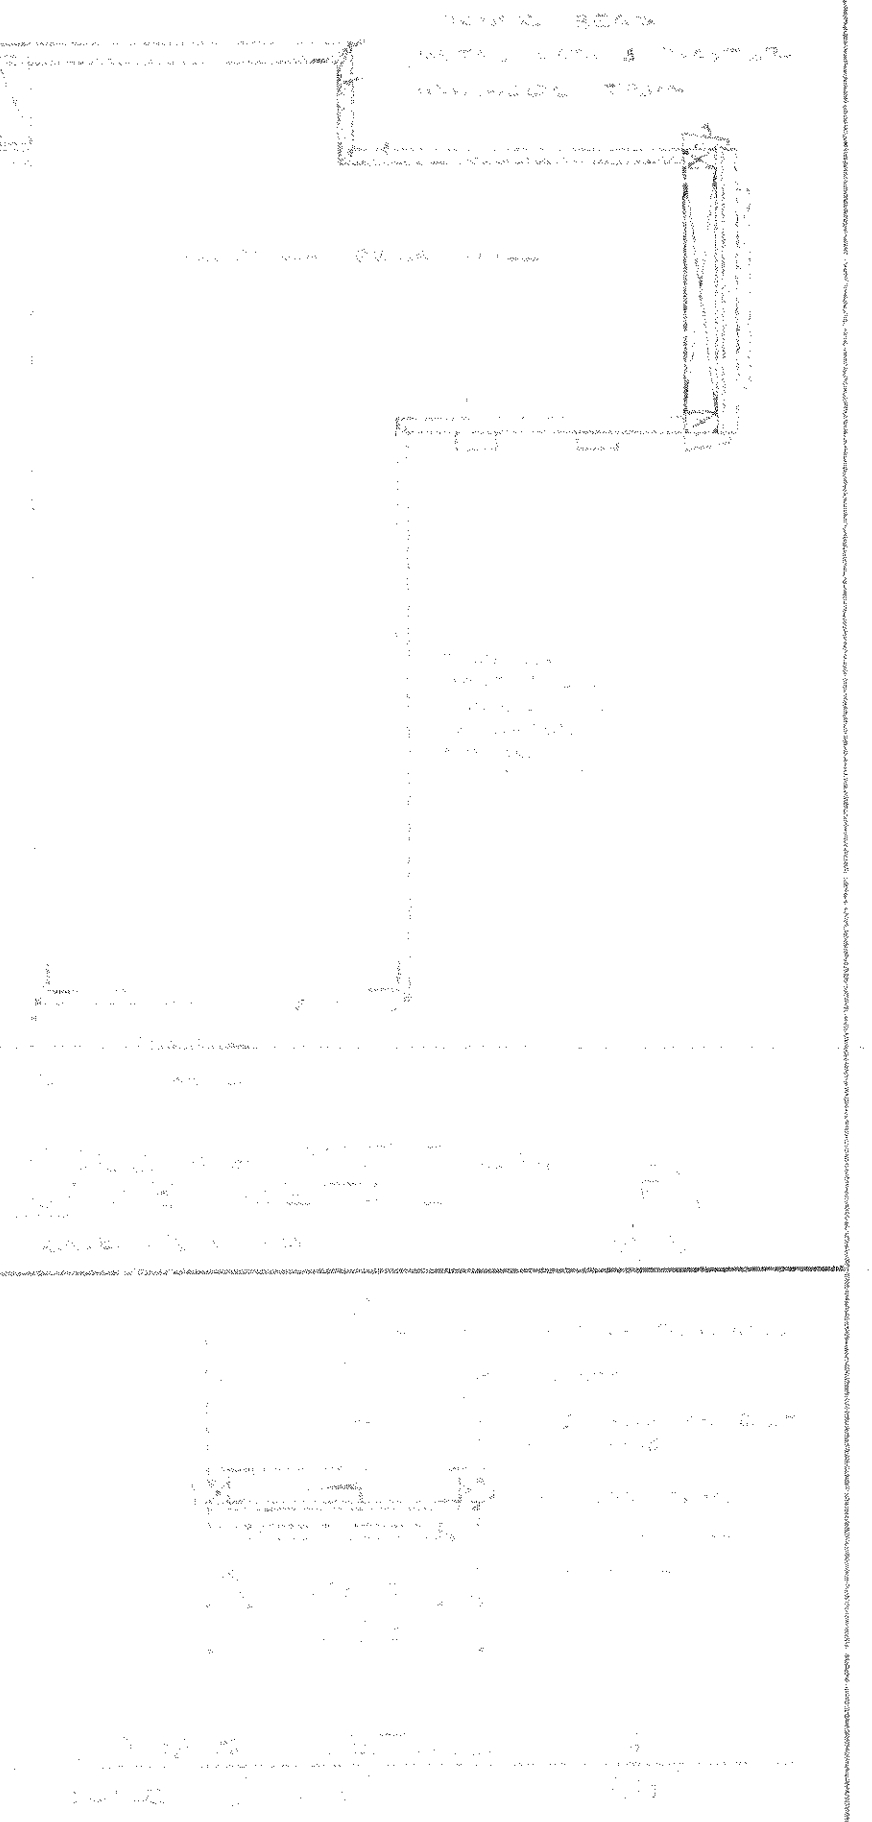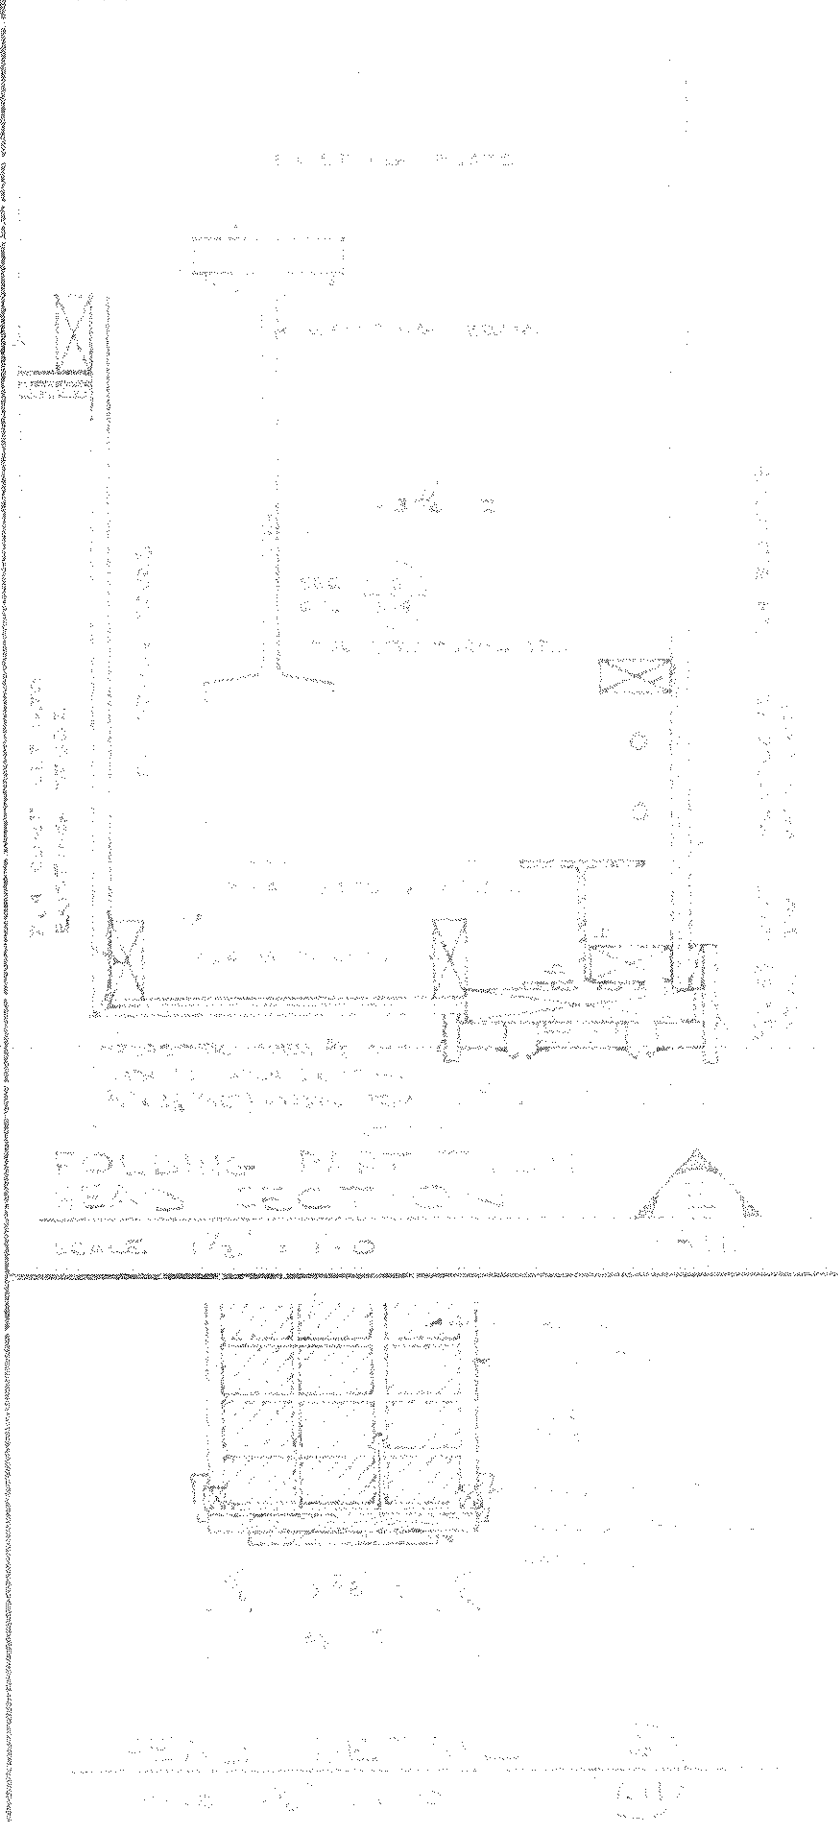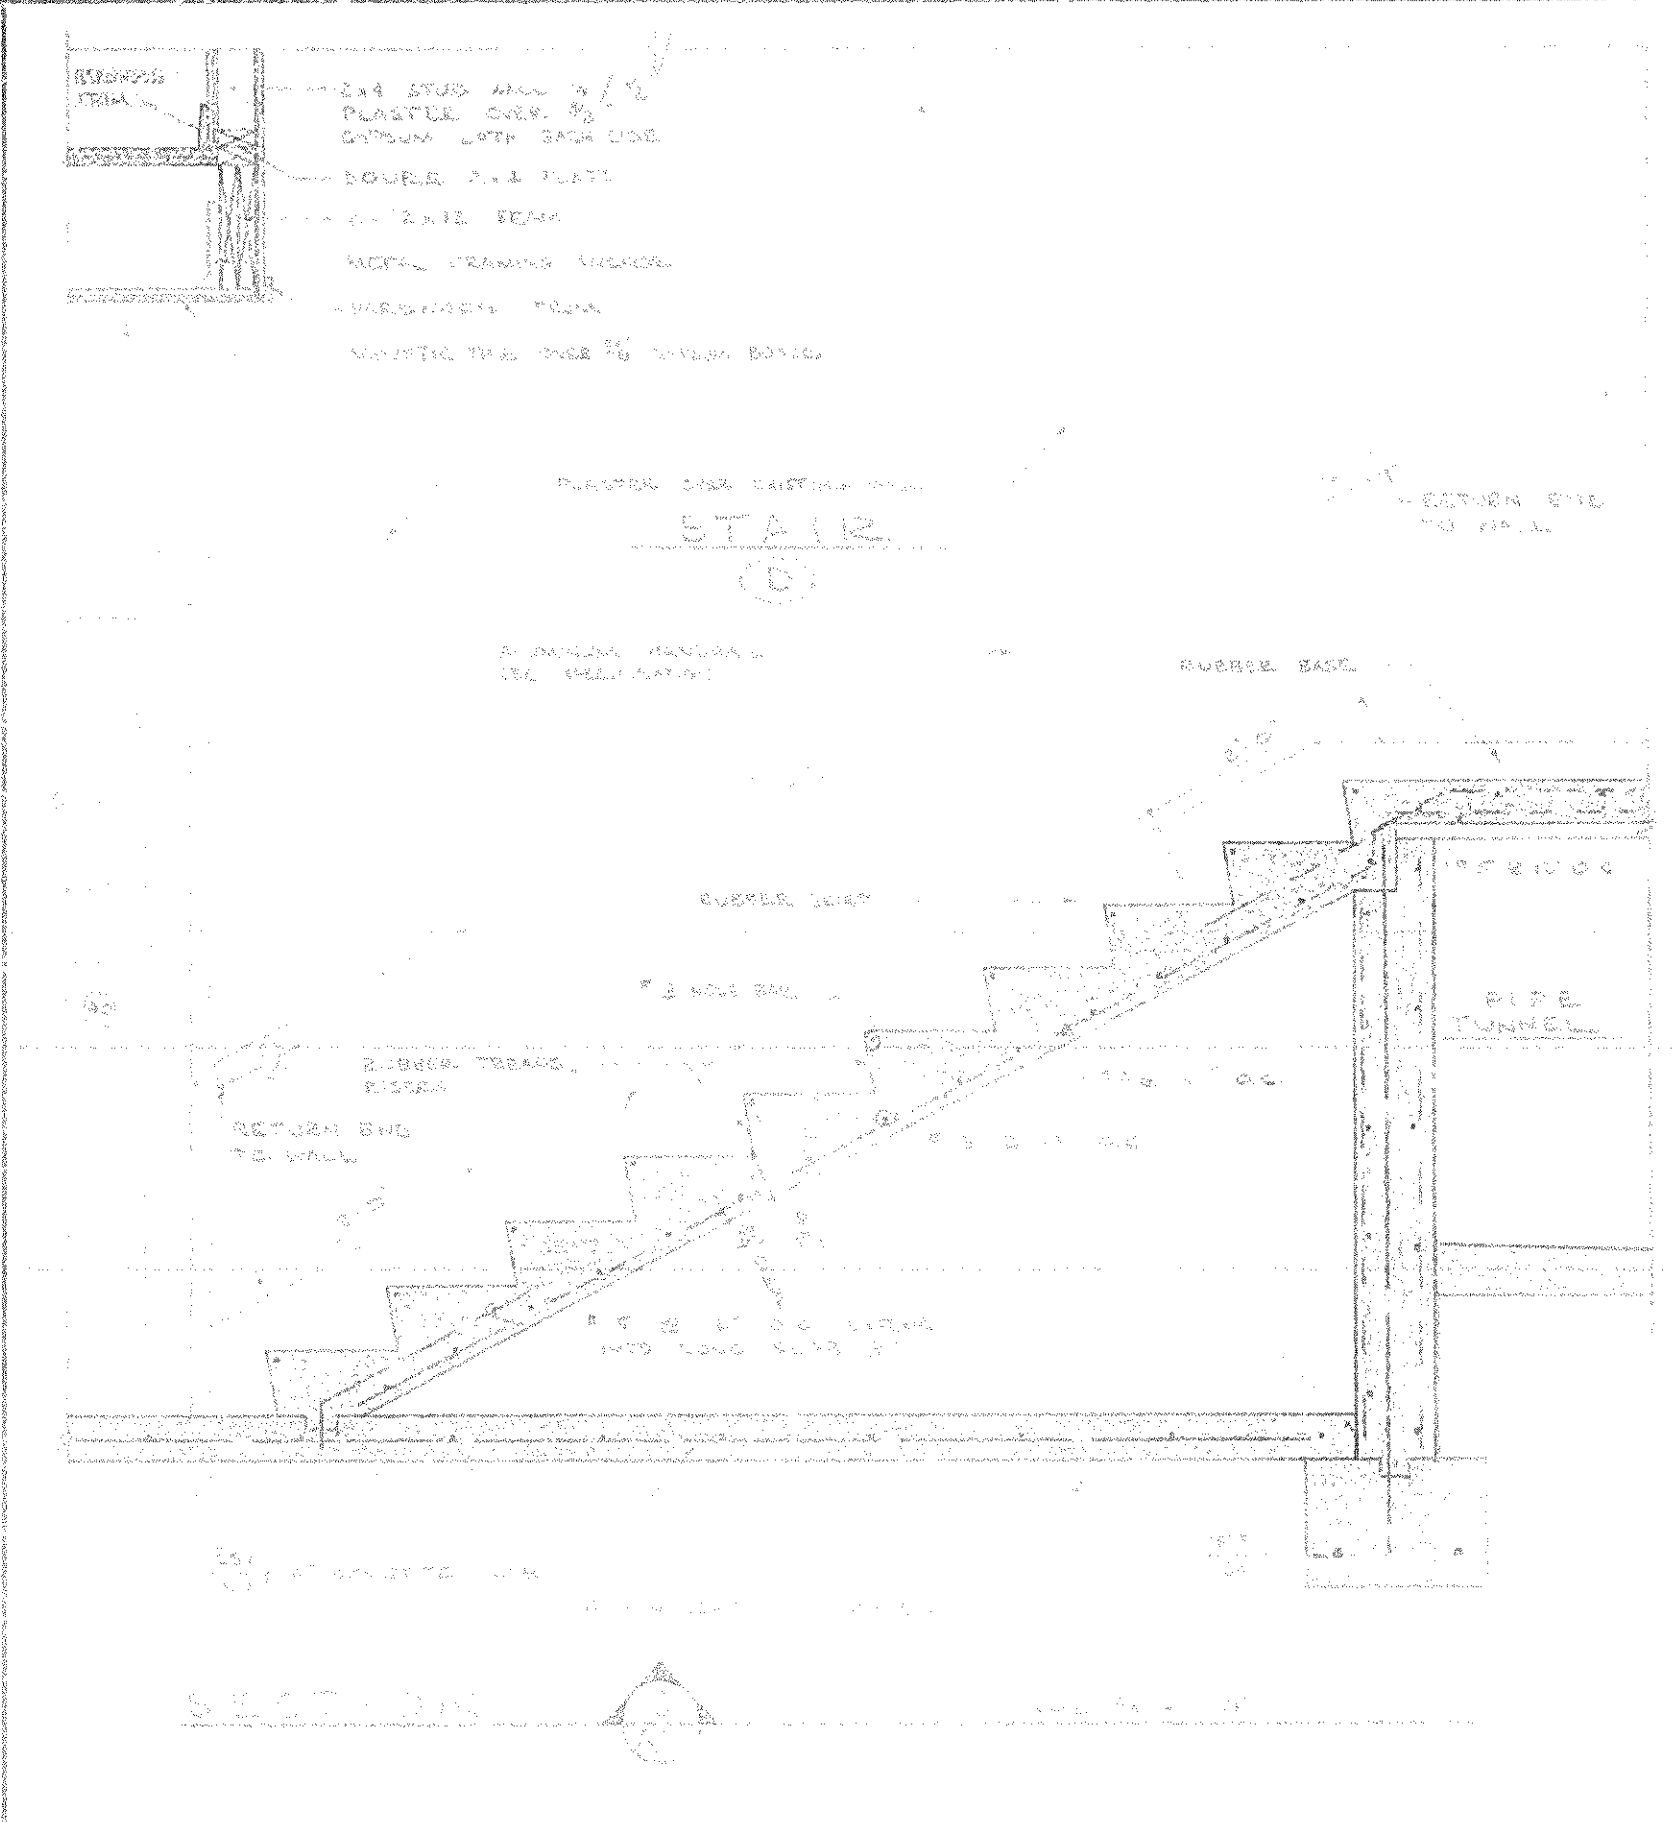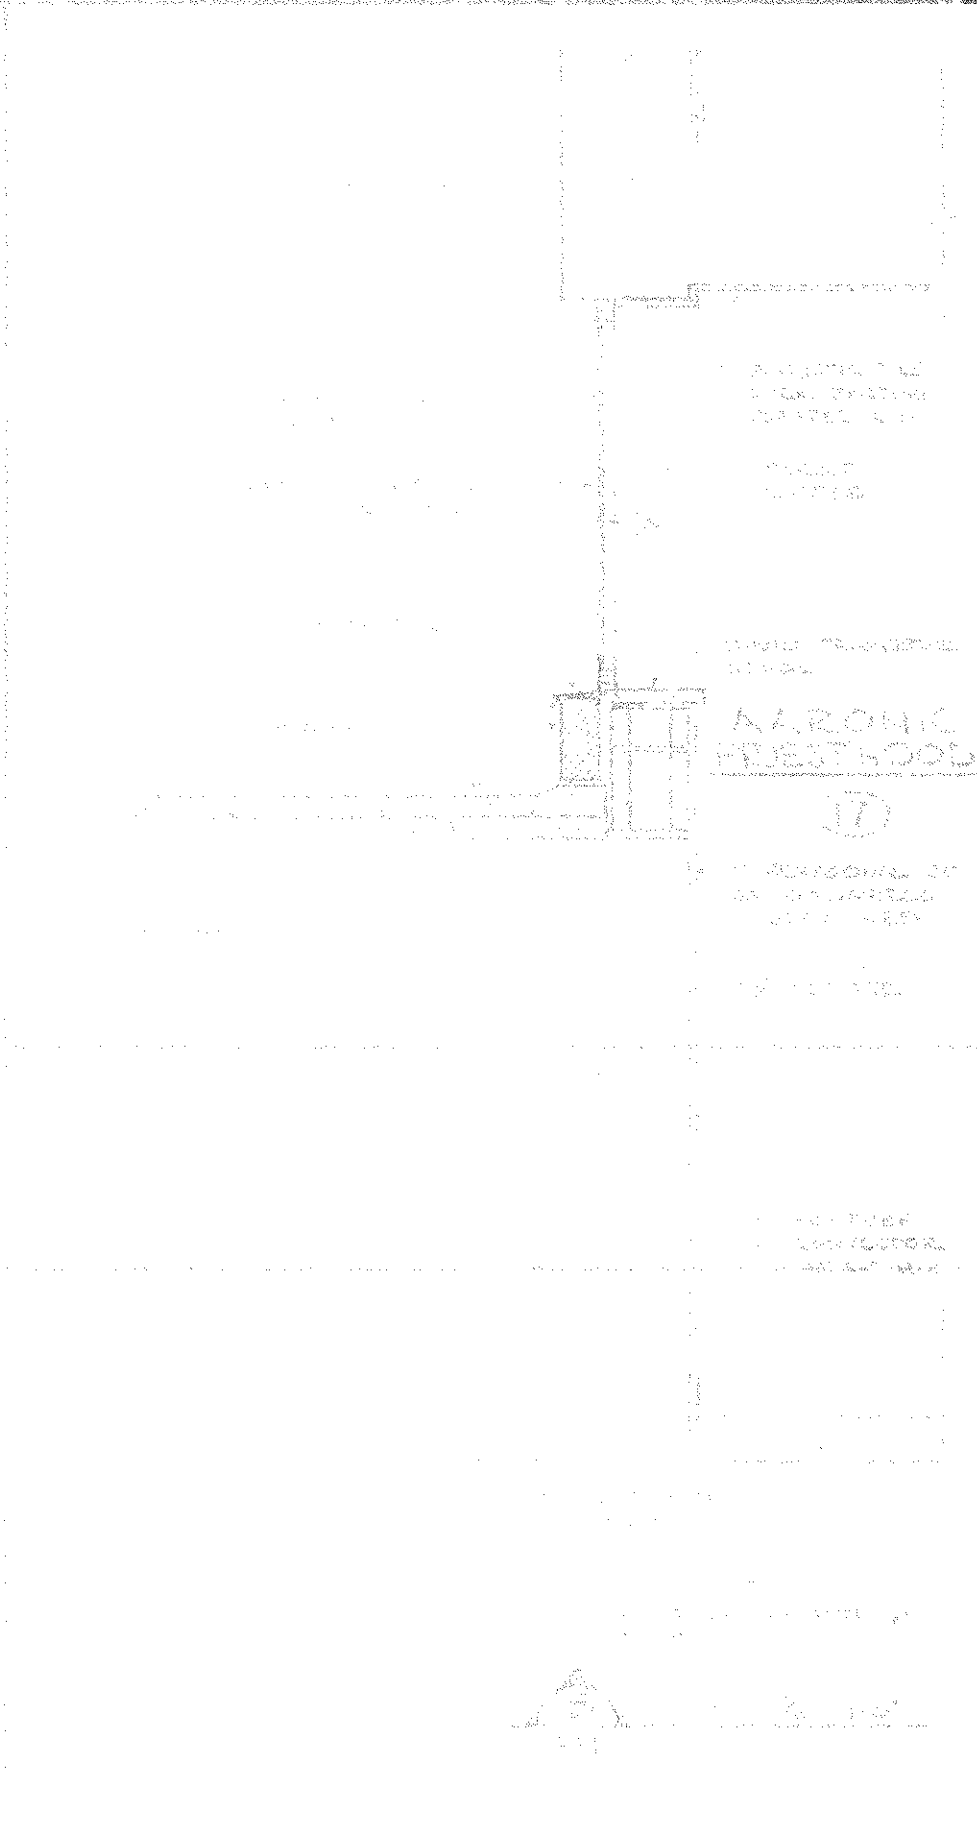

136077  
 SHEET NUMBER  
**A11 20**  
 OF 20  
 HAROLD E. COLLARD  
 ARCHITECT  
 A. I. A.  
 IDAHO FALLS, IDAHO


PROJECT NUMBER

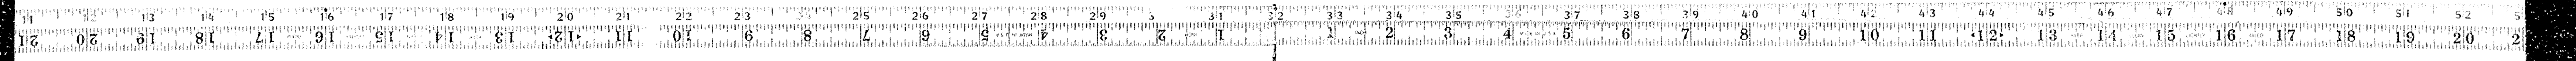


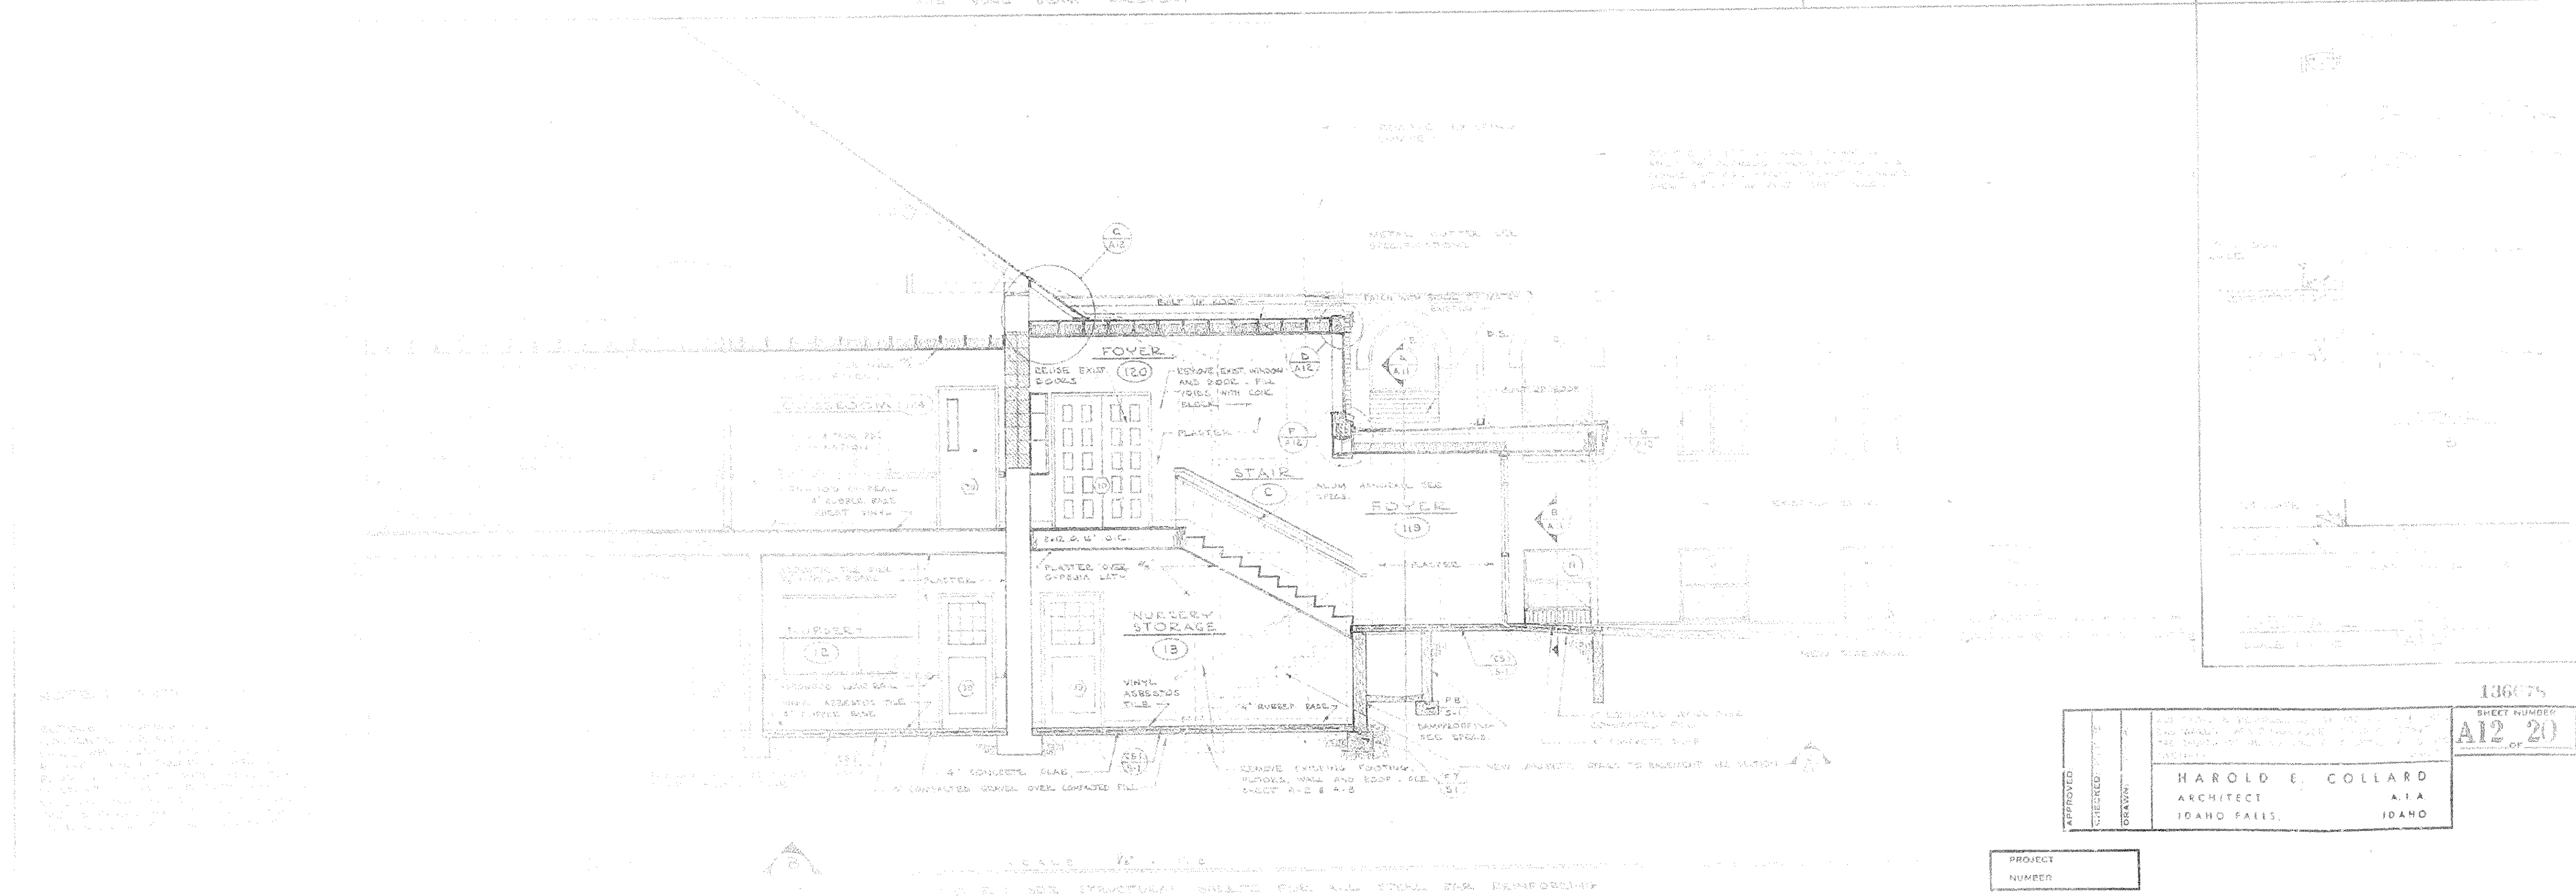
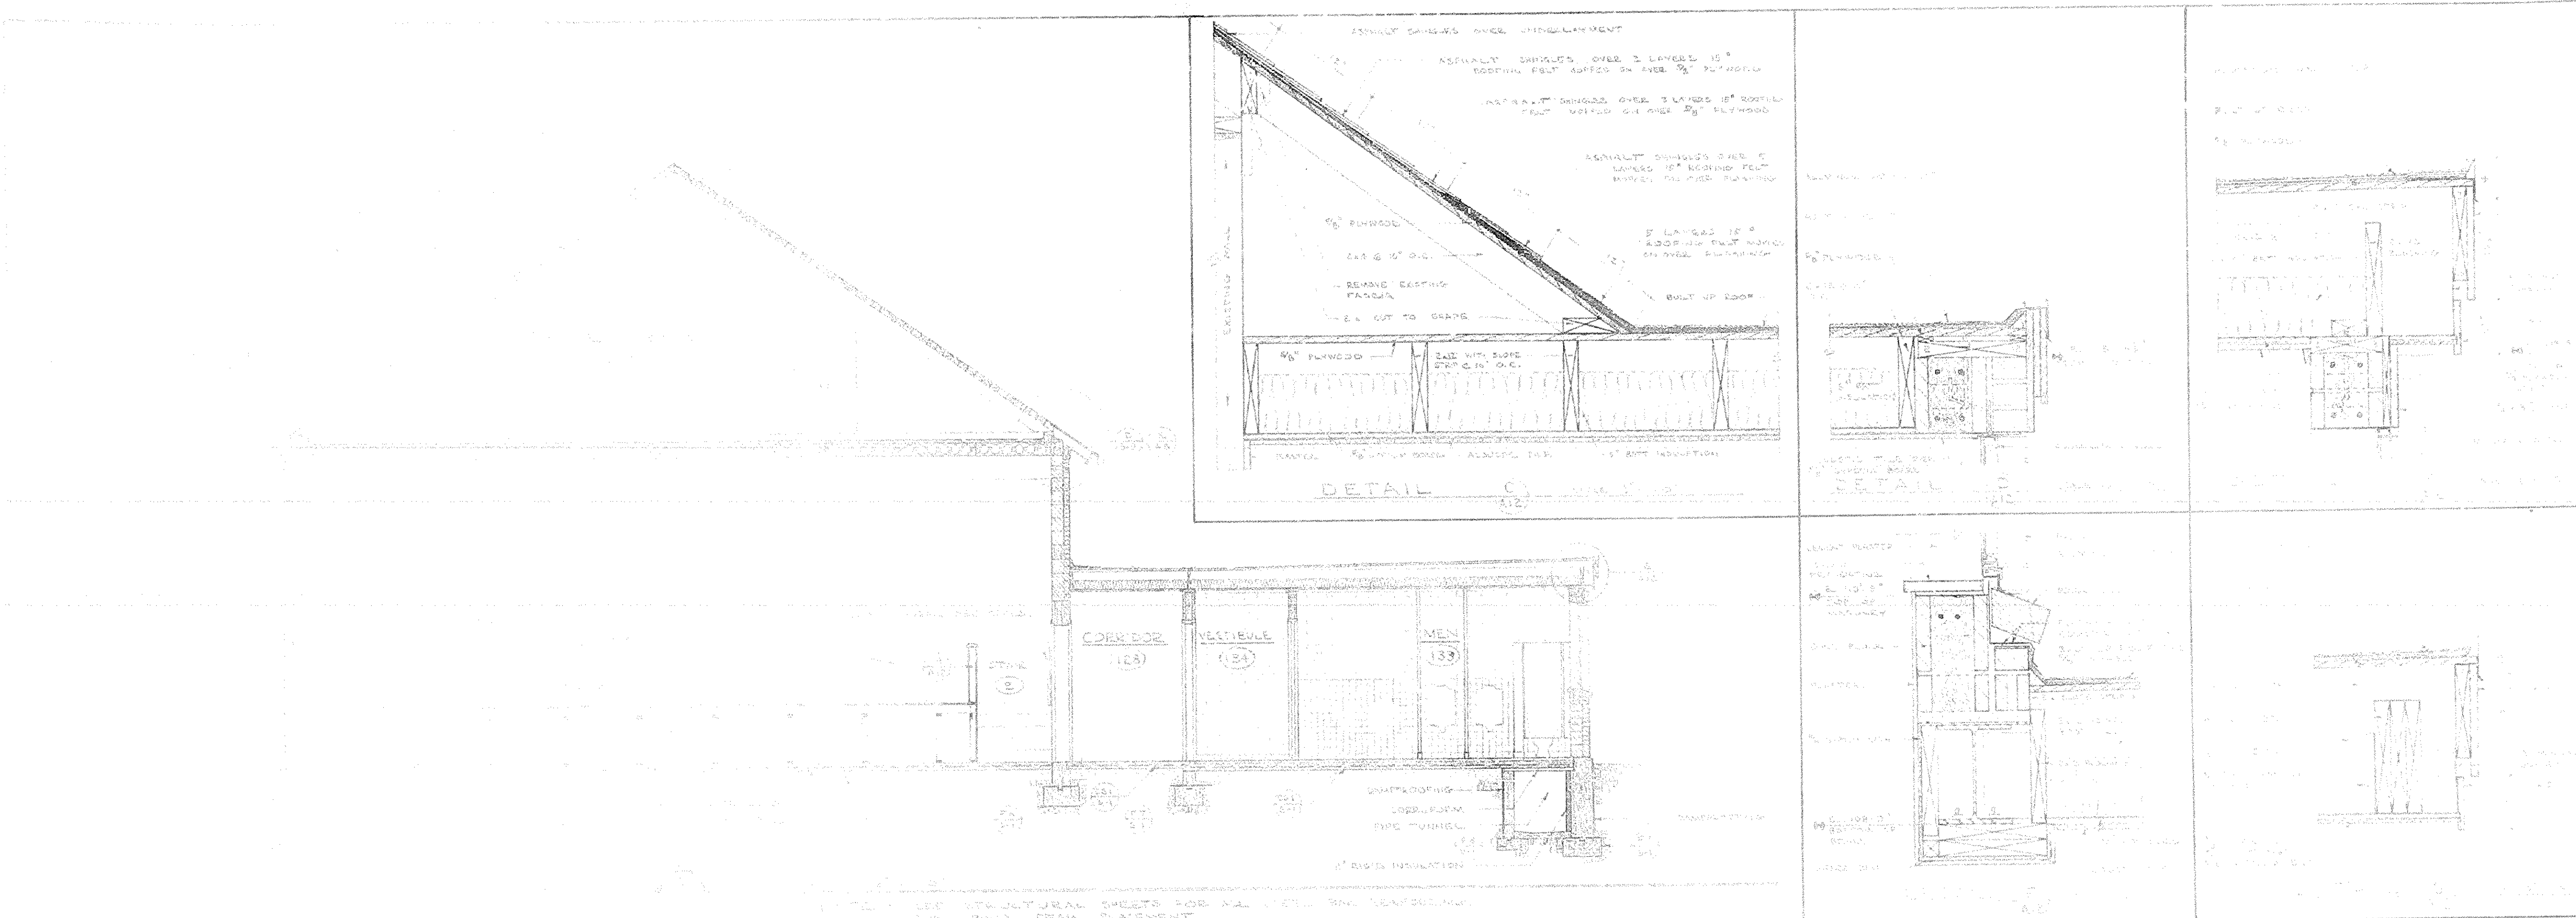


136675  
 SHEET NUMBER  
**A12 OF 20**  
 HAROLD E. COLLARD  
 ARCHITECT  
 A.I.A.  
 IDAHO FALLS,  
 IDAHO

PROJECT  
 NUMBER

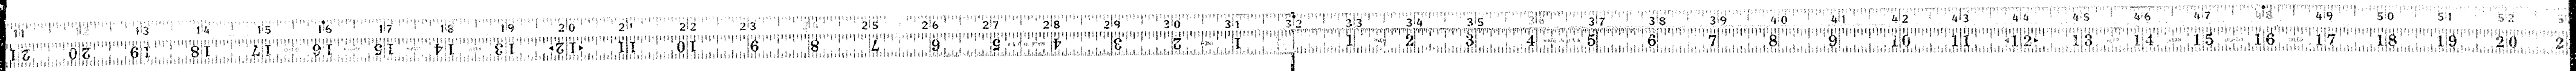



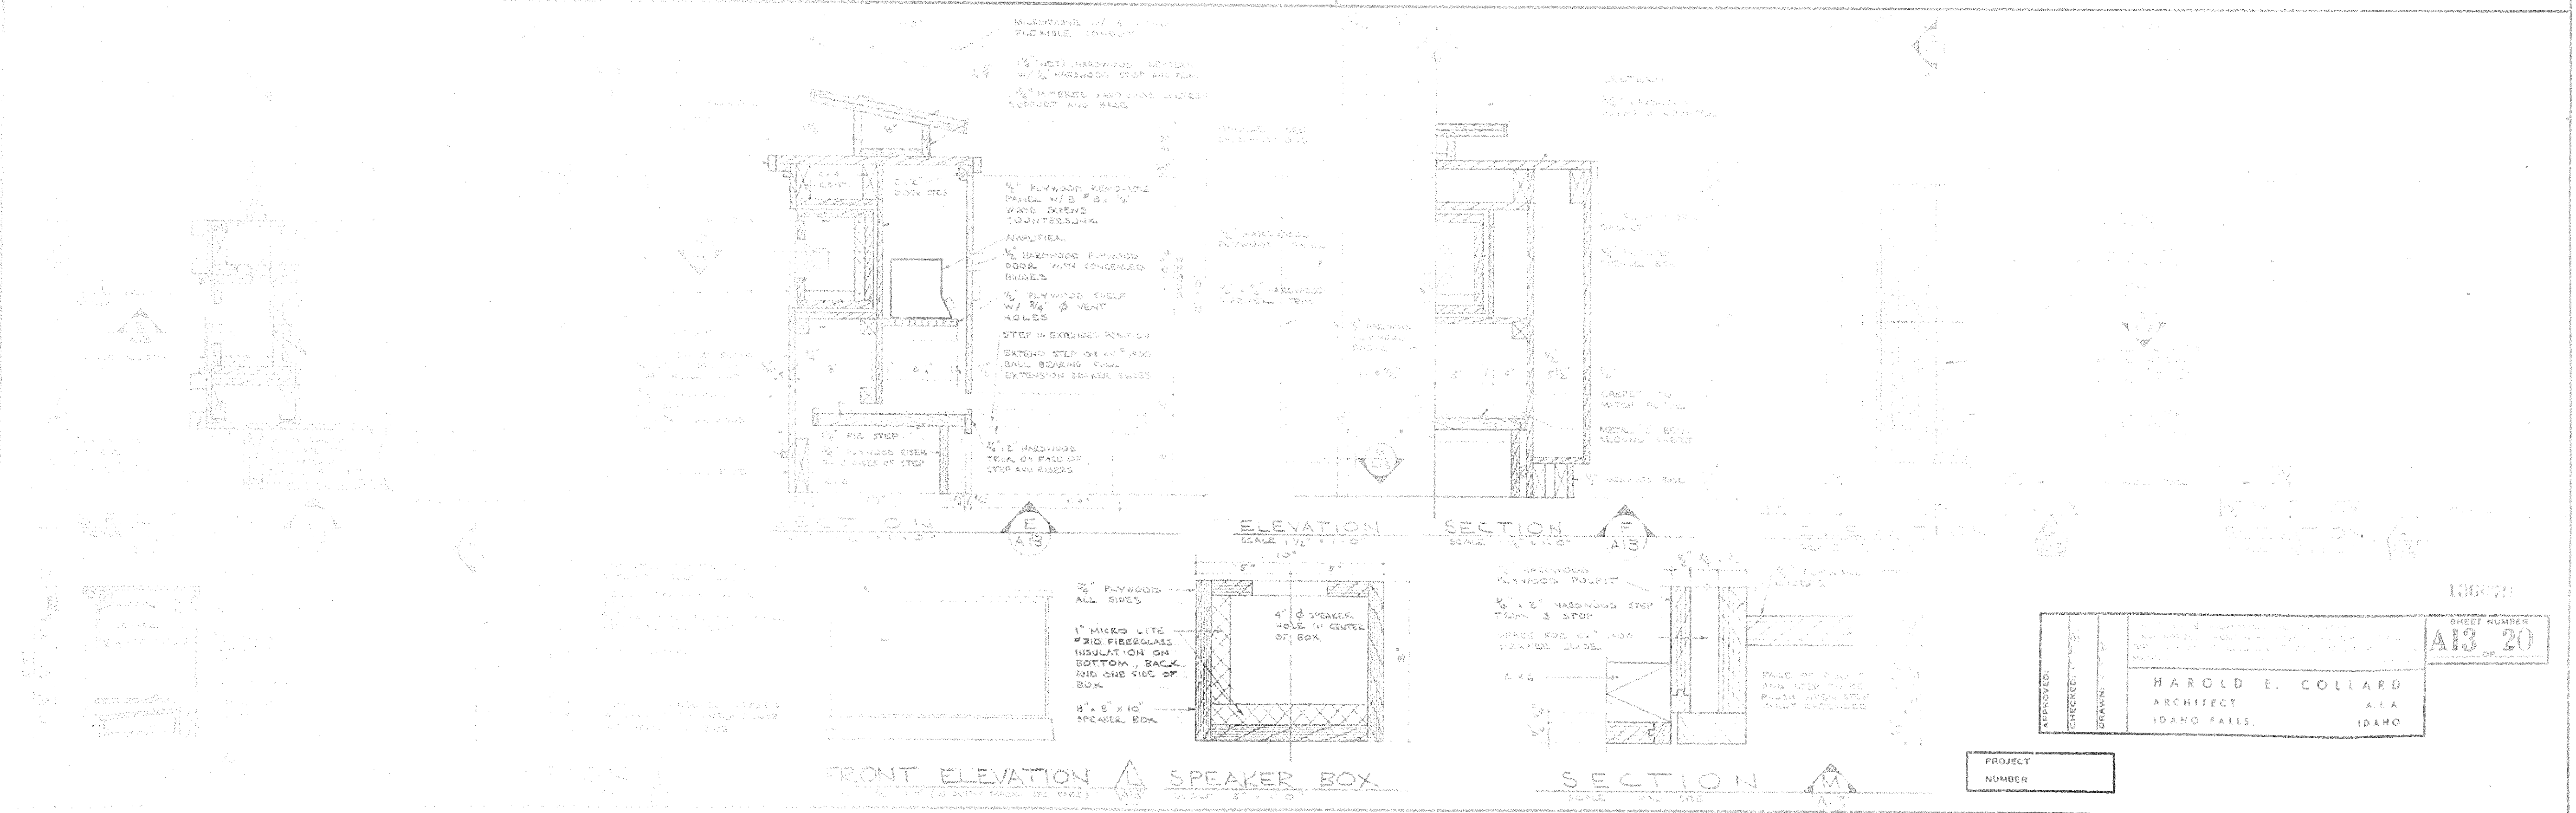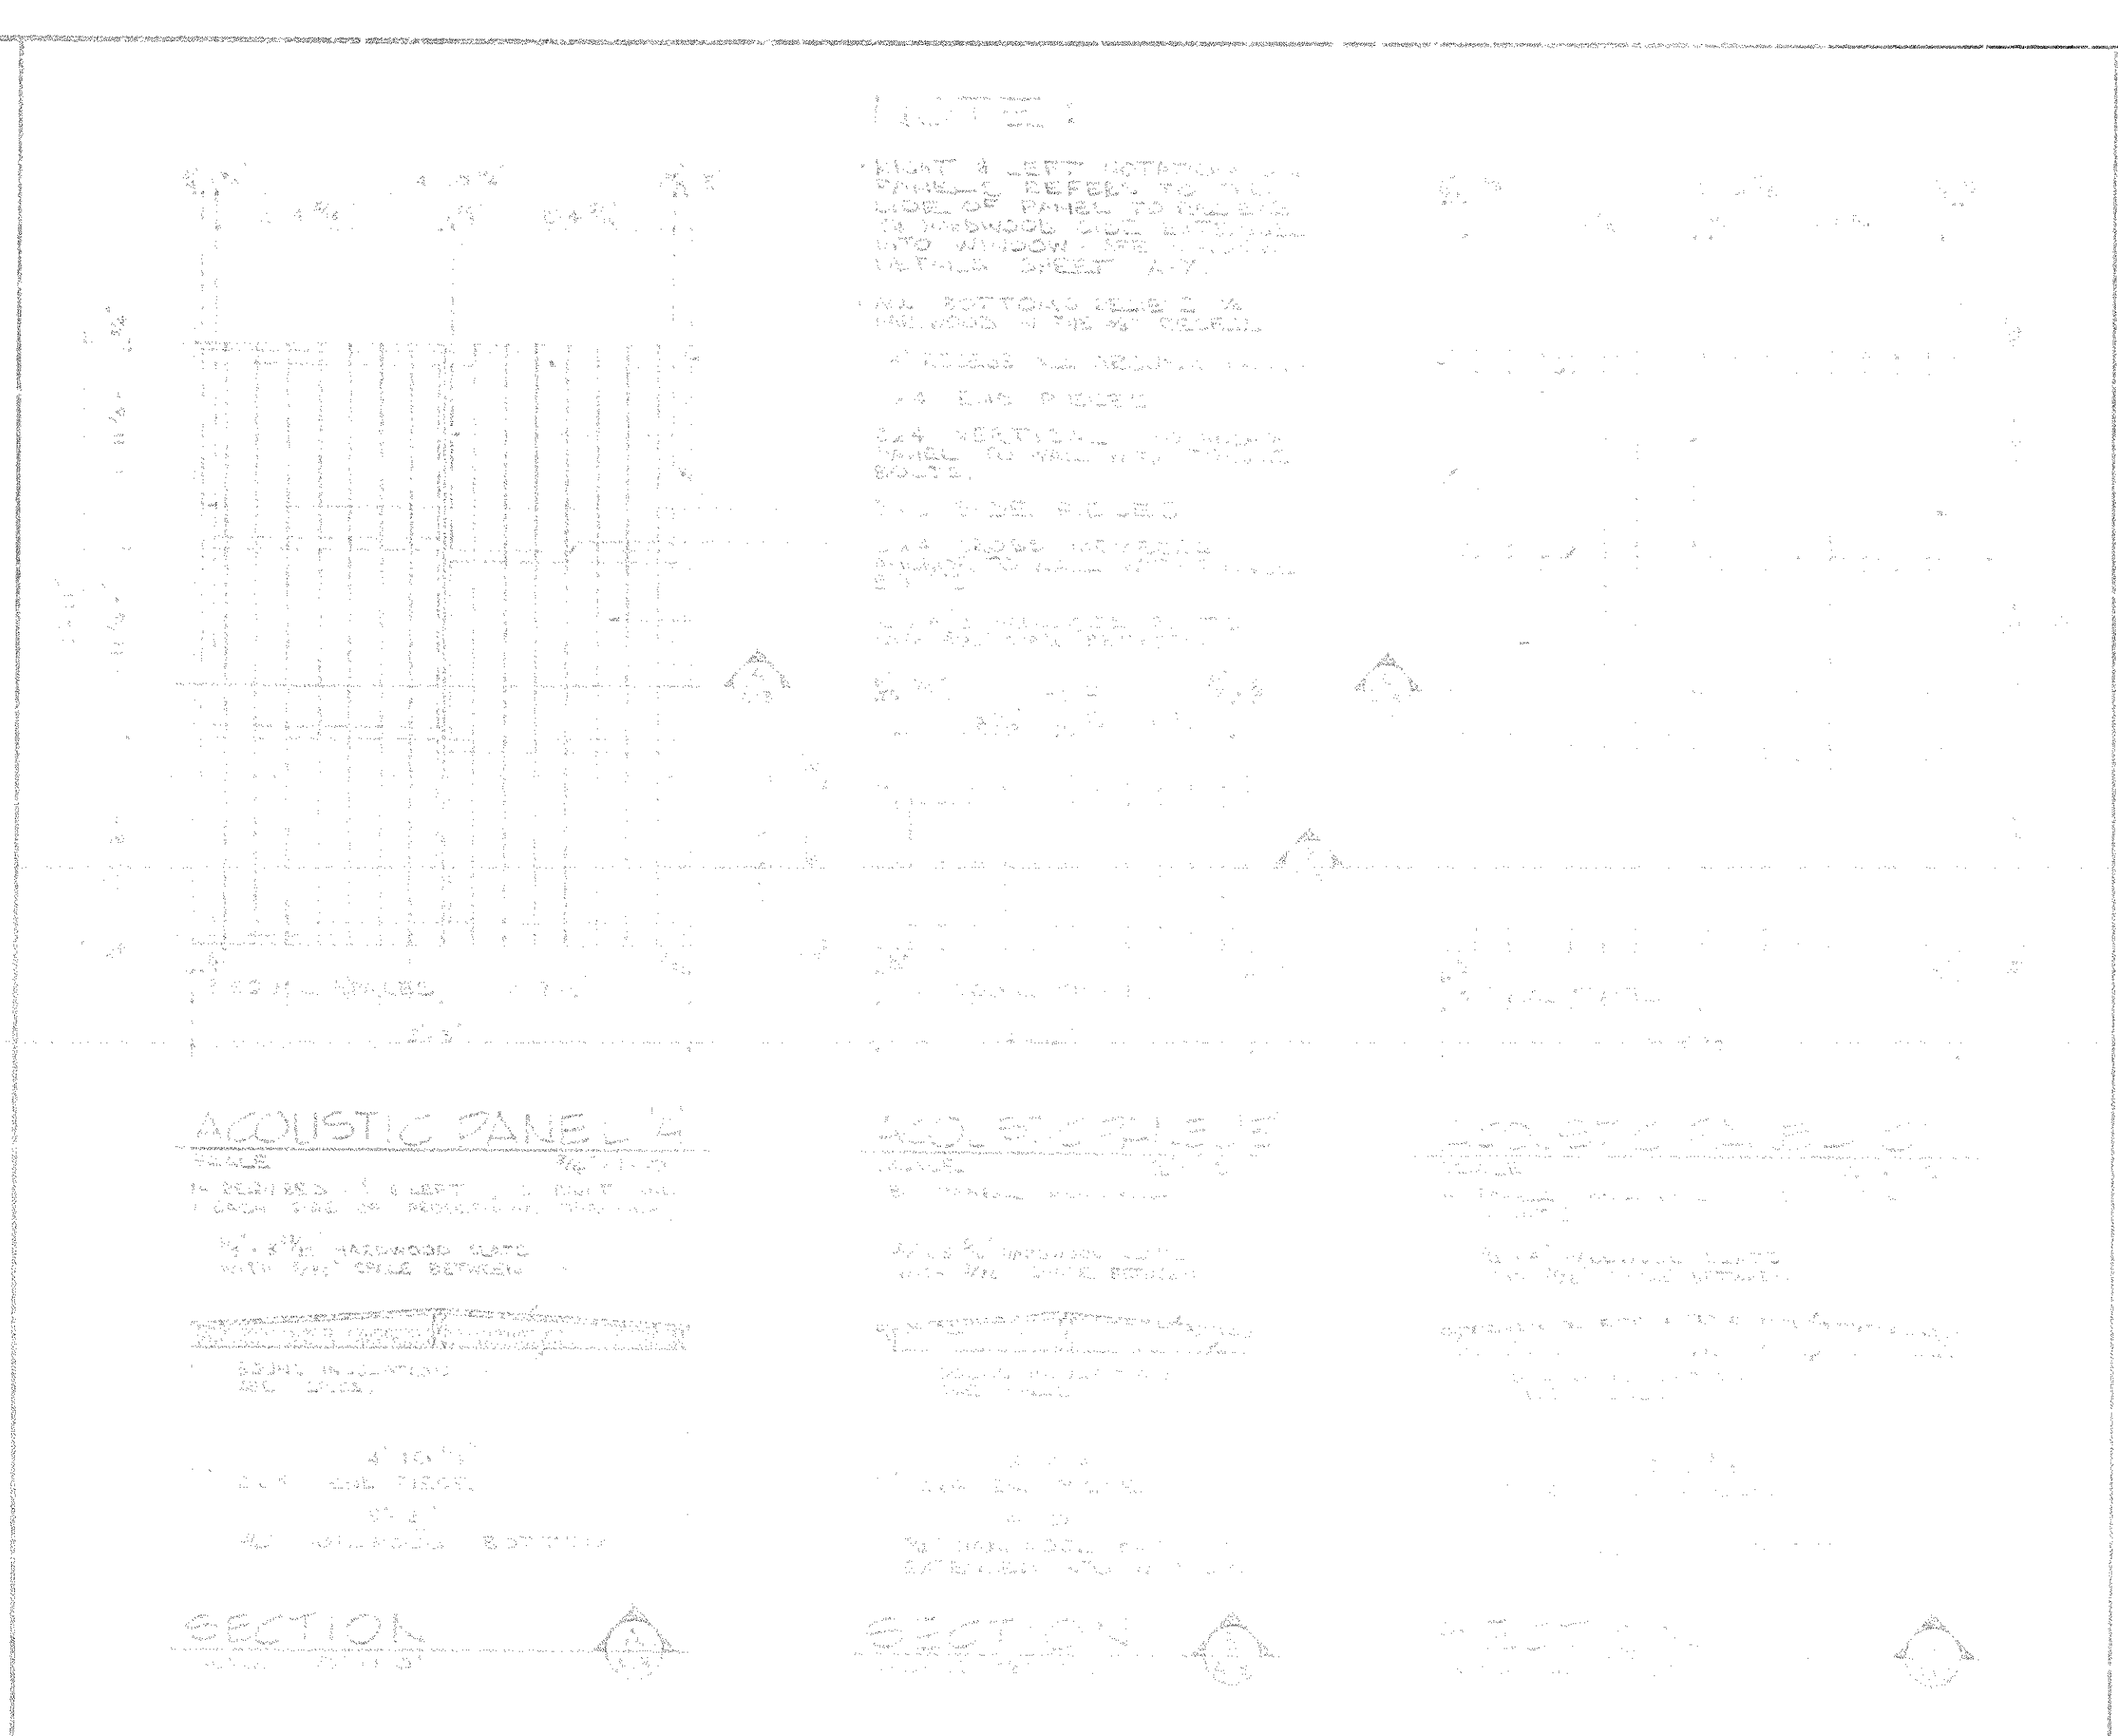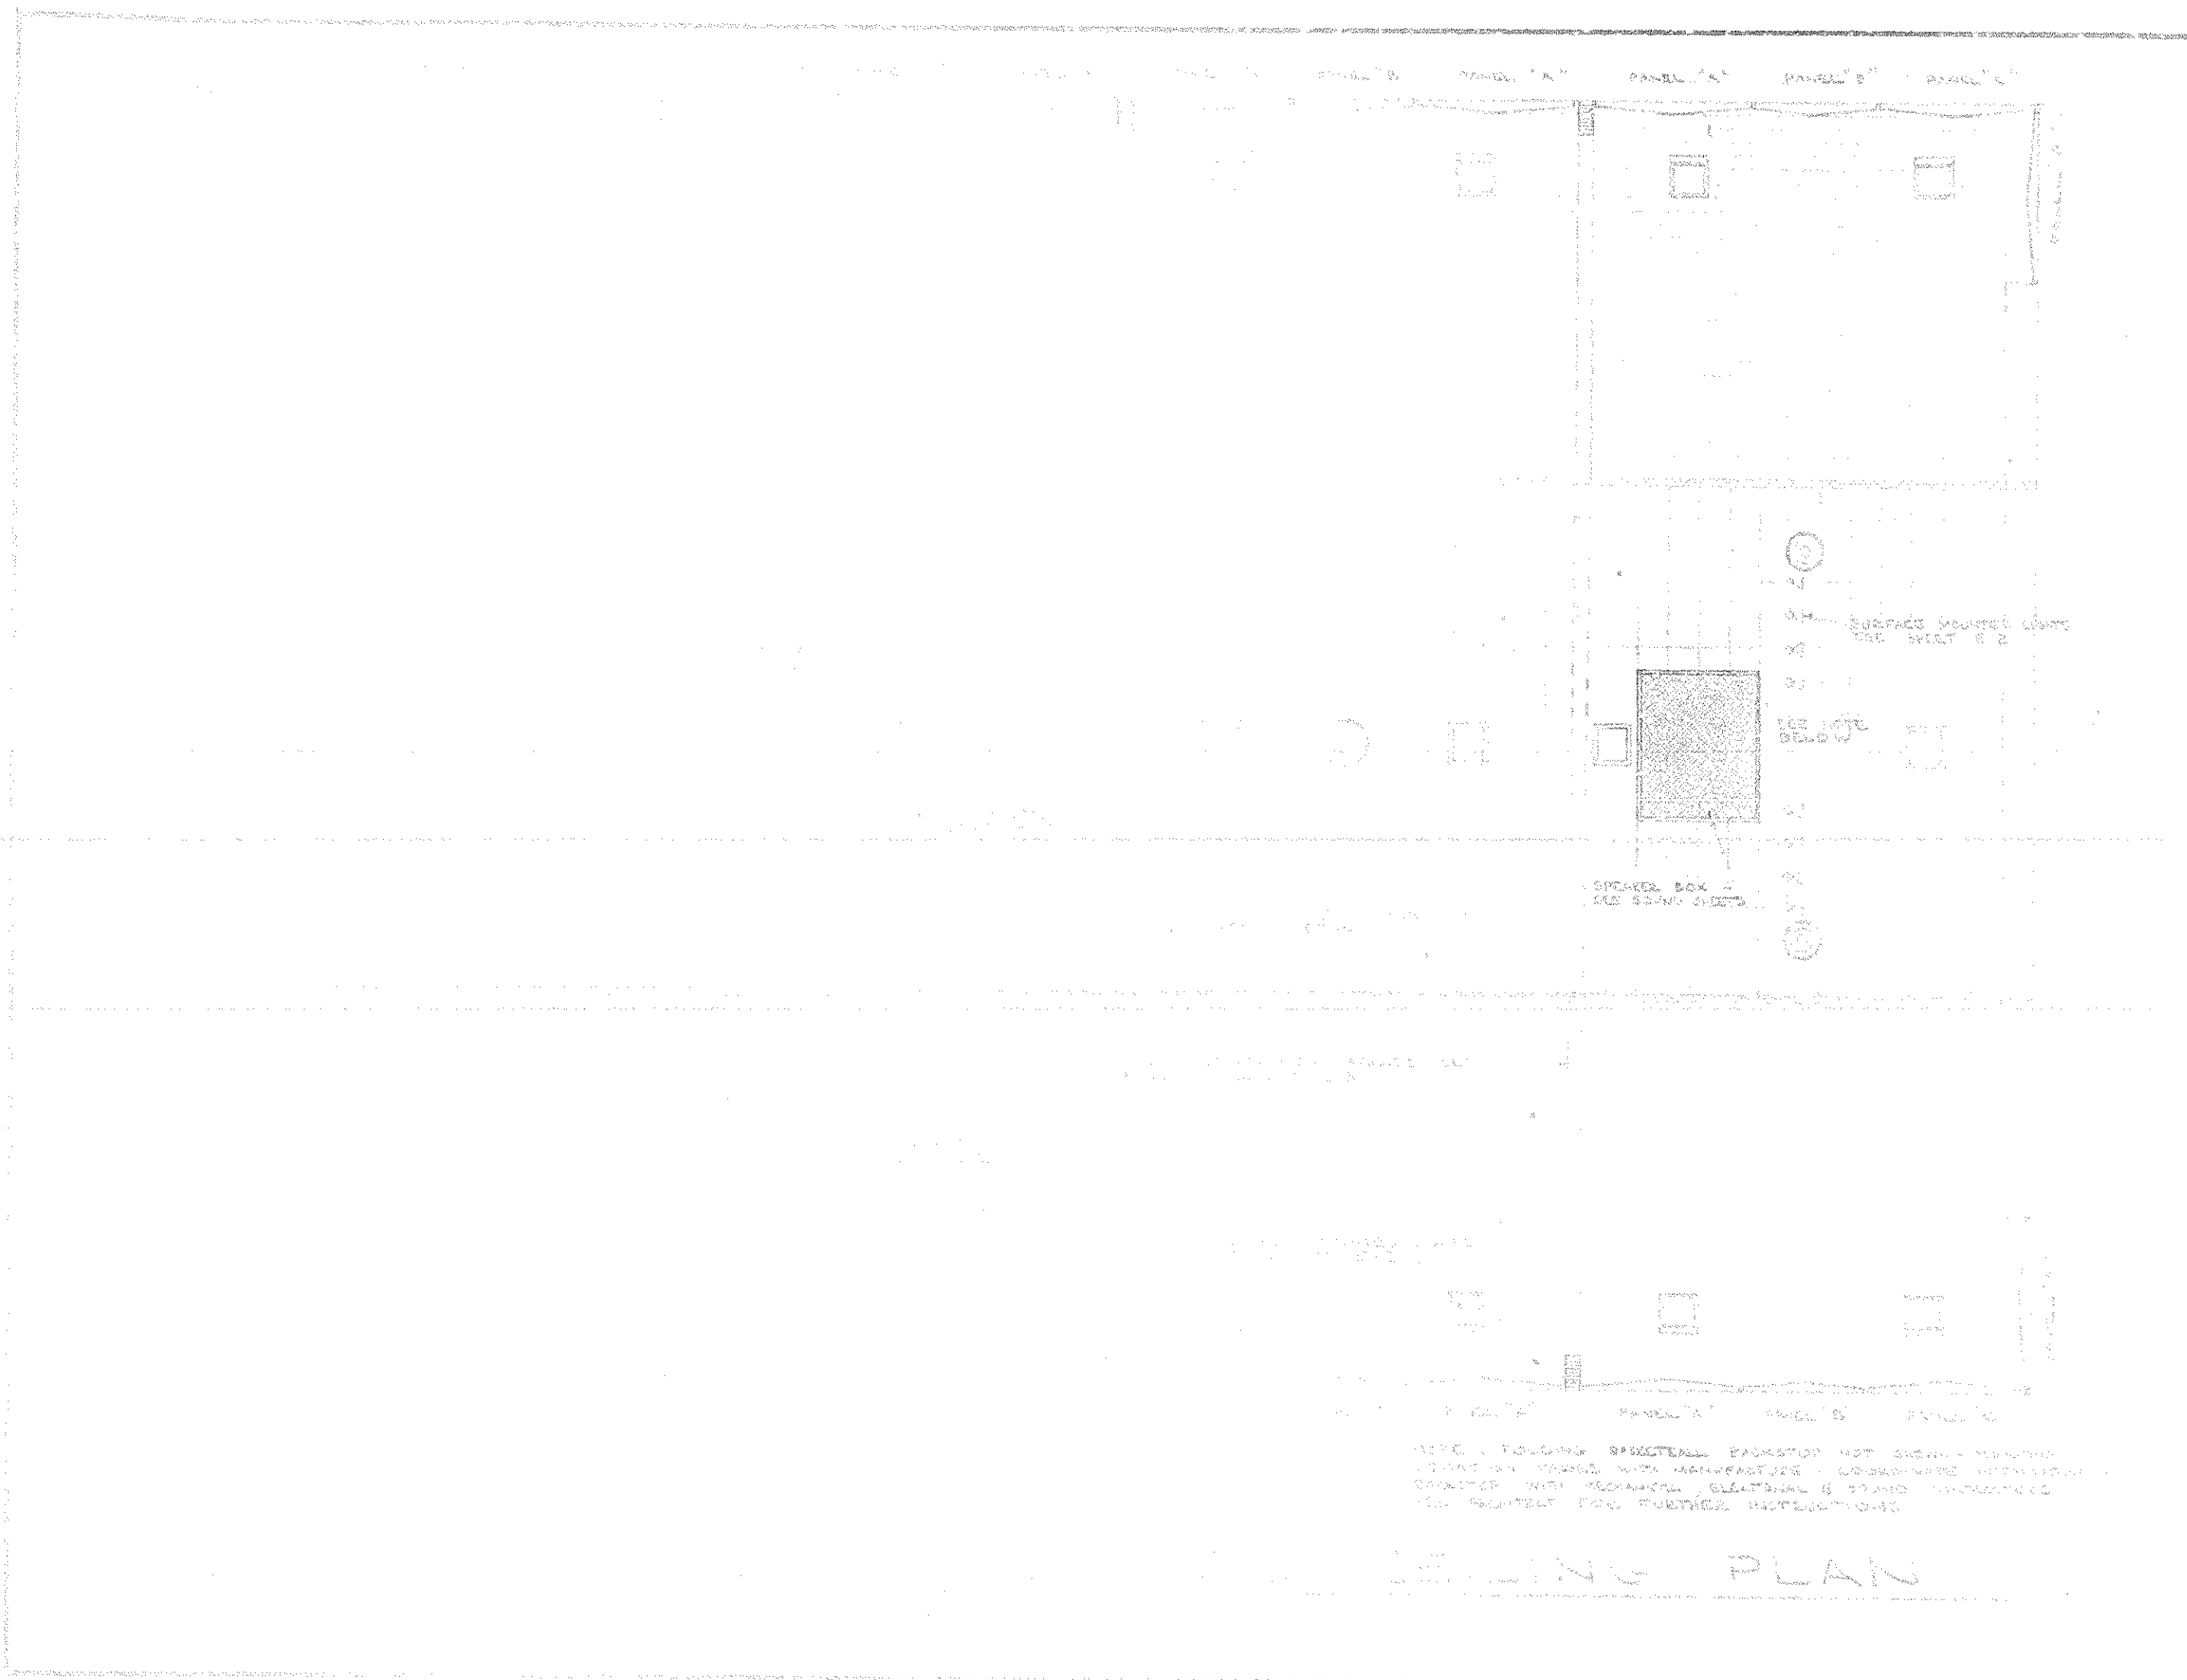


136677

SHEET NUMBER  
**A13 20**

HAROLD E. COLLARD  
ARCHITECT  
IDAHO FALLS, IDAHO

PROJECT NUMBER

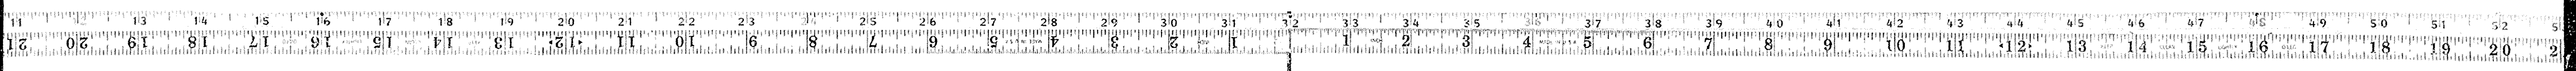



FOOTING SCHEDULE									
MARK	WIDTH	LENGTH	DEPTH	REIN. CROSSWISE			REIN. LENGTHWISE		
				NO.	SIZE	SPACING	NO.	SIZE	SPACING
F1	5'0"	5'0"	10"	6	#6	10"	6	#6	10"
F2	3'0"	3'0"	10"	4	#4	10"	4	#4	10"
F3	2'6"	2'6"	10"	3	#4	10"	3	#4	10"
F4	2'0"	2'0"	10"	3	#4	10"	3	#4	10"
F5	2'9"	CONT.	10"	3	#4	10"	3	#4	10"
F6	2'0"	CONT.	10"	3	#4	10"	3	#4	10"
F7	1'6"	CONT.	10"	3	#4	10"	3	#4	10"
F8	1'6"	CONT.	10"	3	#4	10"	3	#4	10"
F9	1'6"	CONT.	10"	3	#4	10"	3	#4	10"
F10	1'6"	CONT.	10"	3	#4	10"	3	#4	10"
F11	1'6"	CONT.	10"	3	#4	10"	3	#4	10"


FOUNDATION WALL REINFORCING		
MARK	REINFORCING	REMARKS
FW1	#4 @ 16" O.C. TOP & BOT. CONT. THROUGH WALL	
FW2	#4 @ 16" O.C. TOP & BOT. CONT. THROUGH WALL	
FW3	#4 @ 16" O.C. TOP & BOT. CONT. THROUGH WALL	
FW4	#4 @ 16" O.C. TOP & BOT. CONT. THROUGH WALL	
FW5	#4 @ 16" O.C. TOP & BOT. CONT. THROUGH WALL	
FW6	#4 @ 16" O.C. TOP & BOT. CONT. THROUGH WALL	
FW7	#4 @ 16" O.C. TOP & BOT. CONT. THROUGH WALL	
FW8	#4 @ 16" O.C. TOP & BOT. CONT. THROUGH WALL	

REINFORCING DWEL SCHEDULE		
MARK	REINFORCING	REMARKS
RD1	#4 @ 16" O.C. TOP & BOT. CONT. THROUGH WALL	
RD2	#4 @ 16" O.C. TOP & BOT. CONT. THROUGH WALL	
RD3	#4 @ 16" O.C. TOP & BOT. CONT. THROUGH WALL	
RD4	#4 @ 16" O.C. TOP & BOT. CONT. THROUGH WALL	
RD5	#4 @ 16" O.C. TOP & BOT. CONT. THROUGH WALL	
RD6	#4 @ 16" O.C. TOP & BOT. CONT. THROUGH WALL	
RD7	#4 @ 16" O.C. TOP & BOT. CONT. THROUGH WALL	
RD8	#4 @ 16" O.C. TOP & BOT. CONT. THROUGH WALL	


CONCRETE SLAB SCHEDULE		
MARK	THICKNESS	REMARKS
CS1	4"	SEE DETAIL
CS2	4"	SEE DETAIL
CS3	4"	SEE DETAIL

**FOOTING & FOUNDATION PLAN**

SCALE: 1/8" = 1'-0"  
ELEV. TOP OF FTSG SHOWN THIS WAY

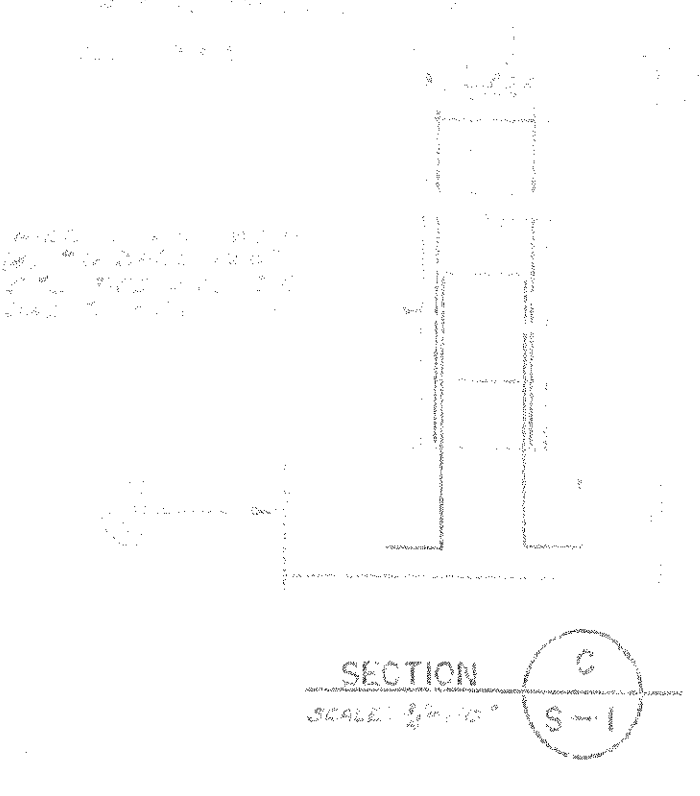

DESIGN CRITERIA	
WIND PRESSURE AREA	20 p.s.f.
SEISMIC ZONE	ZONE 2
DEAD LIVE LOAD	30 p.s.f.
MAXIMUM SOIL PRESSURE	2000 p.s.f.

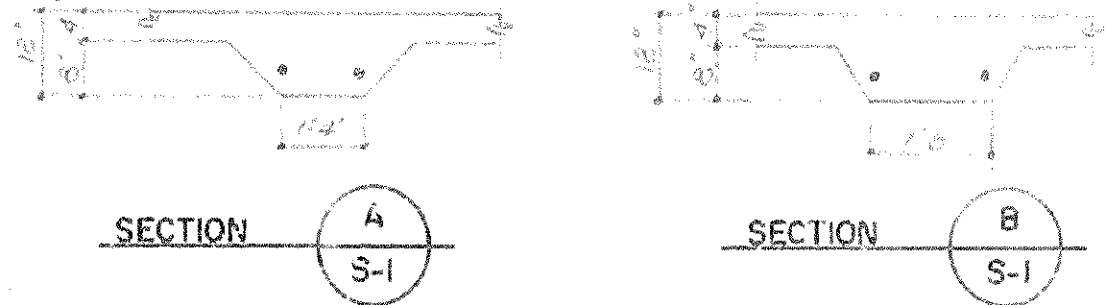


APPROVED: [Signature]  
 CHECKED: [Signature]  
 DRAWN: [Signature]

HAROLD E. COLLARD  
 ARCHITECT  
 IDAHO FALLS, IDAHO


13680

SHEET NUMBER  
 S-1 of 7

PROJECT NUMBER

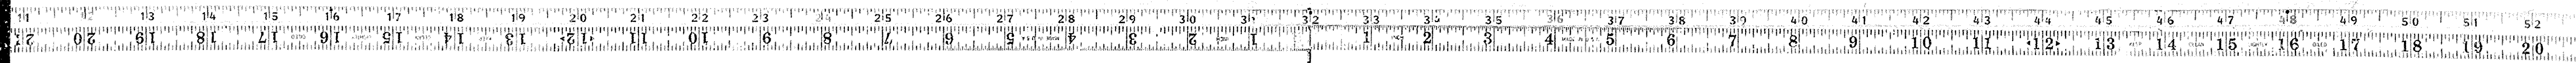



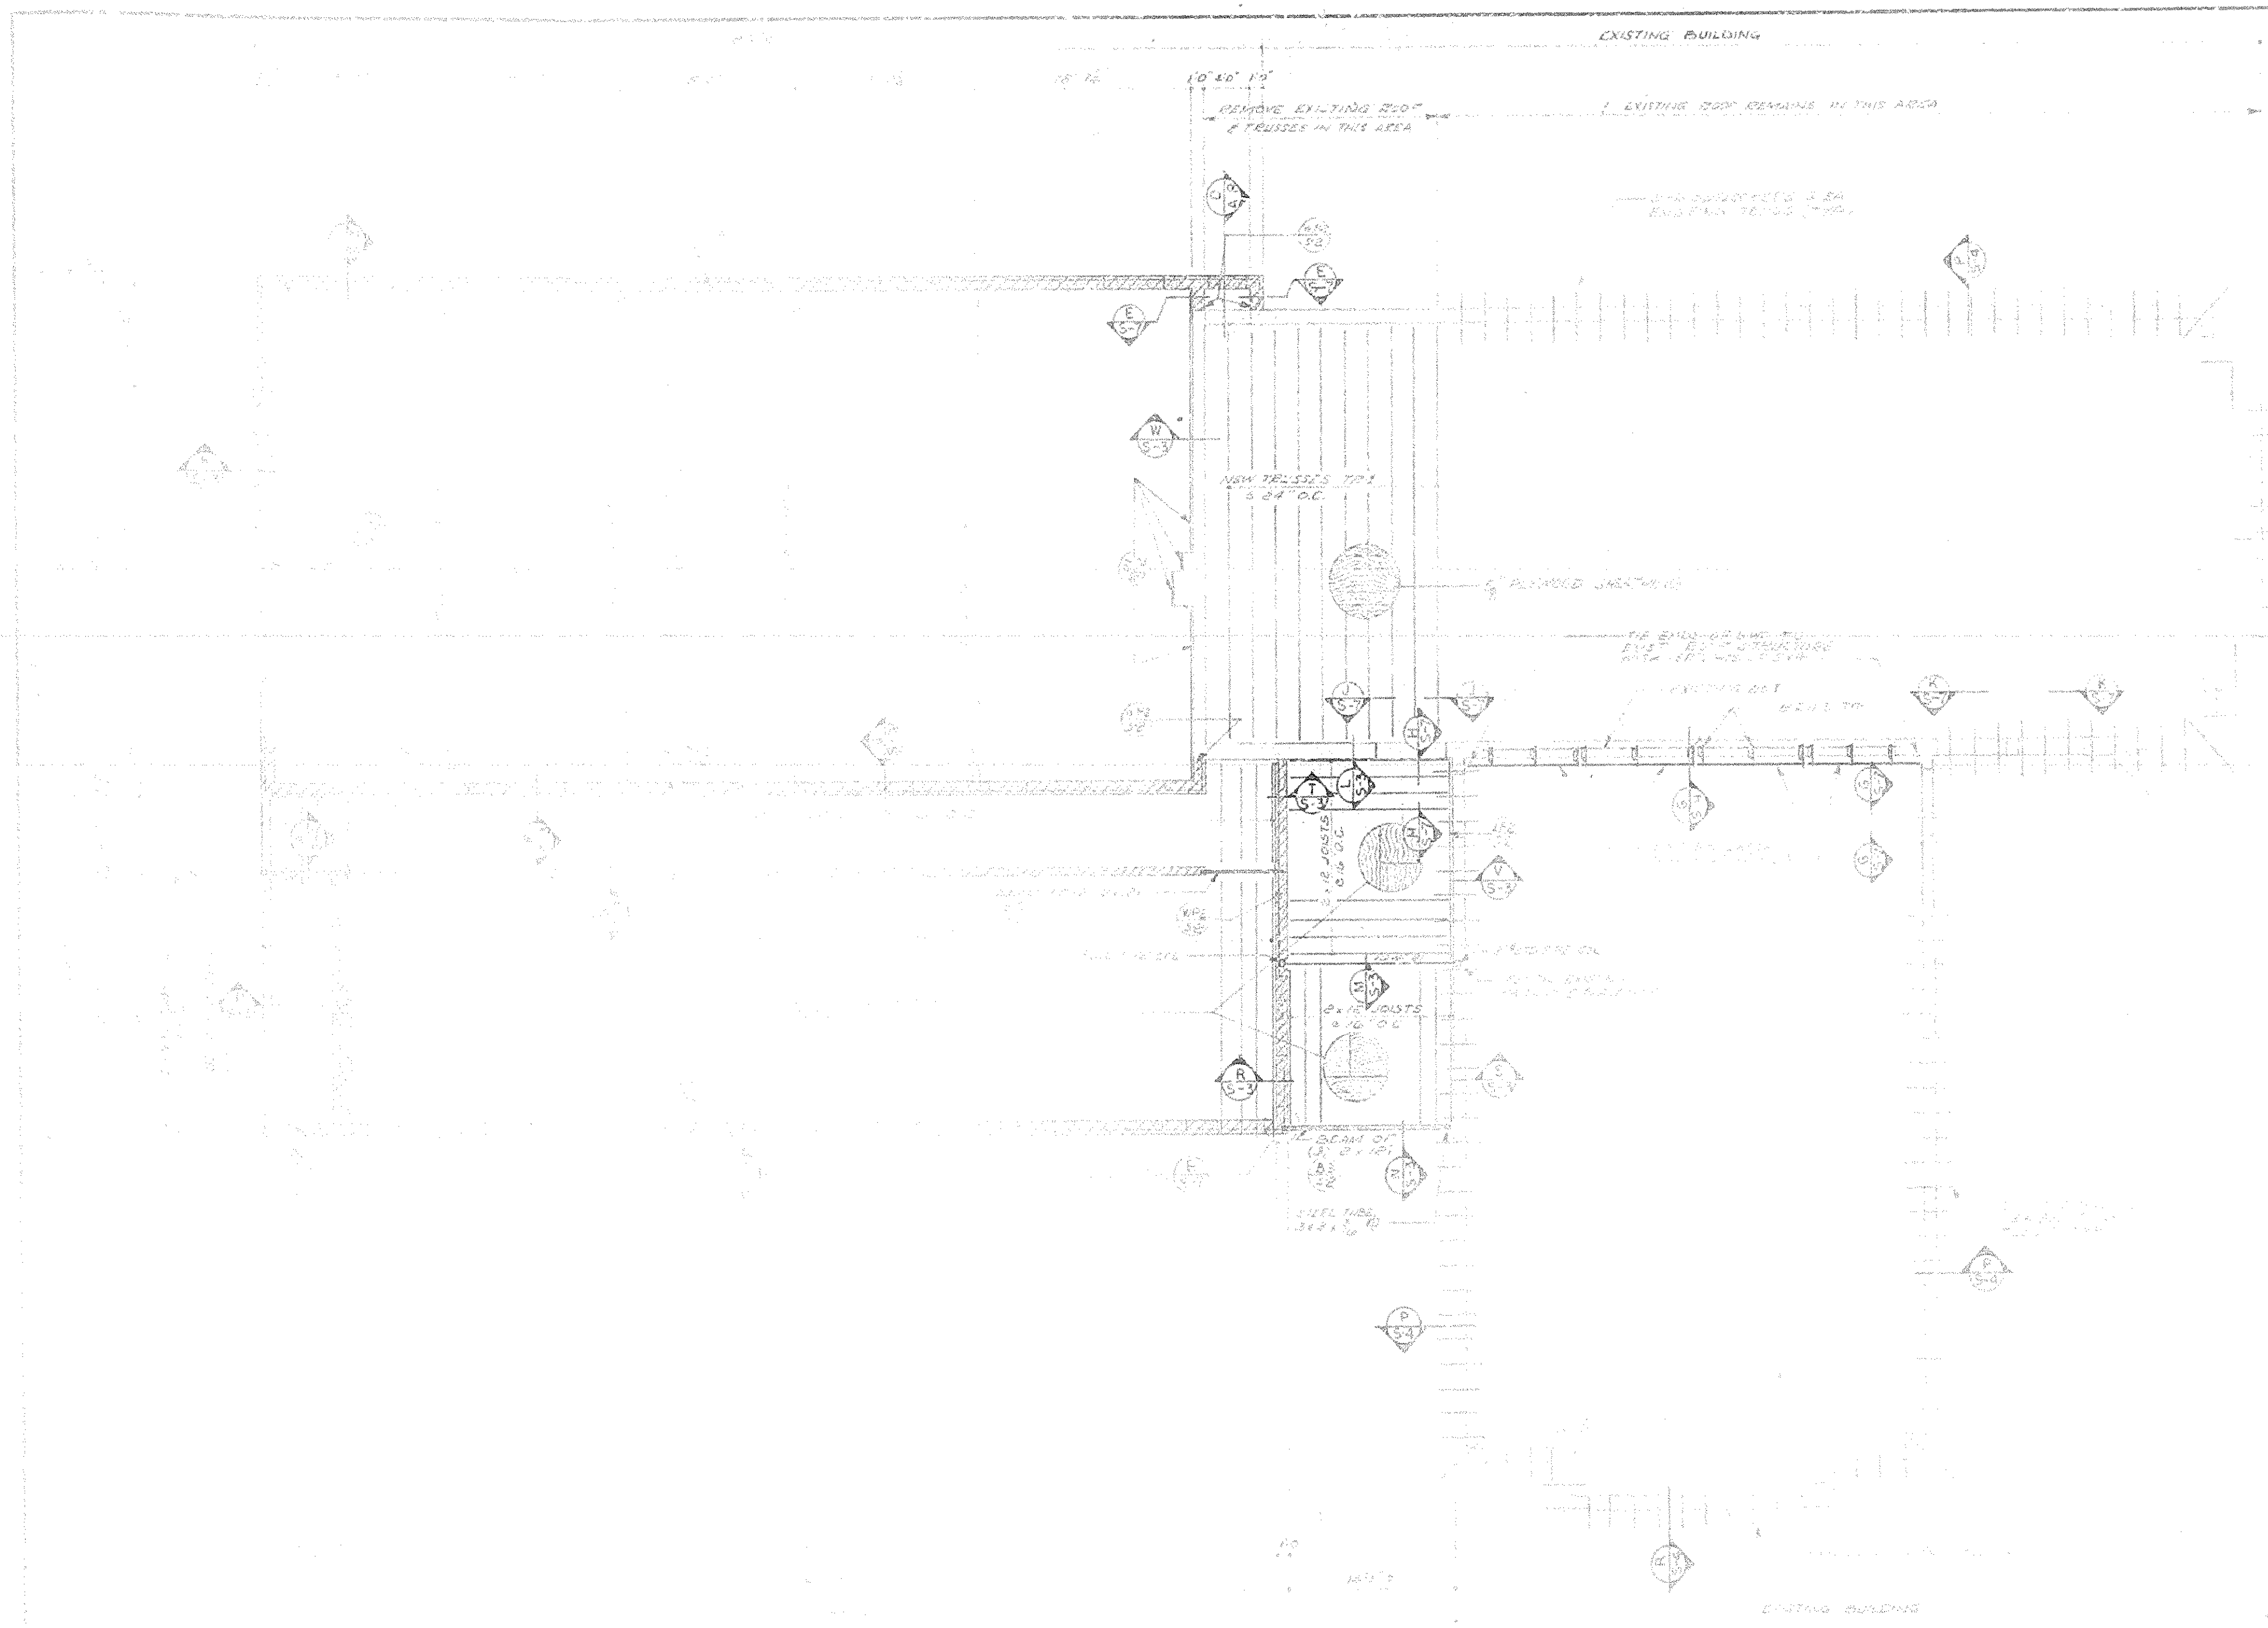

MECHANICAL ROOM FLOOR FRAMING PLAN  
ABOVE PLATFORM 126  
SCALE: 3/8" = 1'-0"

WALL BEARING PLATE SCHEDULE

NO.	DESCRIPTION	REMARKS
1	2" x 4" x 8'	
2	2" x 4" x 8'	
LEDGER PLATE SCHEDULE


NO.	DESCRIPTION	REMARKS
1	2" x 4" x 8'	
2	2" x 4" x 8'	
3	2" x 4" x 8'	
BEAM SCHEDULE

NO.	DESCRIPTION	REMARKS
1	2" x 4" x 8'	
2	2" x 4" x 8'	
3	2" x 4" x 8'	
ROOF FRAMING PLAN  
SCALE: 3/8" = 1'-0"


DETAIL A  
E-2

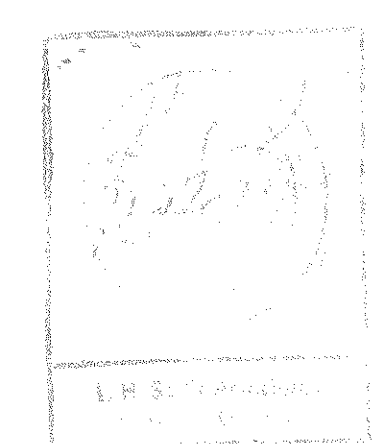

136081  
SHEET NUMBER  
S-2 of 7

HAROLD E. COLLARD  
ARCHITECT  
IDAHO FALLS, IDAHO

PROJECT NUMBER

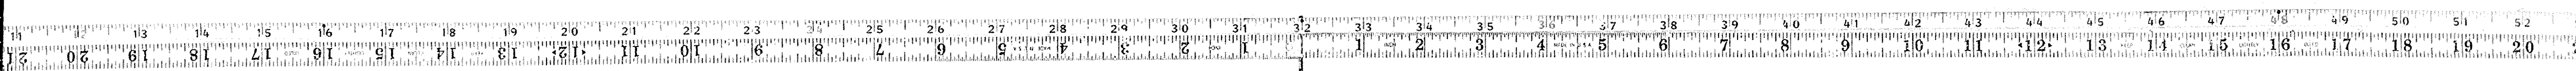




HAROLD E. COLLARD  
 ARCHITECT  
 A. A.  
 IDAHO FALLS, IDAHO

SHEET NUMBER  
 S-3 of 7

PROJECT NUMBER

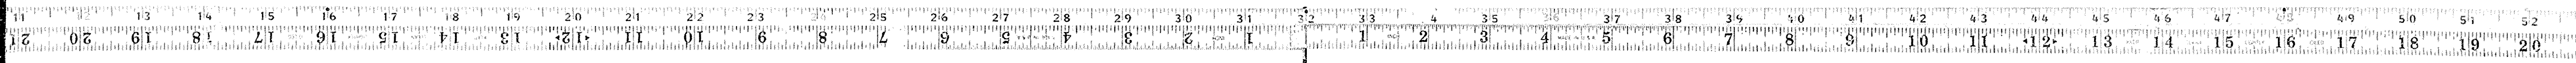





**MASONRY BOND BEAM SCHEDULE**

**LINTEL SCHEDULE**


MARK	SIZE	REINFORCEMENT	TIE	ALIGNMENT
BB1	8 x 8	Ø1" S @ 18" O.C.		
BB2	8 x 8	Ø1" S @ 18" O.C.		
BB3	8 x 8	Ø1" S @ 18" O.C.		
BB4	12 x 12	Ø1" S @ 18" O.C.		

MARK	APERTURE	OPENING	ALIGNMENT	REMARKS
LL1	ASSEMBLY	24" x 48"		SEE PLAN
LL2	ASSEMBLY	24" x 48"		SEE PLAN
LL3	ASSEMBLY	24" x 48"		SEE PLAN
LL4	ASSEMBLY	24" x 48"		SEE PLAN
LL5	ASSEMBLY	24" x 48"		SEE PLAN
LL6	ASSEMBLY	24" x 48"		SEE PLAN
LL7	ASSEMBLY	24" x 48"		SEE PLAN
LL8	ASSEMBLY	24" x 48"		SEE PLAN
LL9	ASSEMBLY	24" x 48"		SEE PLAN
LL10	ASSEMBLY	24" x 48"		SEE PLAN

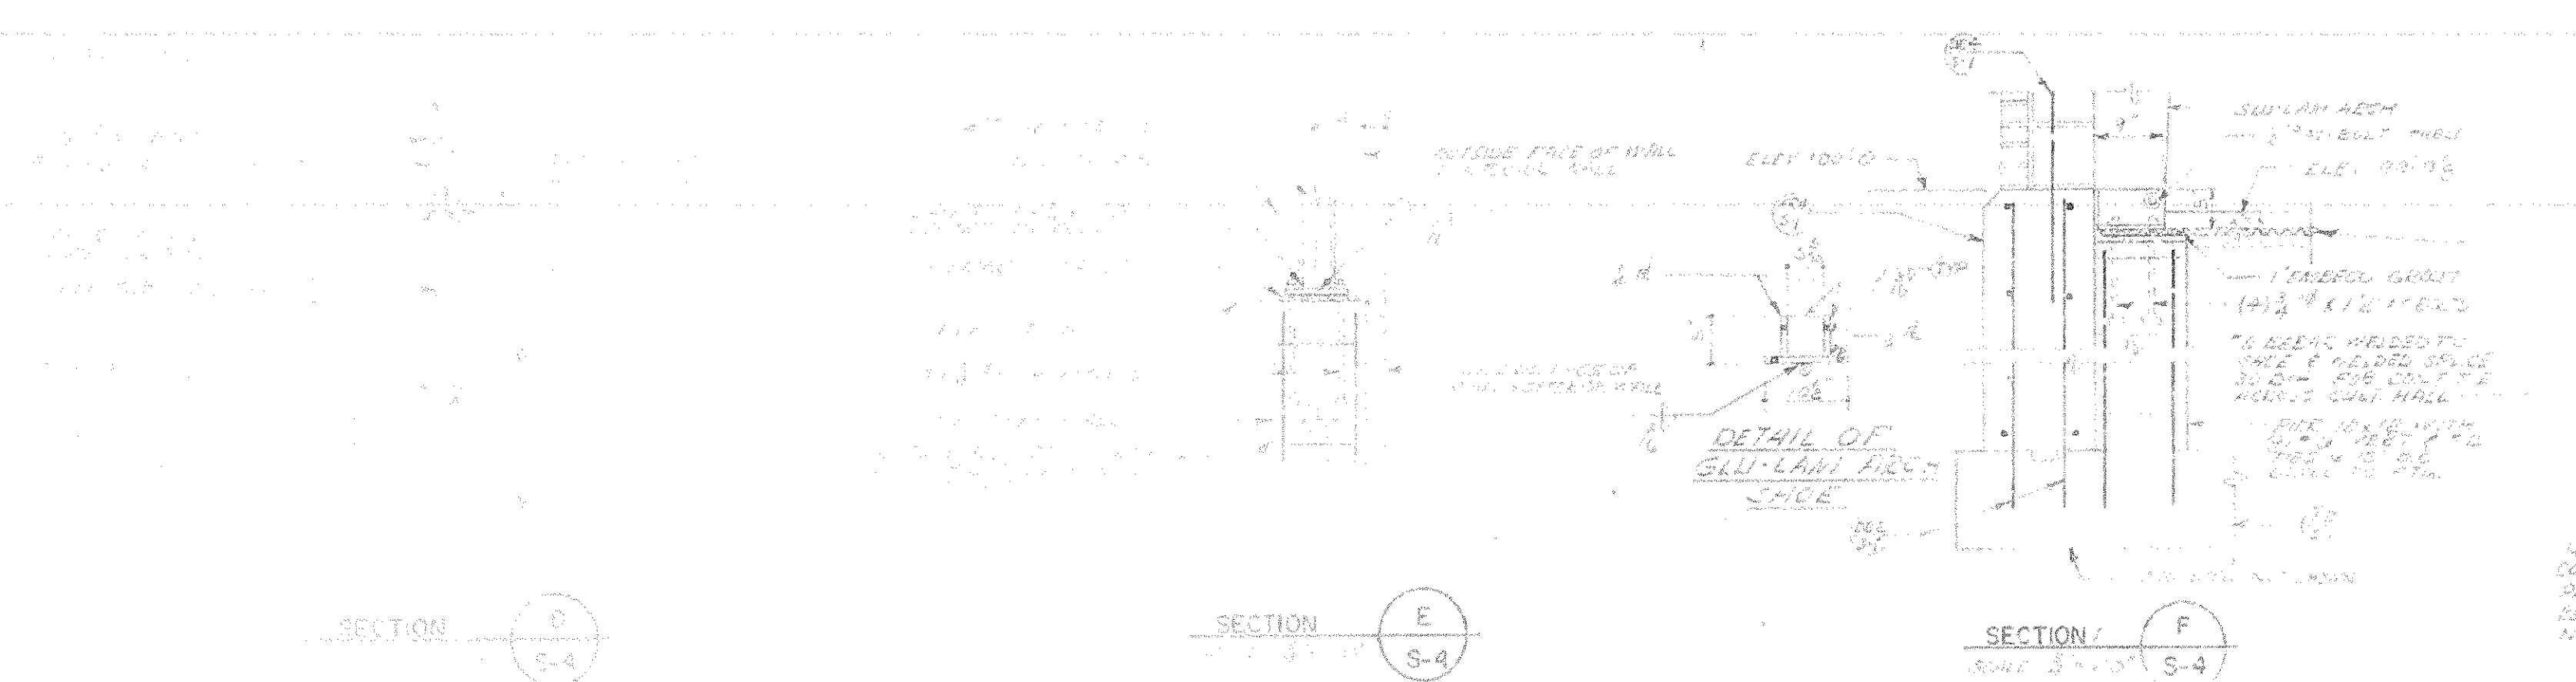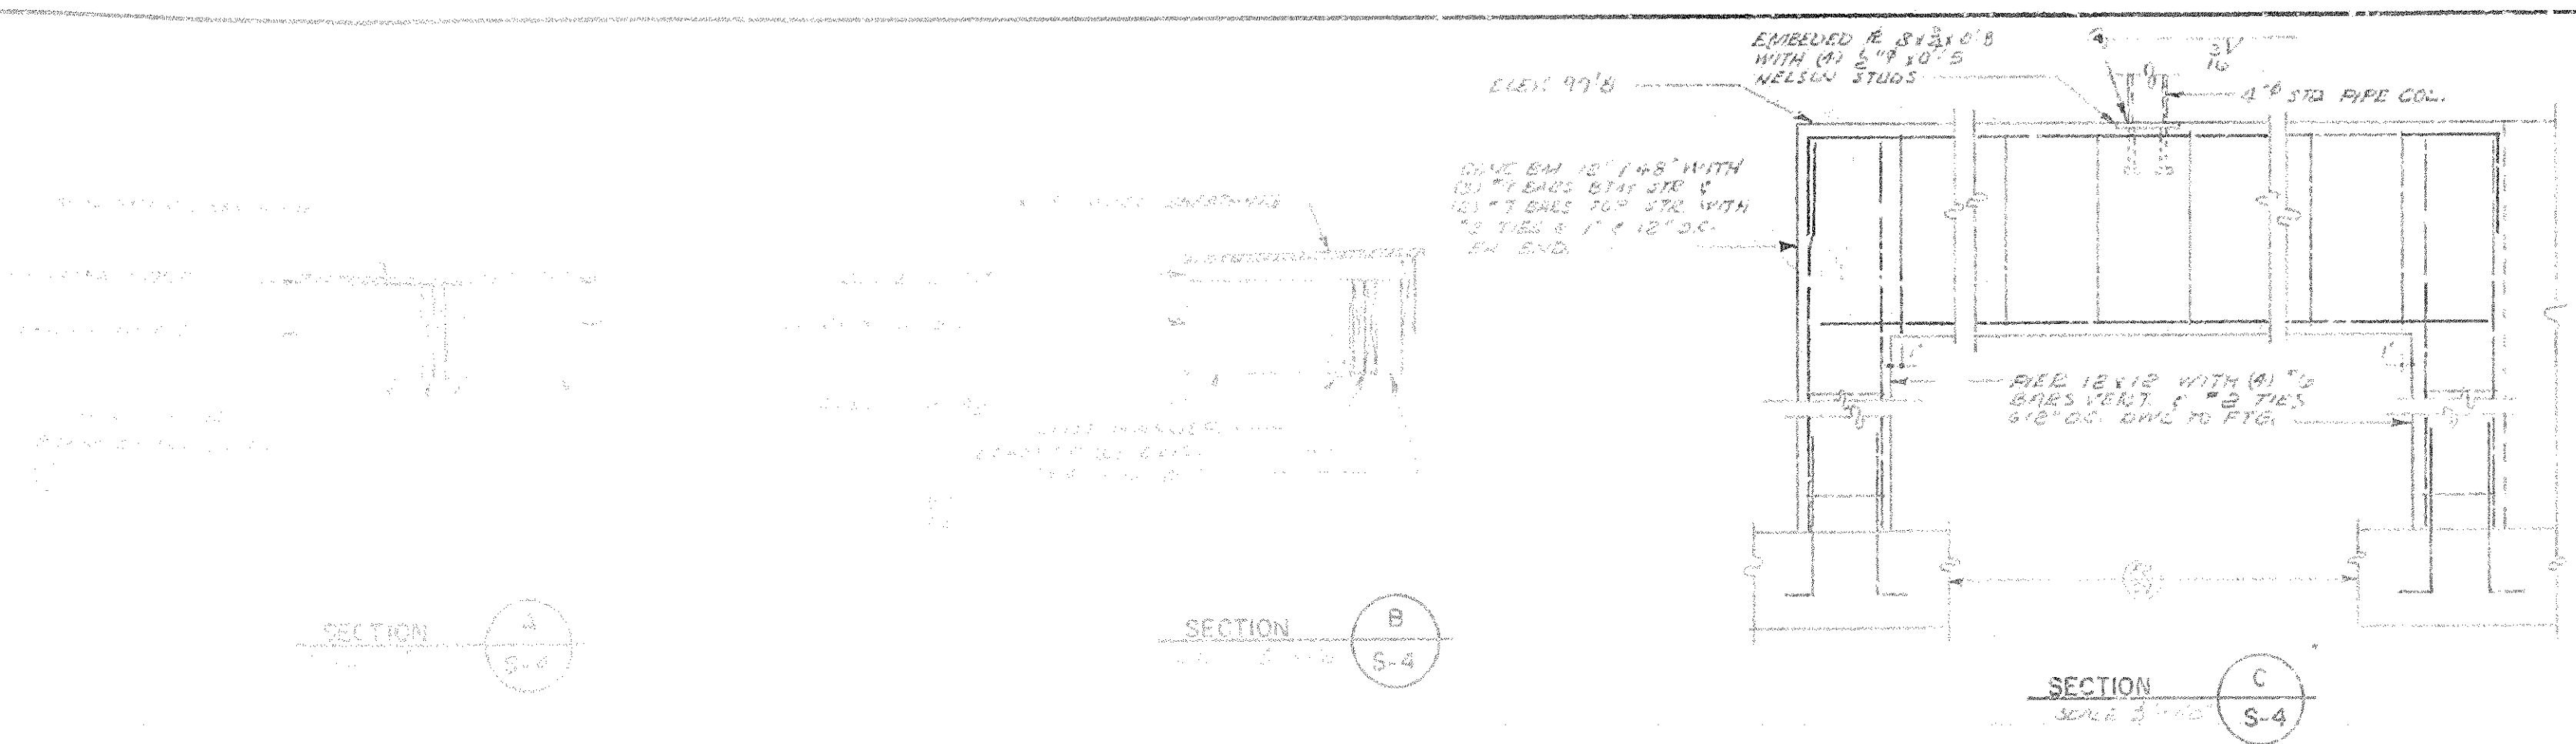




CLEAR OPENING	SIZE OF ANGLES
UP TO 5'-0"	3" x 3" x 1/4"
5'-1" TO 7'-0"	3" x 3" x 1/2"
7'-1" TO 9'-0"	5" x 5" x 1/4"
9'-1" TO 10'-0"	5" x 5" x 1/2"
10'-1" TO 11'-0"	5" x 5" x 3/4"
11'-1" TO 12'-0"	6" x 6" x 1/2"
12'-0" & OVER	12" SQUARE STEEL ANGLE

NOTE: LINTELS OVER WALLS SHALL BE FABRICATED FROM 304 OR 316 STAINLESS STEEL OR GALVANNEZED STEEL COATED WITH 100% ZINC RICH METAL FLAKE FINISH. PROVIDE 1" OF SPACING EACH END OF LINTEL FROM FACE OF WALL. PROVIDE 1" OF SPACING EACH END OF LINTEL FROM FACE OF WALL. PROVIDE 1" OF SPACING EACH END OF LINTEL FROM FACE OF WALL. PROVIDE 1" OF SPACING EACH END OF LINTEL FROM FACE OF WALL.

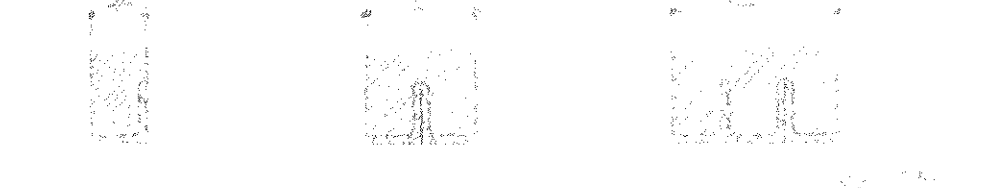

NOTE: THIS SCHEDULE IS TO BE USED FOR OPENINGS AND APERTURES INSTALLED IN THE WALL.

**LINTELS IN MASONRY OPENING**

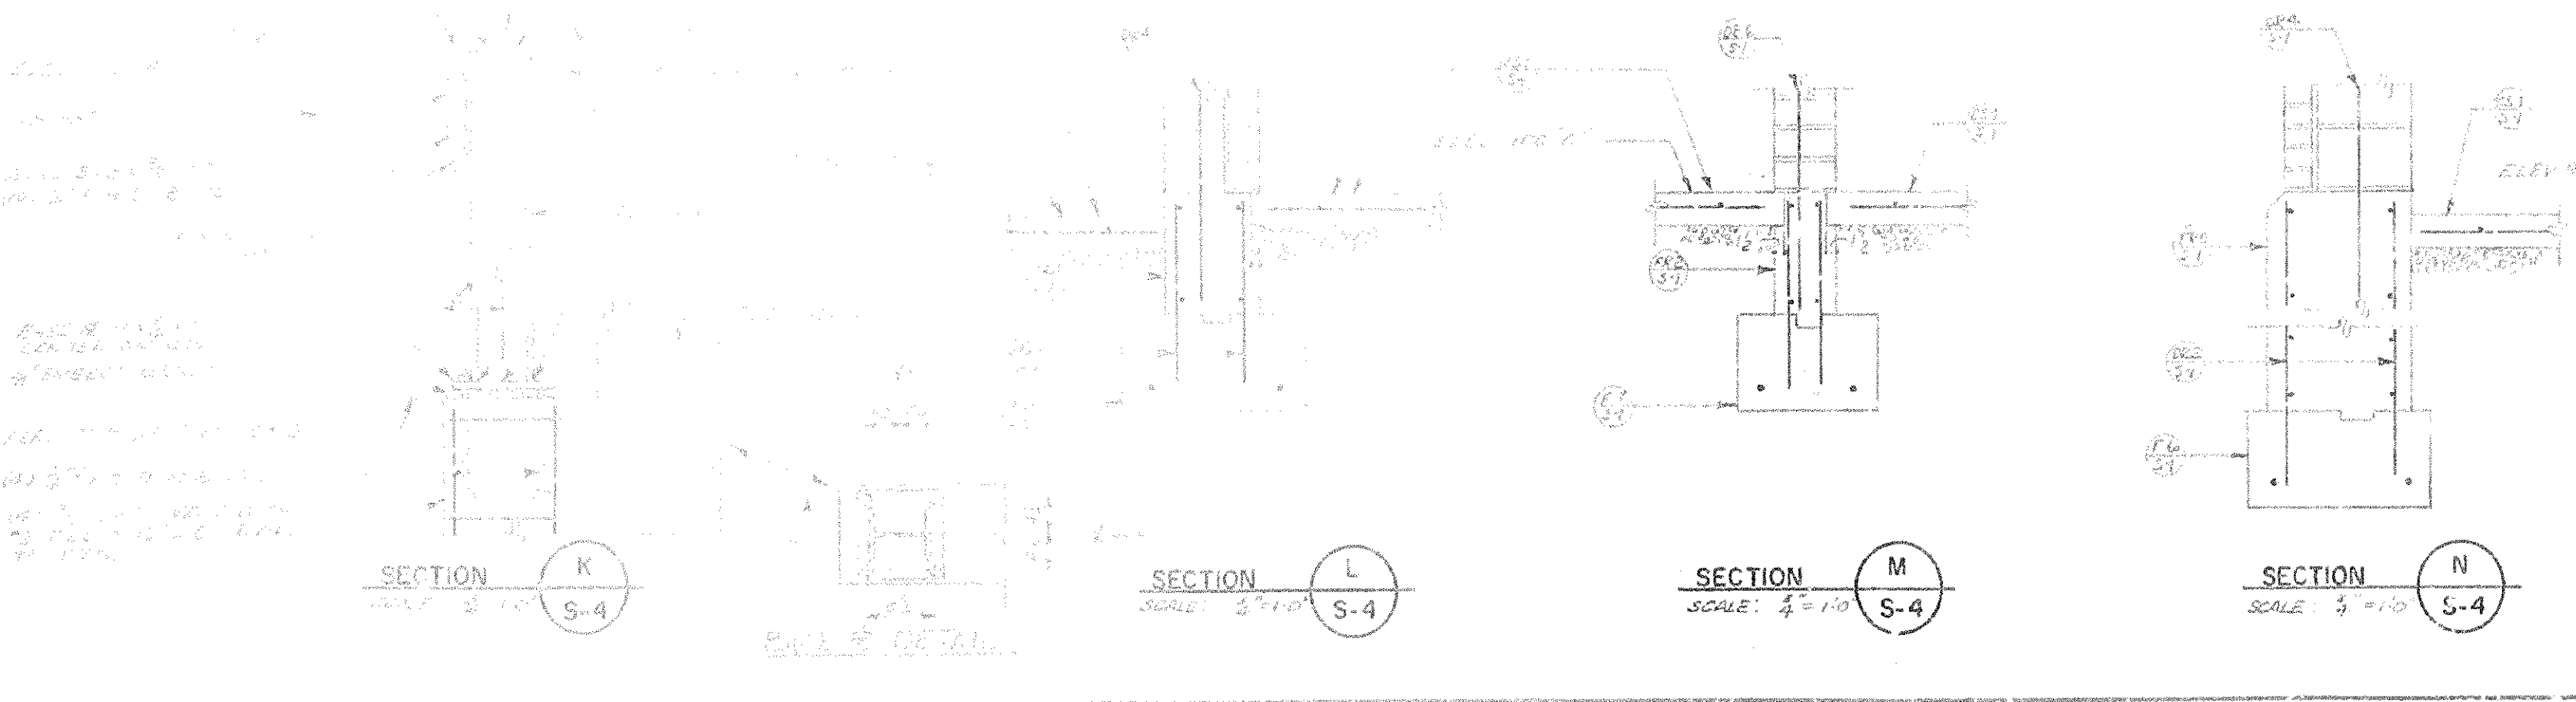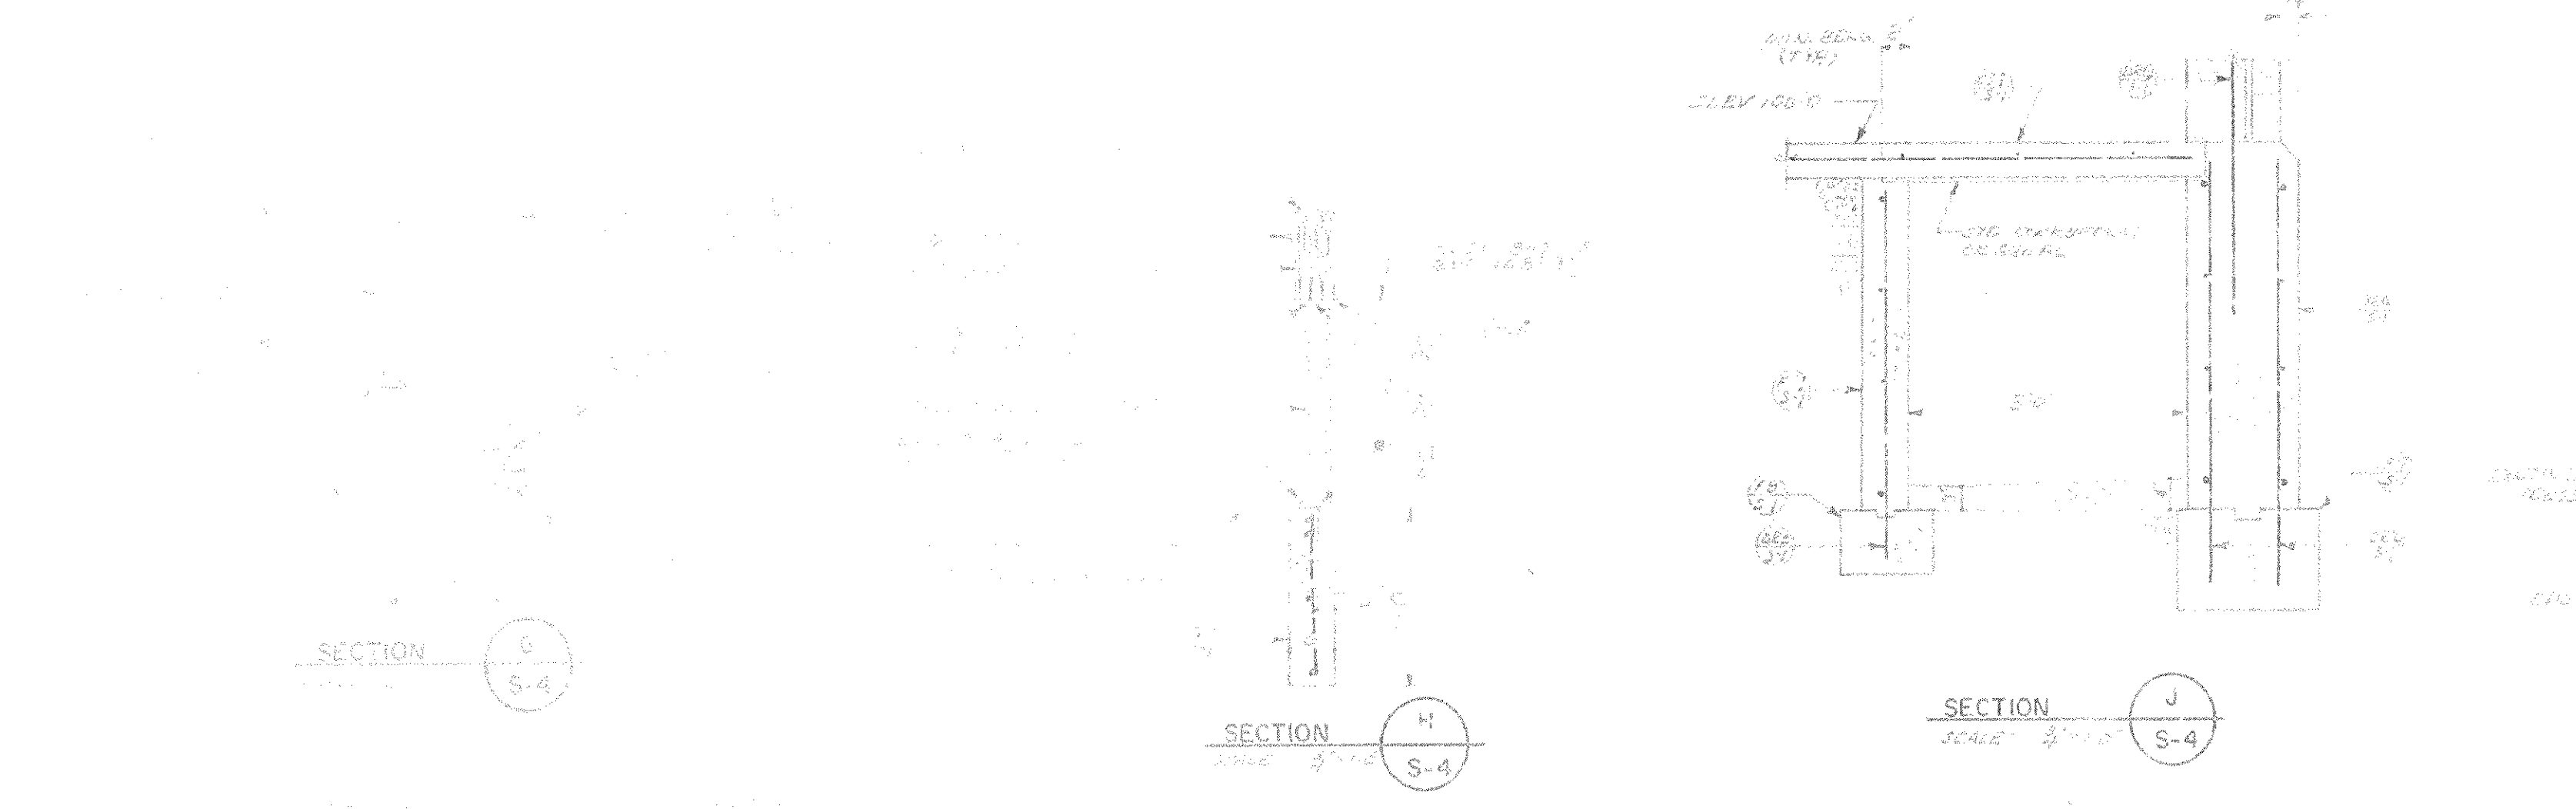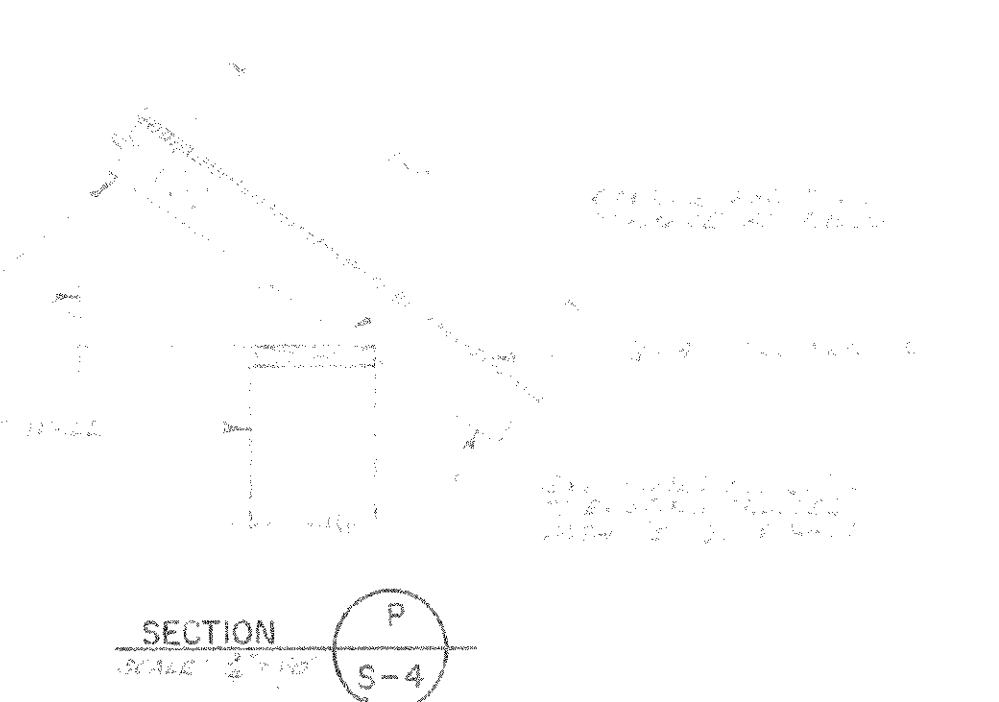

**TABLE OF EQUIVALENT FASTENERS**  
STAPLES, NAILS, & T-NAILS  
(VALID FOR LATERAL LOADS ONLY)

FASTENER TYPE	DIAMETER	LENGTH	EQUIVALENT STRENGTH OF FASTENER FOR LATERAL LOADS
STAPLE	1/8"	1 1/2"	100 LB
STAPLE	1/8"	2"	150 LB
STAPLE	1/8"	2 1/2"	200 LB
STAPLE	1/8"	3"	250 LB
STAPLE	1/8"	3 1/2"	300 LB
STAPLE	1/8"	4"	350 LB
STAPLE	1/8"	4 1/2"	400 LB
STAPLE	1/8"	5"	450 LB
STAPLE	1/8"	5 1/2"	500 LB
STAPLE	1/8"	6"	550 LB
STAPLE	1/8"	6 1/2"	600 LB
STAPLE	1/8"	7"	650 LB
STAPLE	1/8"	7 1/2"	700 LB
STAPLE	1/8"	8"	750 LB
STAPLE	1/8"	8 1/2"	800 LB
STAPLE	1/8"	9"	850 LB
STAPLE	1/8"	9 1/2"	900 LB
STAPLE	1/8"	10"	950 LB
STAPLE	1/8"	10 1/2"	1000 LB
STAPLE	1/8"	11"	1050 LB
STAPLE	1/8"	11 1/2"	1100 LB
STAPLE	1/8"	12"	1150 LB
STAPLE	1/8"	12 1/2"	1200 LB
STAPLE	1/8"	13"	1250 LB
STAPLE	1/8"	13 1/2"	1300 LB
STAPLE	1/8"	14"	1350 LB
STAPLE	1/8"	14 1/2"	1400 LB
STAPLE	1/8"	15"	1450 LB
STAPLE	1/8"	15 1/2"	1500 LB
STAPLE	1/8"	16"	1550 LB
STAPLE	1/8"	16 1/2"	1600 LB
STAPLE	1/8"	17"	1650 LB
STAPLE	1/8"	17 1/2"	1700 LB
STAPLE	1/8"	18"	1750 LB
STAPLE	1/8"	18 1/2"	1800 LB
STAPLE	1/8"	19"	1850 LB
STAPLE	1/8"	19 1/2"	1900 LB
STAPLE	1/8"	20"	1950 LB
STAPLE	1/8"	20 1/2"	2000 LB
STAPLE	1/8"	21"	2050 LB
STAPLE	1/8"	21 1/2"	2100 LB
STAPLE	1/8"	22"	2150 LB
STAPLE	1/8"	22 1/2"	2200 LB
STAPLE	1/8"	23"	2250 LB
STAPLE	1/8"	23 1/2"	2300 LB
STAPLE	1/8"	24"	2350 LB
STAPLE	1/8"	24 1/2"	2400 LB
STAPLE	1/8"	25"	2450 LB
STAPLE	1/8"	25 1/2"	2500 LB
STAPLE	1/8"	26"	2550 LB
STAPLE	1/8"	26 1/2"	2600 LB
STAPLE	1/8"	27"	2650 LB
STAPLE	1/8"	27 1/2"	2700 LB
STAPLE	1/8"	28"	2750 LB
STAPLE	1/8"	28 1/2"	2800 LB
STAPLE	1/8"	29"	2850 LB
STAPLE	1/8"	29 1/2"	2900 LB
STAPLE	1/8"	45 1/2"	4500 LB
STAPLE	1/8"	46"	4550 LB
STAPLE	1/8"	46 1/2"	4600 LB
STAPLE	1/8"	47"	4650 LB
STAPLE	1/8"	47 1/2"	4700 LB
STAPLE	1/8"	48"	4750 LB
STAPLE	1/8"	48 1/2"	4800 LB
STAPLE	1/8"	49"	4850 LB
STAPLE	1/8"	49 1/2"	4900 LB
STAPLE	1/8"	50"	4950 LB
STAPLE	1/8"	50 1/2"	5000 LB
STAPLE	1/8"	51"	5050 LB
STAPLE	1/8"	51 1/2"	5100 LB
STAPLE	1/8"	52"	5150 LB
STAPLE	1/8"	52 1/2"	5200 LB
STAPLE	1/8"	53"	5250 LB
STAPLE	1/8"	53 1/2"	5300 LB
STAPLE	1/8"	54"	5350 LB
STAPLE	1/8"	54 1/2"	5400 LB
STAPLE	1/8"	55"	5450 LB
STAPLE	1/8"	55 1/2"	5500 LB
STAPLE	1/8"	56"	5550 LB
STAPLE	1/8"	56 1/2"	5600 LB
STAPLE	1/8"	57"	5650 LB
STAPLE	1/8"	57 1/2"	5700 LB
STAPLE	1/8"	58"	5750 LB
STAPLE	1/8"	58 1/2"	5800 LB
STAPLE	1/8"	59"	5850 LB
STAPLE	1/8"	59 1/2"	5900 LB
STAPLE	1/8"	60"	5950 LB

NOTE: THE TABLE ABOVE IS FOR LATERAL LOADS ONLY. FOR OTHER LOADS, CONSULT THE MANUFACTURER'S LITERATURE.

NOTE: THE TABLE ABOVE IS FOR LATERAL LOADS ONLY. FOR OTHER LOADS, CONSULT THE MANUFACTURER'S LITERATURE.


NOTE: THE TABLE ABOVE IS FOR LATERAL LOADS ONLY. FOR OTHER LOADS, CONSULT THE MANUFACTURER'S LITERATURE.

NOTE: THE TABLE ABOVE IS FOR LATERAL LOADS ONLY. FOR OTHER LOADS, CONSULT THE MANUFACTURER'S LITERATURE.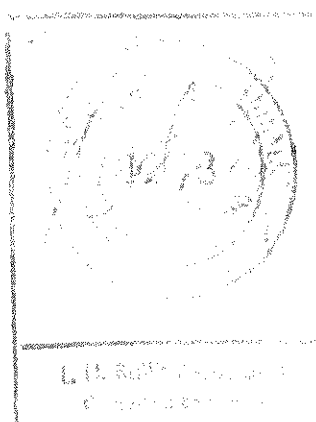

136053  
 SHEET NUMBER  
 S-4 of 7  
 HAROLD E. COLLARD  
 ARCHITECT  
 IDAHO FALLS, IDAHO

PROJECT NUMBER



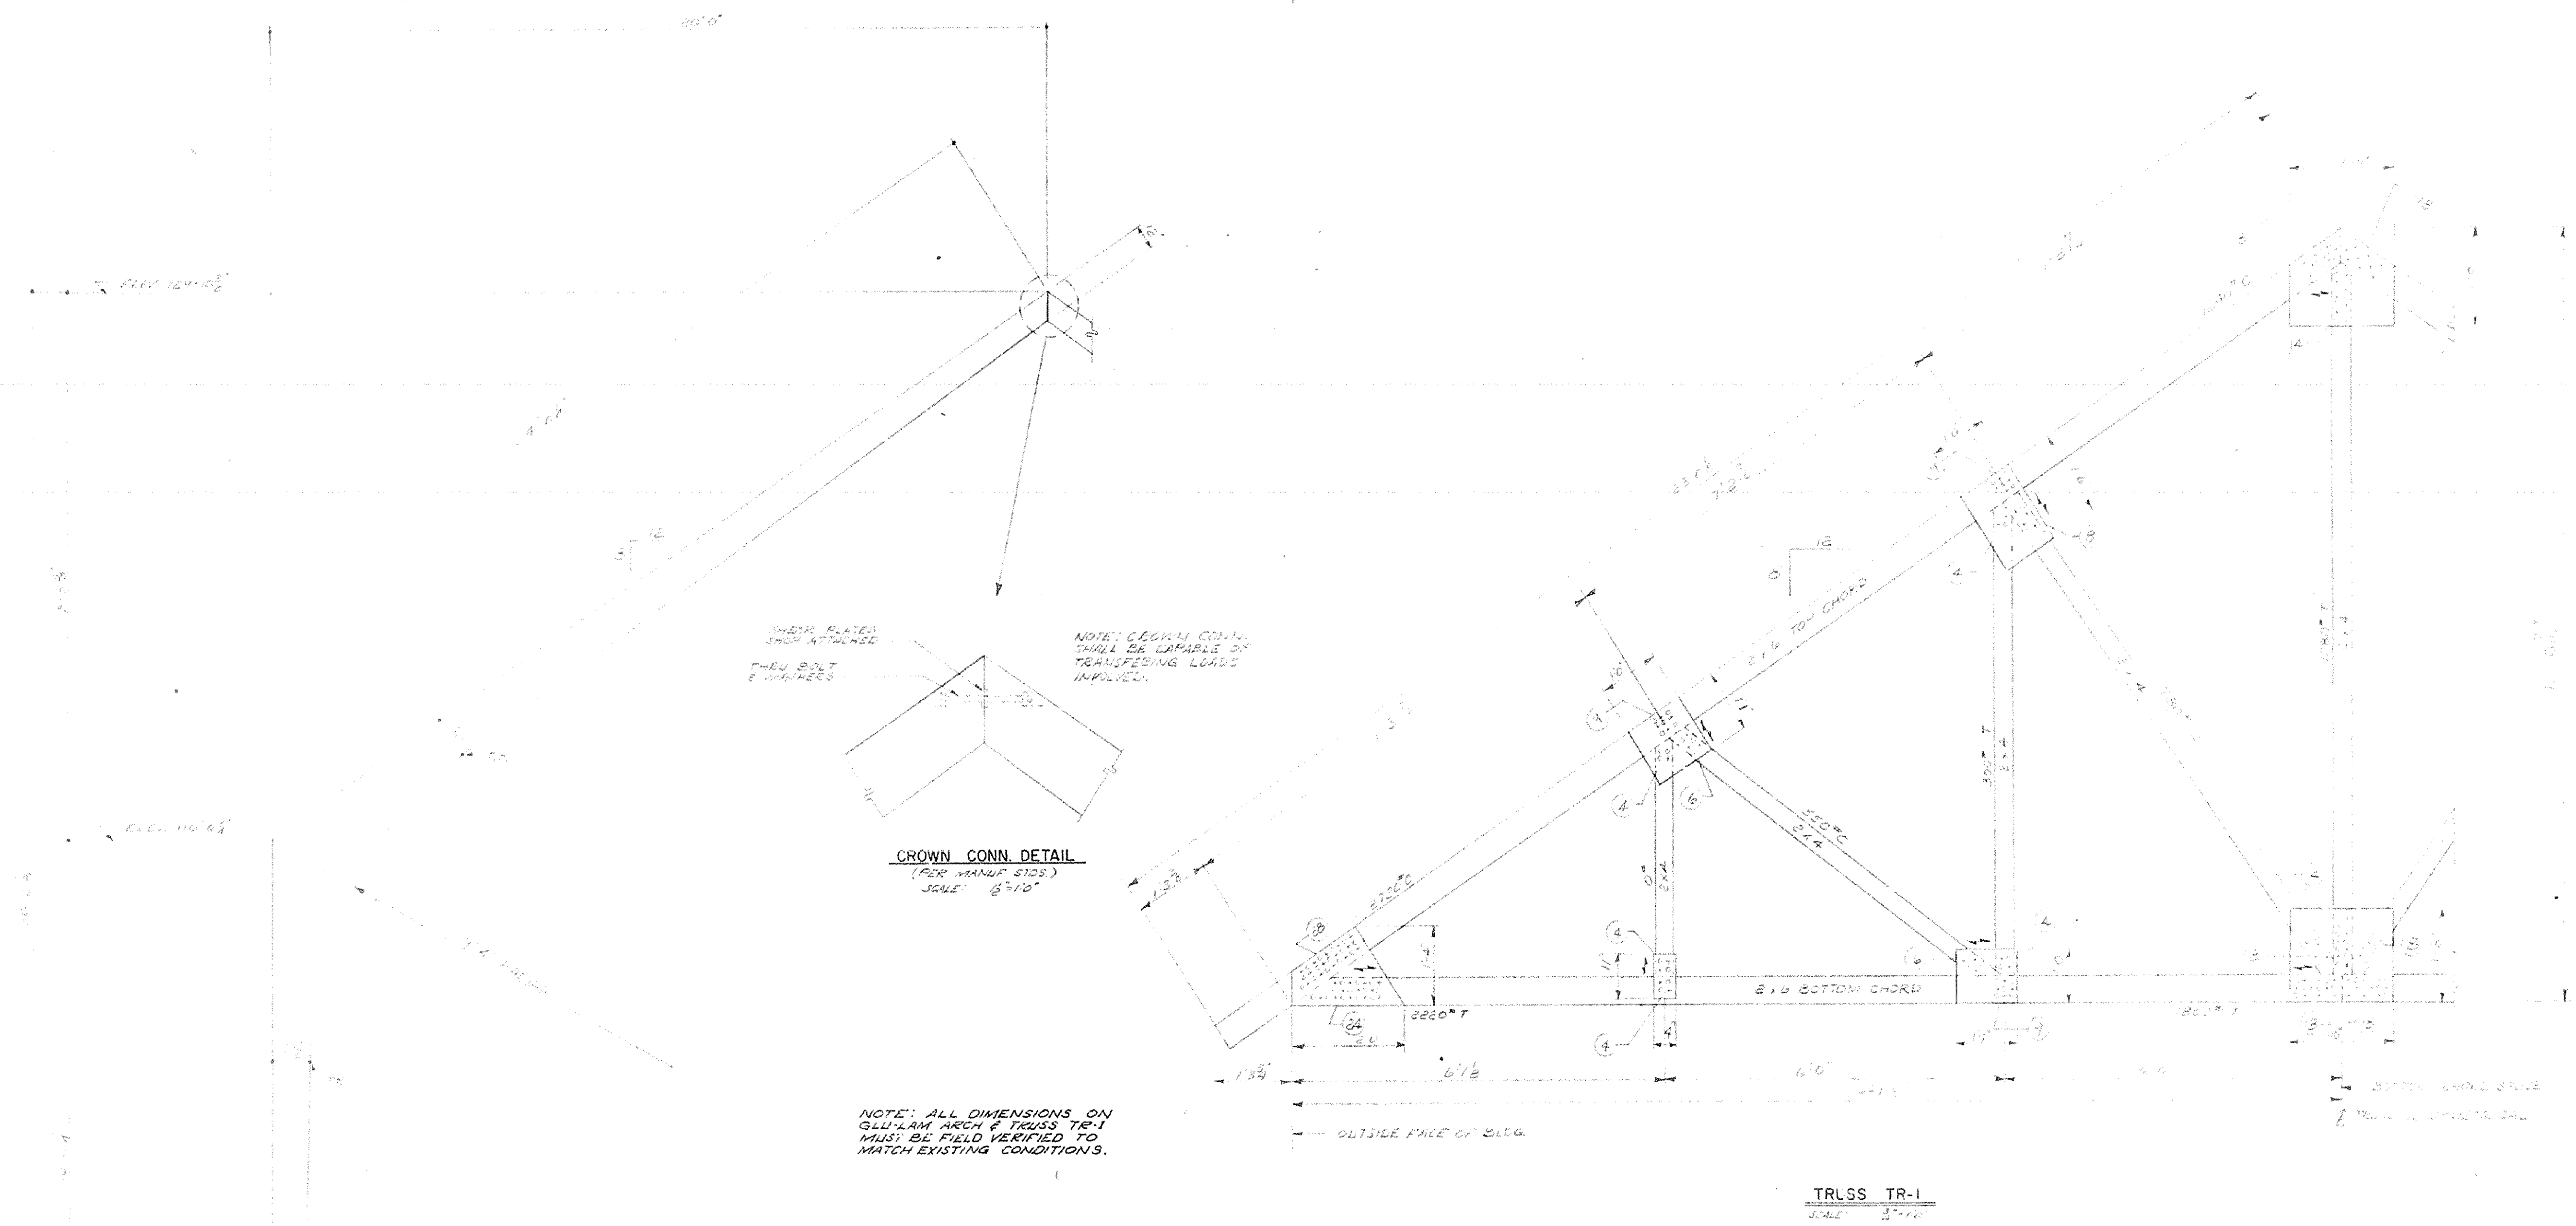


- TRUSS NOTES**
- All gusset plates to be 2" exterior type plywood both sides of truss.
  - Number in circle is total number of 5d common galvanized nails required into each truss member. Drive 2 of nails from each side of truss. (o) nails for face side and (+) nails for opposite side.
  - Arrow indicates required direction of plywood face grain.
  - Use a nailing template and stagger nails to prevent splitting. If splitting occurs blunt nail ends.
  - Trusses to be adequately braced during erection. Lines of bracing to be braced to ground or existing structure at each end of line of bracing.
  - Typical nail spacing is at 3" o.c. each side of truss members.
  - Before the fabrication of these trusses the Contractor shall verify all dimensions shown on the detail from the existing job conditions. Any required change from the dimensions shown shall be reported to the Architect.

APPROVED  
CHECKED  
DRAWN

SECTION & REVISIONS OF RENAISSANCE MOUNTAIN  
BY HAROLD E. COLLARD ARCHITECT  
THE CHURCH OF JESUS CHRIST OF LATTER-DAY SAINTS  
MOUNTAIN VIEW, IDAHO


HAROLD E. COLLARD  
ARCHITECT  
A.I.A.  
TOSHO FALLS, IDAHO

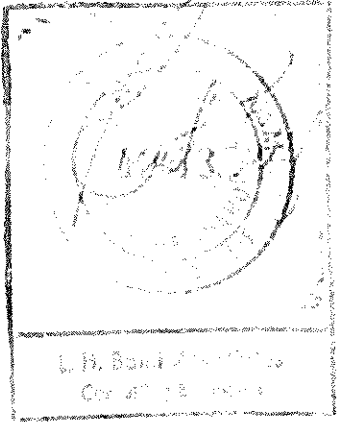














SHEET NUMBER  
S-5 OF 7

136084

PROJECT NUMBER

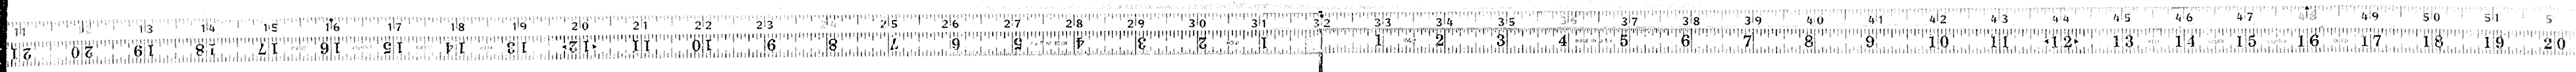




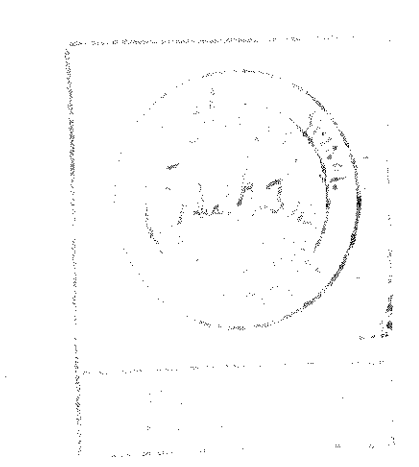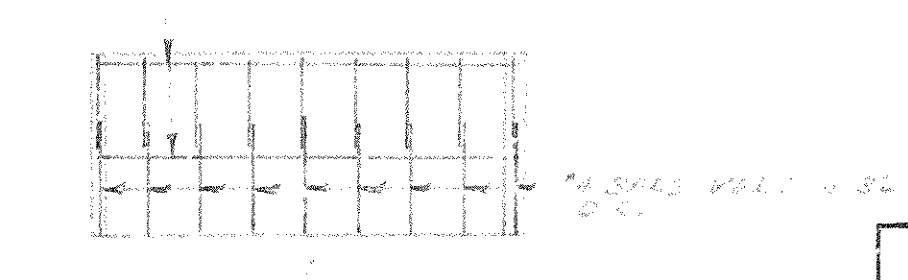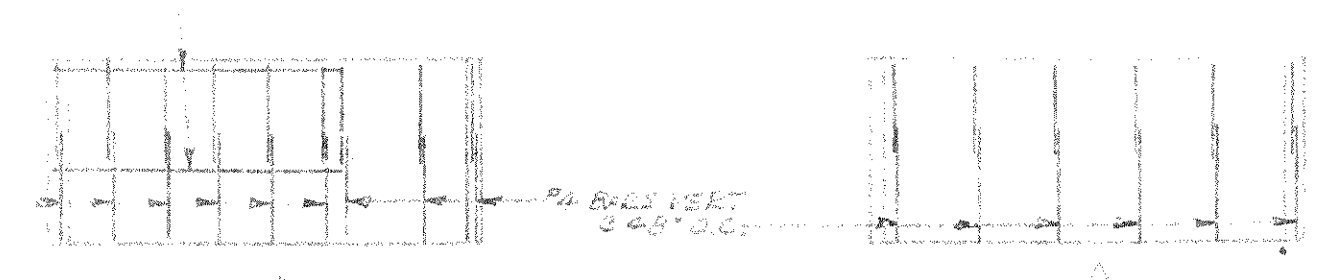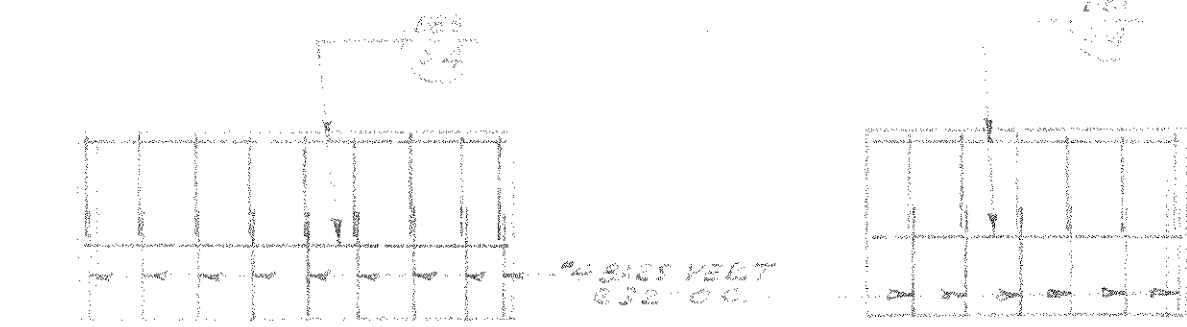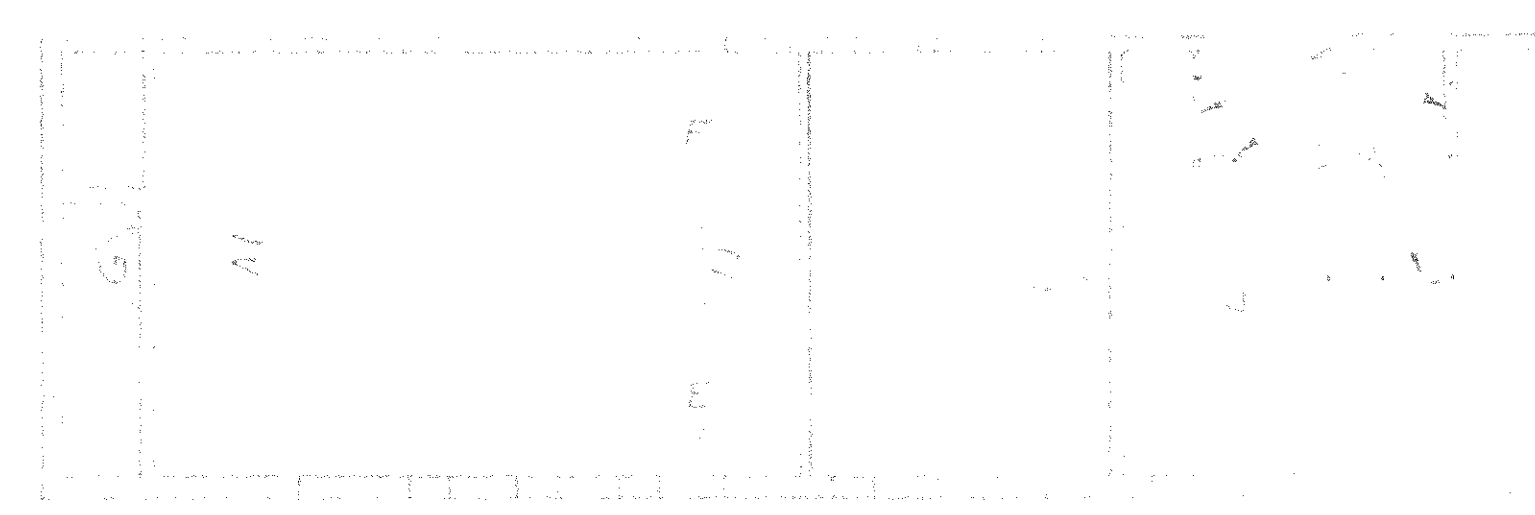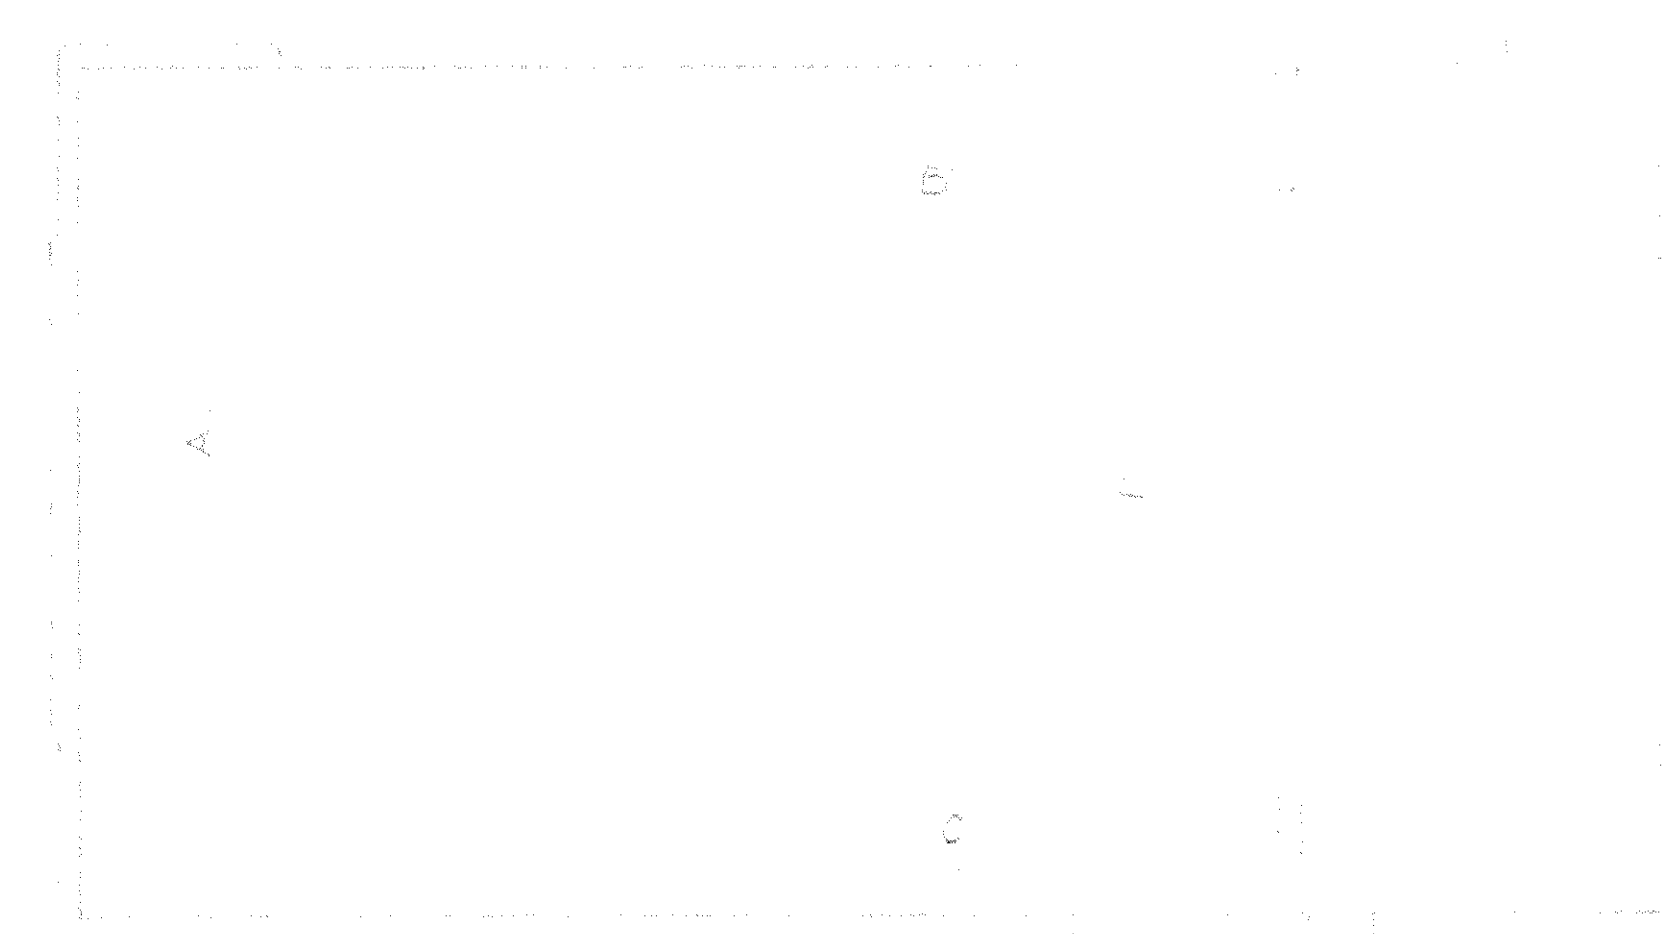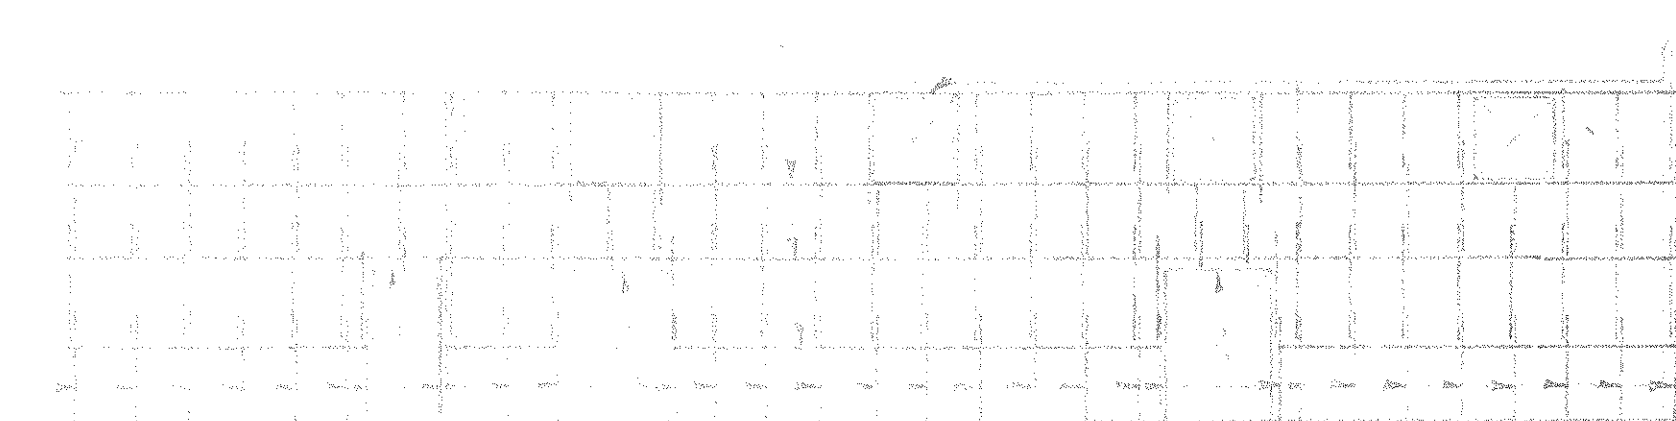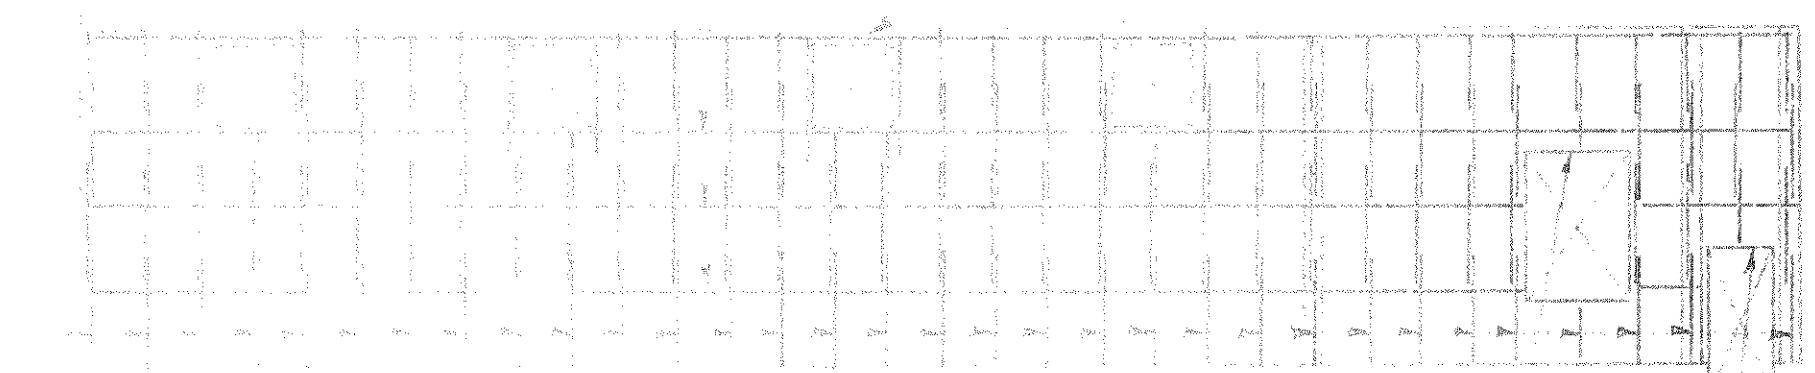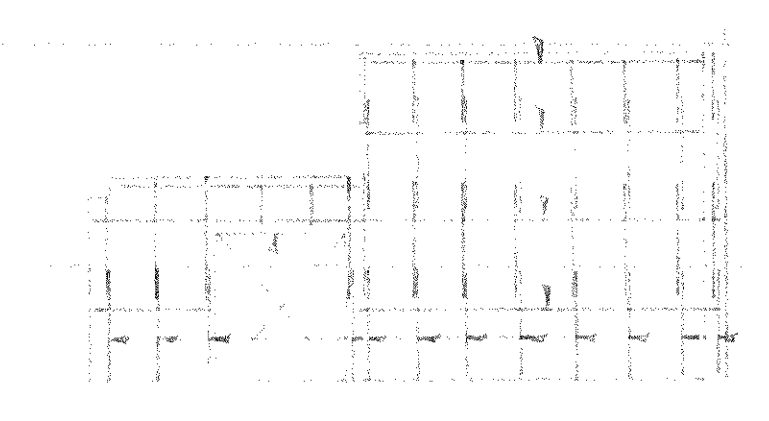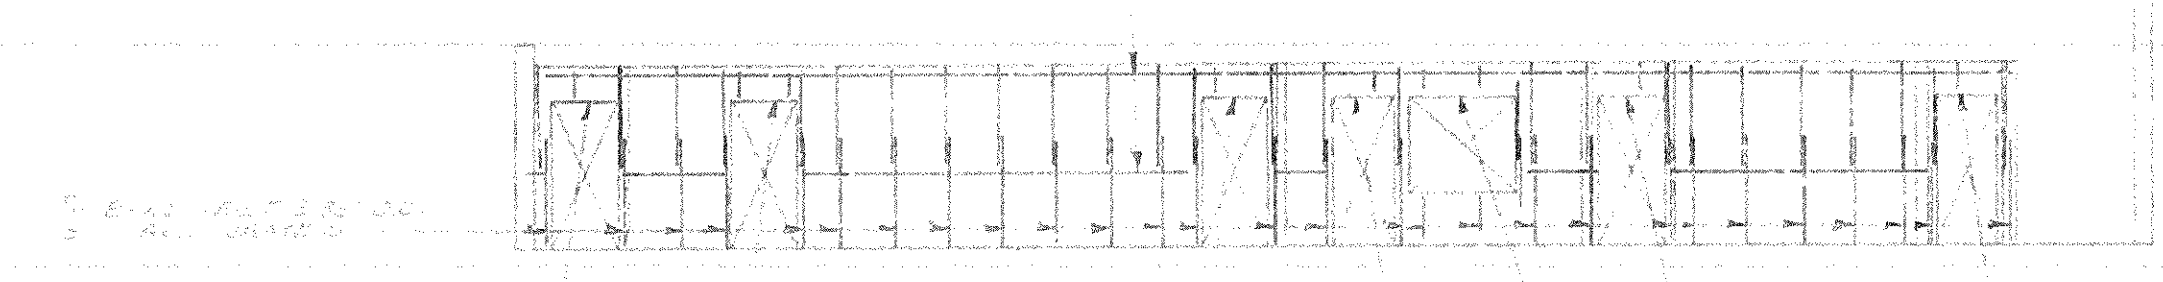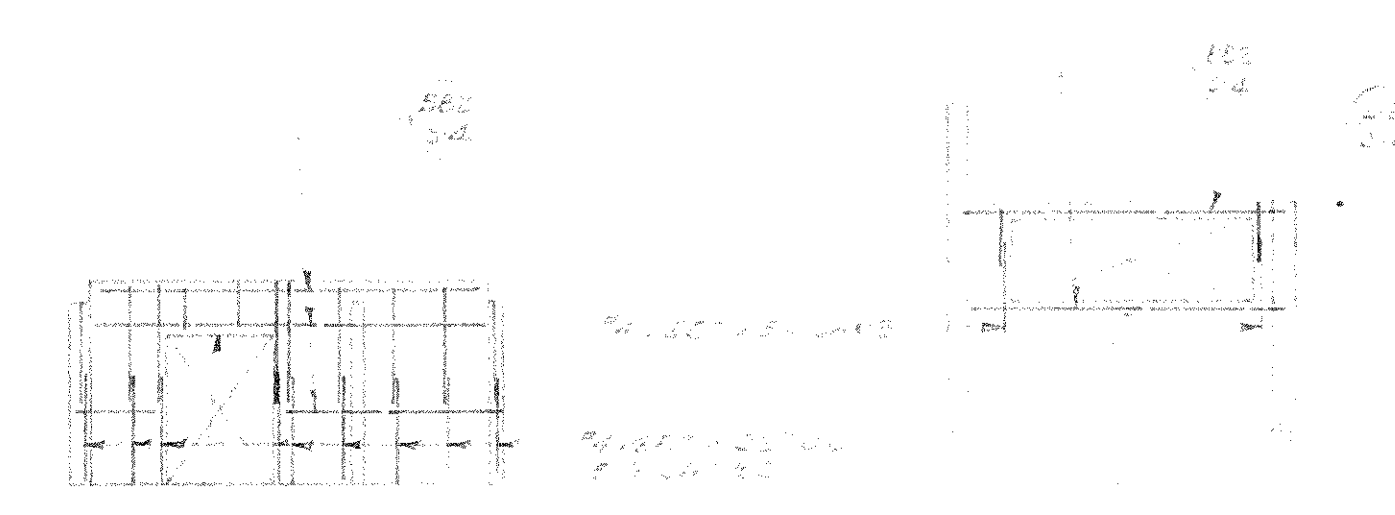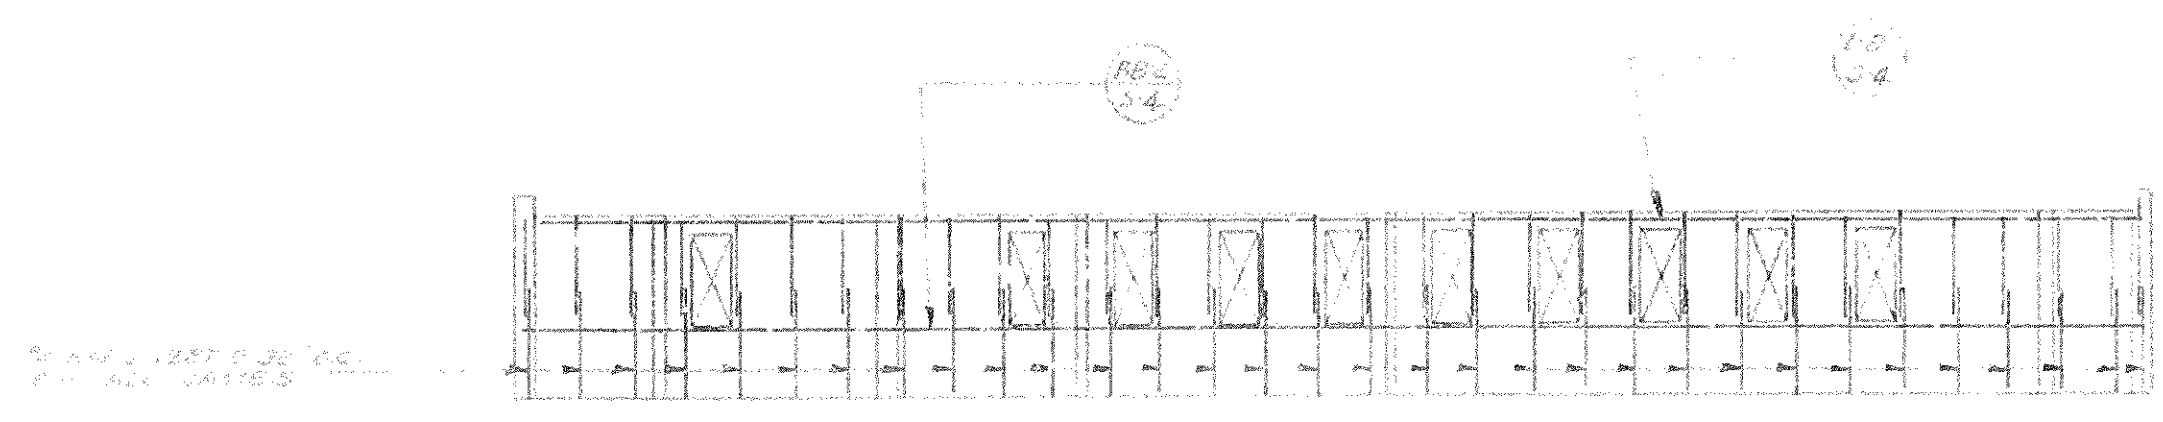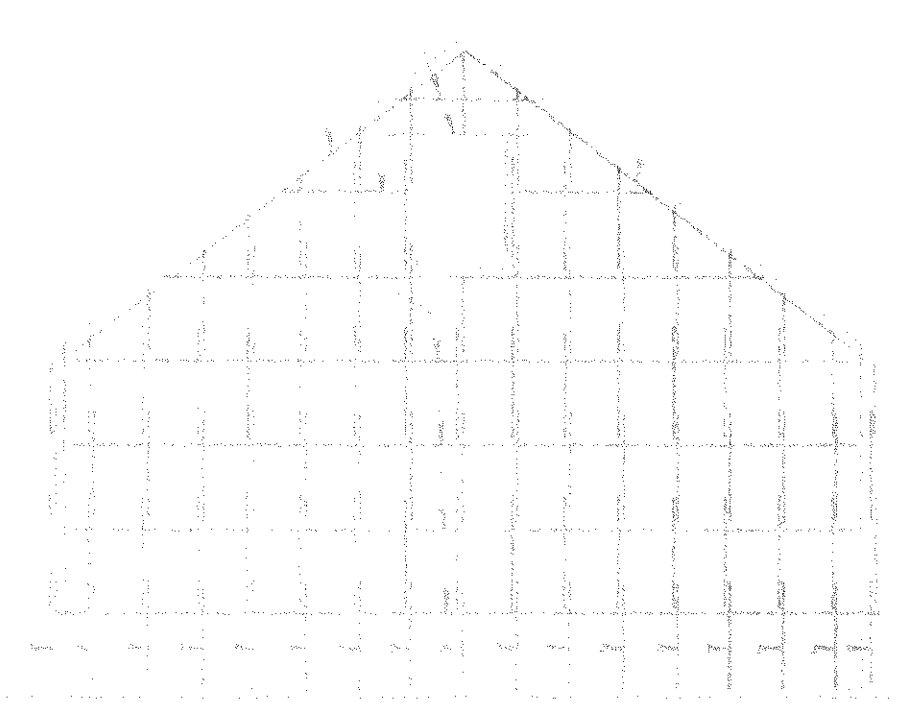


HAROLD E. COLLARD  
 ARCHITECT  
 A.I.A.  
 IDAHO FALLS,  
 IDAHO

SHEET NUMBER  
 S-6 of 7

PROJECT NUMBER  
 136CS5





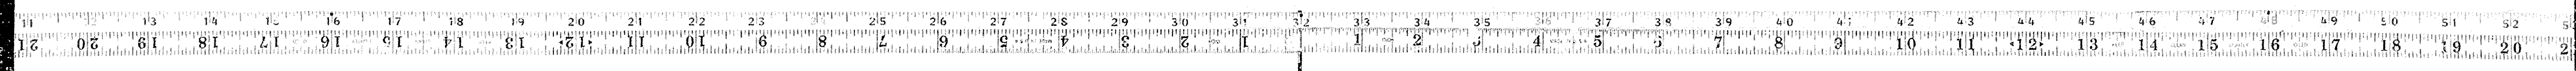


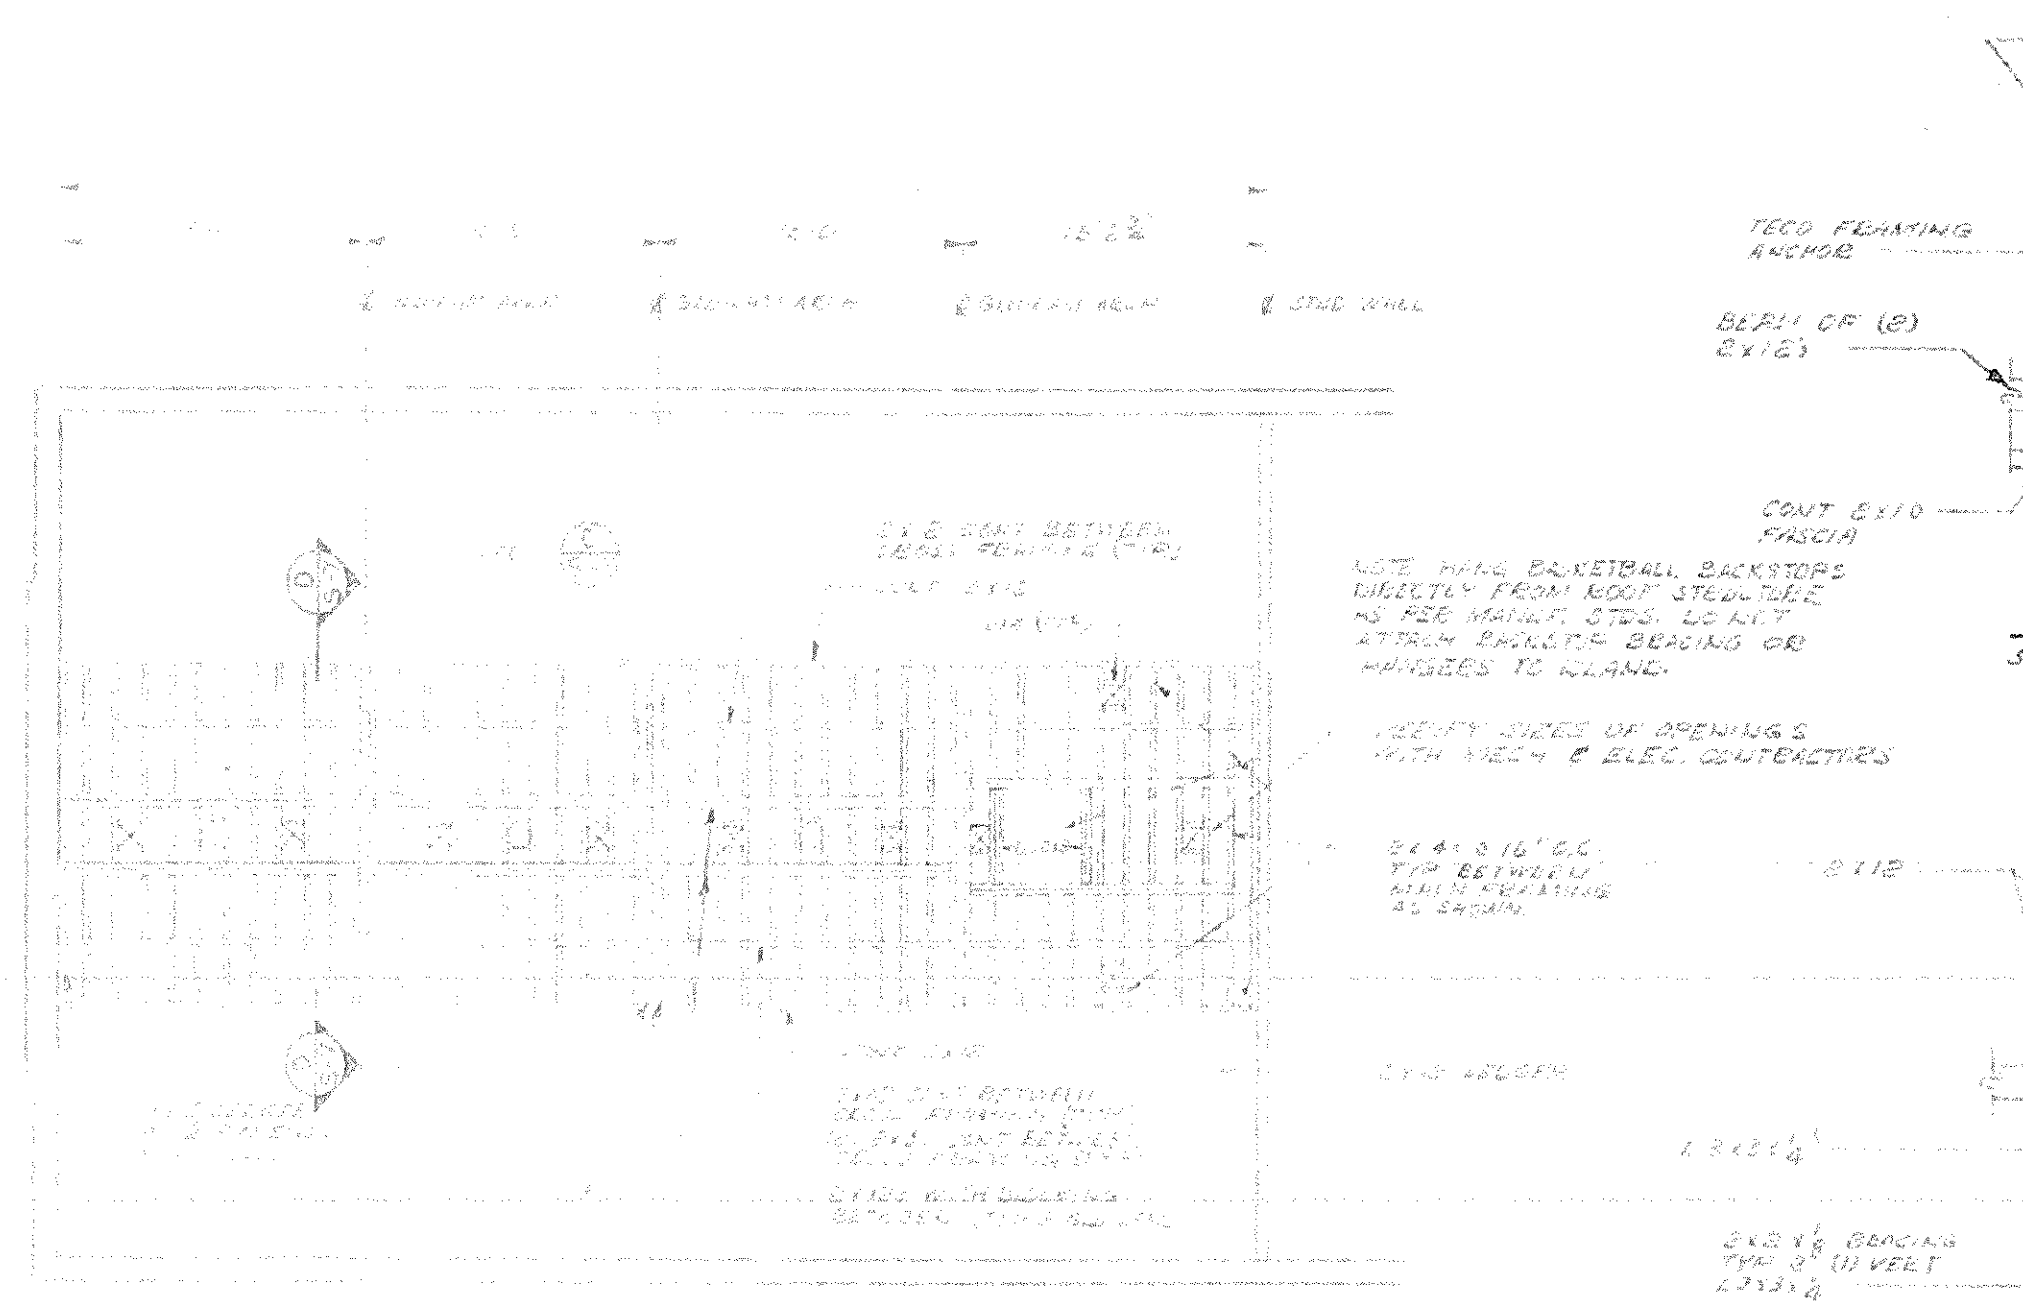

**NOTES REGARDING NEW OPENINGS IN EXISTING WALLS**

1. WHERE INDICATED BY DIMENSIONS AND NOTES, ALL NEW OPENINGS SHALL BE LOCATED AND SIZED TO MAINTAIN THE ORIGINAL STRENGTH OF THE WALLS. ALL NEW OPENINGS SHALL BE REINFORCED TO MAINTAIN THE ORIGINAL STRENGTH OF THE WALLS.
2. REINFORCEMENT SHALL BE PROVIDED TO MAINTAIN THE ORIGINAL STRENGTH OF THE WALLS.
3. SEE NOTES ON SHEET S-7 FOR DETAILS OF NEW OPENINGS IN EXISTING WALLS.
4. SEE NOTES ON SHEET S-7 FOR DETAILS OF NEW OPENINGS IN EXISTING WALLS.

**SUSPENDED CEILING FRAMING PLAN AT CULTURAL HALL**

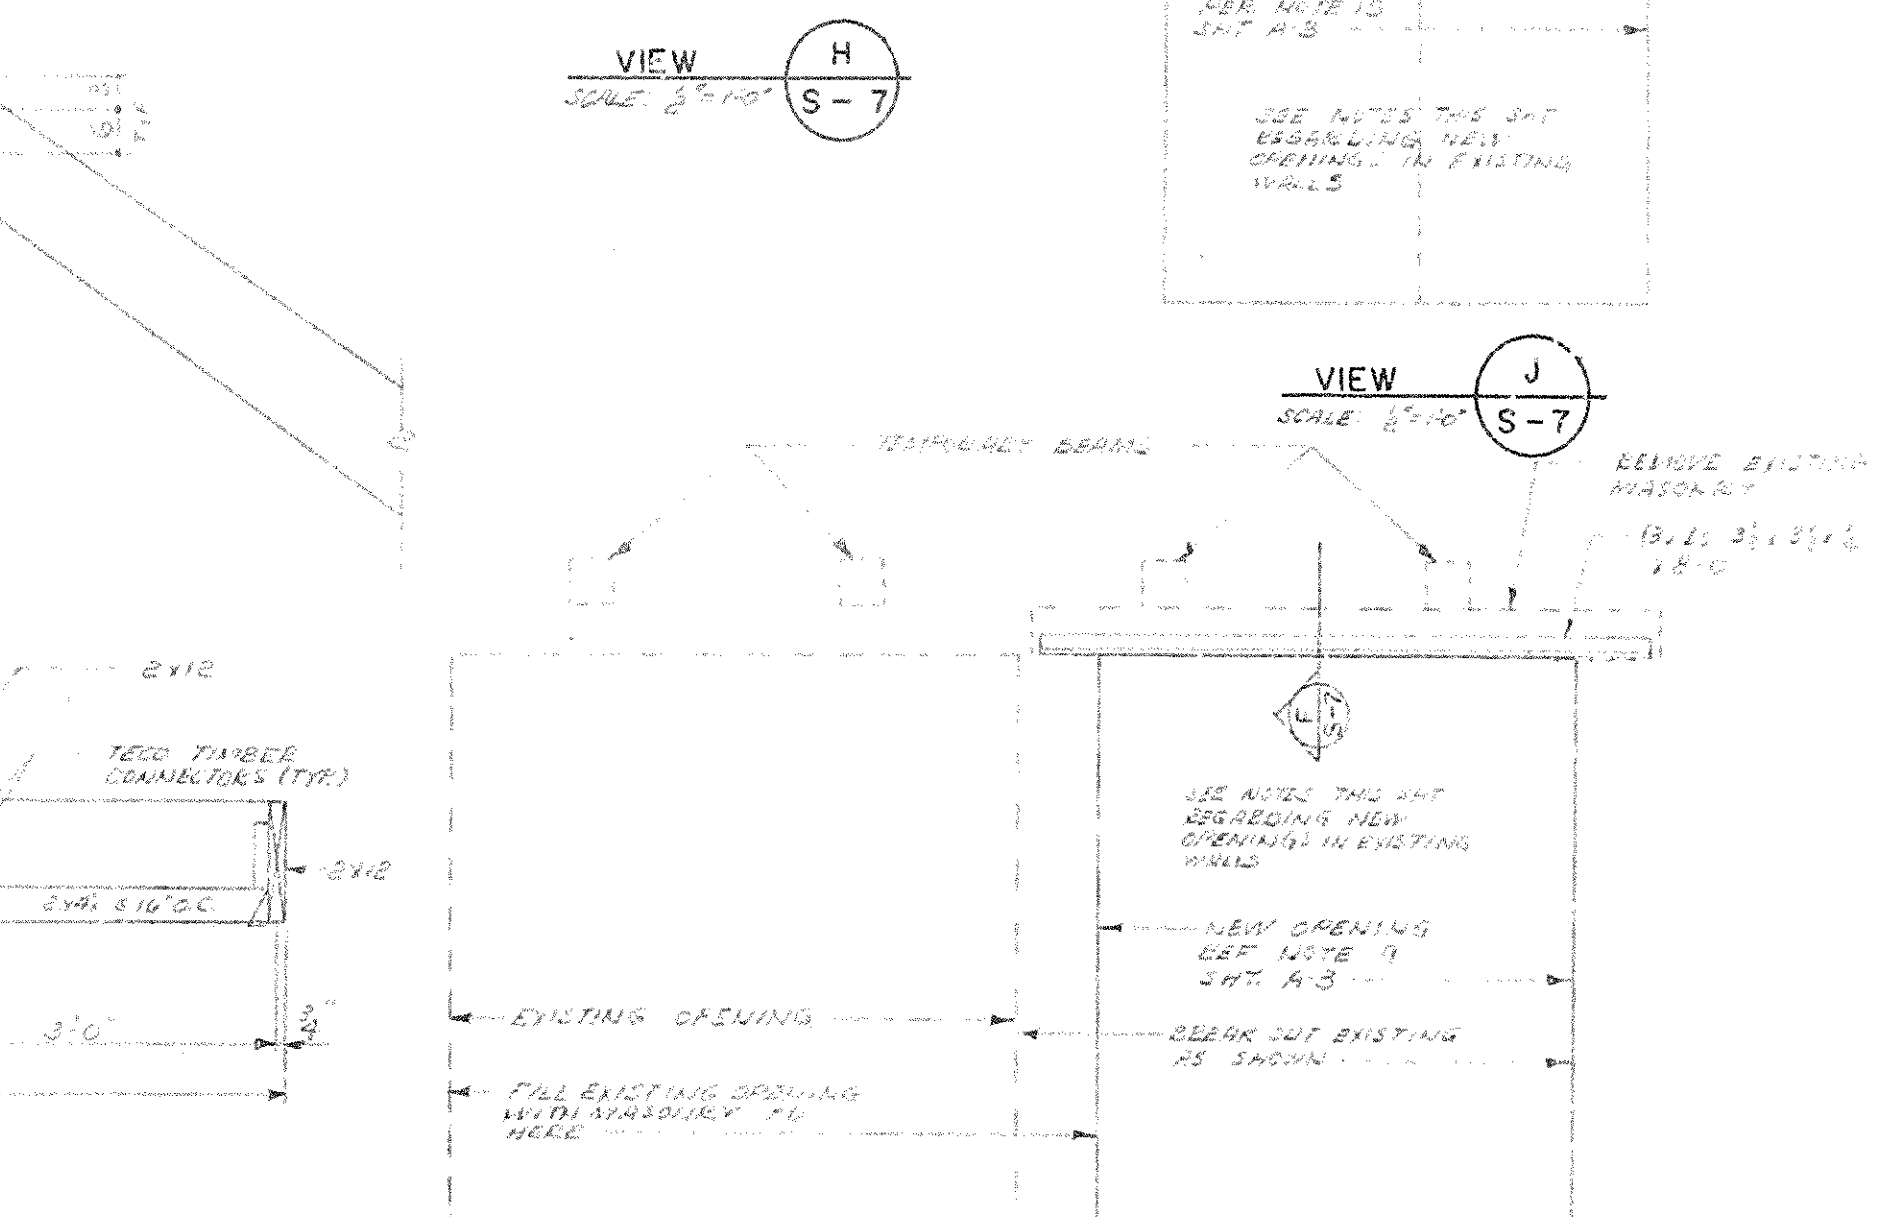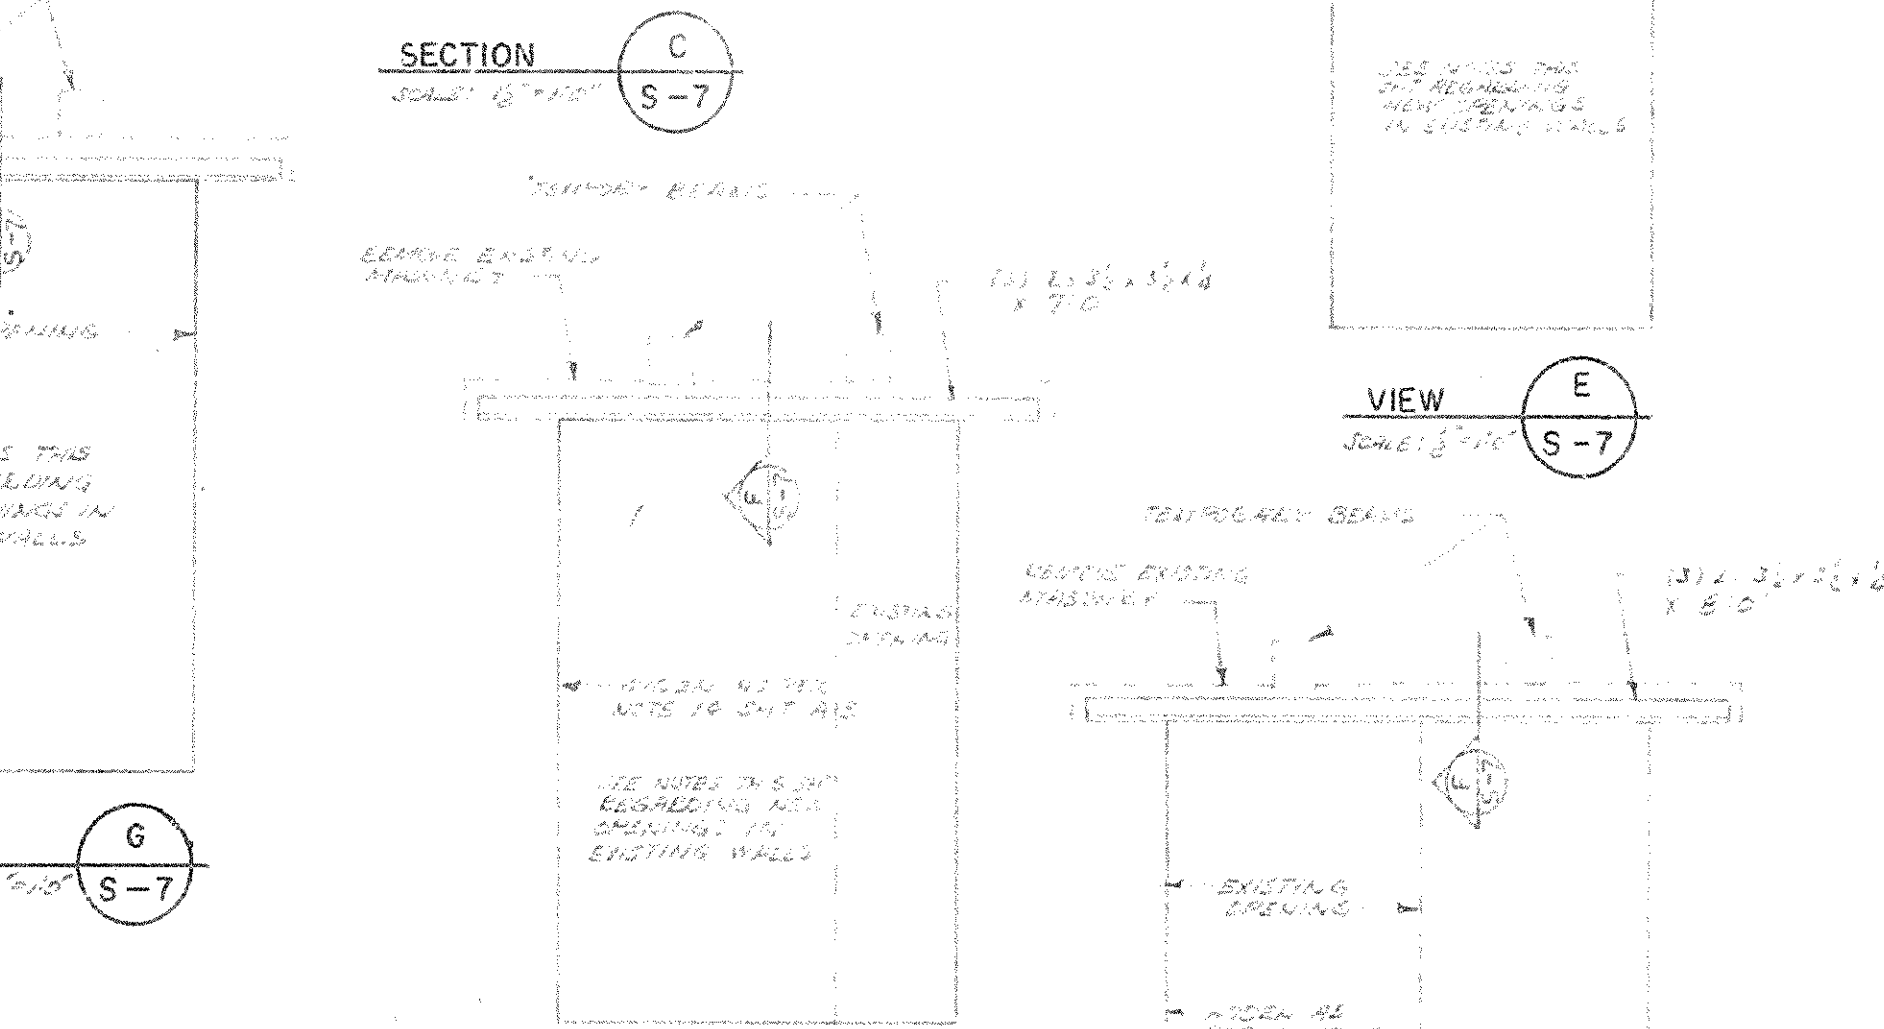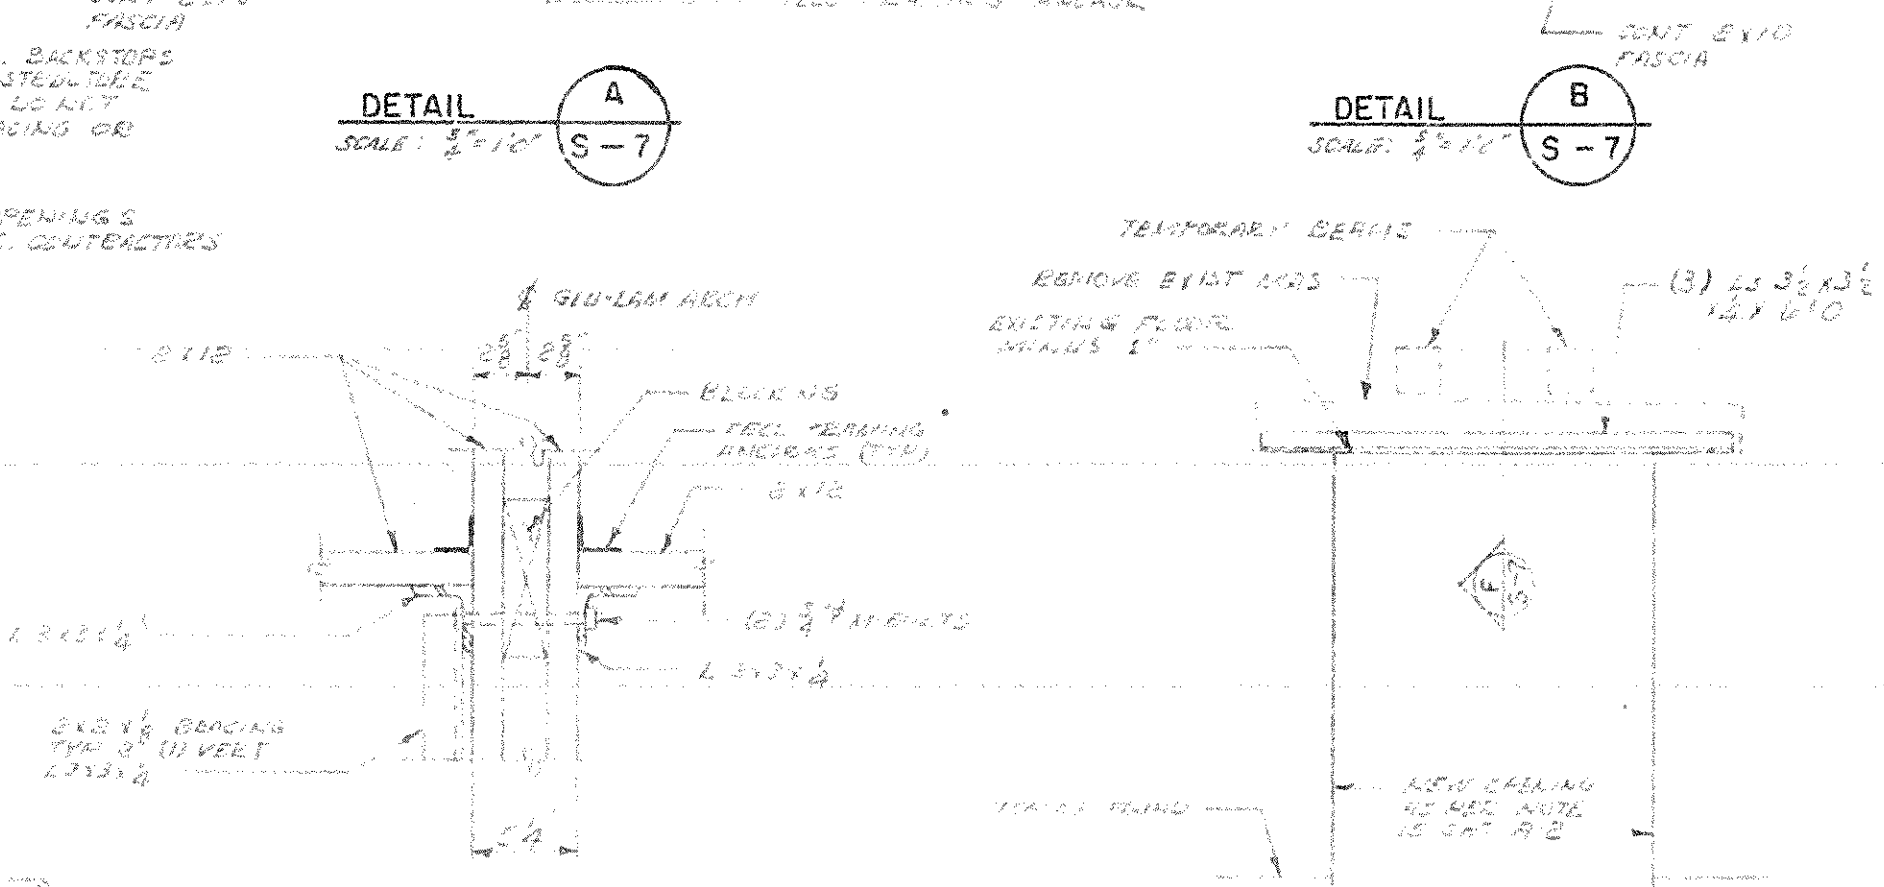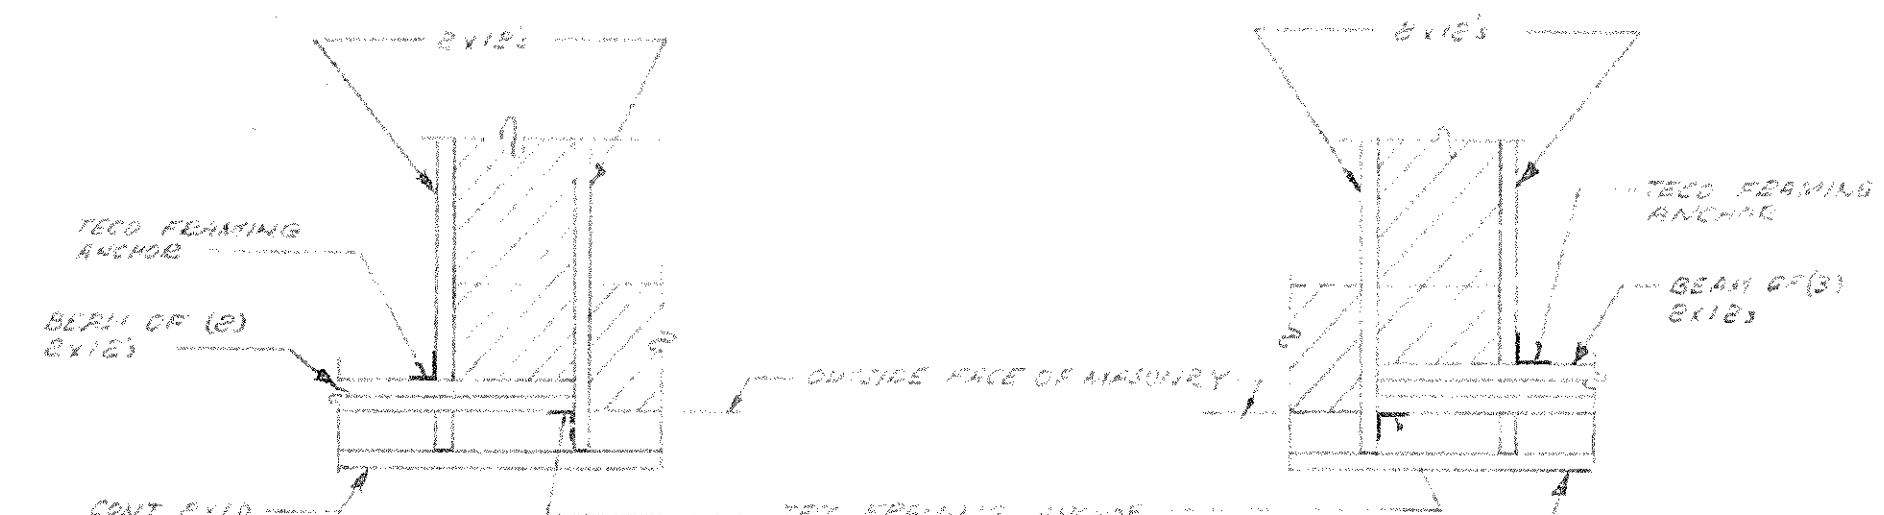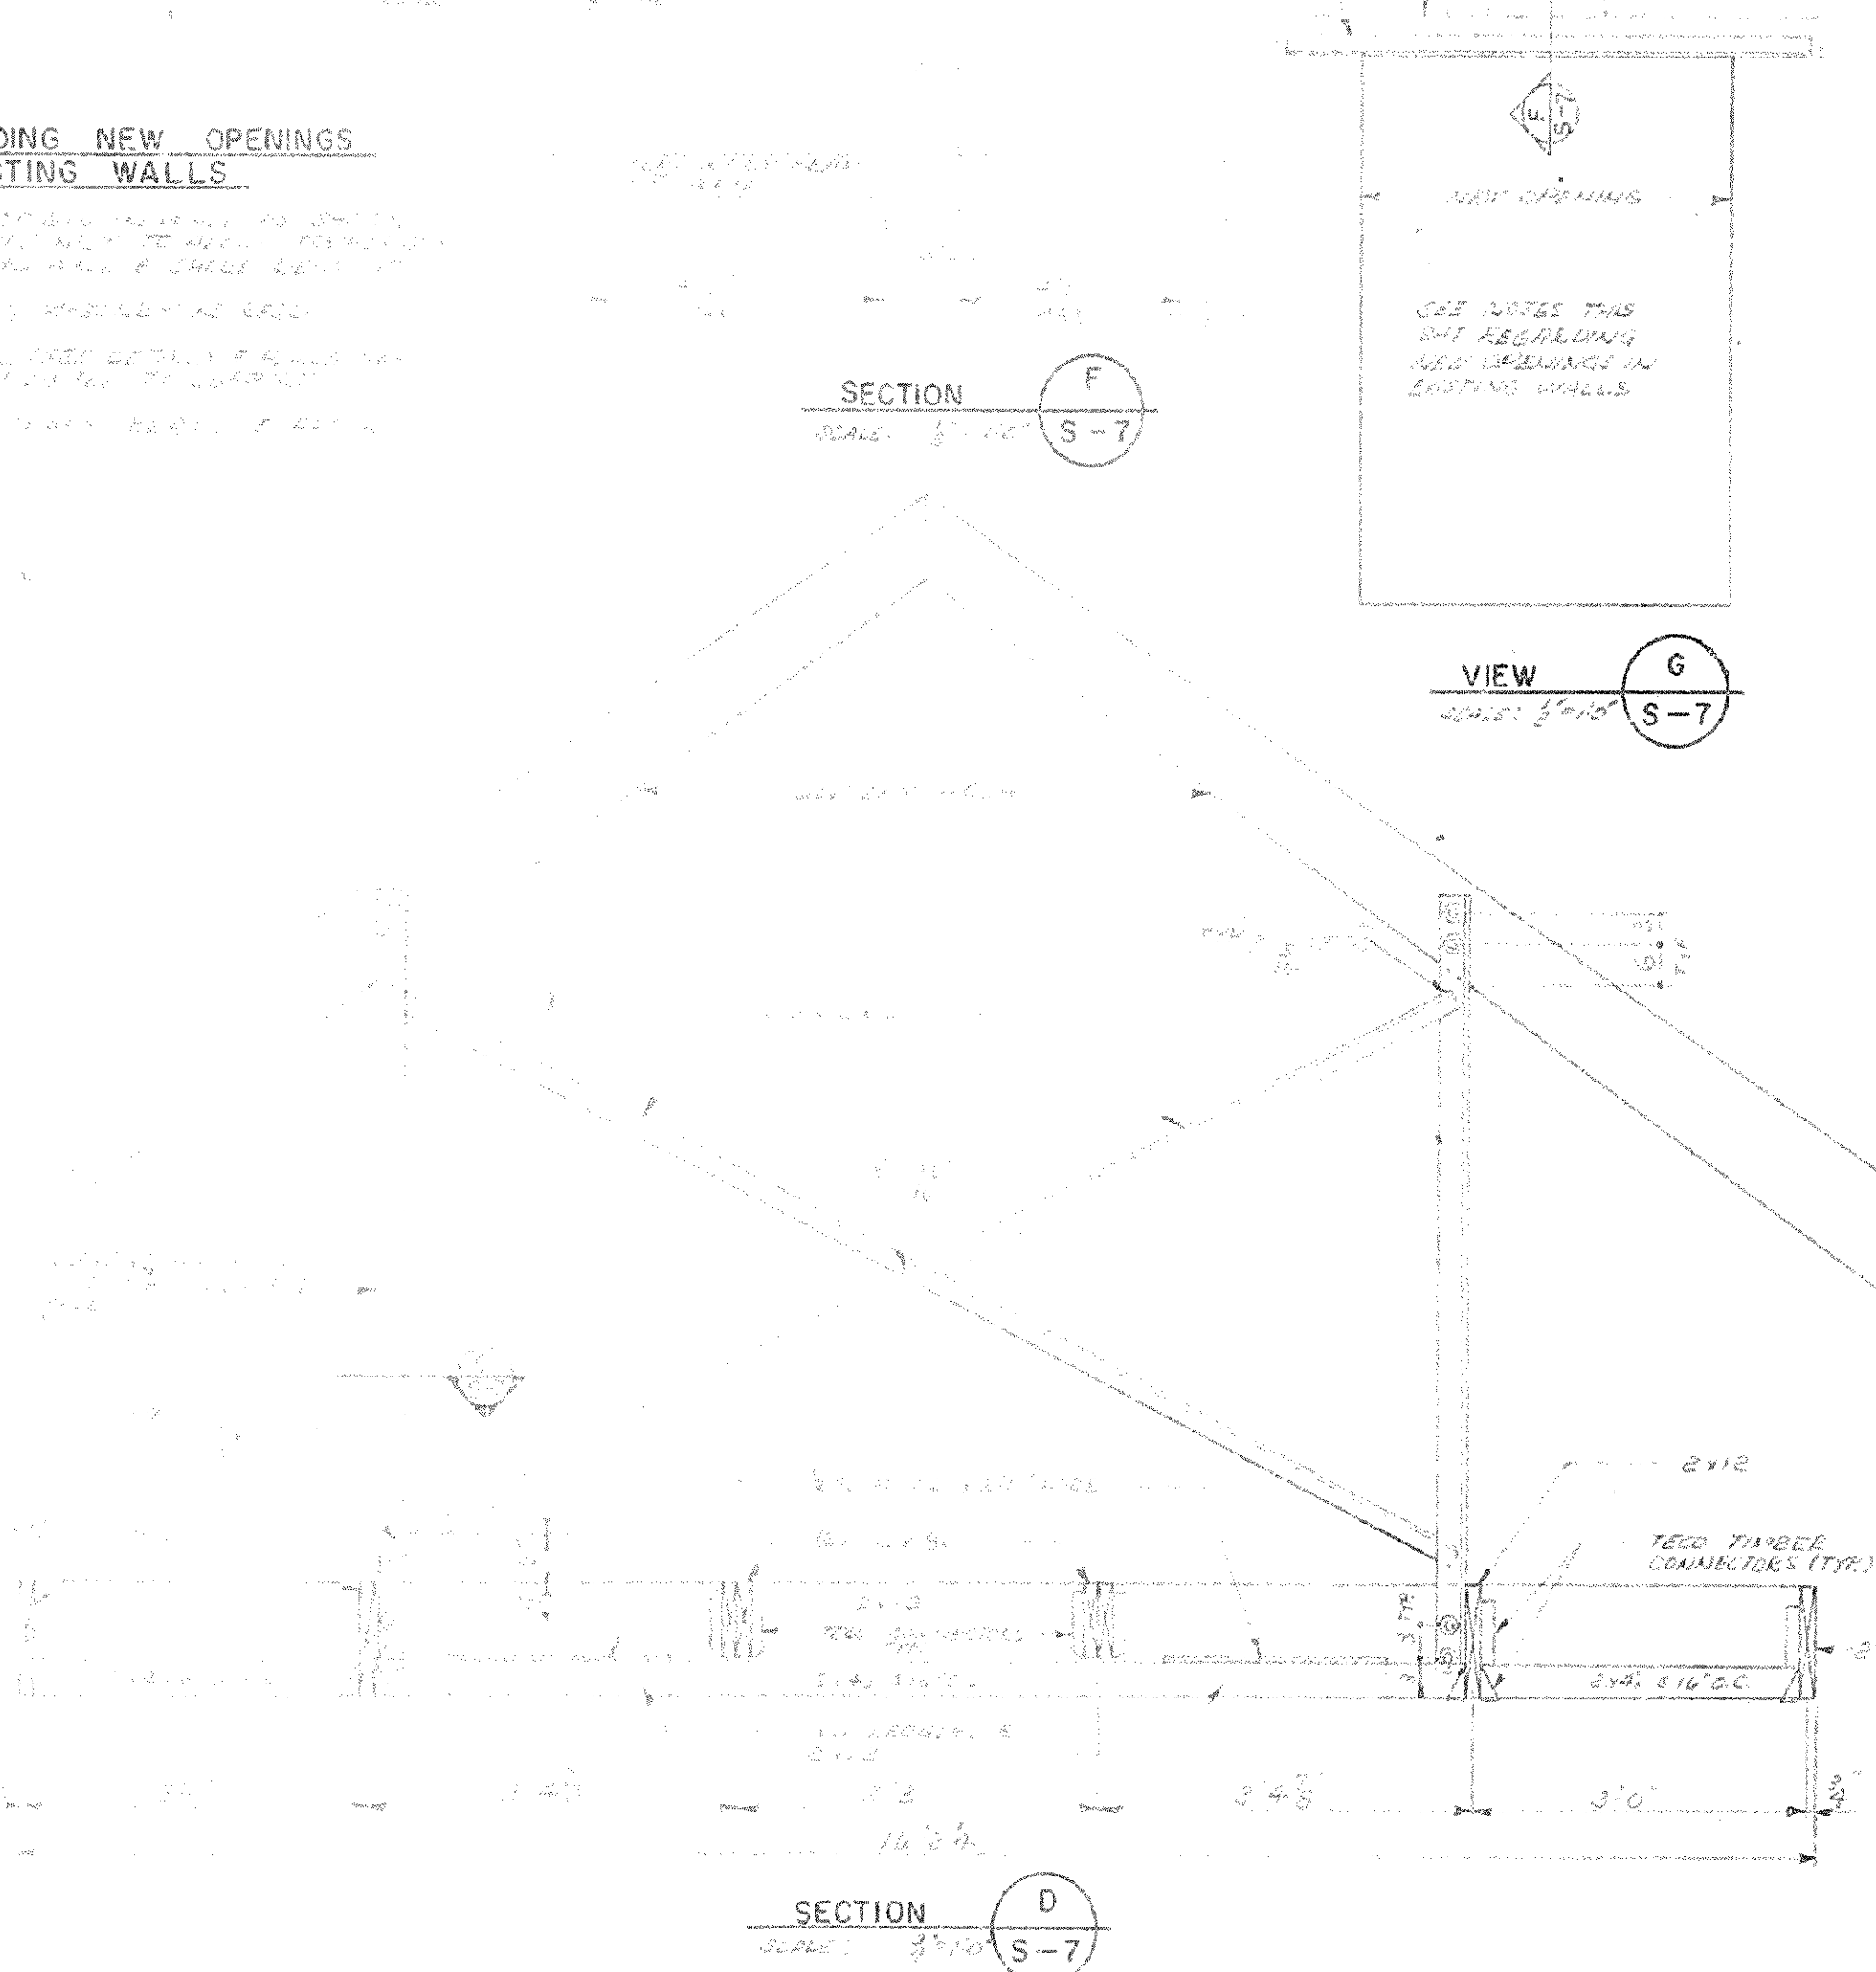

- GENERAL CONTRACTING NOTES**
- Footings:**
1. All footings shall bear 12" into undisturbed earth or on an engineer compacted fill.
  2. Footing shall slope at a 1" to 2" ratio as required.
  3. Exterior wall footings shall bear at a minimum depth of 24" for frost or weather protection.
- Concrete:**
4. All concrete shall have a "minimum" strength of 3000 psi at 28 days.
  5. All concrete shall be air entrained.
  6. All concrete shall be placed, cured and protected as directed by specifications and for A.C.I. Standards and Practices.
  7. Type 1 concrete (3000 psi at 28 days) shall be used for footings, foundations and walls and interior slabs.
  8. Type 2 concrete (4000 psi at 28 days) shall be used for stairs, iron standing curbs, interior walks and curbs and exterior slabs.
- Reinforcement Steel:**
9. All rebar shall comply to ASTM A-615-68 Grade 60. All welded wire fabric shall conform to ASTM A-185.
  10. All rebar shall be securely tied and held in place with a minimum concrete protection cover to all steel as follows:  
 Slabs and Columns - 1 1/2" Min; Wall - 3/4" Min.
  11. All reinforcement shall be detailed and placed according to A.C.I. Standards 318-63 and A.C.I. Detailing Manual 319-63.
  12. All continuous reinforcement shall terminate with 30 degree return (or hook) or a separate corner bar. All splices shall lap to diameter or 1/4" minimum and occur in "zone of development".
- Concrete Walls or Columns:**
13. All vertical reinforcement in columns or walls shall be doweled from the footing or structure below with rebar of the same size and spacing as required above. Provide at diameter lap splices, 12" minimum.
  14. Provide a minimum 2" x 4" x continuous leveled key stop footings at walls.
  15. Unless detailed otherwise provide extra reinforcement around openings in concrete walls: Rebar: 1 # 3 x width = 3'-0" for each 3' width of wall; Splice and stirrups: 1 # 3 x width = 3'-0" as permitted.
- General Concrete:**
16. No aluminum products shall be embedded in concrete.
  17. All construction joints shall be located so as not to impair the strength of the structure. Unless noted on drawings, all reinforcement shall be continuous through joints. Each joint shall be capped.
  18. Provide a 1/2" continuous bonding bar in all slabs.
  19. Unless specified otherwise, provide the following reinforcement in foundation walls:  
 6" walls - 1 # 3 bars, 1 # 3 bottom rebar.  
 8" walls - 2 # 3 bars, 1 top & 1 bottom rebar.  
 10" walls - 3 # 3 bars, 1 top & 2 bottom rebar.  
 In addition to continuous top and bottom reinforcement provide:  
 10" & 12" walls: Vertical #2 bars @ 24" o.c. staggered each way.  
 Horizontal #2 bars @ 24" o.c. with face between continuous top and bottom steel at height of wall will vary.  
 8" walls: Use same as 10" walls, except #2 bars.  
 6" walls: 1 # 3 bar @ 24" o.c. each way as permitted.
- Structural Steel:**
20. All structural steel shall conform with ASTM A-36 standards and be painted with AIA-100 paint or steel "construction" containing the equivalent for the above. All steel shall be of a minimum of structural steel buildings, and the "Code of Standard Practices" for steel buildings.
  21. Prior to fabrication and placement, shop drawings shall be prepared and approved by the Contract Architect.
- Lumber:**
22. All structural framing lumber shall be construction grade, all wood shall be clearly marked as such by approved stamp. The minimum design stress shall be 1000 psi in compression parallel to grain, and 1500 psi extreme fiber stress in bending.
  23. Solid 2" blocking shall be provided at ends or points of support of all wood joists. When trailing of not less than 1" x 3" material shall be placed in rows between support points, not extending 8'-0" apart.
  24. Wood joists bearing on masonry walls or steel beams shall be secured by metal joist anchors at 4'-0" on center unless closer spacing is specified.
- Roofing:**
25. 5/8" plywood deck with 1/2" copper flashing shall be provided on high roof, 1/2" all edges on low roof, and 1/2" on all at all intermediate roof levels.
  26. Flashing to masonry - (1) 1/2" lead nails per batten.
  27. See schedule for acceptable substitutions for roofing and metal fasteners.
- Hollow Block Masonry:**
28. All cells with reinforcement shall be grout full. Cells shall align to preserve an unobstructed vertical cavity 2" x 3" minimum.
  29. Lap splices shall be 40 diameter and all wire shall be in place prior to grouting. Grout in lifts not to exceed 2'-0". All vertical face shall be doweled from the foundation or structure below.
  30. All hollow block masonry walls shall be reinforced as follows, unless otherwise specified:  
 All exterior and bearing partitions:  
 6" & 8" Block Walls:  
 Vertical: One #2 steel bar at each of all openings, corners and at 48" o.c. elsewhere.  
 Horizontal: Four bars block unit at top of wall and at 48" vertically, reinforced with one #2 bar continuous.  
 10" Block Walls: Same as 8" walls except use #3 bars.  
 12" Block Walls: Same as 10" walls except space vertical face at 12" o.c. and two bars in each horizontal bond beam unit.  
 Non-bearing Partitions: 6" and larger block units.  
 Vertical: Reinforce joints of all openings and at 48" o.c. maximum with one #2 bar.  
 Horizontal: Single bond beam block unit at top of wall and at 48" o.c. reinforced with one #2 bar.  
 Concrete Masonry Walls:  
 Use 1/2" o.c. metal mesh, (1/2") ties @ 12" o.c. each way. Finish mortar over tie.  
 Single Course Masonry:  
 No horizontal diaphragm or equal at 16' o.c. vertically in full bed of mortar. Maximum length without support 12'-0".

**APPROVED:** [Signature]

**CHECKED:** [Signature]

**DRAWN:** [Signature]


**L. H. Bahr Architects**  
Consulting Engineers

**HAROLD E. COLLARD**  
ARCHITECT  
IDAHO FALLS, IDAHO



**SHEET NUMBER**  
S-7 of 7

**PROJECT NUMBER**


**136086**

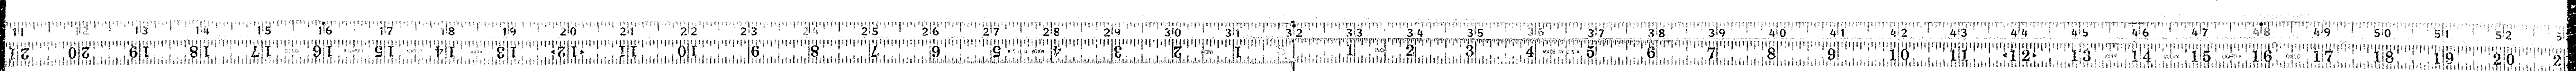



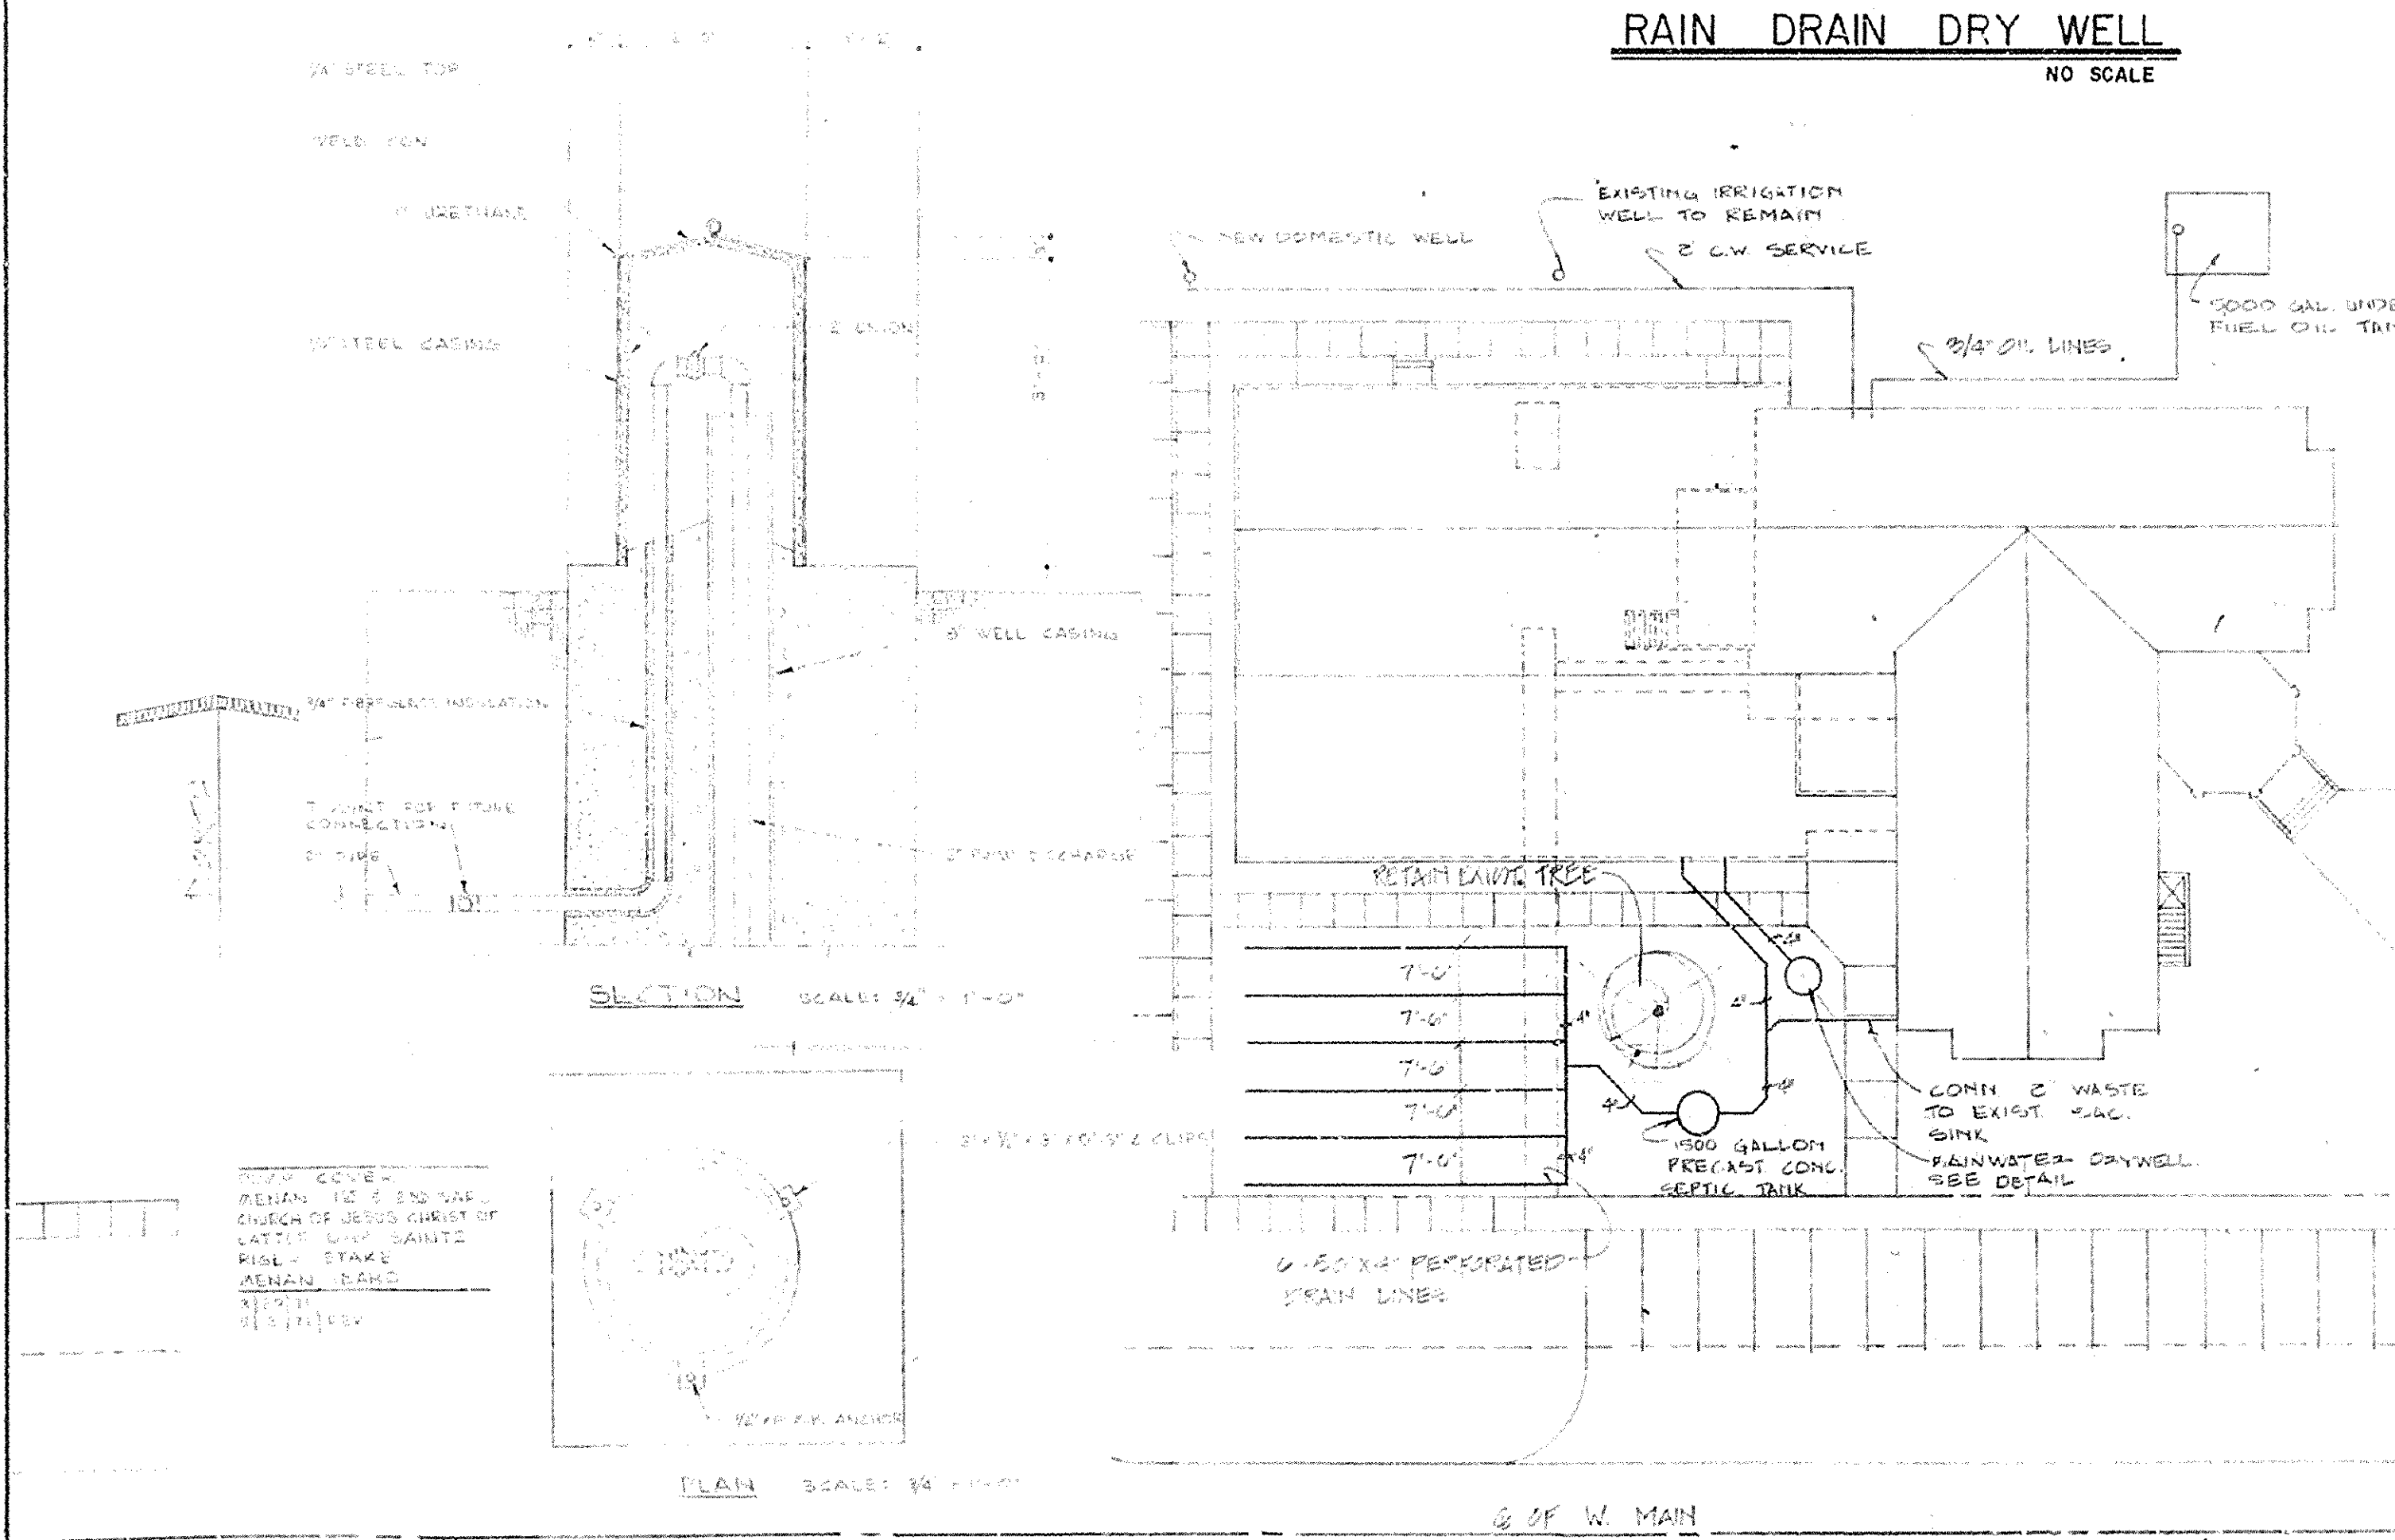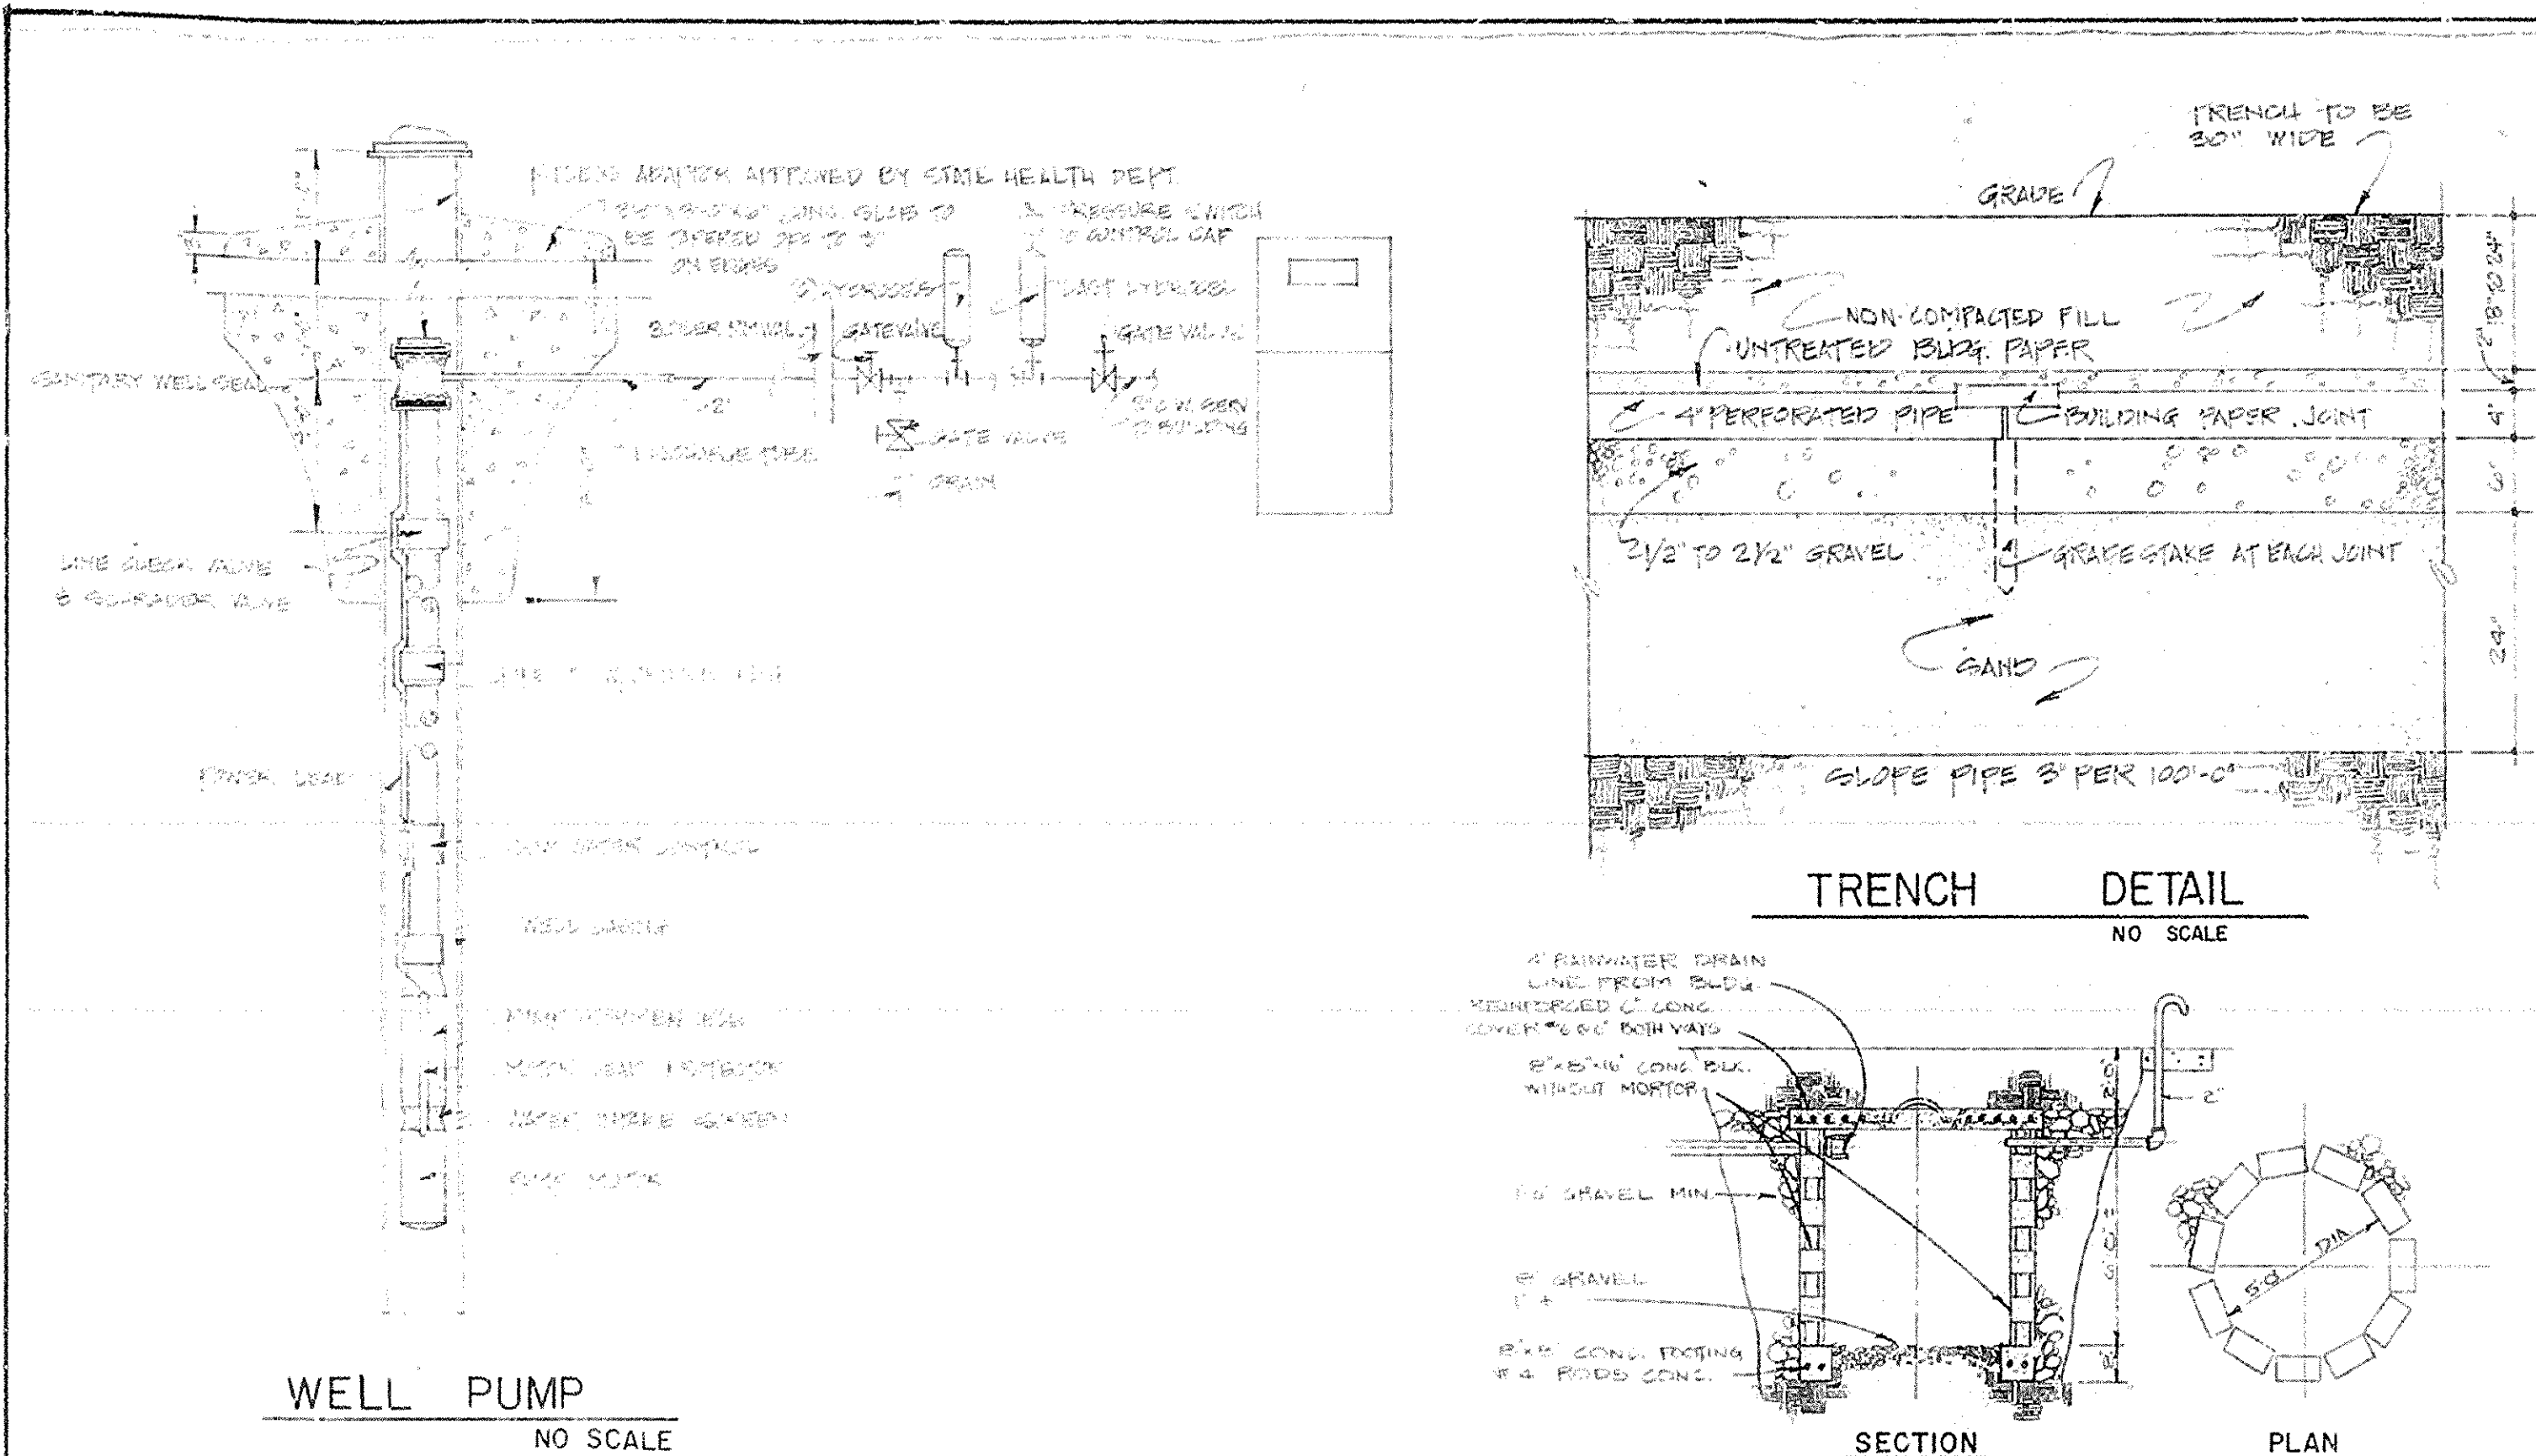

MECHANICAL LEGEND	
SYMBOL	DESCRIPTION
---	COLD WATER LINE
---	HOT WATER LINE
---	WASTE LINE
---	VENT LINE
---	HEATING SUPPLY
---	HEATING RETURN
---	FIRE LINE
---	OIL LINE
○	VENT
●	VENT THRU ROOF
□	SUPPLY DUCT
□	RETURN DUCT
CD	CEILING DIFFUSER
DL	DOOR LOUVER
RA	RETURN AIR GRILLE
RA	RETURN AIR REGISTER
FA	FRESH AIR LOUVER
EG	EXHAUST GRILLE
CA	COMBUSTION AIR LOUVER
GV	GATE VALVE
GV	GLOBE VALVE
SV	STRAINER
CV	CHECK VALVE
U	UNION
⊕	THERMOSTAT
AV	AIR VENT
⊕	THERMOMETER
⊕	PRESSURE GAGE
⊕	MOTORIZED VALVE
⊕	ECCENTRIC REDUCER
⊕	CONCENTRIC REDUCER

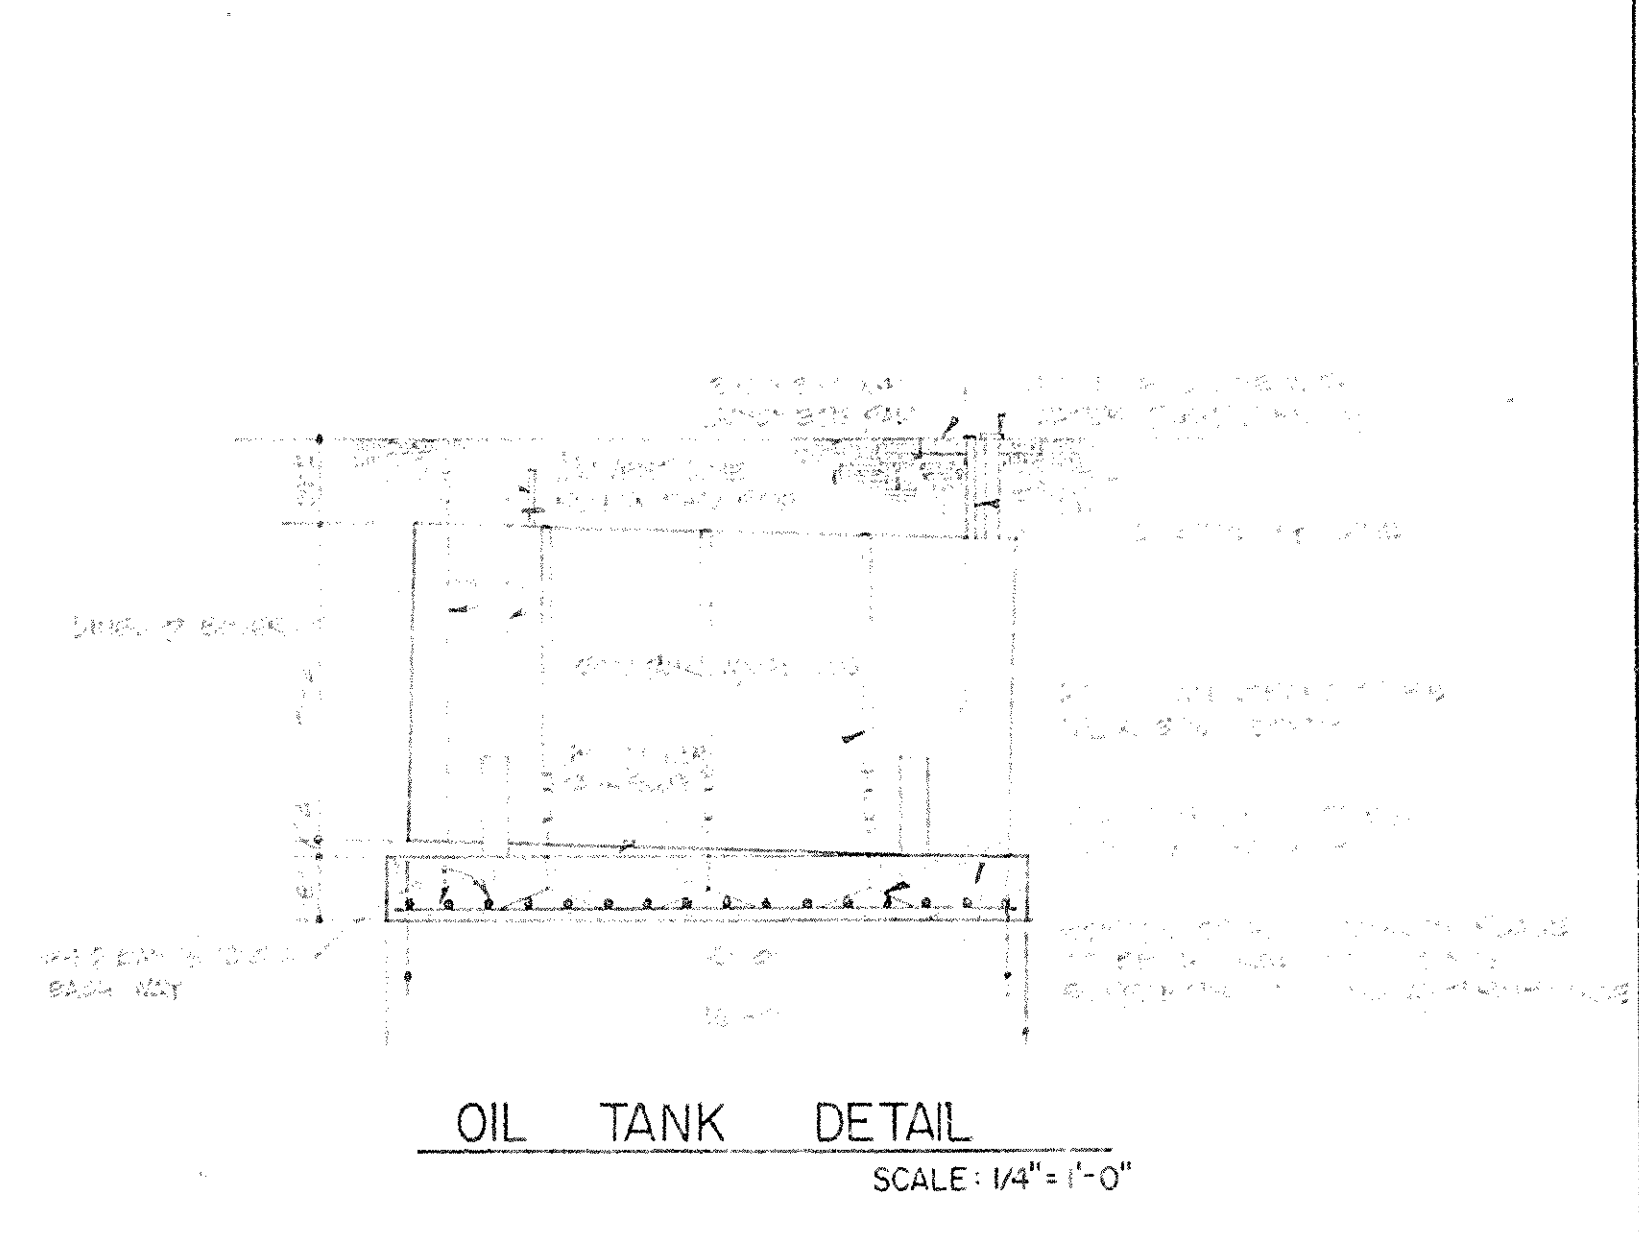

136057


APPROVED: \_\_\_\_\_  
CHECKED: \_\_\_\_\_  
DRAWN: \_\_\_\_\_

ADDITION & REMODELING OF MENAN 1<sup>ST</sup> & MENAN 2<sup>ND</sup> WARD MEETINGHOUSE RIGBY STAKE THE CHURCH OF JESUS CHRIST OF LATTER DAY SAINTS MENAN IDAHO

HAROLD E. COLLARD  
ARCHITECT A.I.A.  
IDAHO FALLS, IDAHO


SHEET NUMBER  
MI OF 4

PROJECT NUMBER

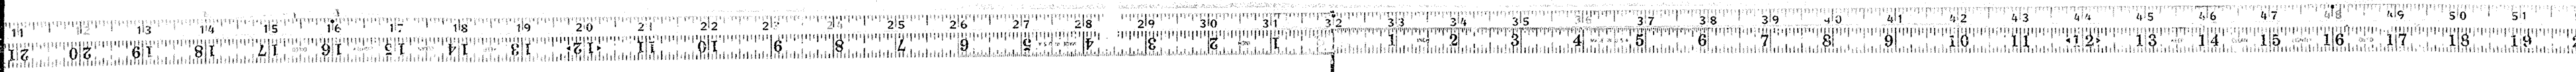

PUMP SCHEDULE

NO.	ISDN	ROOM	HS	CHAR	CTRL	REMARKS	SIZE	TYPE	PIPE

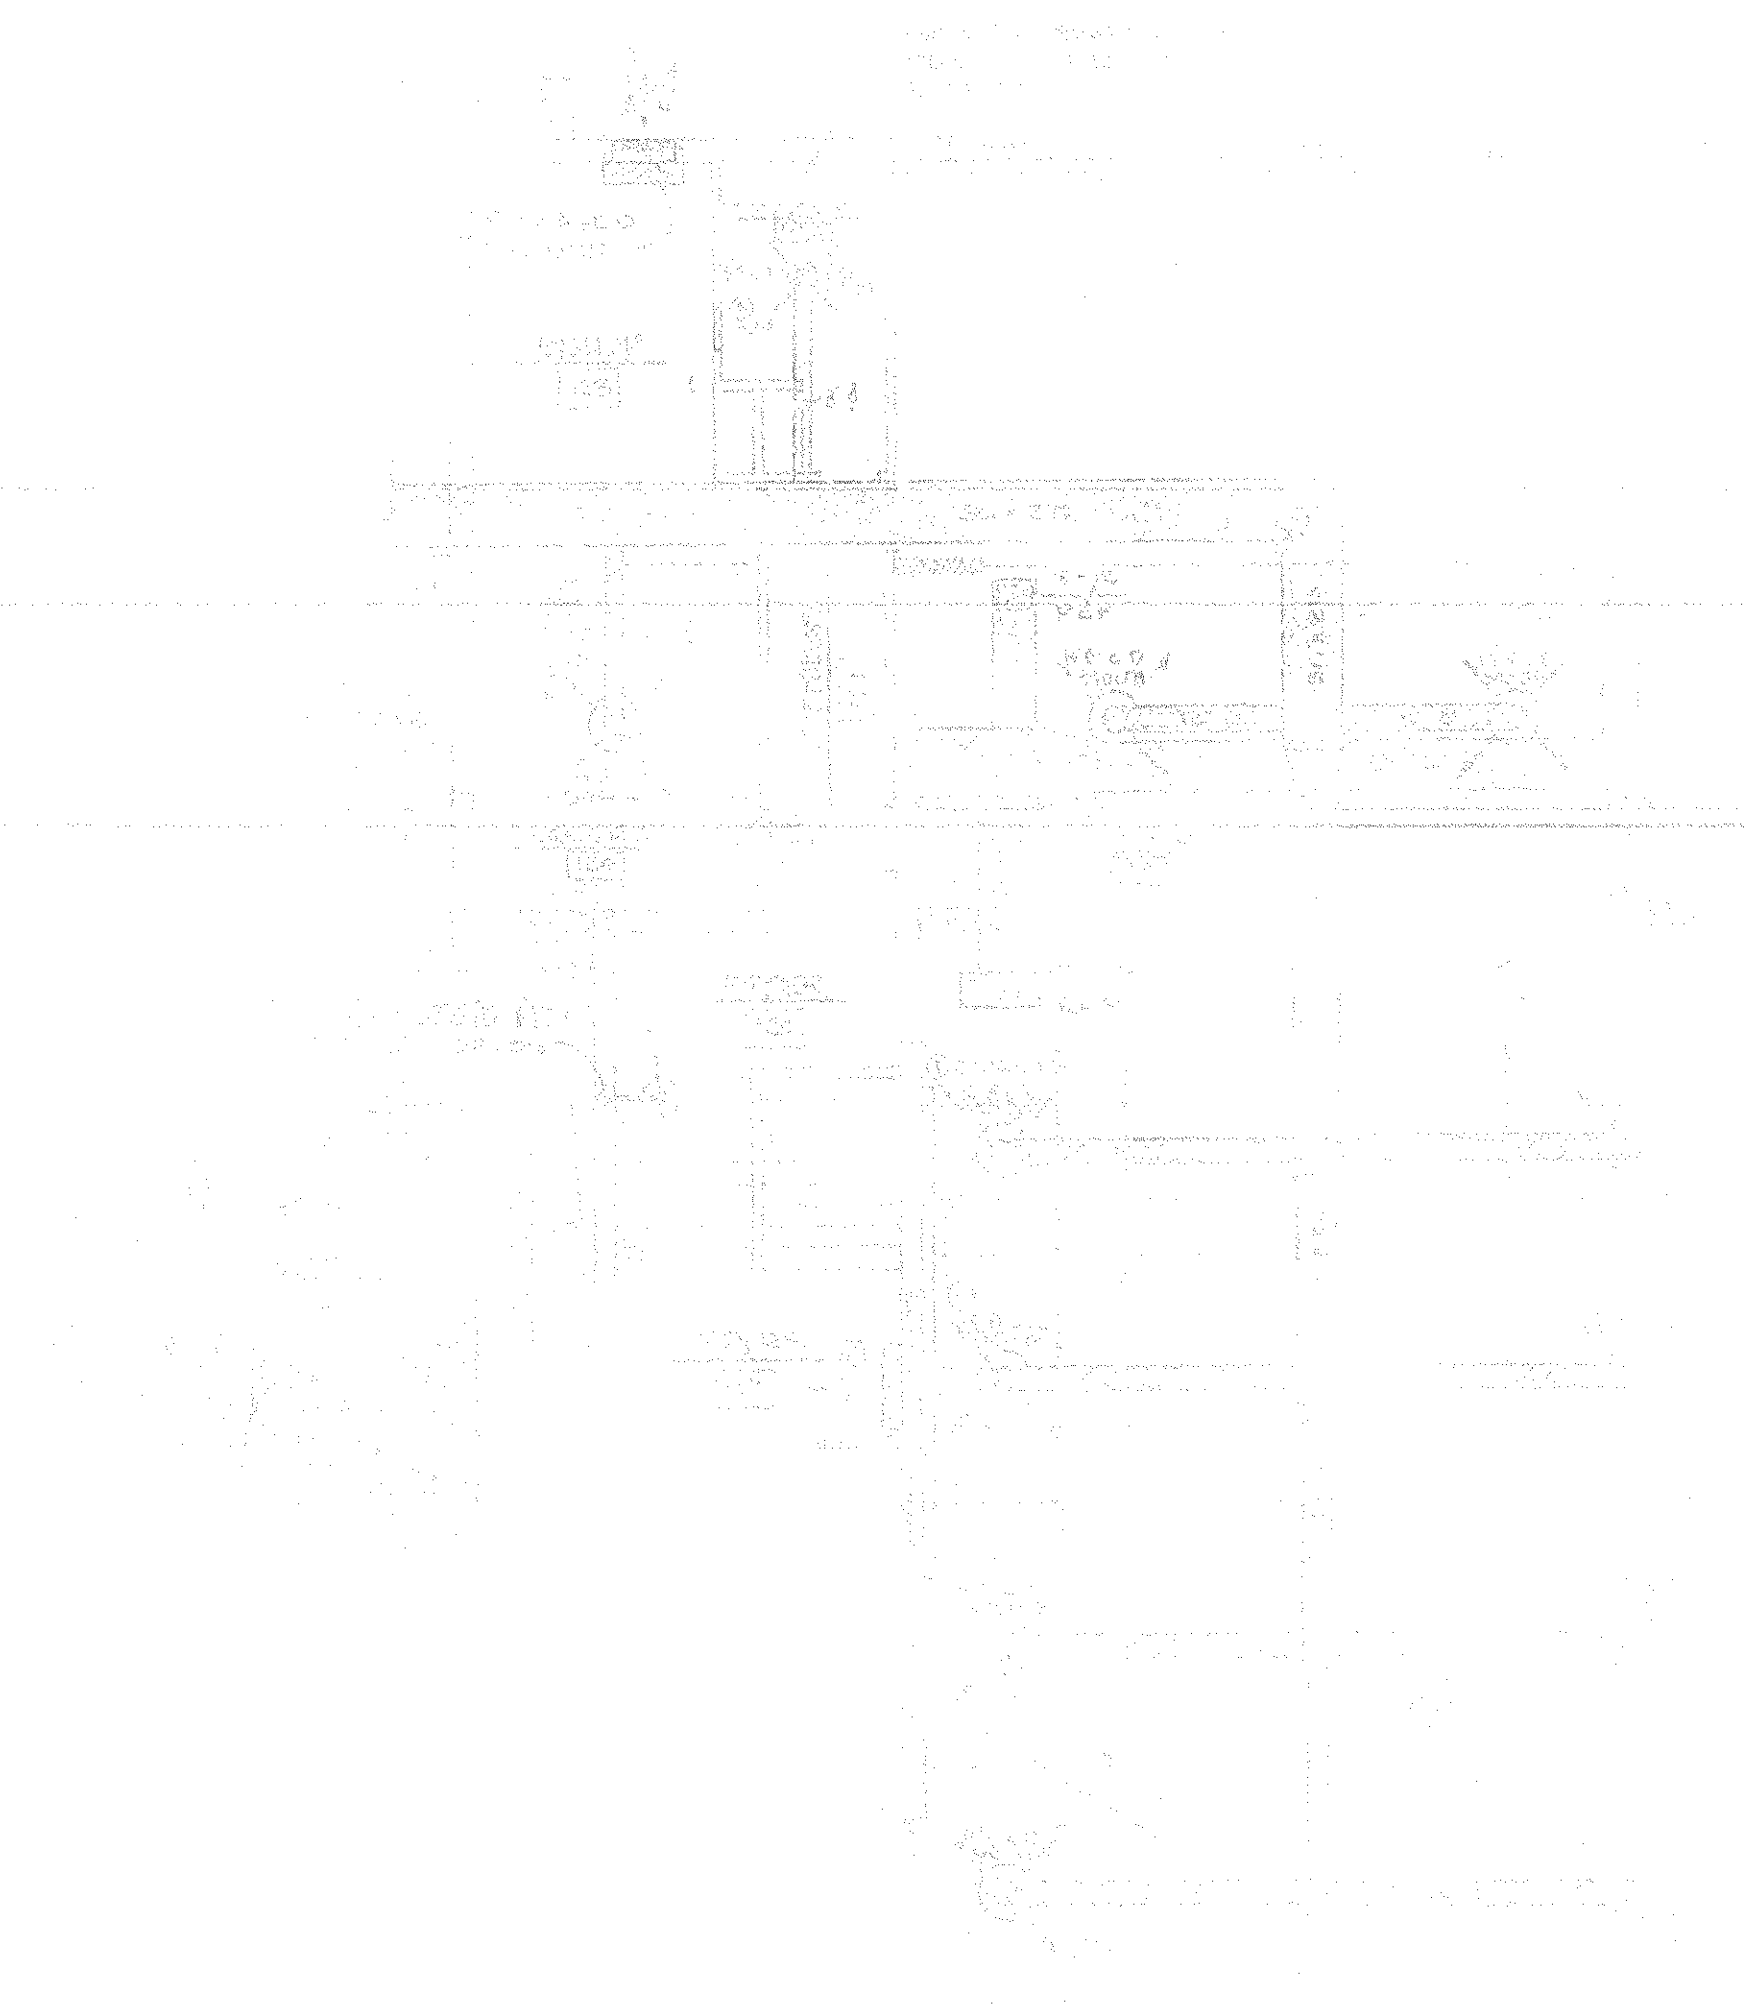

FIXTURE SCHEDULE

NO.	TYPE	ROOM	CHAR	CTRL	REMARKS

UNIT HEATER SCHEDULE

NO.	TYPE	ROOM	CHAR	CTRL	REMARKS

FIXTURE SCHEDULE

NO.	TYPE	ROOM	CHAR	CTRL	REMARKS

ELECTRIC HEATER SCHEDULE

NO.	BTU	KW	CHAR	CONTROL	REMARKS

CONVECTOR SCHEDULE

NO.	SIZE	MBH	ENT. AIR	ENT. WATER	TEMP. DROP	SUPPLY	RETURN	VALVE

HEATING & VENTILATING UNIT SCHEDULE


NO.	TYPE	ROOM	CHAR	CTRL	REMARKS

EXHAUST FAN SCHEDULE





NO.	TYPE	ROOM	SP. G.	HR	CHAR	RPM	NO.	JOV.	REMARKS

NOTICE: THESE DRAWINGS ARE THE PROPERTY OF THE ARCHITECT. NO PART OF THESE DRAWINGS IS TO BE REPRODUCED OR TRANSMITTED IN ANY FORM OR BY ANY MEANS, ELECTRONIC OR MECHANICAL, INCLUDING PHOTOCOPYING, RECORDING, OR BY ANY INFORMATION STORAGE AND RETRIEVAL SYSTEM, WITHOUT THE WRITTEN PERMISSION OF THE ARCHITECT.




PROJECT NUMBER

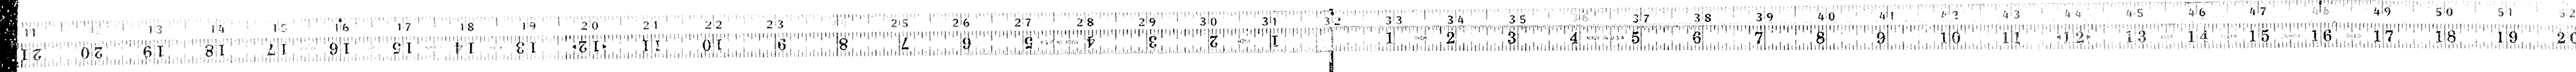



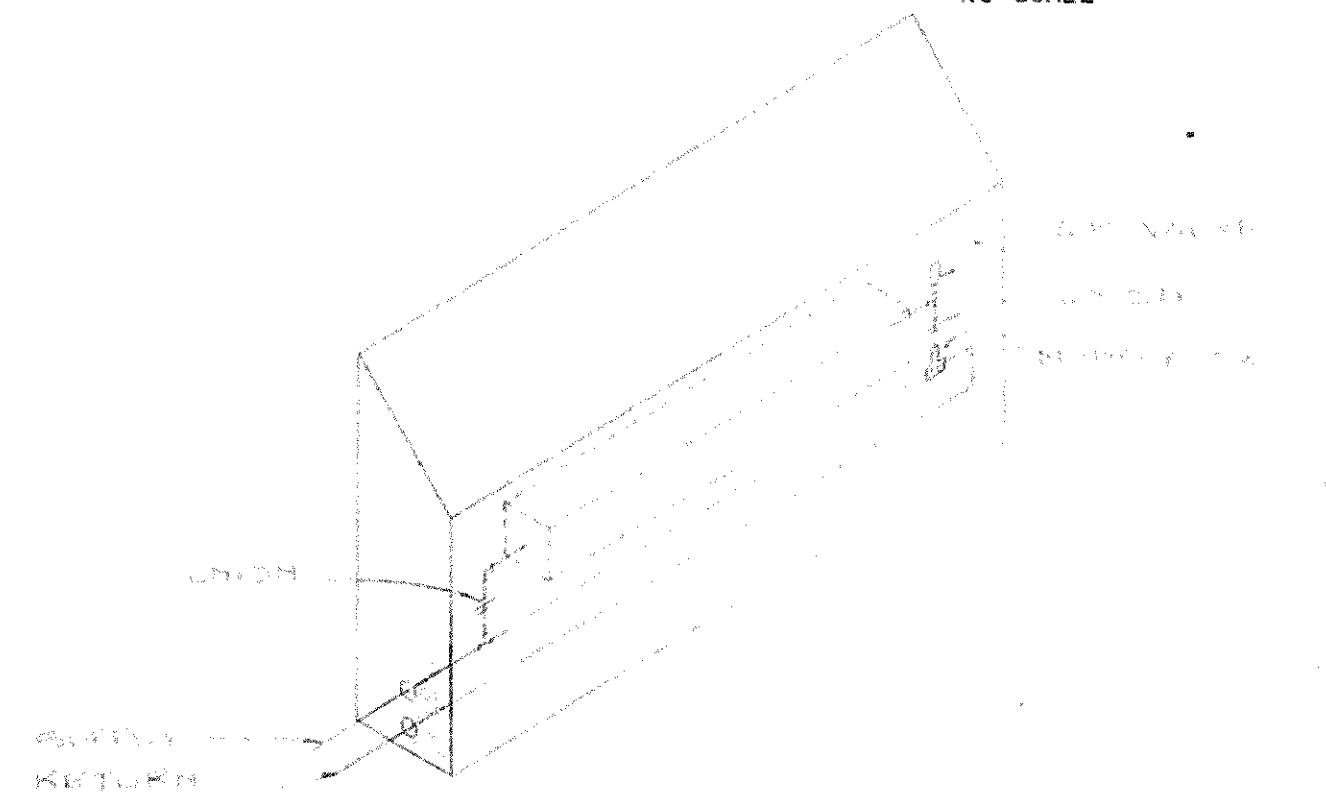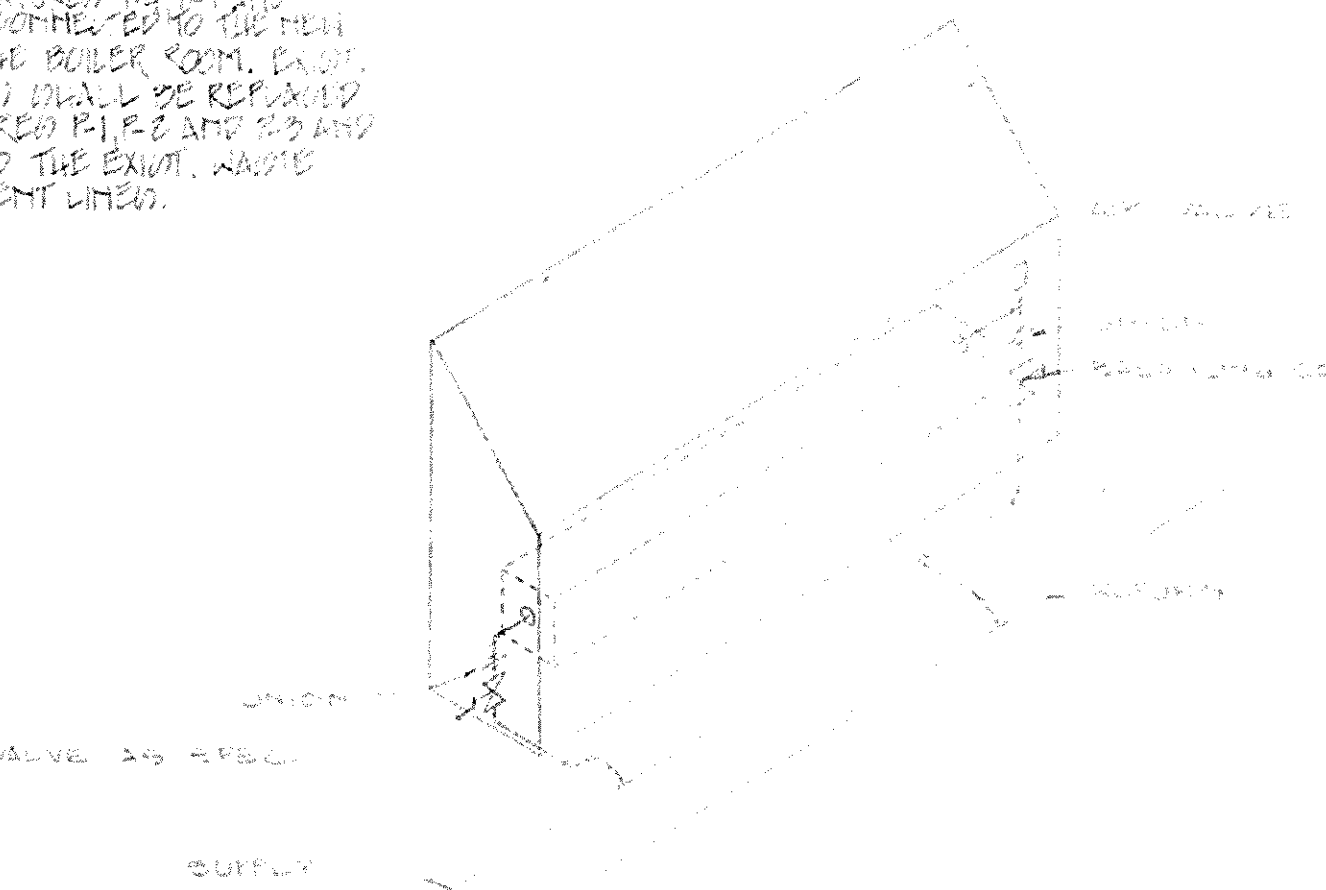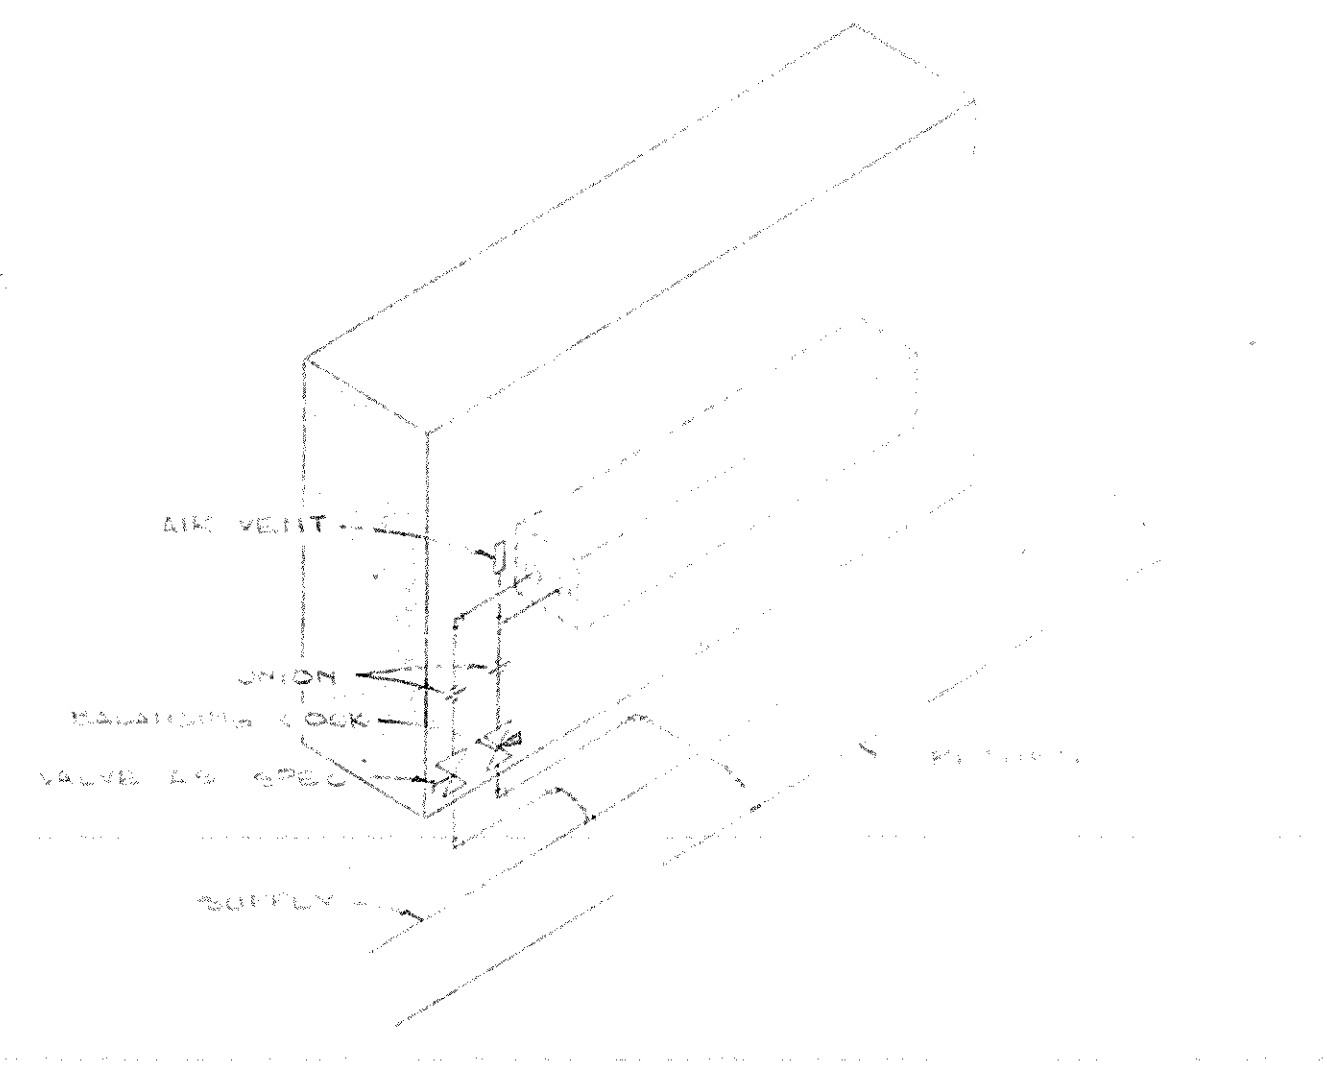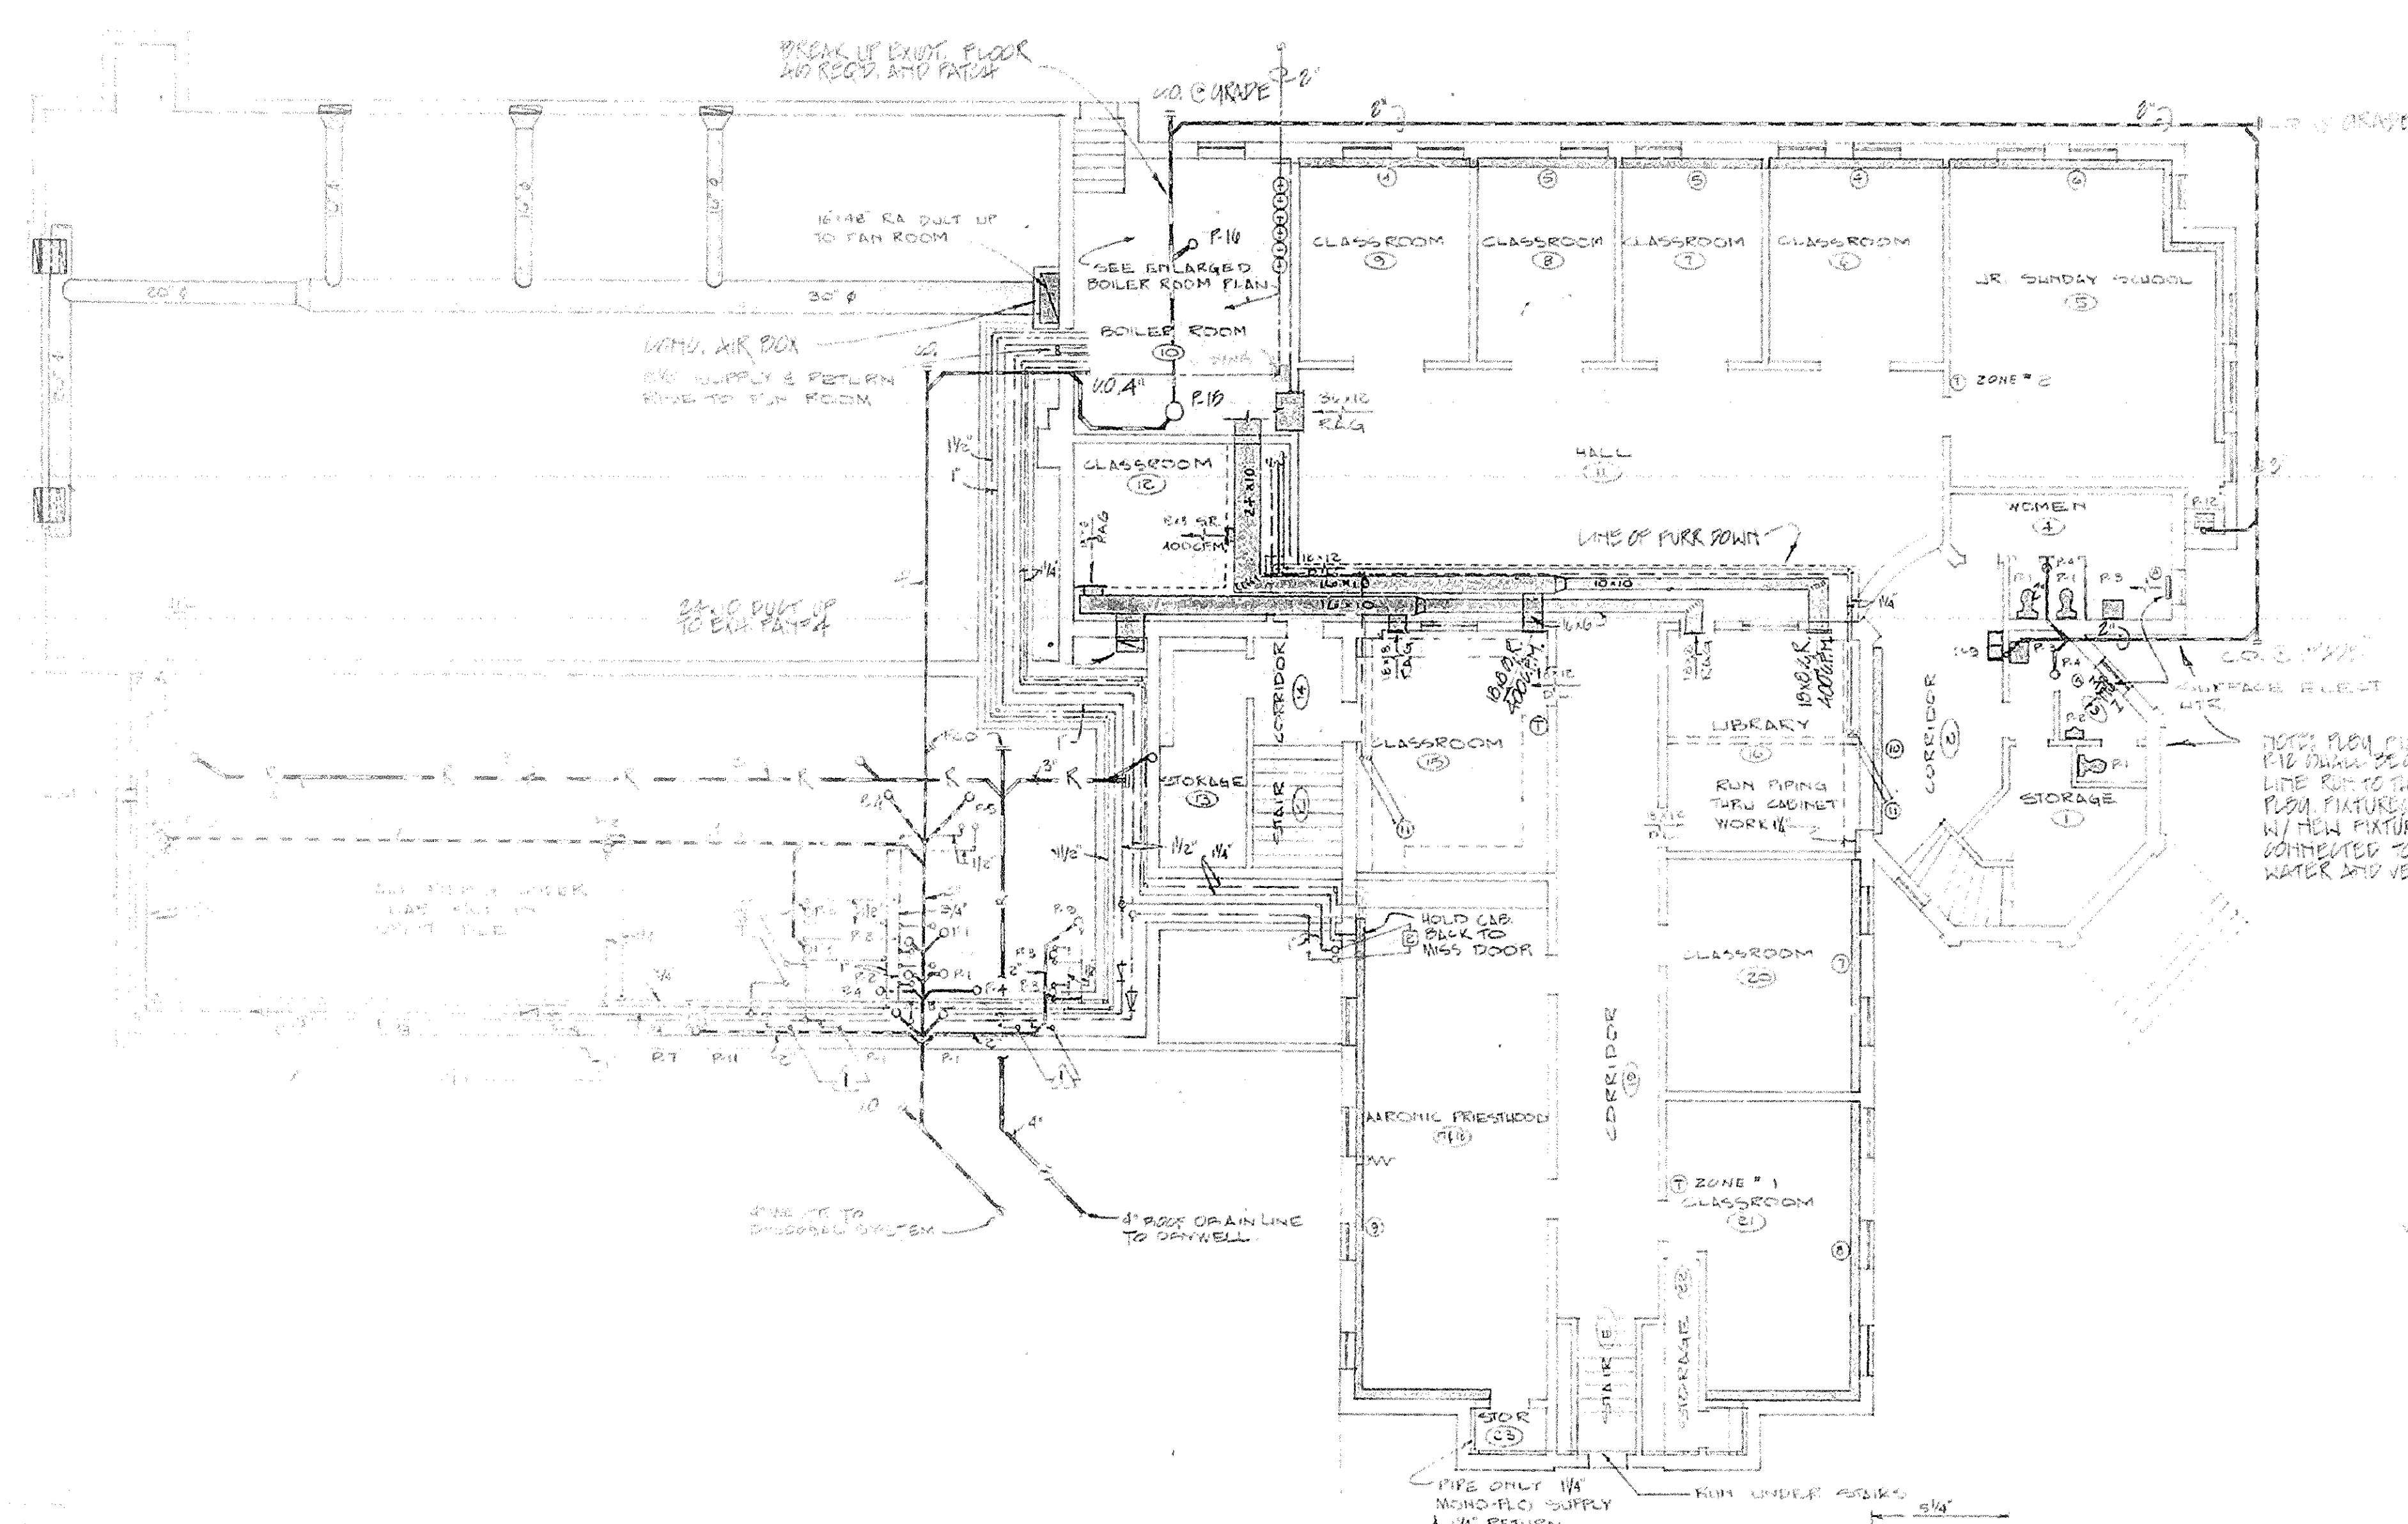


**BASEMENT FLOOR PLAN — MECHANICAL**  
SCALE: 1/8" = 1'-0"

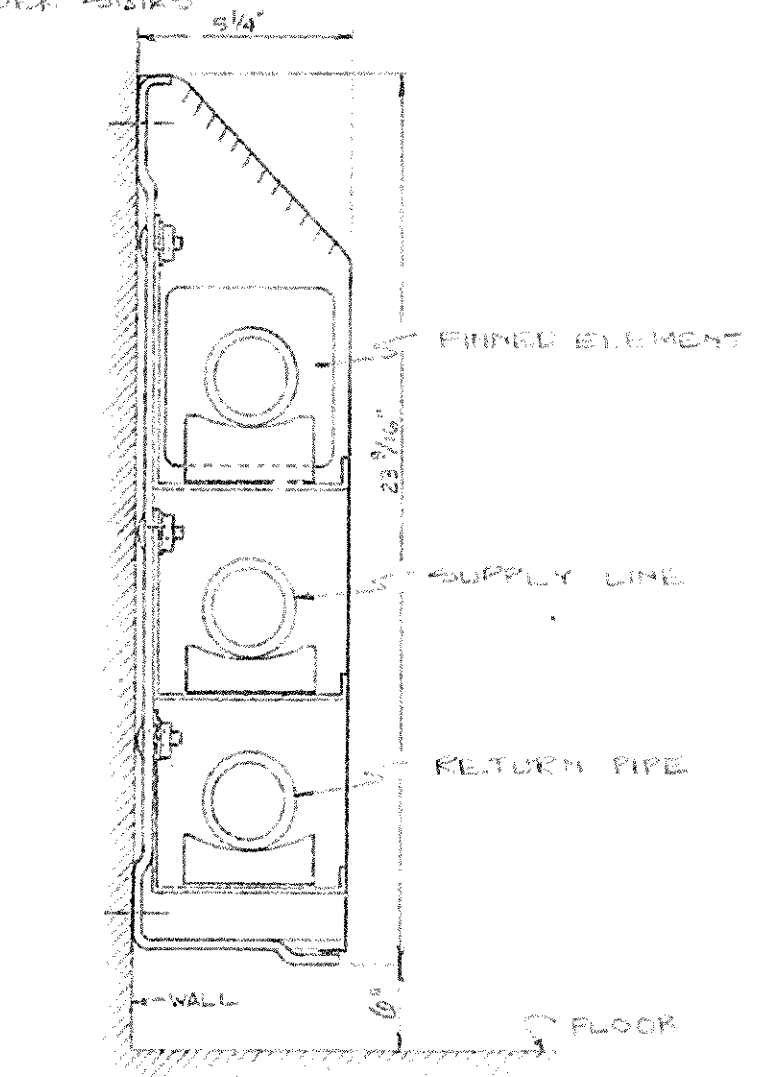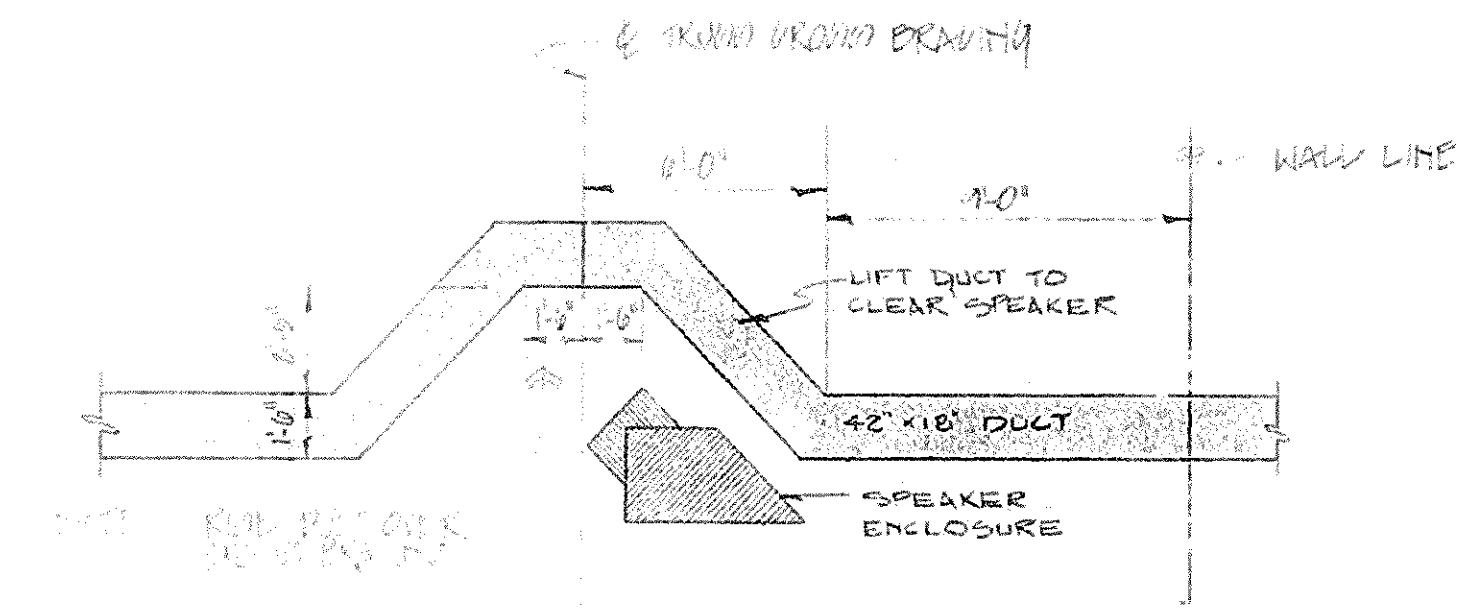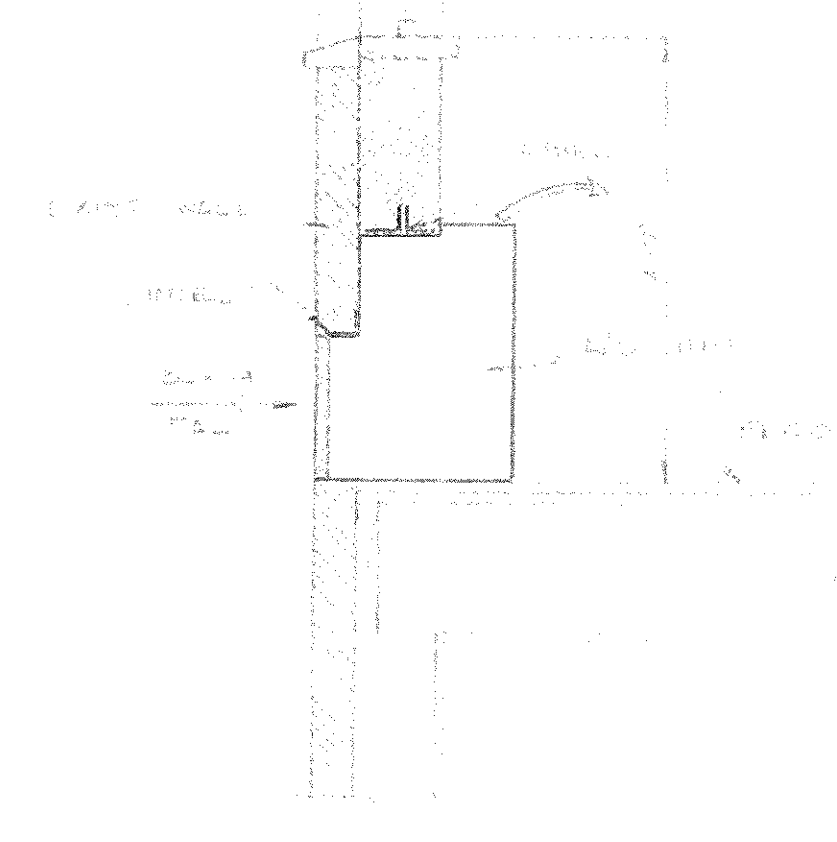

136059

APPROVED	CHECKED	DRAWN	ADDITION & REMODELING OF MENAN 1 & MENAN 2 <sup>ND</sup> WARD MEETINGHOUSE RIGBY STAKE THE CHURCH OF JESUS CHRIST OF LATTER-DAY SAINTS MENAN IDAHO HAROLD E. COLLARD ARCHITECT A.I.A. IDAHO FALLS, IDAHO	SHEET NUMBER <b>M3</b> OF <b>4</b>
PROJECT NUMBER				

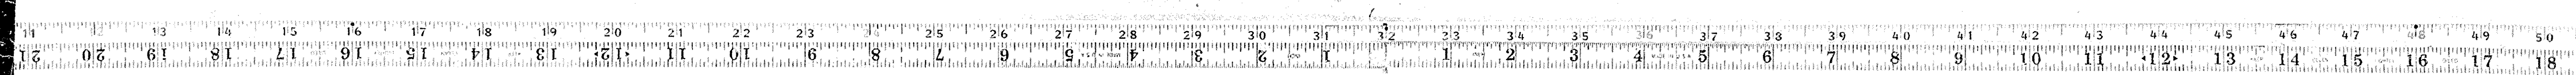



SCHEMATIC BOILER PIPING 136090  
 NO SCALE

ADDITION & REMODELING OF MENAN 1 & MENAN 2 WARD'S MEETINGHOUSE RIGBY STAKE THE CHURCH OF JESUS CHRIST OF LATTER DAY SAINTS MENAN IDAHO HAROLD E. COLLARD ARCHITECT A.I.A. HARBO FALLS, IDAHO	SHEET NUMBER <b>M4</b> OF <b>4</b>
---	---------------------------------------

PROJECT NUMBER





# ELECTRICAL SYMBOL & OUTLET SCHEDULE

SYMBOL	DESCRIPTION	MOUNTING HEIGHT	WIRING DEVICE	NOTES
○	CEILING LIGHT OUTLET	CEILING	SEE FIXTURE SCHEDULE (1)	(1)
○	WALL LIGHT OUTLET	AS NOTED		(1)
○	RECESSED INCANDESCENT LIGHT FIXTURE	CEILING		(1) (2)
○	FLUORESCENT LIGHT FIXTURE	AS NOTED		(1)
○	WALL MOUNTED EXIT LIGHT	AS NOTED		(1) (3)
○	CEILING MOUNTED EXIT LIGHT	CEILING		(1) (3)
○	FLOODLIGHT	AS NOTED		(1)
○	FLUORESCENT NIGHT LIGHT	AS NOTED		(1) NOT SWITCH
○	SINGLE POLE SWITCH	+4'-6"	HUBBELL 1221-1	(4) (5)
○	THREE-WAY SWITCH	+4'-6"	HUBBELL 1223-1	(4) (5)
○	FOUR-WAY SWITCH	+4'-6"	HUBBELL 1224-1	(4) (5)
○	SWITCH & PILO. LIGHT	+4'-6"	HUBBELL 1475	(5)
○	VARIABLE INTENSITY SWITCH	+4'-6"	(SEE SPECS)	
○	FAN SWITCH	+4'-6"	PARAGON FF-15-D	
○	DOOR SWITCH	+4'-6"	HUBBELL 2022	(5)
○	THERMAL OVERLOAD SWITCH WITH PILOT LIGHT	+4'-6"	SQ "D" 2510 FC1P	(6)
○	SPEED SWITCH	+4'-6"	BY MECHANICAL	
○	FUSED SWITCH	ON EQUIP	BUSS "S S W"	(5)
○	LOW VOLTAGE SWITCH	+4'-6"	6 E. RCS2PL/ARB/RT	SEE SPECS
○	TMRD SWITCH (ASTRO)	+5'-0"	TORK 7300L	(9)
○	TMRD SWITCH (24 HR)	+5'-0"	TORK 7300L	(9)
○	ELECTRIC EYE W/RELAY	AS NOTED	TORK 2000A	(9)
○	THERMOSTAT (ELECTRIC)	+5'-0"		
○	LOCKOUT STOP SWITCH	+5'-0"	SQ "D" NYC 105	
○	TELEVISION OUTLET (8 SQUARE)	9"	(SEE SPECS)	
○	GROUNDING TYPE DUPLEX CONVENIENCE OUTLET	9"	HUBBELL 5252-1	(5)
○	WEATHERPROOF CONY OUTLET	+2'-0"	SIERRA WFD-B	(8)
○	FLOOR OUTLET W/15 AMP DEVICE	FLOOR	HUBBELL F-2428	
○	PLUS MOLD	+3'-6"	WIRE MOLD SC-3093	
○	SPECIAL OUTLET WITH CAP & LIFT COVER	1" - IN FLOOR	HUBBELL 7310	+2'-0"
○	FUNCTION BOX	1" - IN FLOOR	HUBBELL 7330	+2'-0"
○	FUNCTION BOX	1" - IN FLOOR	HUBBELL 7330	+4'-6"
○	FUNCTION BOX	1" - IN FLOOR	HUBBELL 7410	+4'-0"
○	MOTOR OUTLET	TO SUIT EQUIP	HUBBELL 73430	+4'-0"
○	FAN MOTOR	TO SUIT EQUIP	HUBBELL 7379	+4'-0"
○	DISCONNECT SWITCH (FUSED)	+5'-0"	SQ "D" GENERAL DUTY	(6) (7)
○	MAGNETIC STARTER	+5'-0"	SQ "D" 8536	(6) (SIZE TO EQUIP)
○	MAGNETIC STARTER / DISCONNECT	+5'-0"	SQ "D" 8536	(6)
○	BREAKER - STARTER COMBINATION	+5'-0"	SQ "D" 8539	(6) (SIZE TO EQUIP)
○	TELEPHONE OUTLET	9"	(SEE SPECS)	
○	TELEPHONE OUTLET	FLOOR	HUBBELL F-2428	
○	TELEPHONE CABINET	TOP AT 6'-6"	AS NOTED	
○	PANELBOARD	TOP AT 6'-6"	(SEE SCHEDULE)	
○	MAIN POWER PANEL	(SEE SCHEDULE)		
○	CLOCK OUTLET	+8'-0"	HUBBELL 1707-5B	
○	PROGRAM CLOCK	+8'-0"	(SEE SPECS)	
○	MASTER CLOCK	+5'-0"	(SEE SPECS)	
○	CLOCK WORK SIGNAL BELL	+7'-6"	(SEE SPECS)	(8)
○	MUSIC STATION	+8'-0"	(SEE SPECS)	
○	FIRE DETECTOR	CEILING	(SEE SPECS)	(8)
○	FIRE ALARM BREAK GLASS STATION	+5'-0"	(SEE SPECS)	
○	FIRE ALARM CONTROL CABINET	(SEE SPECS)		
○	FIRE ALARM SIGNAL HORN	+7'-6"	(SEE SPECS)	
○	INTER COM	AS NOTED	(SEE SPECS)	
○	MICROPHONE FLOOR RECP	FLOOR	(SEE SPECS)	
○	MICROPHONE CEILING RECP	CEILING	(SEE SPECS)	
○	MICROPHONE OUTLET	9"	(SEE SPECS)	
○	SOUND SYSTEM SPEAKER OUTLET	+8'-0" OR CEILING	(SEE SPECS)	
○	REMOTE CONTROL	(SEE SPECS)		
○	PRIVACY ANNUNCIATOR SWITCH	+4'-6"	(SEE SPECS)	
○	VOLUME CONTROL	+4'-6"	(SEE SPECS)	

STANDARD MOUNTING HEIGHT UNLESS NOTED OTHERWISE (ON PLANS)

ONE CIRCUIT - TWO WIRE - HOME RUN TO PANEL

TWO CIRCUIT - THREE WIRE - COMMON NEUTRAL - HOME RUN TO PANEL

THREE CIRCUIT - FOUR WIRE - COMMON NEUTRAL - HOME RUN TO PANEL

(A) CONDUIT RUN(A) IN WALL OR CEILING, (B) IN FLOOR OR GROUND

(A) CONDUIT(A) UP CONDUIT(B) DOWN

(1) SEE FIXTURE SCHEDULE FOR TYPE, MOUNTING, & WATTAGE

(2) WIRED FROM OUTLET BOX ADJACENT

(3) REFER TO DRAWINGS FOR DIRECTIONAL ARROWS

(4) SUBSCRIPT KEYS SWITCH TO OUTLETS CONTROLLED

(5) EQUALS OF BRYANT, GE, SIERRA OR HUBBELL ARE ACCEPTABLE

(6) EQUALS OF WESTINGHOUSE, SQ "D", GE, OR A-B, ARE ACCEPTABLE

(7) NEMA TYPE "ND" UNFUSED UNLESS NOTED "F" (FUSED) USE "HD" FOR 480 VOLTS

(8) # INDICATES SIZE AND/OR TYPE (SEE SPECS)



(9) EQUALS OF PARAGON AND INTERMATIC ARE ACCEPTABLE

PANEL TYPE I-LINE VOLTS 120/240		LOCATION ROOM 10 FLOOR BASEMENT MOUNTING SURFACE	
MAIN 600 NAD BREAKER TOP FEED			
CR	BREAKER	NO. OUTLETS	LOAD
NO.	AMPS	POLES	AMPS
1	20	3	1500
2	10	1	1500
3	1	1	800
4	1	1	800
5	4	1	1750
6	1	1	800
7			
8			
9			
10			
11			
12			
13	2	4	350 350
14			
15	1	1	1500 1500
16	1	1	1800 1800
17	40	1	2000 2000
18	1	1	2000 2000
19	1	1	2000 2000
20	1	1	2000 2000
21	1	1	2000 2000
22			
23			
24			
25	30	1	1500 1500
26	100	1	10000 10000
27			
28	125	1	12800 14000
29	150	1	17650 18700
30			
31			
32			
33			
34			

TOTAL 83800 83850

AMPS/PHASE (A) 725 (B) 726

WIRE SIZE CONDUCTED BY LOCAL TOWN CO. CONDUIT SIZE 4"

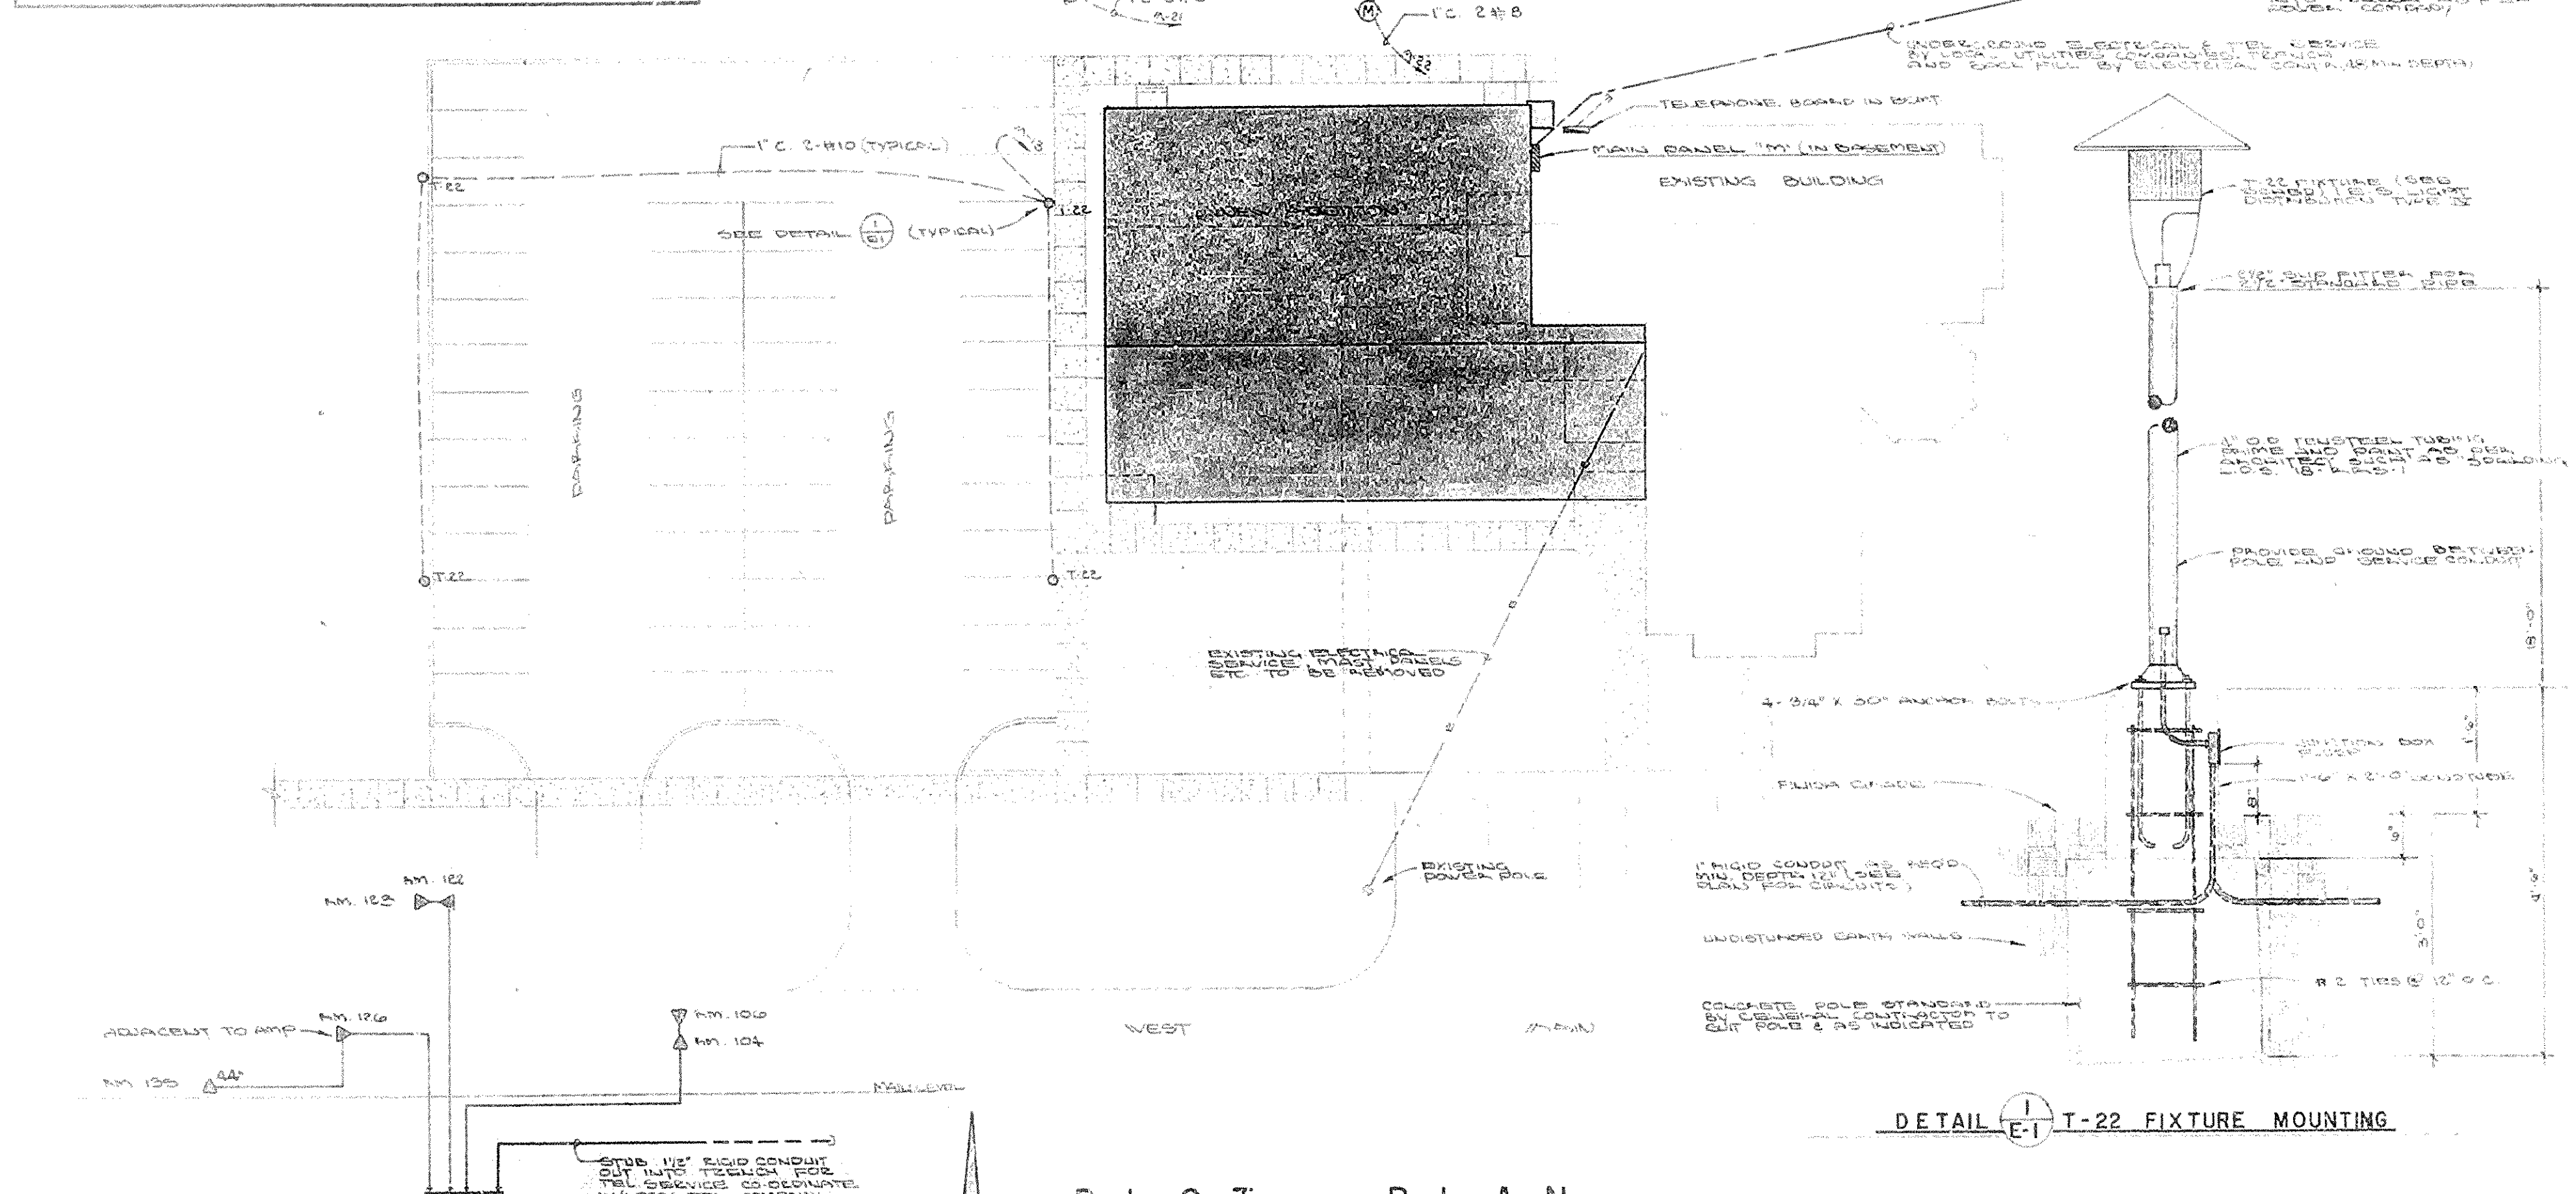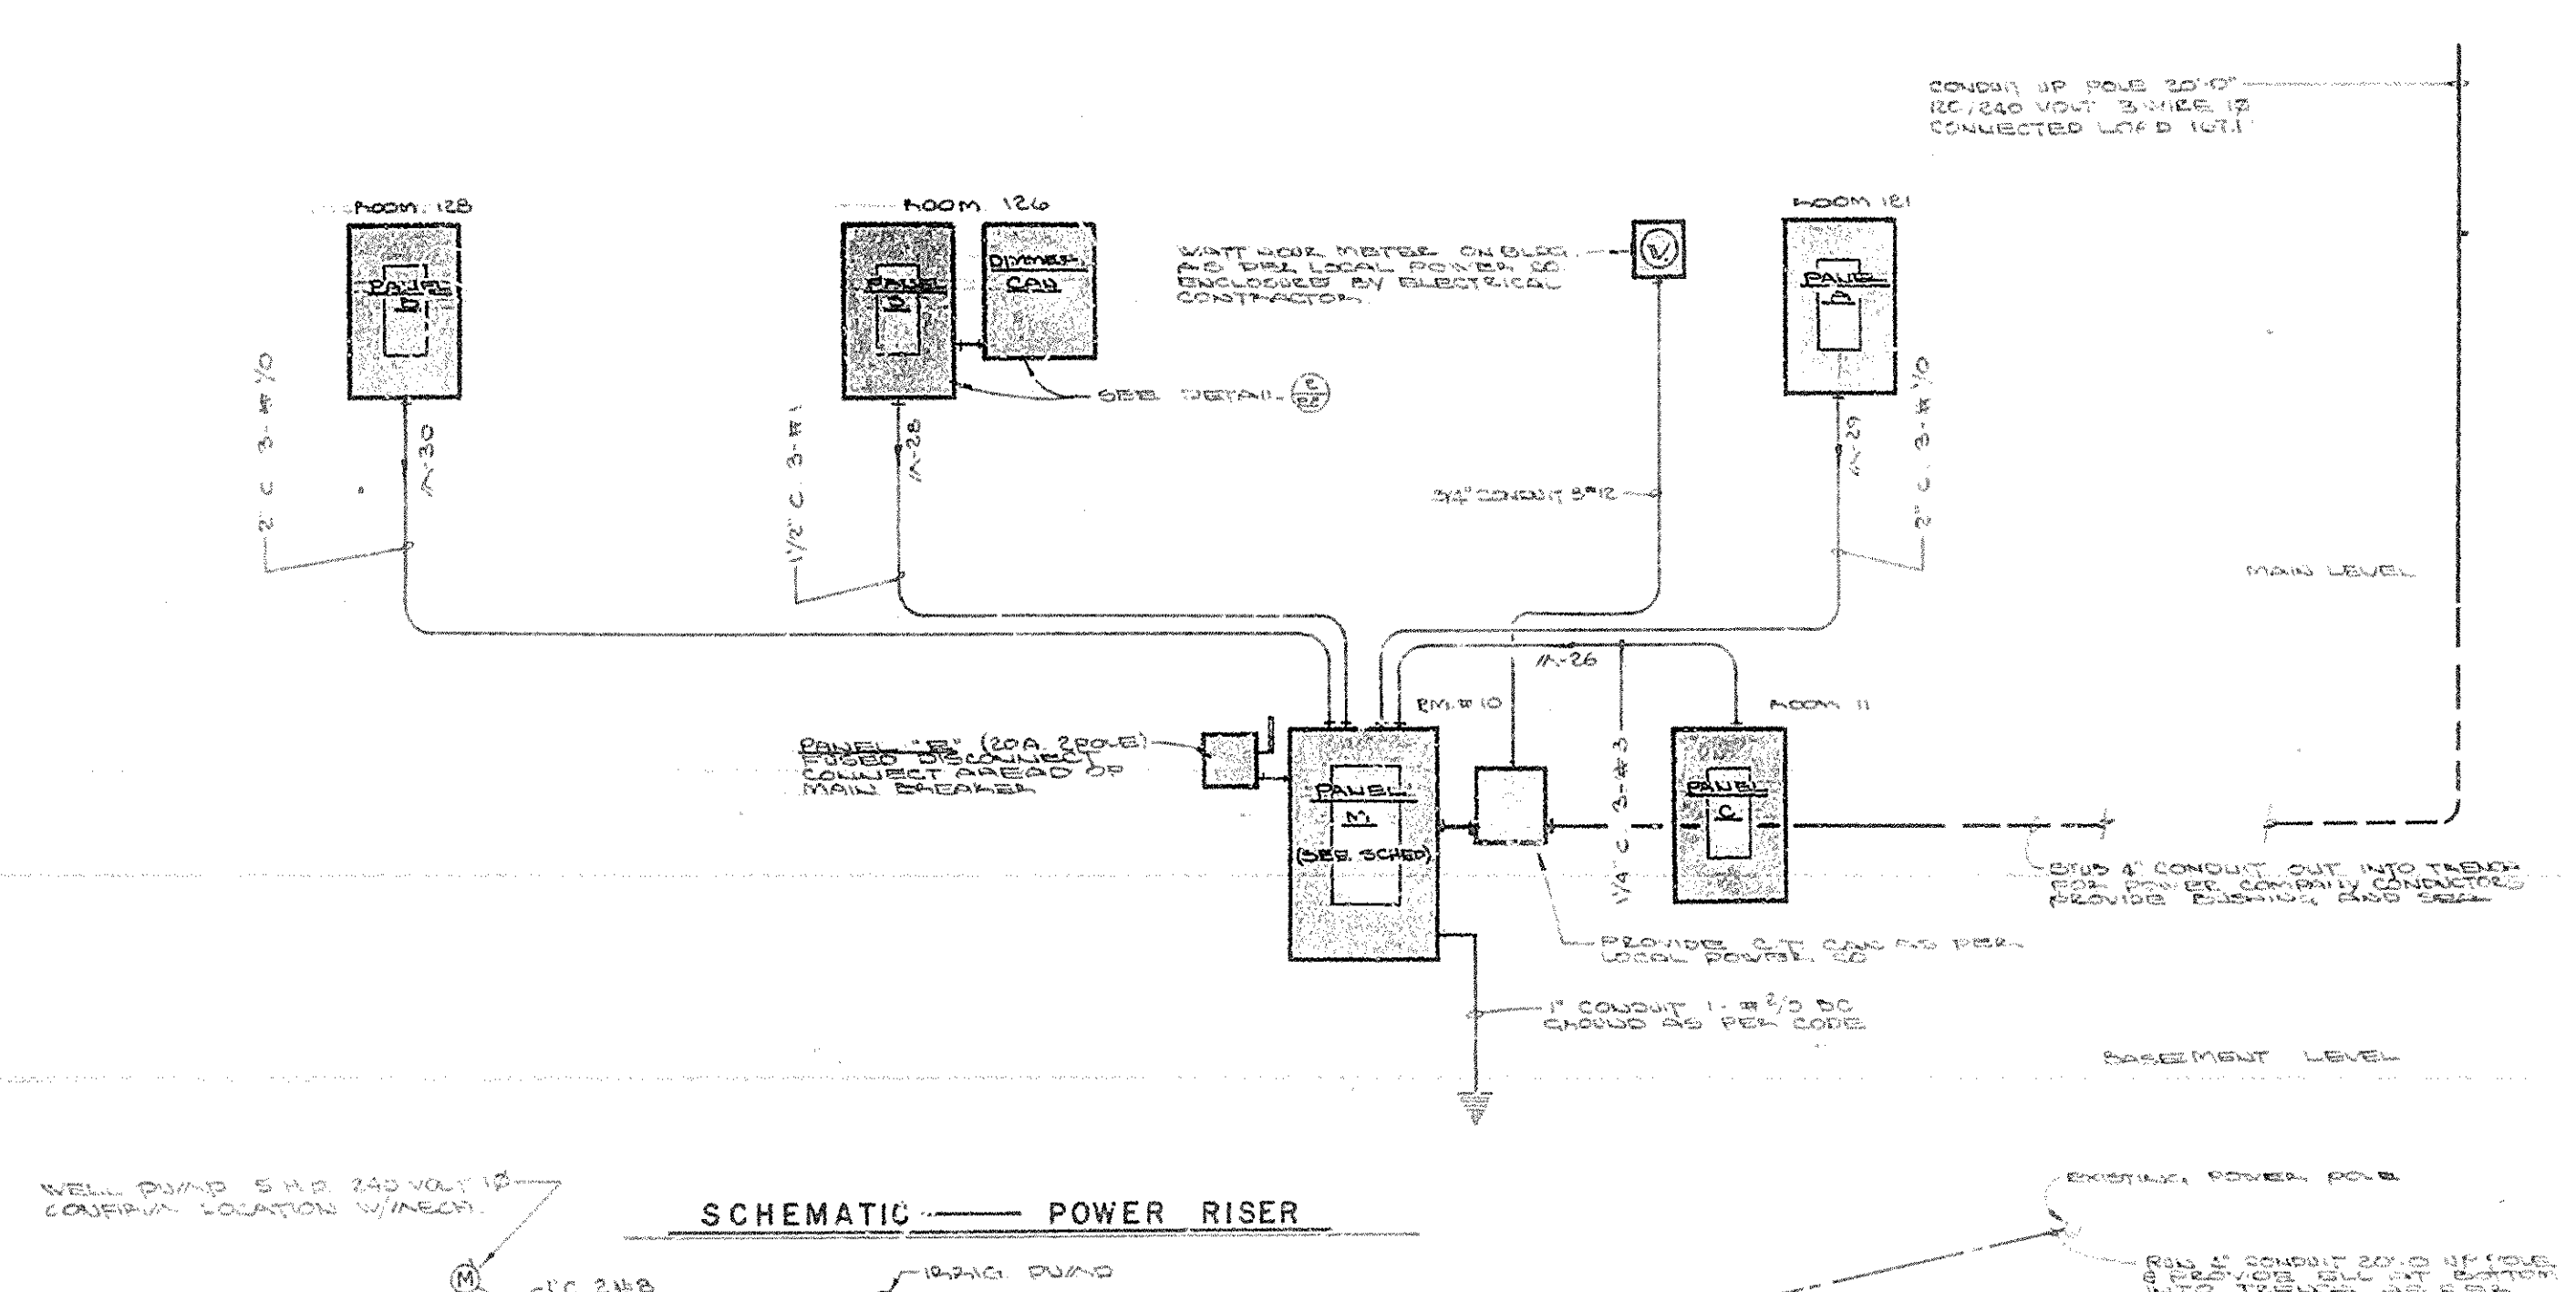


DETAIL E-1 T-22 FIXTURE MOUNTING


136091

HAROLD E. COLLARD ARCHITECT A.I.A. IDAHO FALLS, IDAHO

PROJECT NUMBER

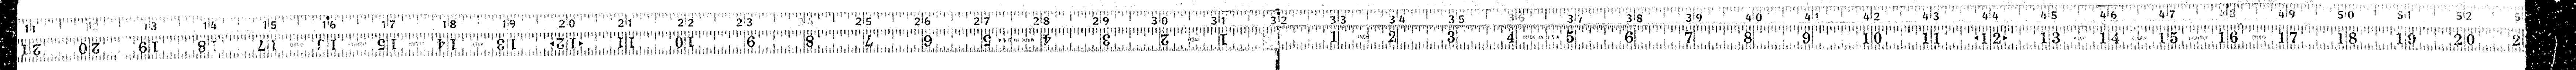




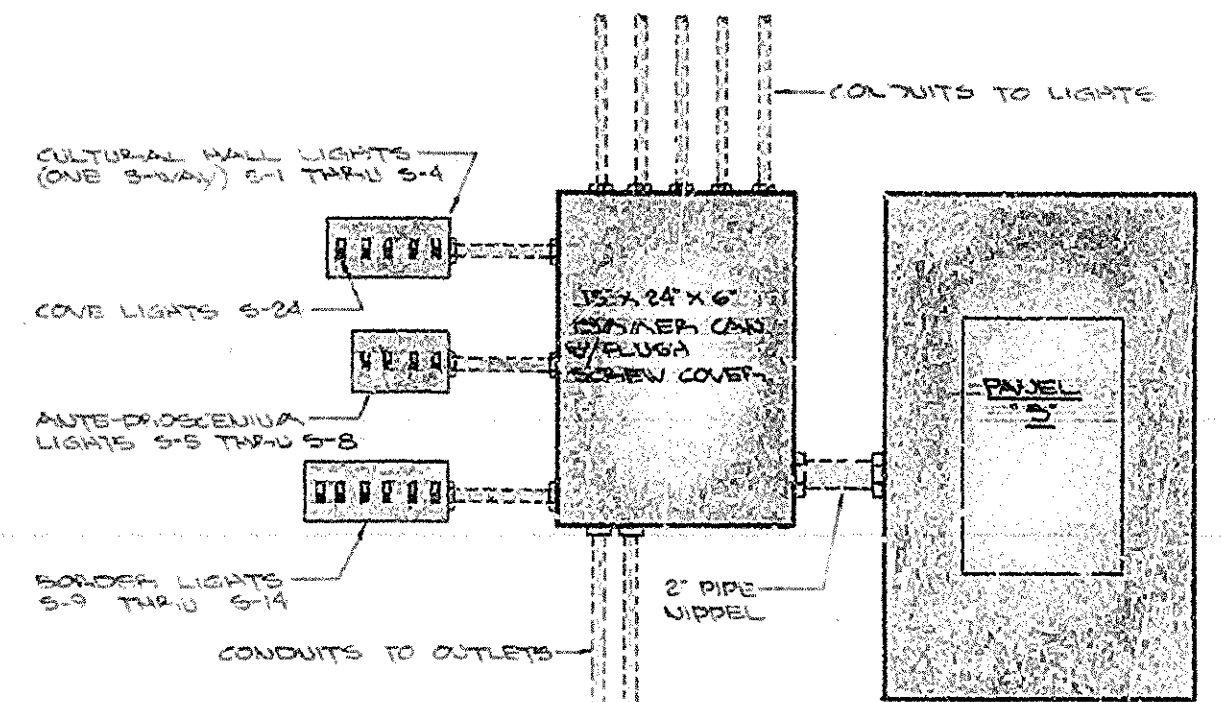


NOTES  
 1. LOCATE SINGLE & 3-POLE SWITCHES AS INDICATED FOR CONTROL OF LIGHTS - ENGRAVE SWITCH PLATES TO LIGHTS CONTROLLED  
 2. LOOP CIRCUITS S-1 THRU S-20 THRU DIMMER CAN (LEAVE 18 MINIMUM SLACK), PULL NEUTRAL FOR EACH CIRCUIT THRU DIMMER.


DETAIL E2 PANEL "S" DIMMER CAN & SWITCH

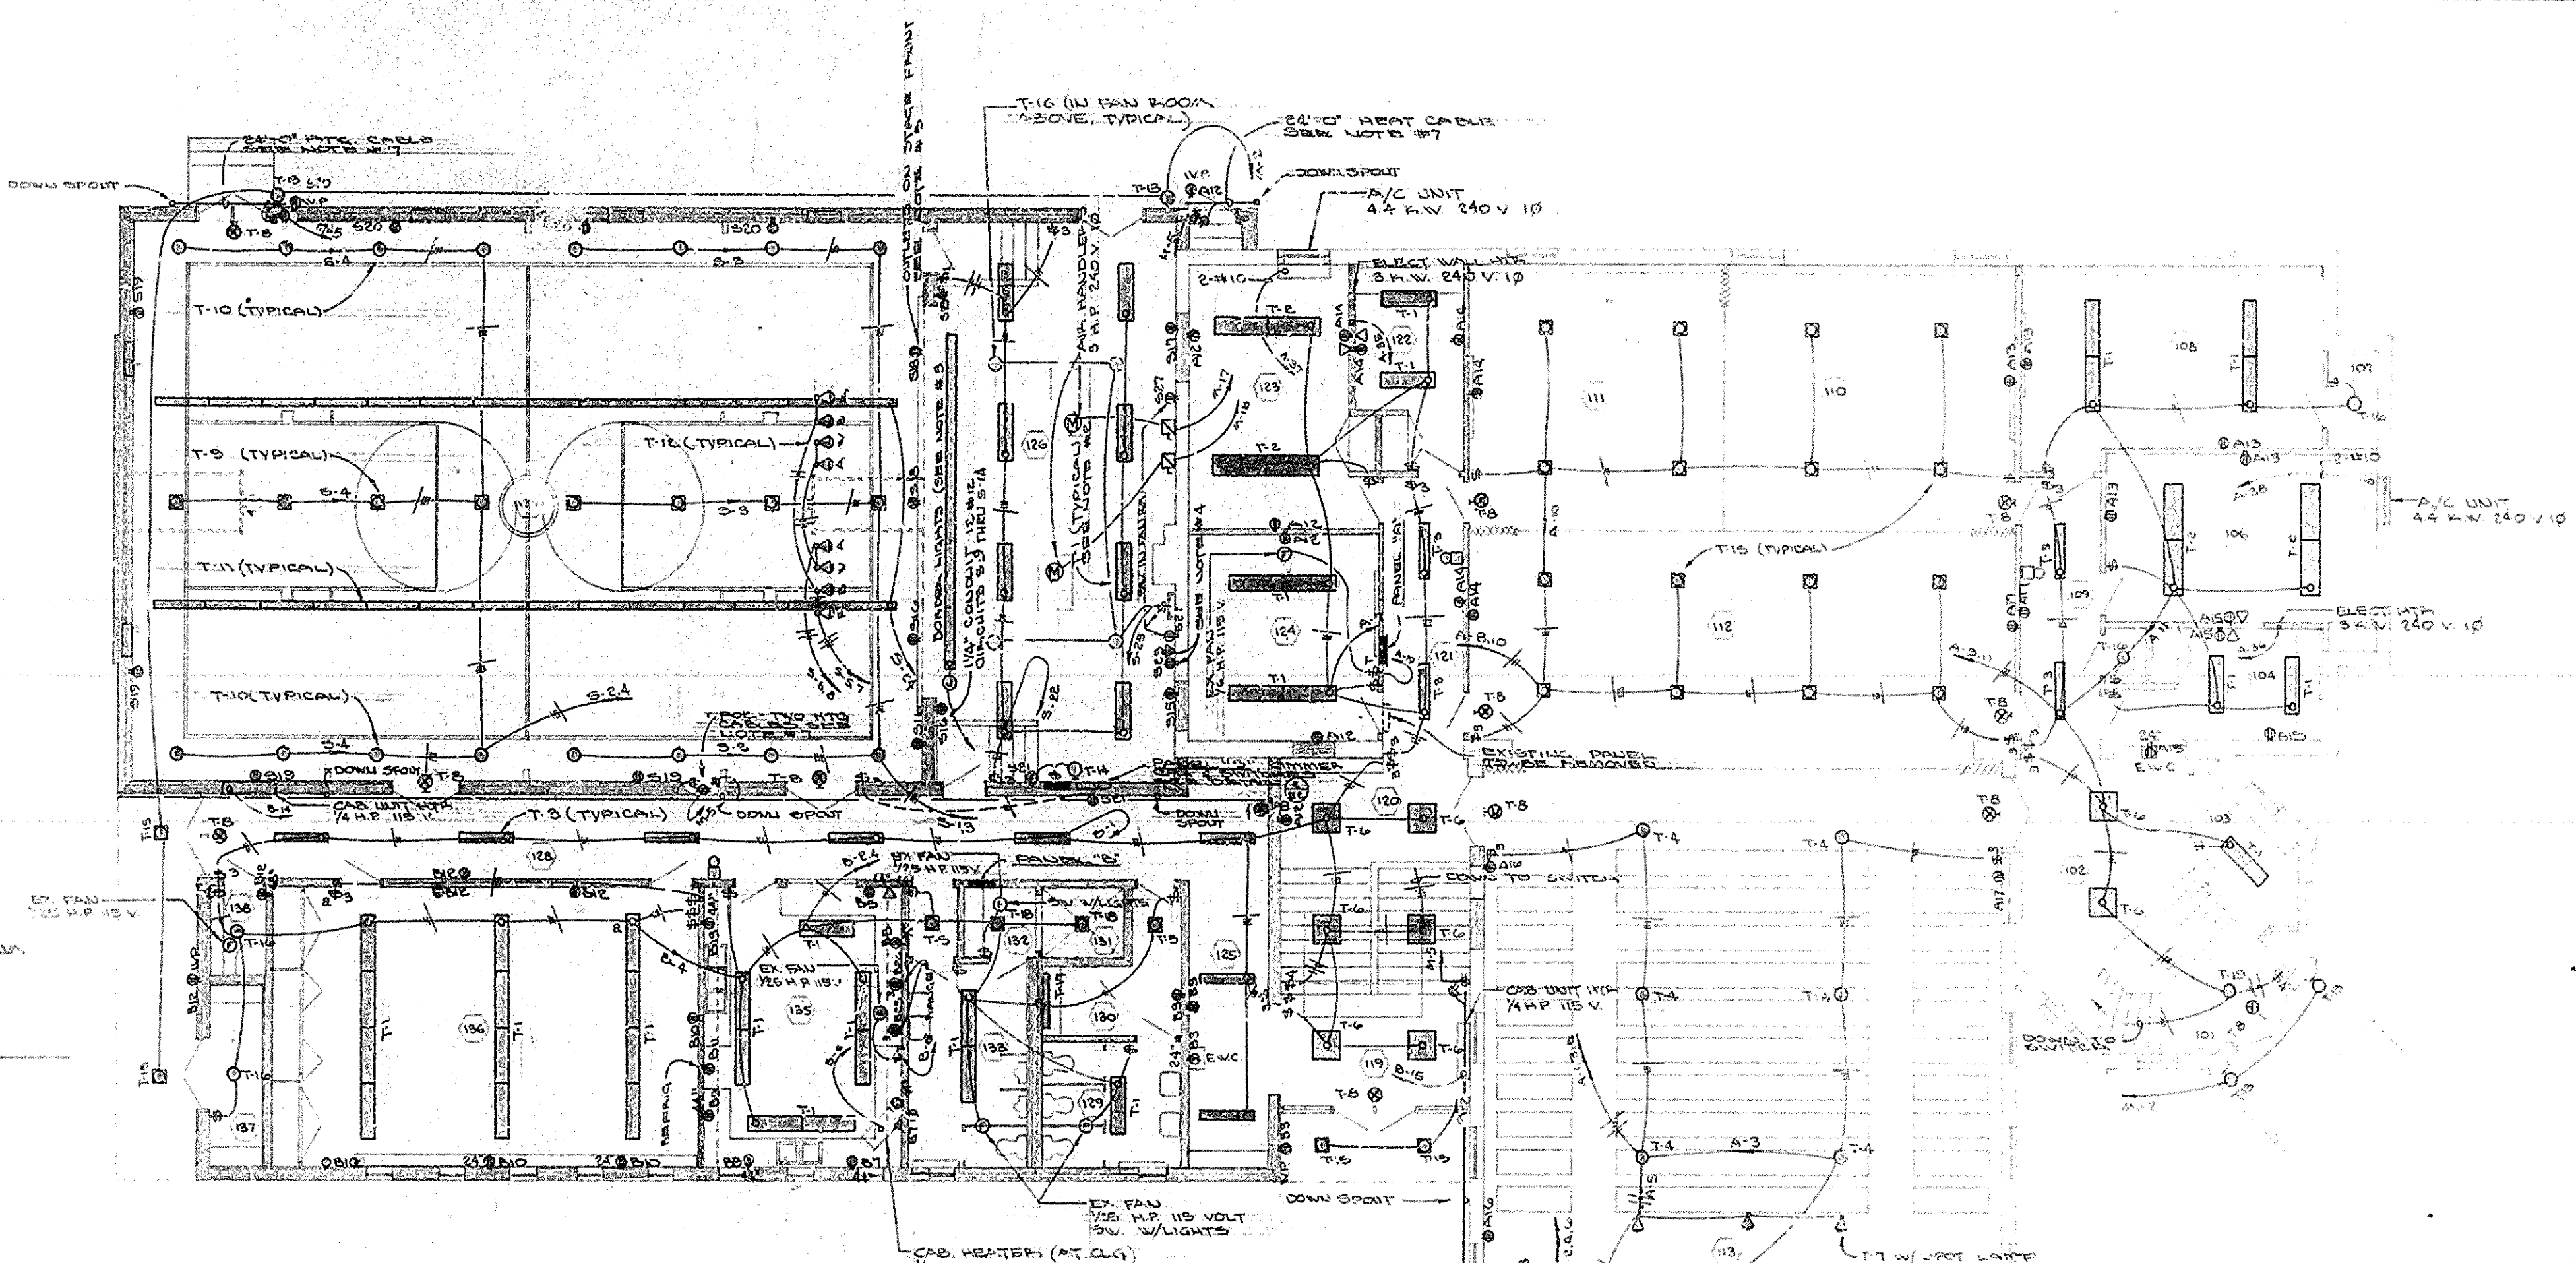


MAIN LEVEL PLAN  
 SCALE 1/8" = 1'-0"

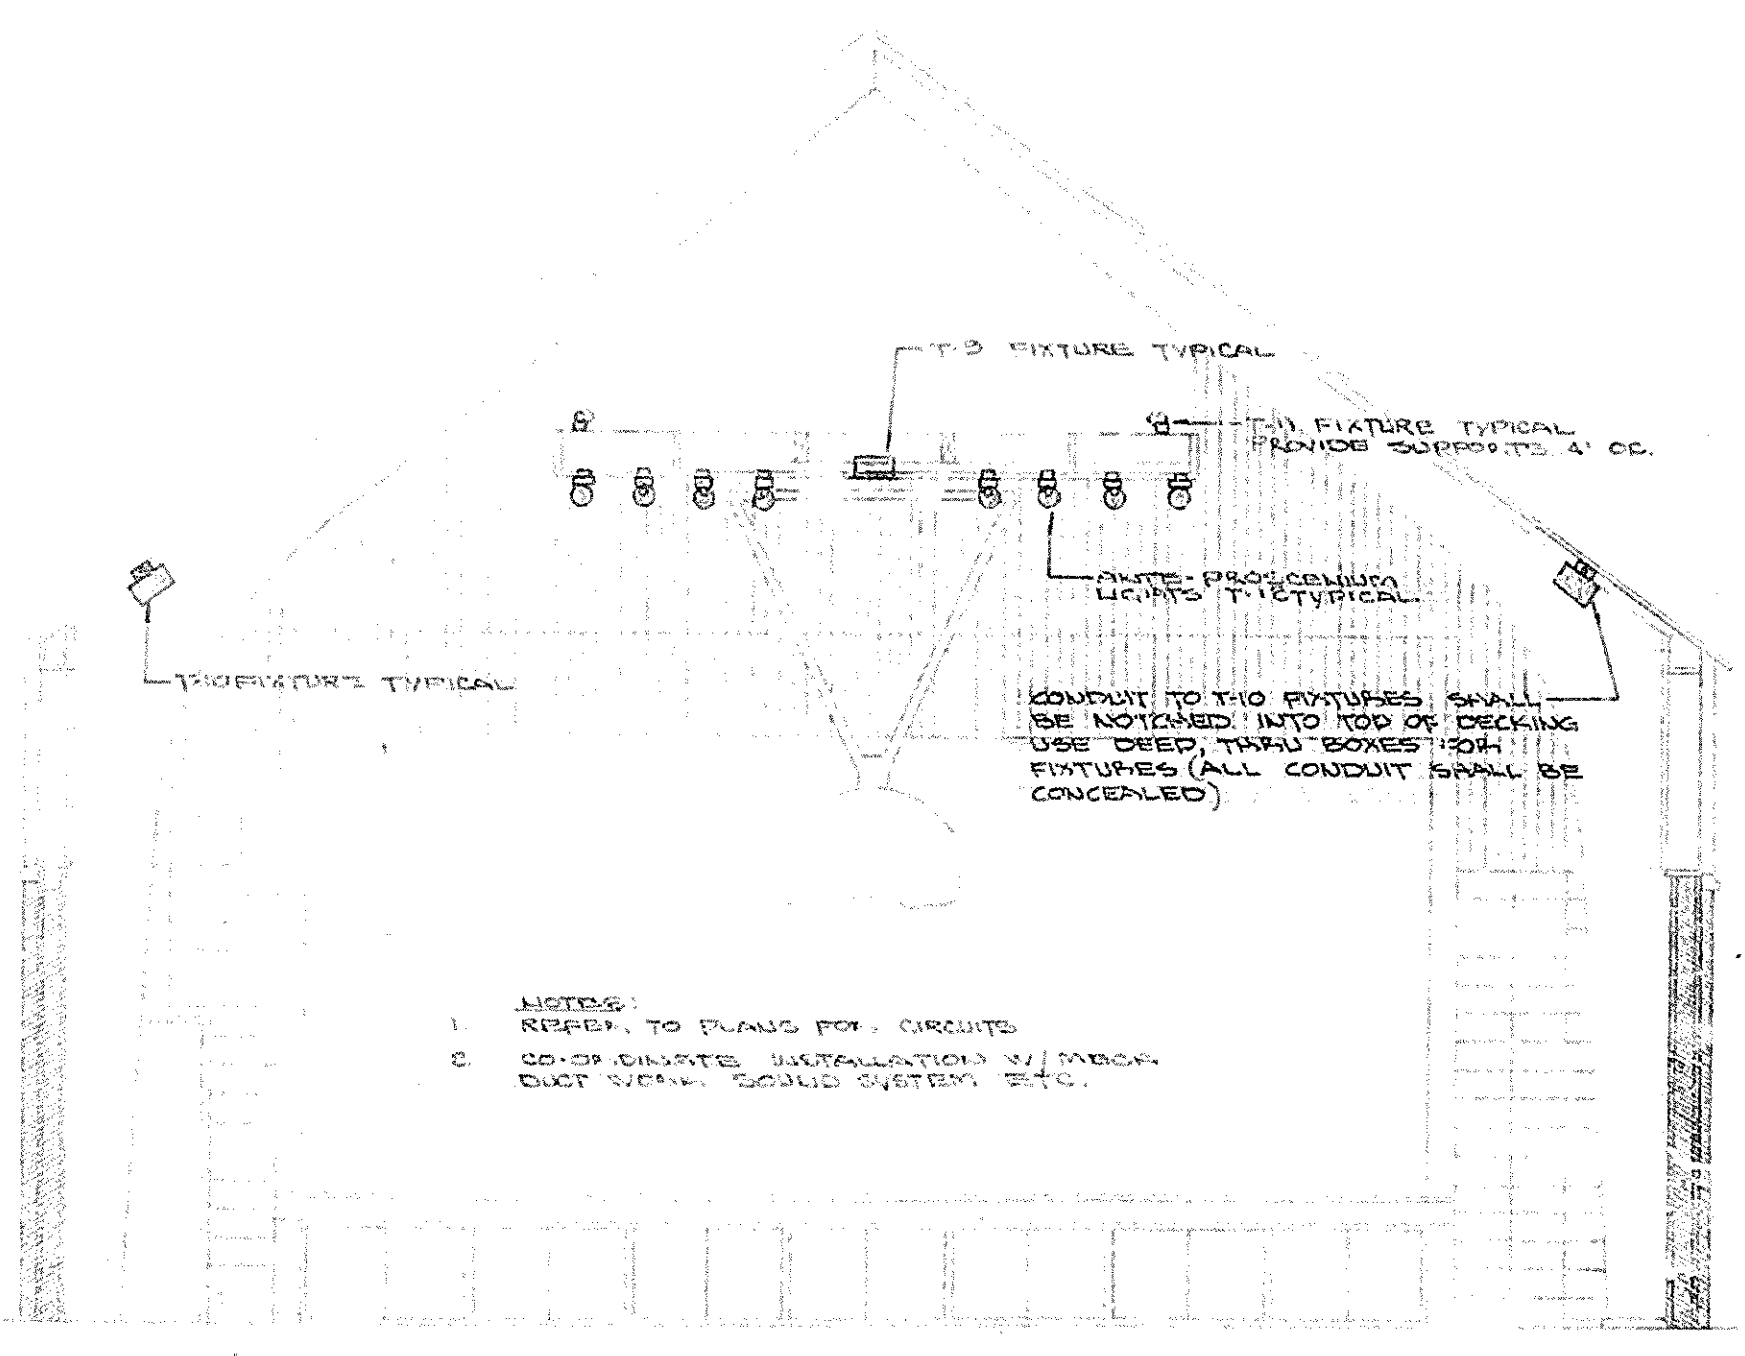

DETAIL E2 CULTURAL HALL FIXTURE MOUNTING

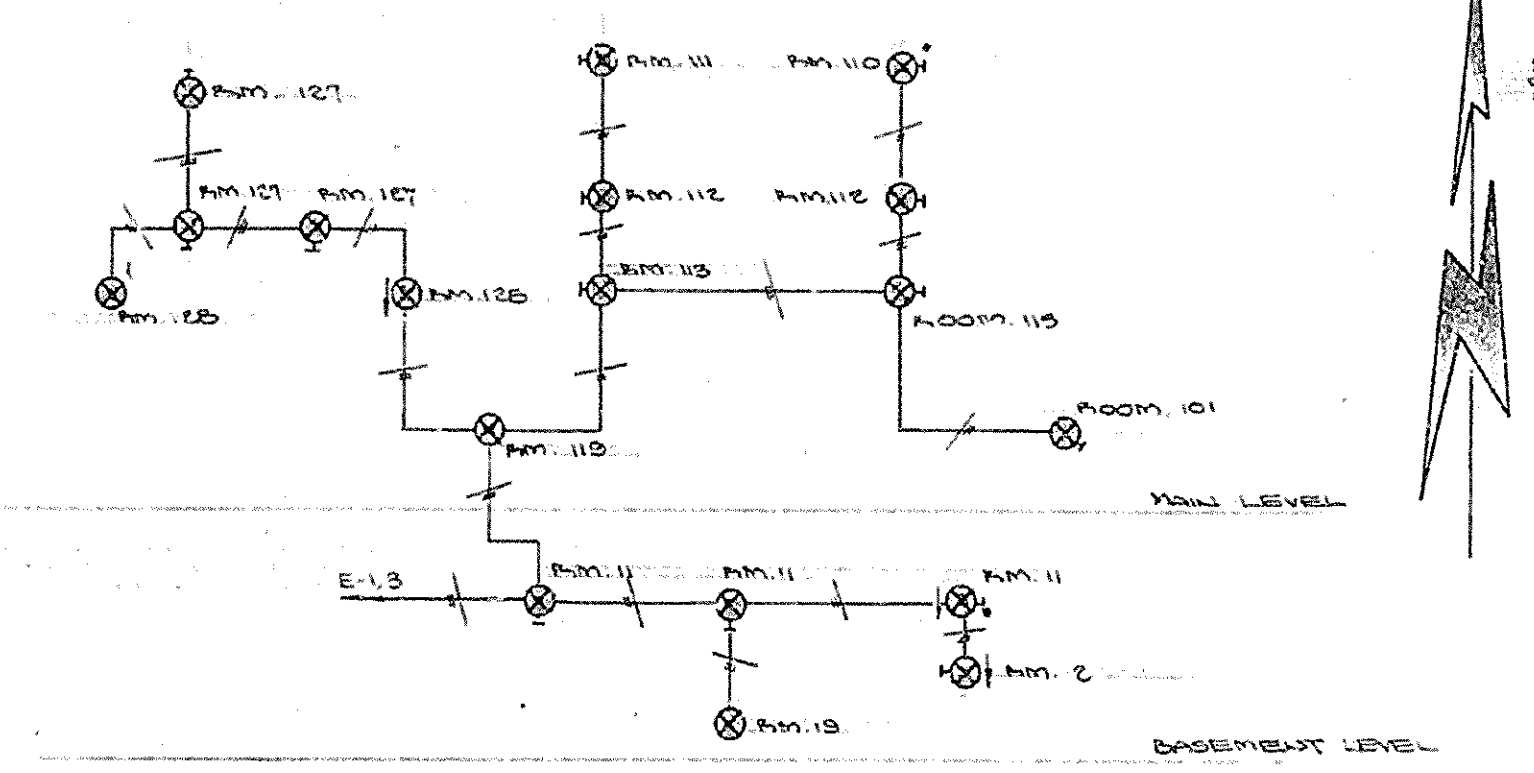


SCHEMATIC — EXIT LIGHT SYSTEM

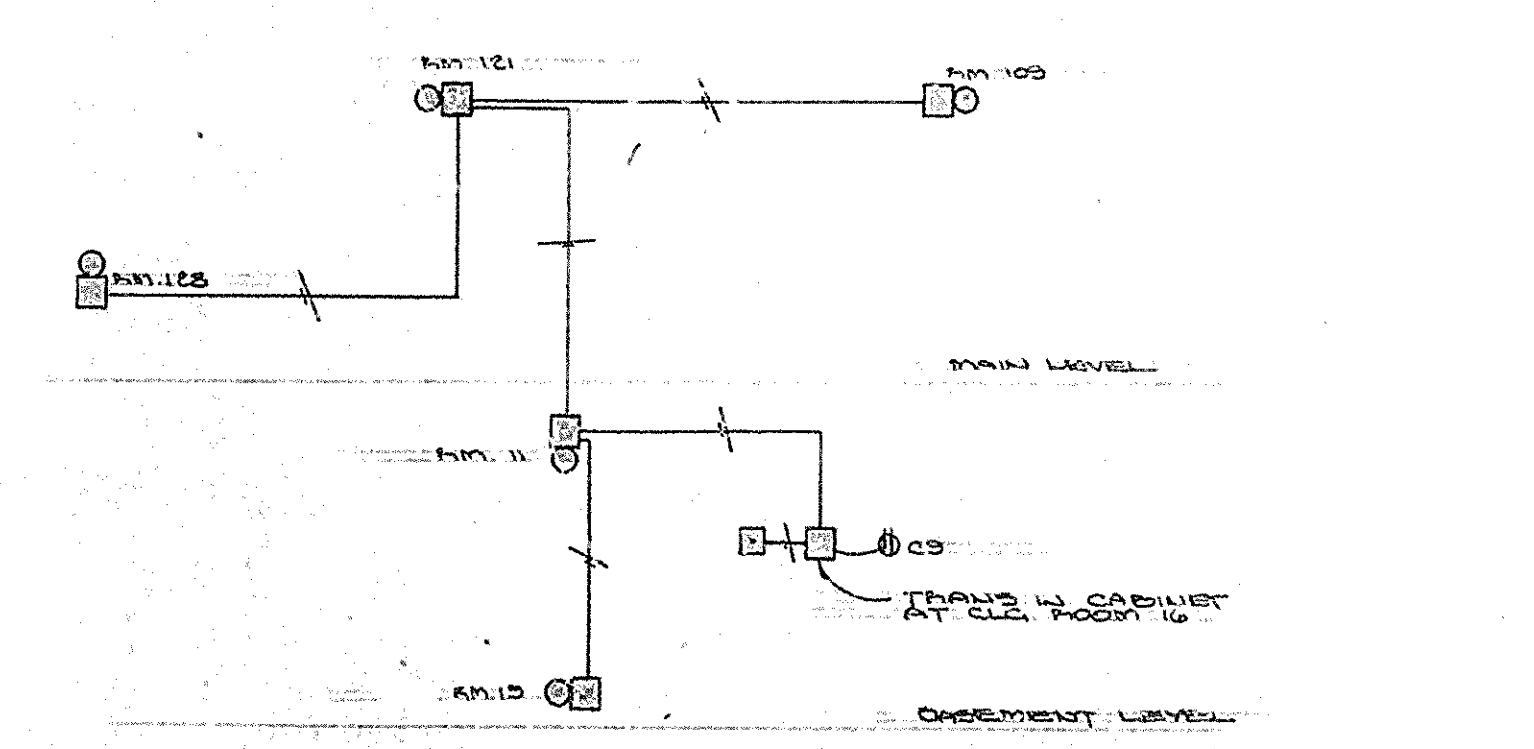

SCHEMATIC — CLASSROOM SIGNAL SYSTEM

NOTES  
 1. IN EXIST AREAS WHERE NEW FIXTURES ARE INSTALLED, EXISTING FIXTURES SHALL BE REMOVED & CEILING REPAIRS (AS PER ARCHITECT). EXISTING FIXTURES TO REMAIN PROPERTY OF THE OWNER. NEW SWITCHES, CONDUIT, OUTLETS, COVER PLATES & ALL WIRING SHALL REPLACE EXISTING SYSTEM, EXISTING CONDUIT SHALL BE USED WHERE POSSIBLE.  
 2. STAGE LIGHTS (T-1) SHALL BE SUSPENDED BY CHAIN & FLEX CONDUIT SUCH THAT THEY MAY BE LOWERED TO A POINT 3 FEET BELOW THE PROSCENIUM ARCH. COORDINATE INSTALLATION W/ STAGE CYCLOPAMA.  
 3. BORDER LIGHT TO BE SUCH AS ELECTRO-COOLS # ACM 25-60 (245/40) (PFC/20) - UN PROVIDE 24 100 WATT PAR 38 FL LAMPS - COLORS: SIX EACH RED, BLUE, AMBER, & WHITE. SUPPORT BORDER LIGHT FROM CHAIN & FLEX CONDUIT (FROM CEILING "J" BOX) LEVEL 12" ABOVE THE BOTTOM OF THE ARCH OR VALANCE (WHICHEVER IS LOWER). LEAVE SLACK SUCH THAT BORDER LIGHT MAY BE LOWERED 3 FEET BELOW ARCH.  
 4. PROVIDE CONVENIENCE OUTLET & TELEPHONE OUTLET AT LOCATION OF SOUNDAMP. (ON STAGE) COORDINATE W/ SOUND SYSTEM SUPPLIER.  
 5. MOUNT OUTLETS ON STAGE FRONT - USE STAINLESS STEEL COVER PLATE.  
 6. INSTALL 5 SWITCHES (TWO 2-WAY & THREE 1-POLE) FOR CONTROL OF CHAPEL LIGHTS.  
 7. INSTALL HEAT CABLE, FULL LENGTH, OF ALL OUTLETS & DOWN SPOOTS AS INDICATED ON THE PLANS. CABLE TO BE SECURED WITH CLIPS TO KEEP THEM APART WITH EXCESS CABLE COILED BACK INSIDE CUTTER OR DOWN SPOOTS. PROVIDE 5 CABLES AS INDICATED ON PLAN. TWO (2) ONLY 1/2" CABLE, ONE 1/2" CABLE & TWO 1/2" CABLE, EACH CABLE TO BE COMPLETE W/ A TOTAL ALL CABLE TO BE 1/2". INSTALL A DUPLEX OUTLET AT EACH CUTTER & AND CIRCUIT THRU A SWITCH IN ROOM # 10

APPROVED ENGINEER	DATE 3-28-70	PROJECT NUMBER	136892 SHEET NUMBER E-2 OF 3
HAROLD E. COLLARD ARCHITECT A.I.A. IDAHO FALLS, IDAHO		ADDITION & REMODELING OF MENAUN 1938 MENAUN 200 WHICH IS BEING USED AS A DAY CARE THE CHURCH OF JESUS CHRIST OF LATTER-DAY SAINTS. IDAHO	

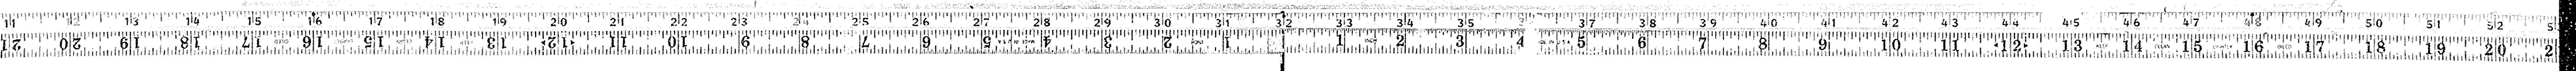




PANEL 1A		TYPE		NO. OF		VOLTS 120/240	
LOCATION ROOM 112		FLOOR MAIN		MOUNTING HUB			
MAIN 225 AMP LUGS		BOTTOM FEED		DIM 20" X 25" X 4"			
OR	BREAKER	NO. OUTLETS	LOAD	WIRE	REMARKS		
NO.	AMP/POLE	TS	C.O. MISC.	SIZE			
1	20	1	1500	12	CEILING LIGHTS		
2	20	3	1800	12	EMERGENCY LIGHTS		
3	20	3	1800	12	EMERGENCY LIGHTS		
TOTAL			11500 18700				
AMPS/PHASE (A)	142						
WIRE SIZE	3-#14		CONDUIT SIZE	2"			

LIGHT FIXTURE SCHEDULE				
TYPE	MANUFACTURER	CATALOG NO.	MOUNTING	LAMPS
1	LITHONIA	LB 240-LD	CEILING	2-F40/CV
2	LITHONIA	LB 440-LD	CEILING	4-F40/CV
3	LITHONIA	CB 140-LD	CEILING	1-F40/CV
4	ELYPHY-LITE	WAPT C237 W/60" STEA	CEILING	6-75 A
5	KIRLIN	1202	RECESSED	1-100 A
6	DAYBRITE	2X24-383-LD	CEILING	4-F20 T8/CV
7	SWIVELIER	22211 S.A. 1/2 LOWER	AS NOTED	1-150 P-SP & FL
8	DAYBRITE	22116	AS REQUIRED	AS REQUIRED
9	KIRLIN	1216-10	RECESSED	1-300 A
10	KIRLIN	4311-10	CEILING	1-300 A
11	LITHONIA	B140 HRS 1/2 AC-40	RECESSED	1-F40/CV
12	SWIVELIER	22951 SA 1/2 LOWER	CEILING	1-300 DIM 56/56
13	MARCO	B 385 VT	WALL @ T-6"	2-75 A
14	SWIVELIER	L1465	WALL @ 2'-0"	1-75 F30/FL
15	KIRLIN	1209	RECESSED	1-150 A
16	GENERAL ELECT.	GE 6740-7	CEILING	1-150 A
17	DAYBRITE	A 9740 W	WALL @ 6'-6"	2-F40/CV
18	MARCO	M.R. 61	RECESSED	1-75 A
19	MARCO	SP 31 24" STEA	CEILING	1-200 A
20	DRESCOLITE	CFX-10	CEILING	1-150 A
21	DRESCOLITE	VB-16	WALL @ T-0"	1-100 A
22	GENERAL ELECT.	CTOK-280 240 VOLT	SEE DETAIL	1-HITS 280-22
23				
24				


- 1 REFER TO PLANS FOR DIRECTIONAL ARROWS
- 2 THE FIXTURES TO BE COMPLETE W/20% LOWER & COLORED FILTERS. AS PER PLAN (A-AMBER, W-WHITE, B-BLUE, G-RED)
- 3 ALL SURFACE MOUNT FLUORESCENT FIXTURES TO HAVE LOW DENSITY PATENT POLY CARBONATE MOUNTS TO COMBUSTIBLE CEILING TILE.

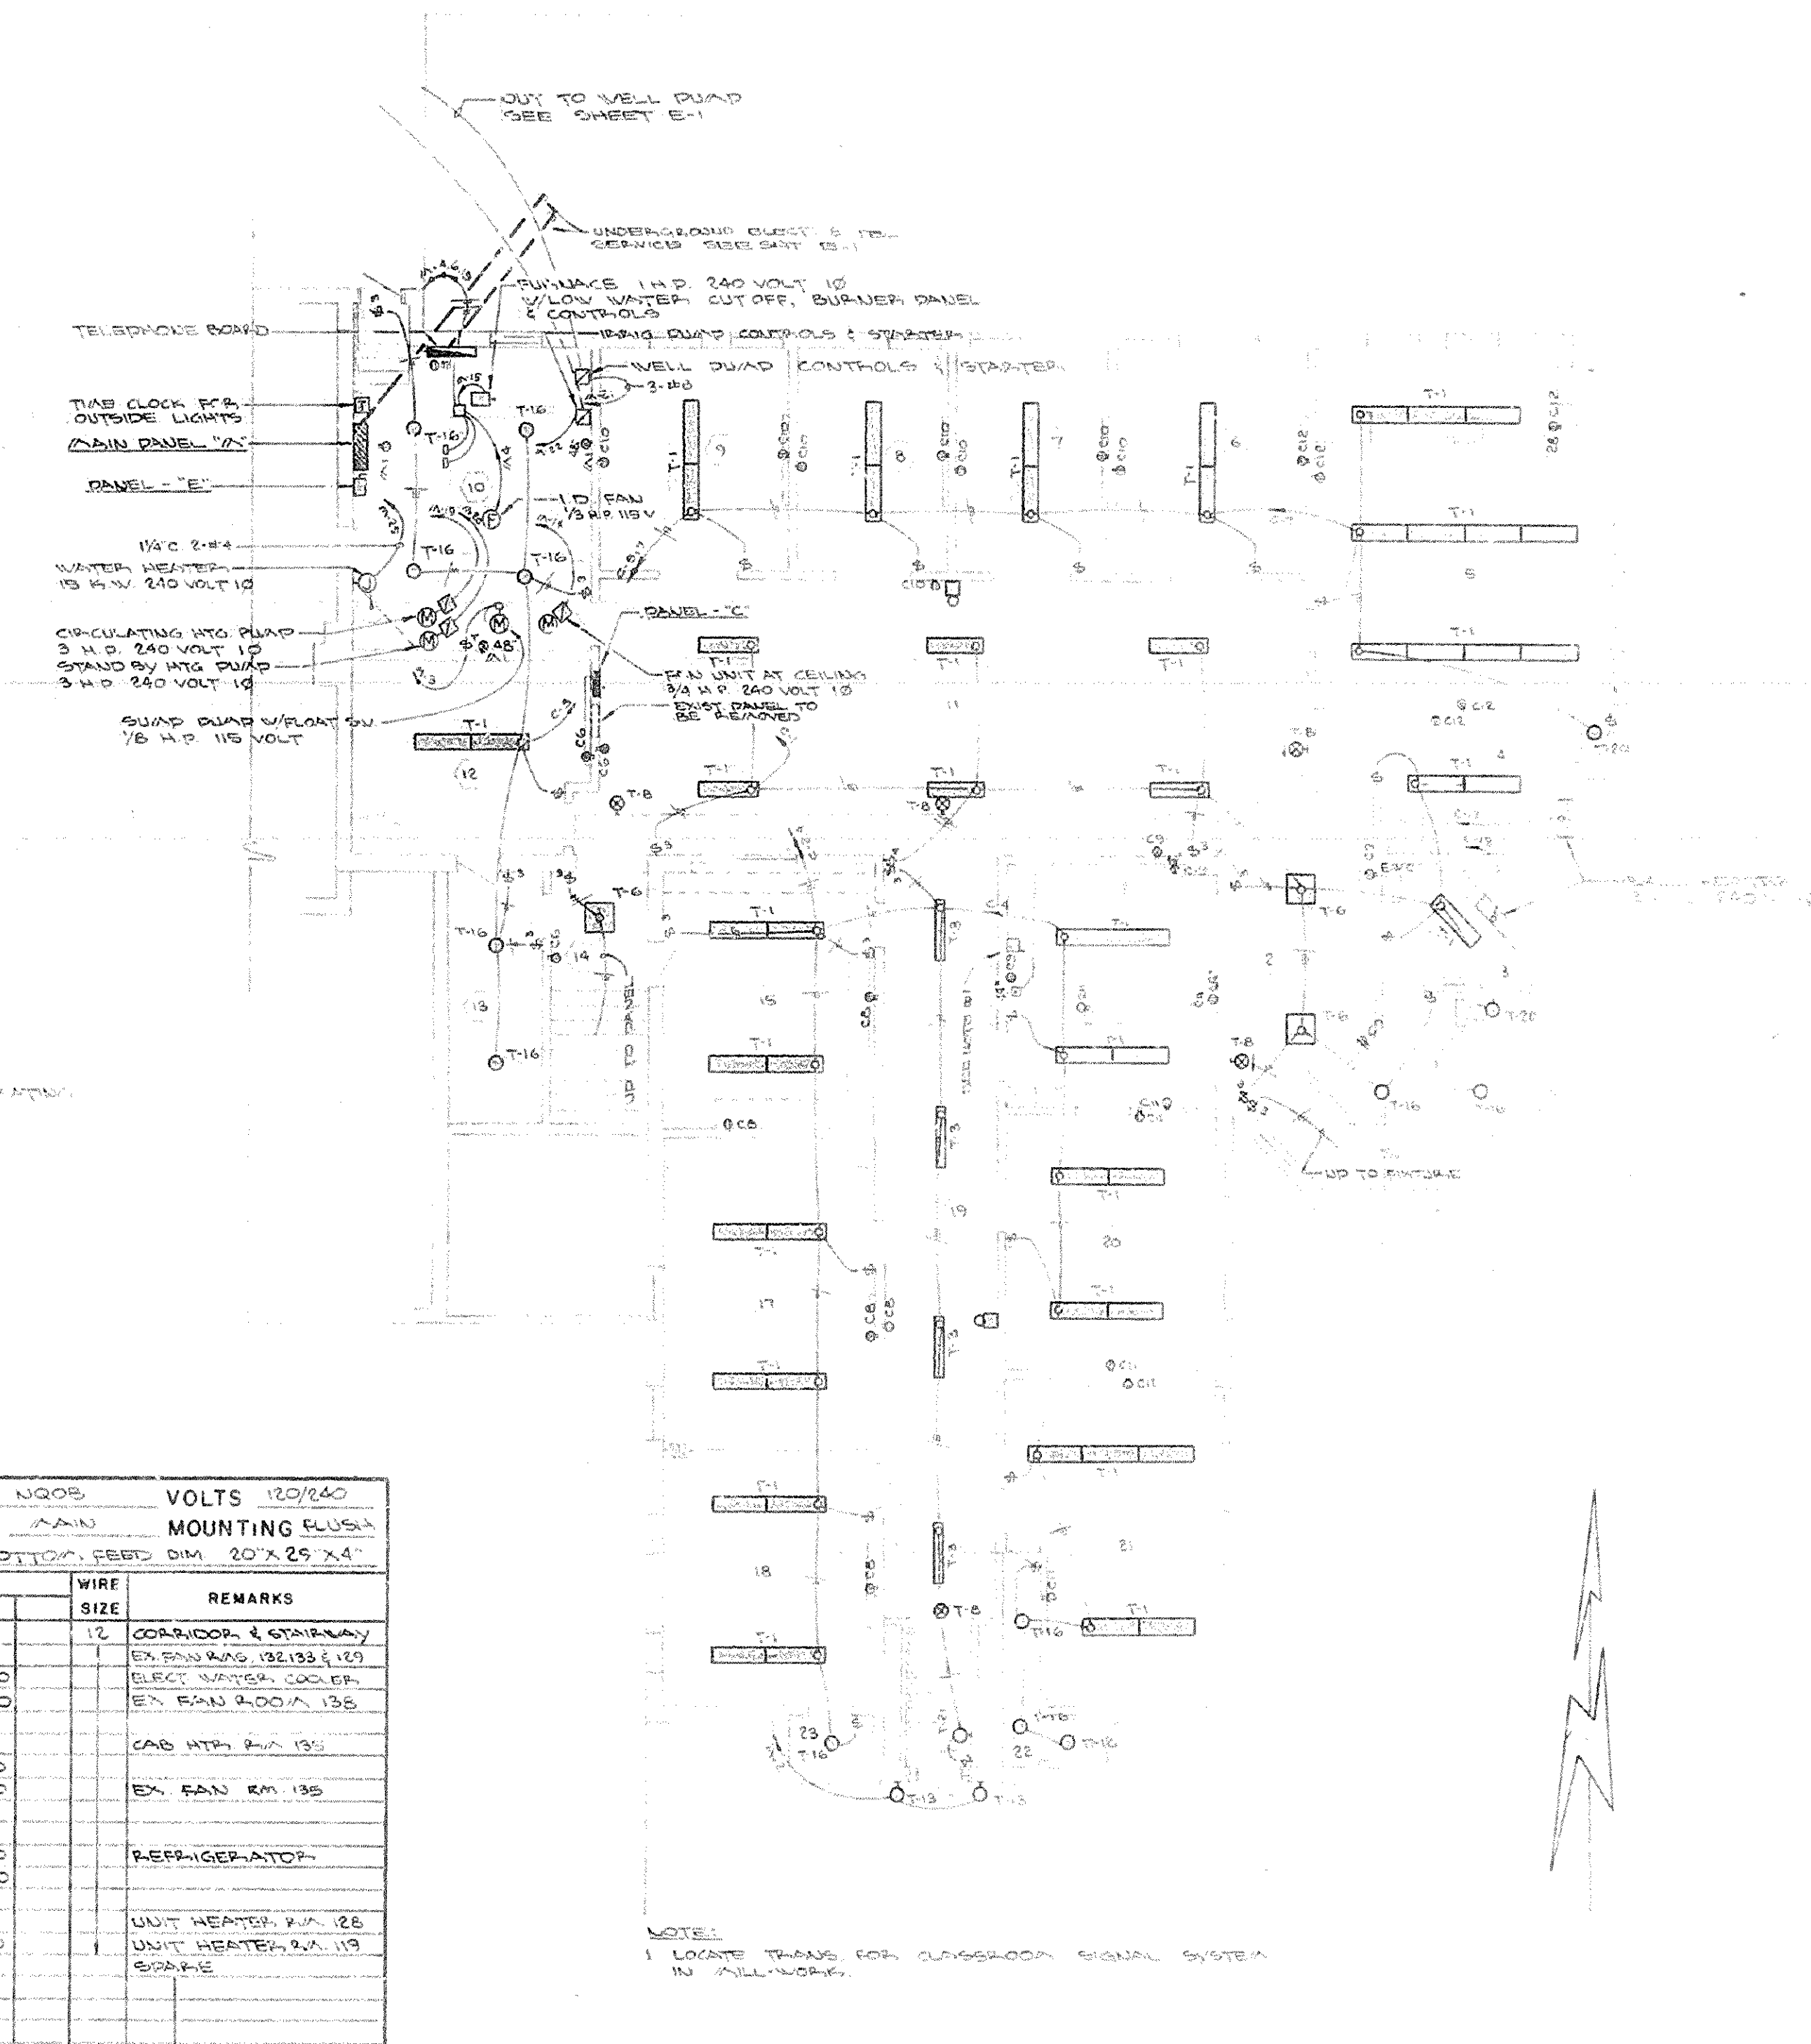

PANEL 1B		TYPE		NO. OF		VOLTS 120/240	
LOCATION ROOM 112		FLOOR MAIN		MOUNTING HUB			
MAIN 225 AMP LUGS		BOTTOM FEED		DIM 20" X 25" X 4"			
1	20	1	1500	12	CULTURAL WALL		
2	20	3	1800	12	EMERGENCY LIGHTS		
3	20	3	1800	12	EMERGENCY LIGHTS		
TOTAL			11500 18700				
AMPS/PHASE (A)	142						
WIRE SIZE	3-#14		CONDUIT SIZE	2"			

PANEL 1C		TYPE		NO. OF		VOLTS 120/240	
LOCATION ROOM 112		FLOOR BASEMENT		MOUNTING HUB			
MAIN 100 AMP LUGS		BOTTOM FEED		DIM 20" X 25" X 4"			
1	20	1	1500	12			
2	20	1	1600	12			
3	20	1	1100	12			
4	20	1	1150	12			
5	20	1	800	12			
6	20	1	1000	12			
7	20	1	1250	12			
8	20	1	1000	12			
9	20	1	1000	12	SIGNAL SYSTEM (ENC)		
10	20	1	1000	12			
11	20	1	1000	12			
12	20	1	1000	12			
13	20	1	1000	12			
14	20	1	1000	12			
15	20	1	1000	12			
16	20	1	1000	12			
17	20	1	1500	12	WALL HEATER R/A 4		
18	20	1	1500	12	R/A 5		
19	20	1	1000	12			
20	20	1	1000	12			
TOTAL			10000 10100				
AMPS/PHASE (A)	82						
WIRE SIZE	3-#14		CONDUIT SIZE	1 1/2"			

PANEL 1D		TYPE		NO. OF		VOLTS 120/240	
LOCATION ROOM 120		FLOOR MAIN		MOUNTING HUB			
MAIN 225 AMP LUGS		BOTTOM FEED		DIM 20" X 25" X 4"			
1	20	1	1100	12	COORNDOP & STAIRWAY		
2	20	1	1800	12	EX FAN R/OOM 128		
3	20	1	1000	12	ELECT WATER COOLDR		
4	20	1	1600	12	EX FAN R/OOM 135		
5	20	1	1000	12			
6	20	1	500	12	CAB WITH R/A 135		
7	20	1	1000	12			
8	20	1	1000	12	EX FAN R/A 135		
9							

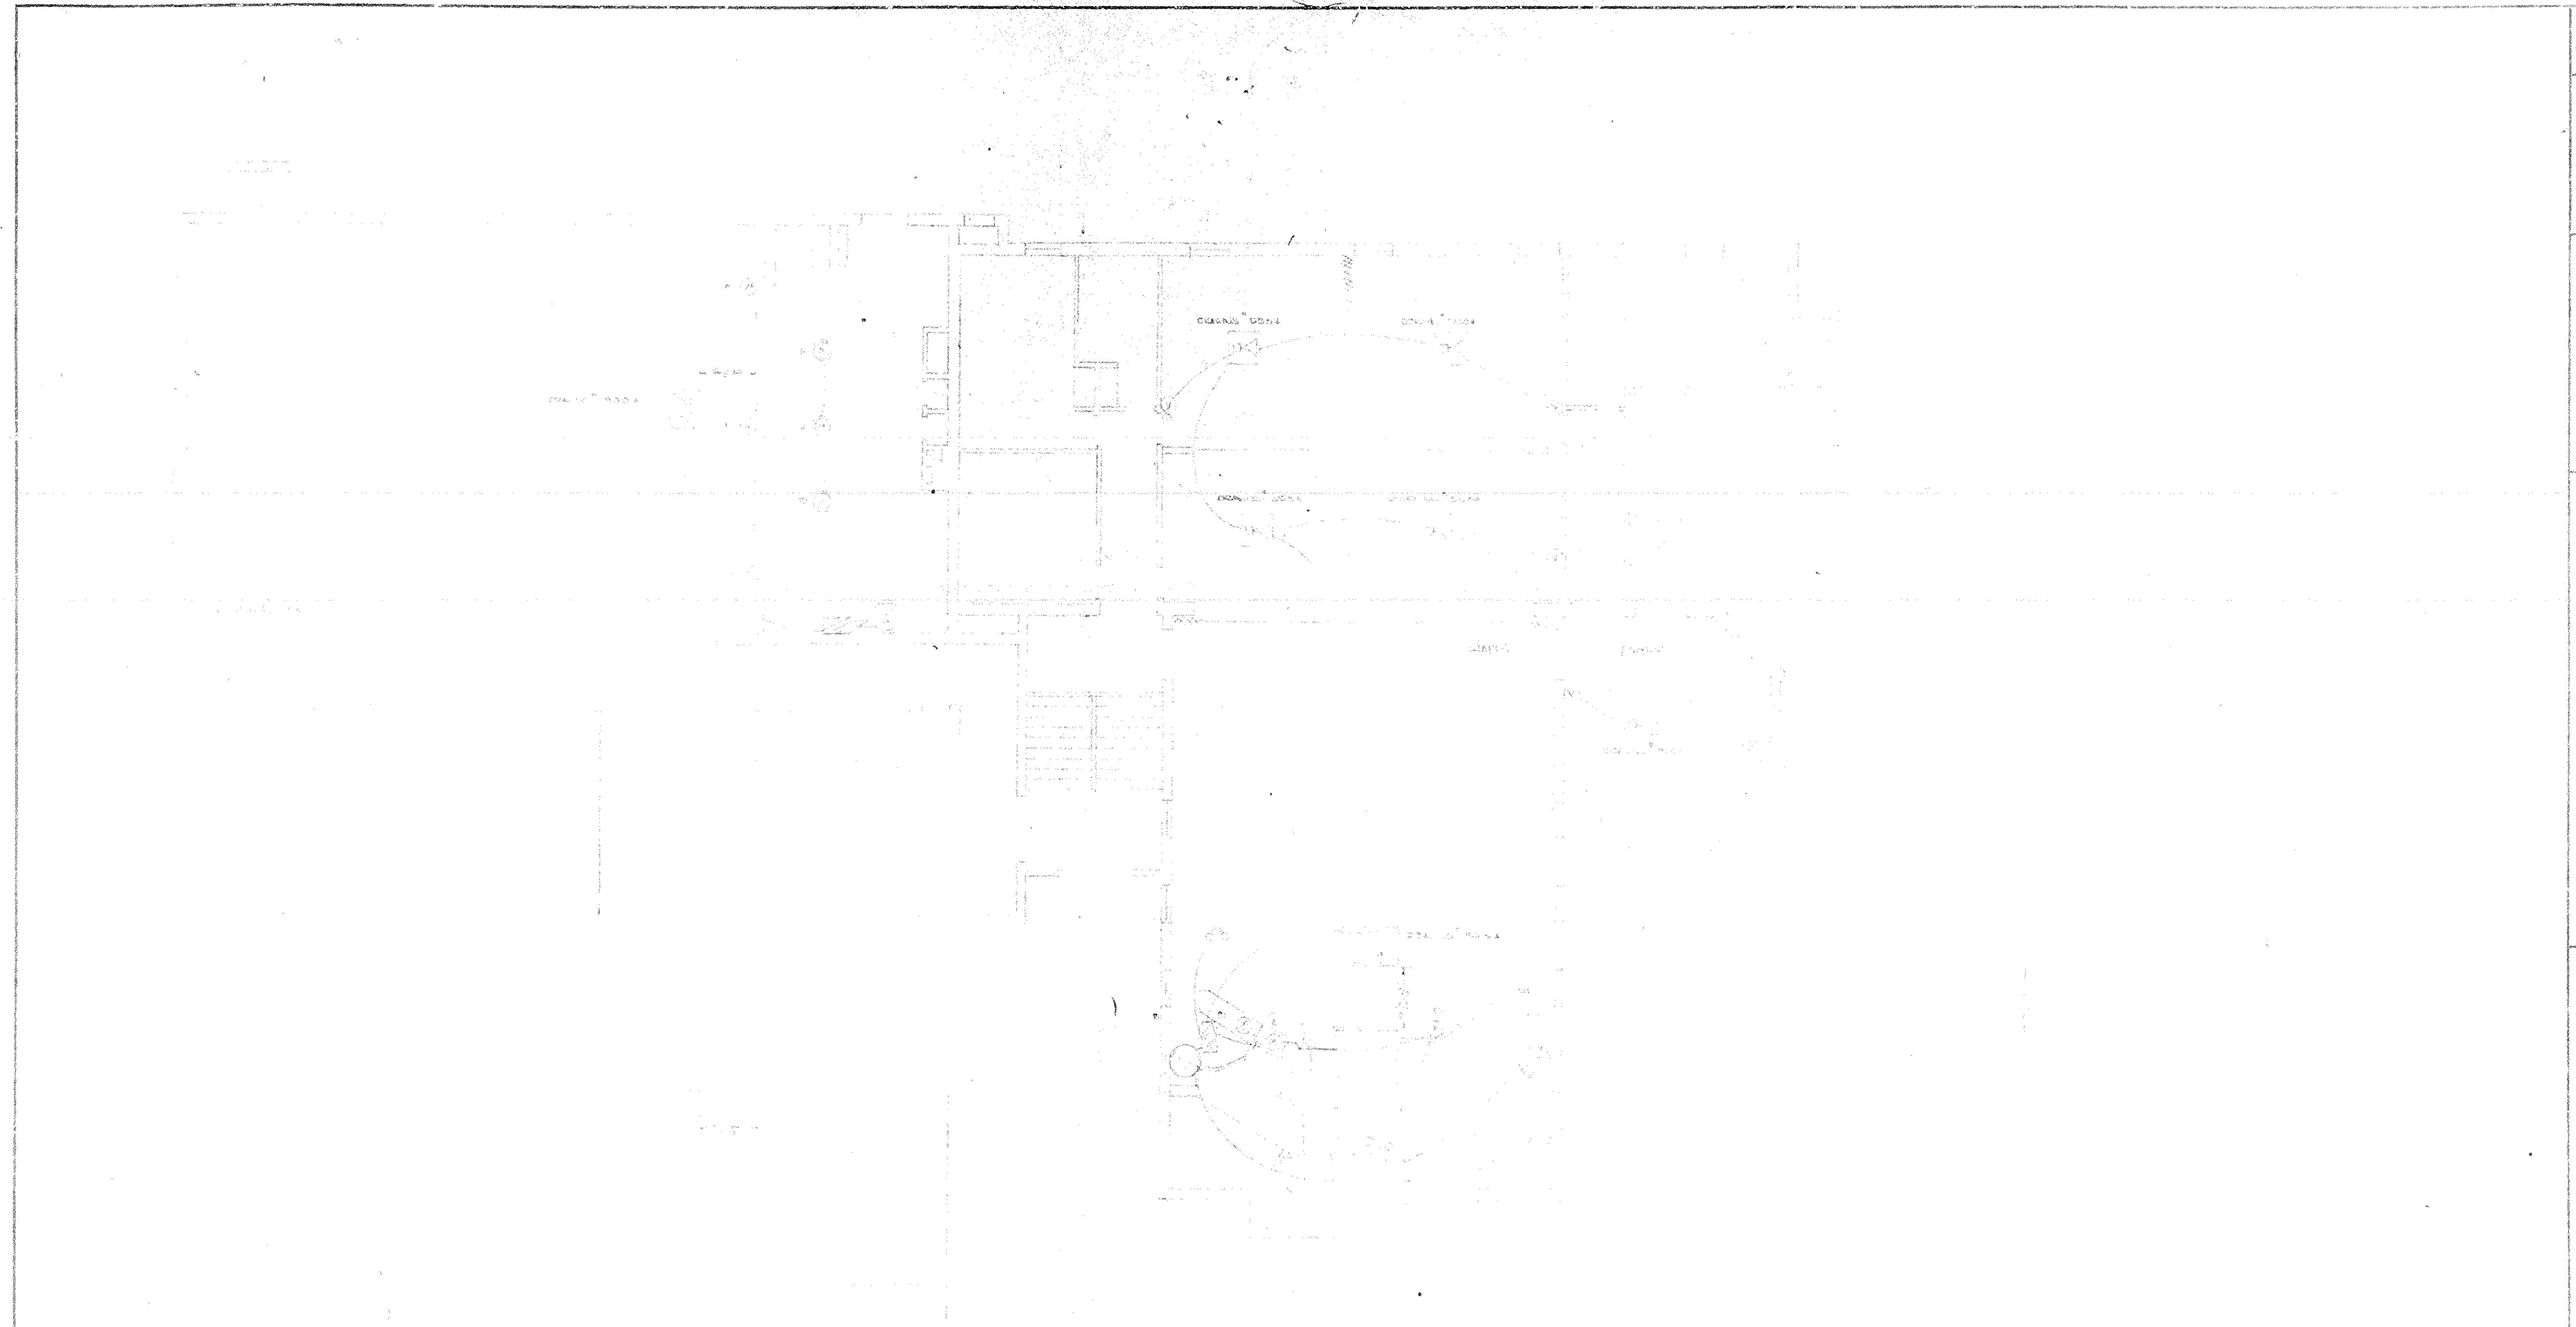

DOUBLE CHECK SYMBOLS

- SYMBOL
- ELECTRICAL SYMBOL
- WALLS CONTROL BOX (2000 1/2 DIA X 12 1/2 H) MULTIPHONE OUTLET
- CEILING MICROPHONE OUTLET
- WALL EXPOSED BOUNDARY
- CEILING EXPOSED BOUNDARY
- POINT TWO WAY SYSTEM WITH 1/2 IN DIA TUBING
- TWO WAY WOODWORKED SYSTEM

LIST OF APPROVED BIDDERS

- ELECTRO DESIGN  
1225 MAJOR  
SALT LAKE CITY, UTAH
- G.D.R. ELECTRO SYSTEMS  
128 SO. 20th EAST  
SALT LAKE CITY, UTAH
- GENERAL COMMUNICATIONS  
612 E. 3500 SOUTH  
SALT LAKE CITY, UTAH
- EVANS SUPPLY CO.  
503 W. 2ND NORTH  
SALT LAKE CITY, UTAH
- GENE'S RADIO & SOUND  
RT. 1 BOX 201  
IDAHO FALLS, IDAHO 83401
- NORM B. SCHREIER  
1047 CANAL AVE.  
IDAHO FALLS, IDAHO 83401

ALL SYMBOLS SHALL BE IN ACCORDANCE WITH THE UTAH BUILDING CODE.

FOR THE PURPOSES OF THIS BIDDING PROCESS, THE BIDDERS SHALL BE REQUIRED TO PROVIDE A LIST OF ALL SUBCONTRACTORS TO BE USED IN THE PROJECT AND TO OBTAIN ALL NECESSARY PERMITS AND APPROVALS.

THE BIDDERS SHALL BE RESPONSIBLE FOR OBTAINING ALL NECESSARY PERMITS AND APPROVALS FROM THE LOCAL AUTHORITIES.

336004

THE OFFICE OF ARCHITECTURE, PLANNING & ENGINEERING DEPARTMENT  
SALT LAKE CITY, UTAH

OFFICE OF THE BUILDING COMMITTEE  
SALT LAKE CITY, UTAH


DATE: \_\_\_\_\_

REVISIONS: \_\_\_\_\_

NO. OF SHEETS: \_\_\_\_\_

SHEET NO. \_\_\_\_\_

CI

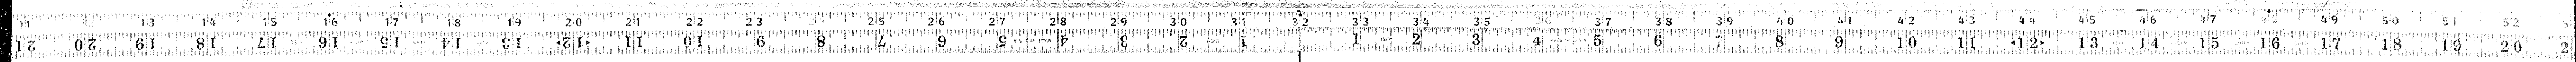



# MENAN 1, 2

# MENAN IDAHO STAKE

MENAN,

MAIN & BROADWAY


IDAHO

PROPERTY #: 507 - 2638

APRIL 1995

AS-BUILT  
RECORD DRAWINGS  
25 JULY 1996

THE CHURCH OF  
JESUS CHRIST  
OF LATTER-DAY  
SAINTS

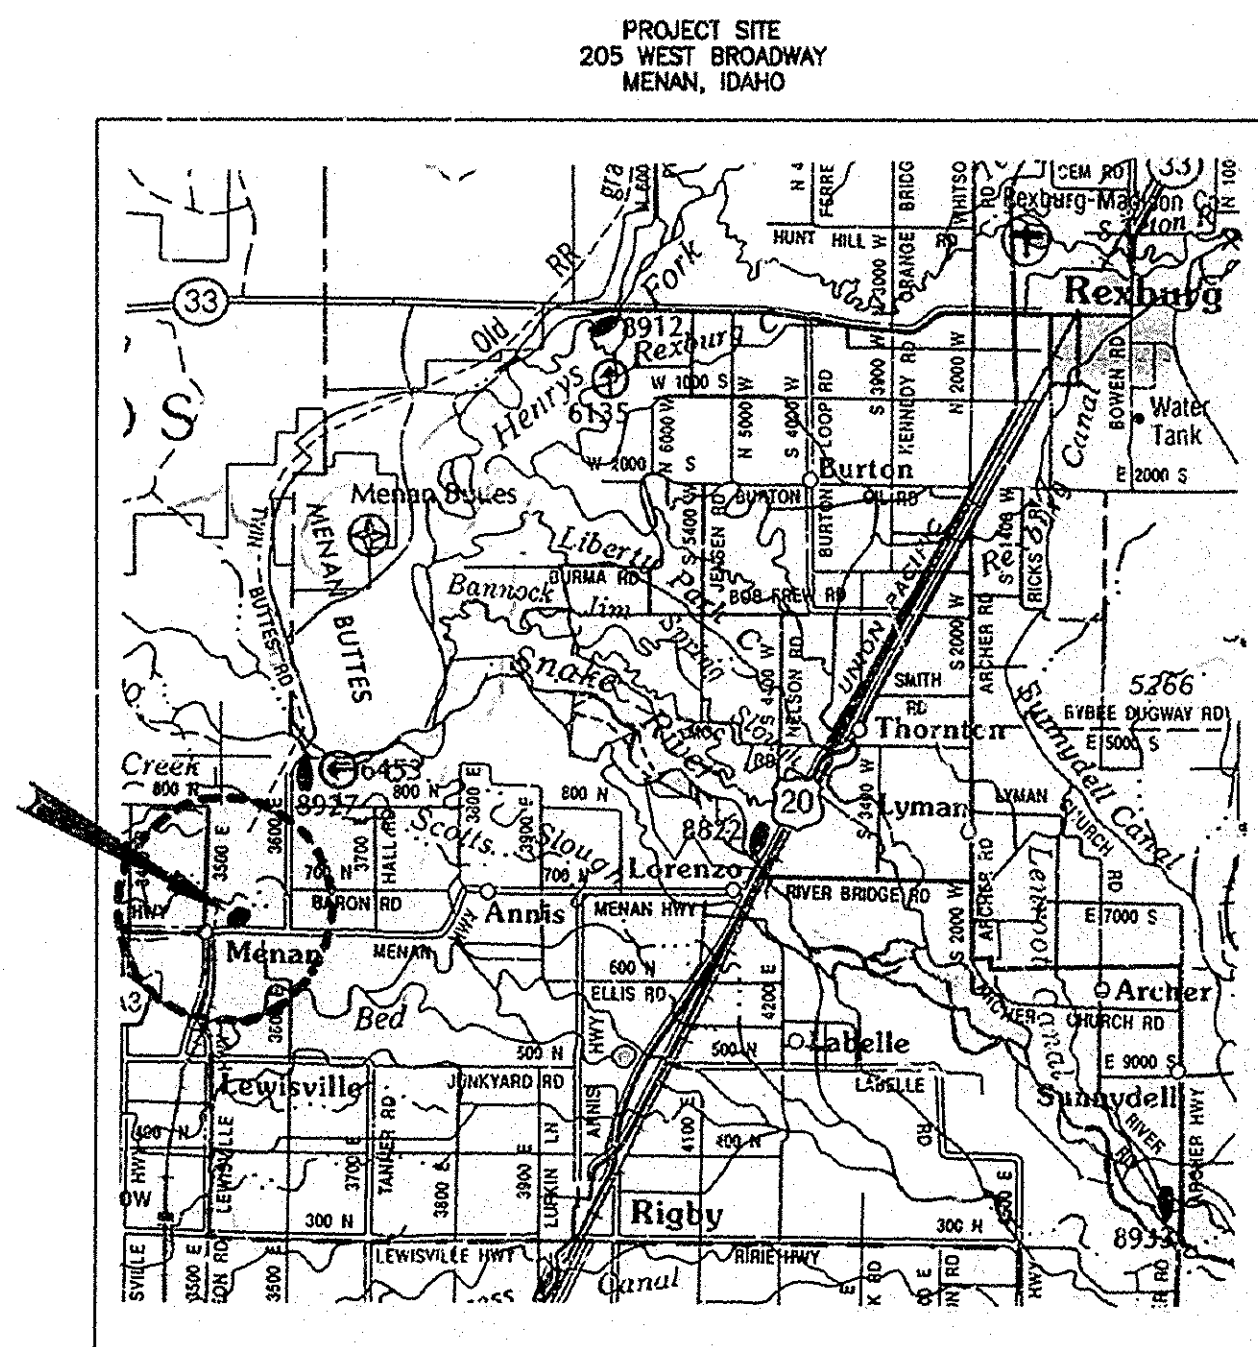

AREA MAP

DATE	DESCRIPTION	SIGNATURE
	CONSULTANT COORDINATION MEETING APP'RS OR ARCHITECT/ARCHITECTURAL COORDINATOR'S SIGNATURE REQUIRED.	<i>[Signature]</i>
	THIS IS TO CERTIFY THAT THE STAKE/MISSION PRESIDENT HAS REVIEWED THESE DRAWINGS AND SPECIFICATIONS AND FINDS THEM ACCEPTABLE AND IS IN CONCURRENCE. STAKE PRESIDENT'S SIGNATURE REQUIRED.	<i>[Signature]</i>
	DOCUMENTS HAVE BEEN REVIEWED BY GOVERNMENTAL JURISDICTIONS AND PERMITS ARE SECURED. CONTRACT ARCHITECT'S SIGNATURE REQUIRED.	<i>[Signature]</i>



**JRW**


&  
ASSOCIATES

ARCHITECTURE - ENGINEERING  
CONSTRUCTION MANAGEMENT


(208) 359-2309  
Fax (208) 359-2271

49 PROFESSIONAL PLAZA  
REXBURG, IDAHO 83440

DRAWING INDEX	
GENERAL	
C-1	COVER SHEET & INDEX TO DRAWINGS
SITE DEVELOPMENT	
SD-1	SITE PLAN
ARCHITECTURAL	
A-1	FLOOR PLANS
A-2	ELEVATIONS, DETAILS, SECTIONS, SCHEDULES
A-3	REFLECTED CEILING PLANS
MECHANICAL	
M-1	FLOOR PLAN MECHANICAL
ELECTRICAL	
E-1	FLOOR PLAN ELECTRICAL

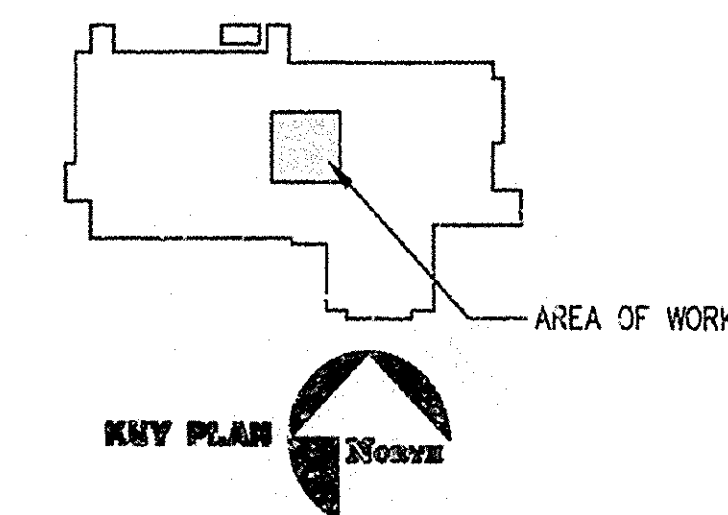

07552

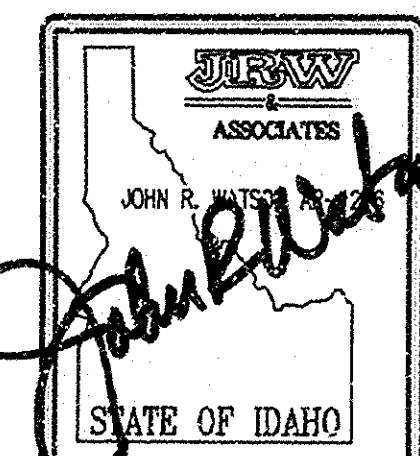

JOHN R. WATSON  
ARCHITECTURE - ENGINEERING  
CONSTRUCTION MANAGEMENT  
100 W. WATSON  
REXBURG, IDAHO 83400  
PH (208) 359-2271

CONSULTANTS:  
CIVIL ENGINEERING  
ROBERT L. LEWITT  
595 No. Capitol  
Boise Falls, Idaho 83405  
(208) 524-0212  
MECHANICAL ENGINEERING  
ENGINEERED SYSTEMS ASSOC.  
315 West Center  
Pocatello, Idaho 83201  
(208) 233-0501  
Fax (208) 233-1529  
ELECTRICAL ENGINEERING  
ENGINEERED SYSTEMS ASSOC.  
315 West Center  
Pocatello, Idaho 83201  
(208) 233-0501  
Fax (208) 233-1529

PROJECT:  
DRAWING TITLE:  
MENAN IDAHO STAKE  
COVER SHEET AND INDEX TO DRAWINGS

REG. NO. 4-18-84	PROJECT NO. 9413-01-013	JOB NO. 1-8	DATE: APRIL 1995
DRAWN BY: RENSAEGRE	CHECKED BY: JRW		
DRAWING NO. C-1	OF 1		

24X







**GENERAL NOTES**

- (A) CONTRACTOR & SUBCONTRACTOR SHALL FIELD VERIFY DIMENSIONS, EXISTING CONDITIONS & AREAS AFFECTED BY CONSTRUCTION PRIOR TO SUBMISSION OF BIDS & BEFORE COMMENCING WORK. NOTIFY ARCHITECT IMMEDIATELY OF CONDITIONS OR PROBLEMS NOT IN ACCORDANCE WITH CONTRACT DOCUMENTS.
- (B) CONTRACTOR IS RESPONSIBLE FOR REPAIRS DUE TO DAMAGE OF EXISTING WORK AS A RESULT OF NEW WORK. MATCH EXISTING MATERIALS / FINISHES WHERE REPAIRS ARE NECESSARY & AS DIRECTED BY ARCHITECT.
- (C) REMOVE RUBBISH / DEBRIS FROM PROPERTY. DISPOSE OF TRASH PROPERLY USING APPROVED DISPOSAL SITES FOR TYPE OF MATERIAL ENCOUNTERED. CONSULT LOCAL AUTHORITIES AS REQUIRED.
- (D) VERIFY LOCATION OF EXISTING UTILITIES WITH LOCAL AUTHORITIES. UNDERGROUND UTILITIES HAVE NOT BEEN INDEPENDENTLY VERIFIED BY OWNER OR ITS REPRESENTATIVE. CONTRACTOR SHALL DETERMINE LOCATION OF EXISTING UTILITIES BEFORE COMMENCING WORK AND SHALL BE RESPONSIBLE FOR DAMAGES OCCASIONED BY FAILURE TO LOCATE AND PRESERVE UTILITY LINES.
- (E) BASE BID TO INCLUDE 1500 LINEAL FEET OF CRACK REPAIR.

**PLAN NOTES**

- (1) EXTEND ASPHALT PAVING
- (2) PAINT STRIPES TO BE 4" WIDE - TYPICAL.
- (3) SHADED AREA INDICATES EXTENT OF PARKING AREA TO BE SEALED, CRACK REPAIRED & RE-STRIPED
- (4) REMOVE EXISTING DAMAGED PAVEMENT AND BASE TO 30" BELOW ASPHALT. INSTALL COMPACTED SUB-BASE & BASE. INSTALL NEW ASPHALT.
- (5) NOT USED
- (6) NOT USED
- (7) PAINT STRIPES 4" WIDE AND 2'-0" O.C. DIAGONAL LINES.
- (8) STRIP EXISTING VEGETATION LAYER & TOP SOIL LAYER AS REQUIRED.
- (9) NOT USED
- (10) REMOVE EXISTING TREE STUMP
- (11) REPAIR EXISTING PAVEMENT CUT & FILL IN WITH NEW ASPHALT.
- (12) MATCH EXISTING ELEVATION.
- (13) BUILD UP NEW ASPHALT GRADE ELEVATION 5' ABOVE EXISTING.

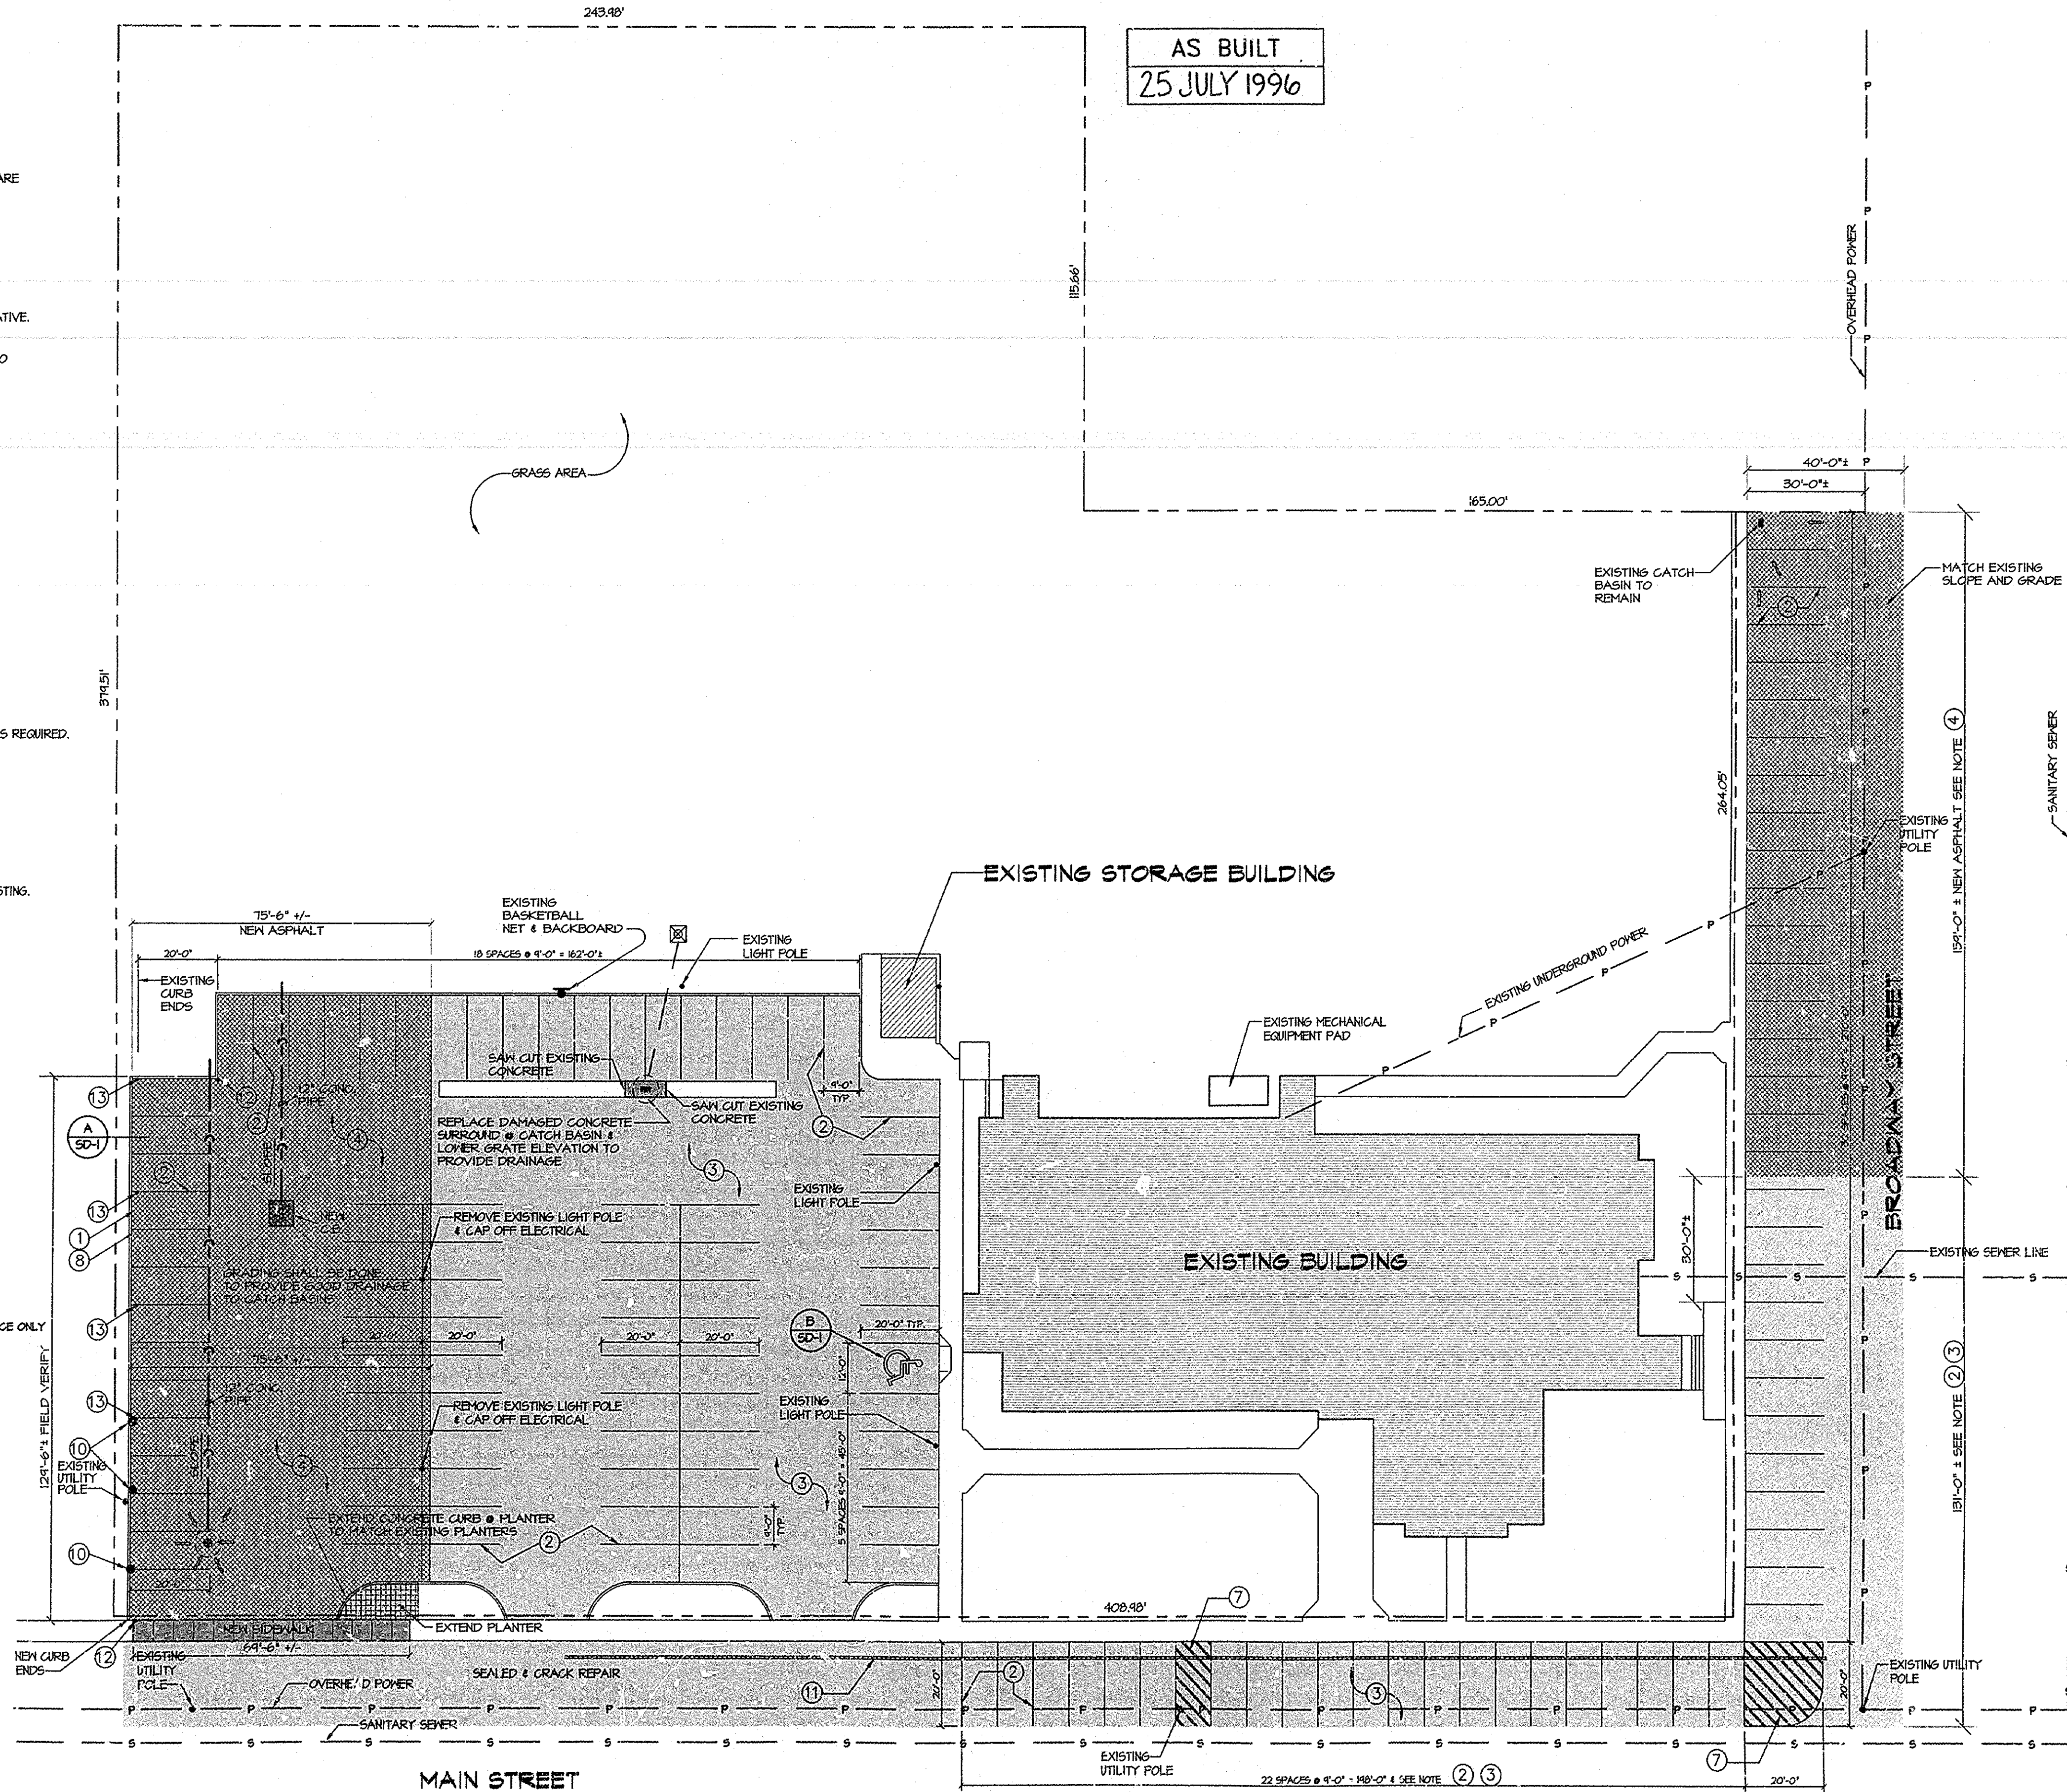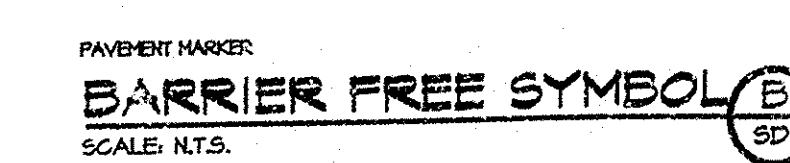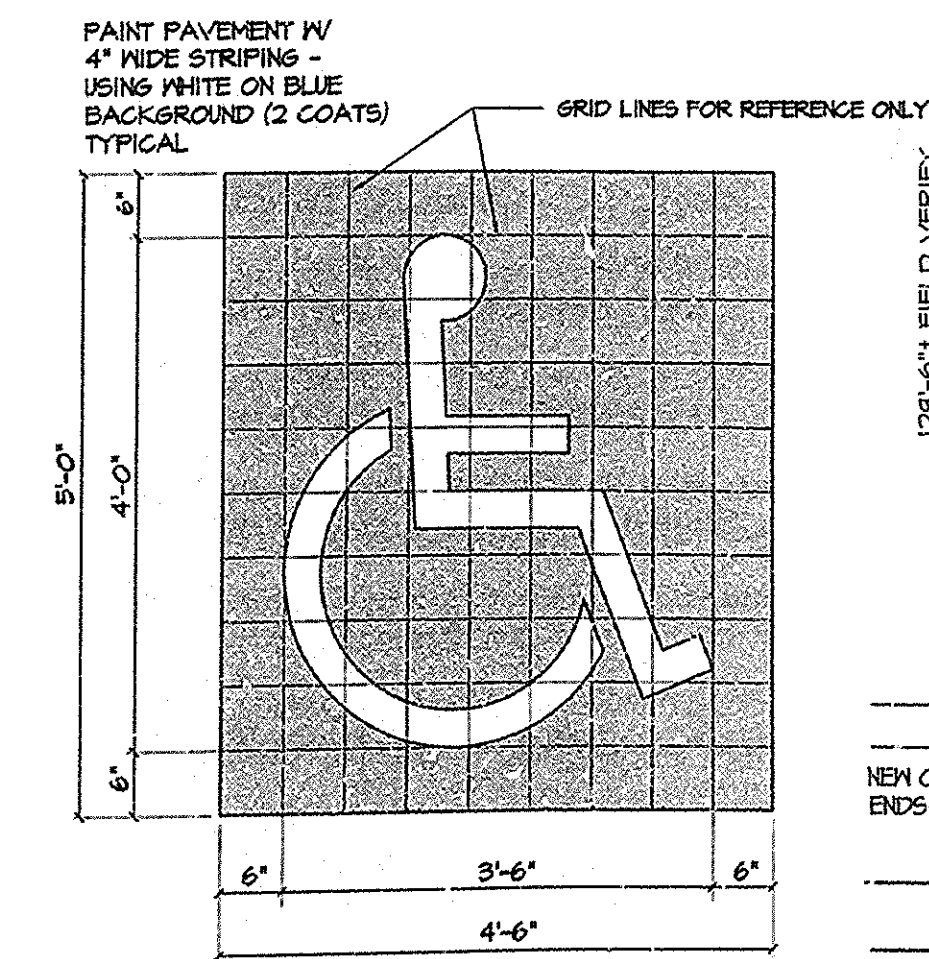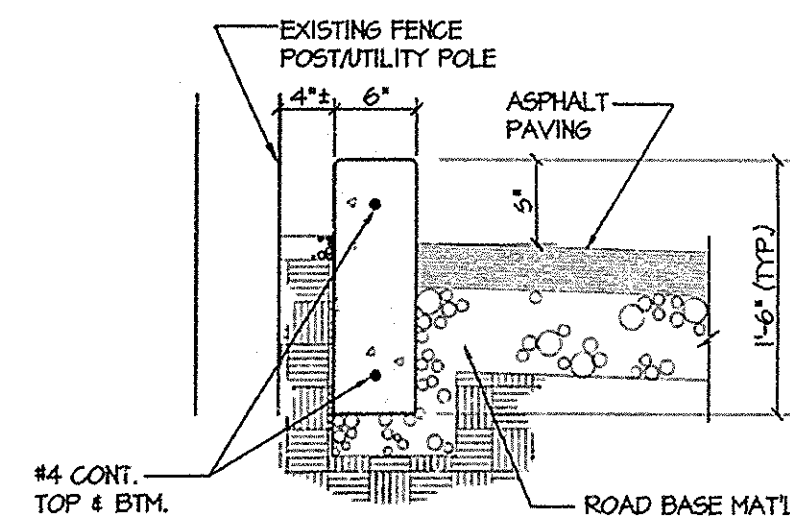

**JRW ASSOCIATES**  
JOHN F. WATSON AR-1276  
STATE OF IDAHO

**JRW ASSOCIATES**  
ARCHITECTURE-ENGINEERING-CONSTRUCTION MANAGEMENT  
JOHN F. WATSON  
1000 SHILOH DRIVE  
BOZEMAN, MONT. 59717  
PHONE (406) 338-0501

**CONSULTANTS:**

**CIVIL ENGINEERING**  
HARPER - LEAVY  
895 No. Capitol  
P.O. Box 50801  
Idaho Falls, Idaho 83405  
(208) 324-0212

**MECHANICAL ENGINEERING**  
ENGINEERED SYSTEMS ASSOC.  
315 West Center  
Pocatello, Idaho 83201  
(208) 233-0201  
Fax (208) 233-0529

**ELECTRICAL ENGINEERING**  
ENGINEERED SYSTEMS ASSOC.  
315 West Center  
Pocatello, Idaho 83201  
(208) 233-0201  
Fax (208) 233-0529

---

**PROJECT:** MENAN, 1, 2  
**MENAN IDAHO STAKE**  
IDAHO

**DRAWING TITLE:** SITE PLAN

---



**DATE:** 9-3-85  
**PROJECT NO.:** 9413-01-013  
**DATE:** 1-2-90

**DRAWN BY:** RWS  
**CHECKED BY:** JWS

**DRAWING NO.:** SD-1  
**OF:** 1



24X



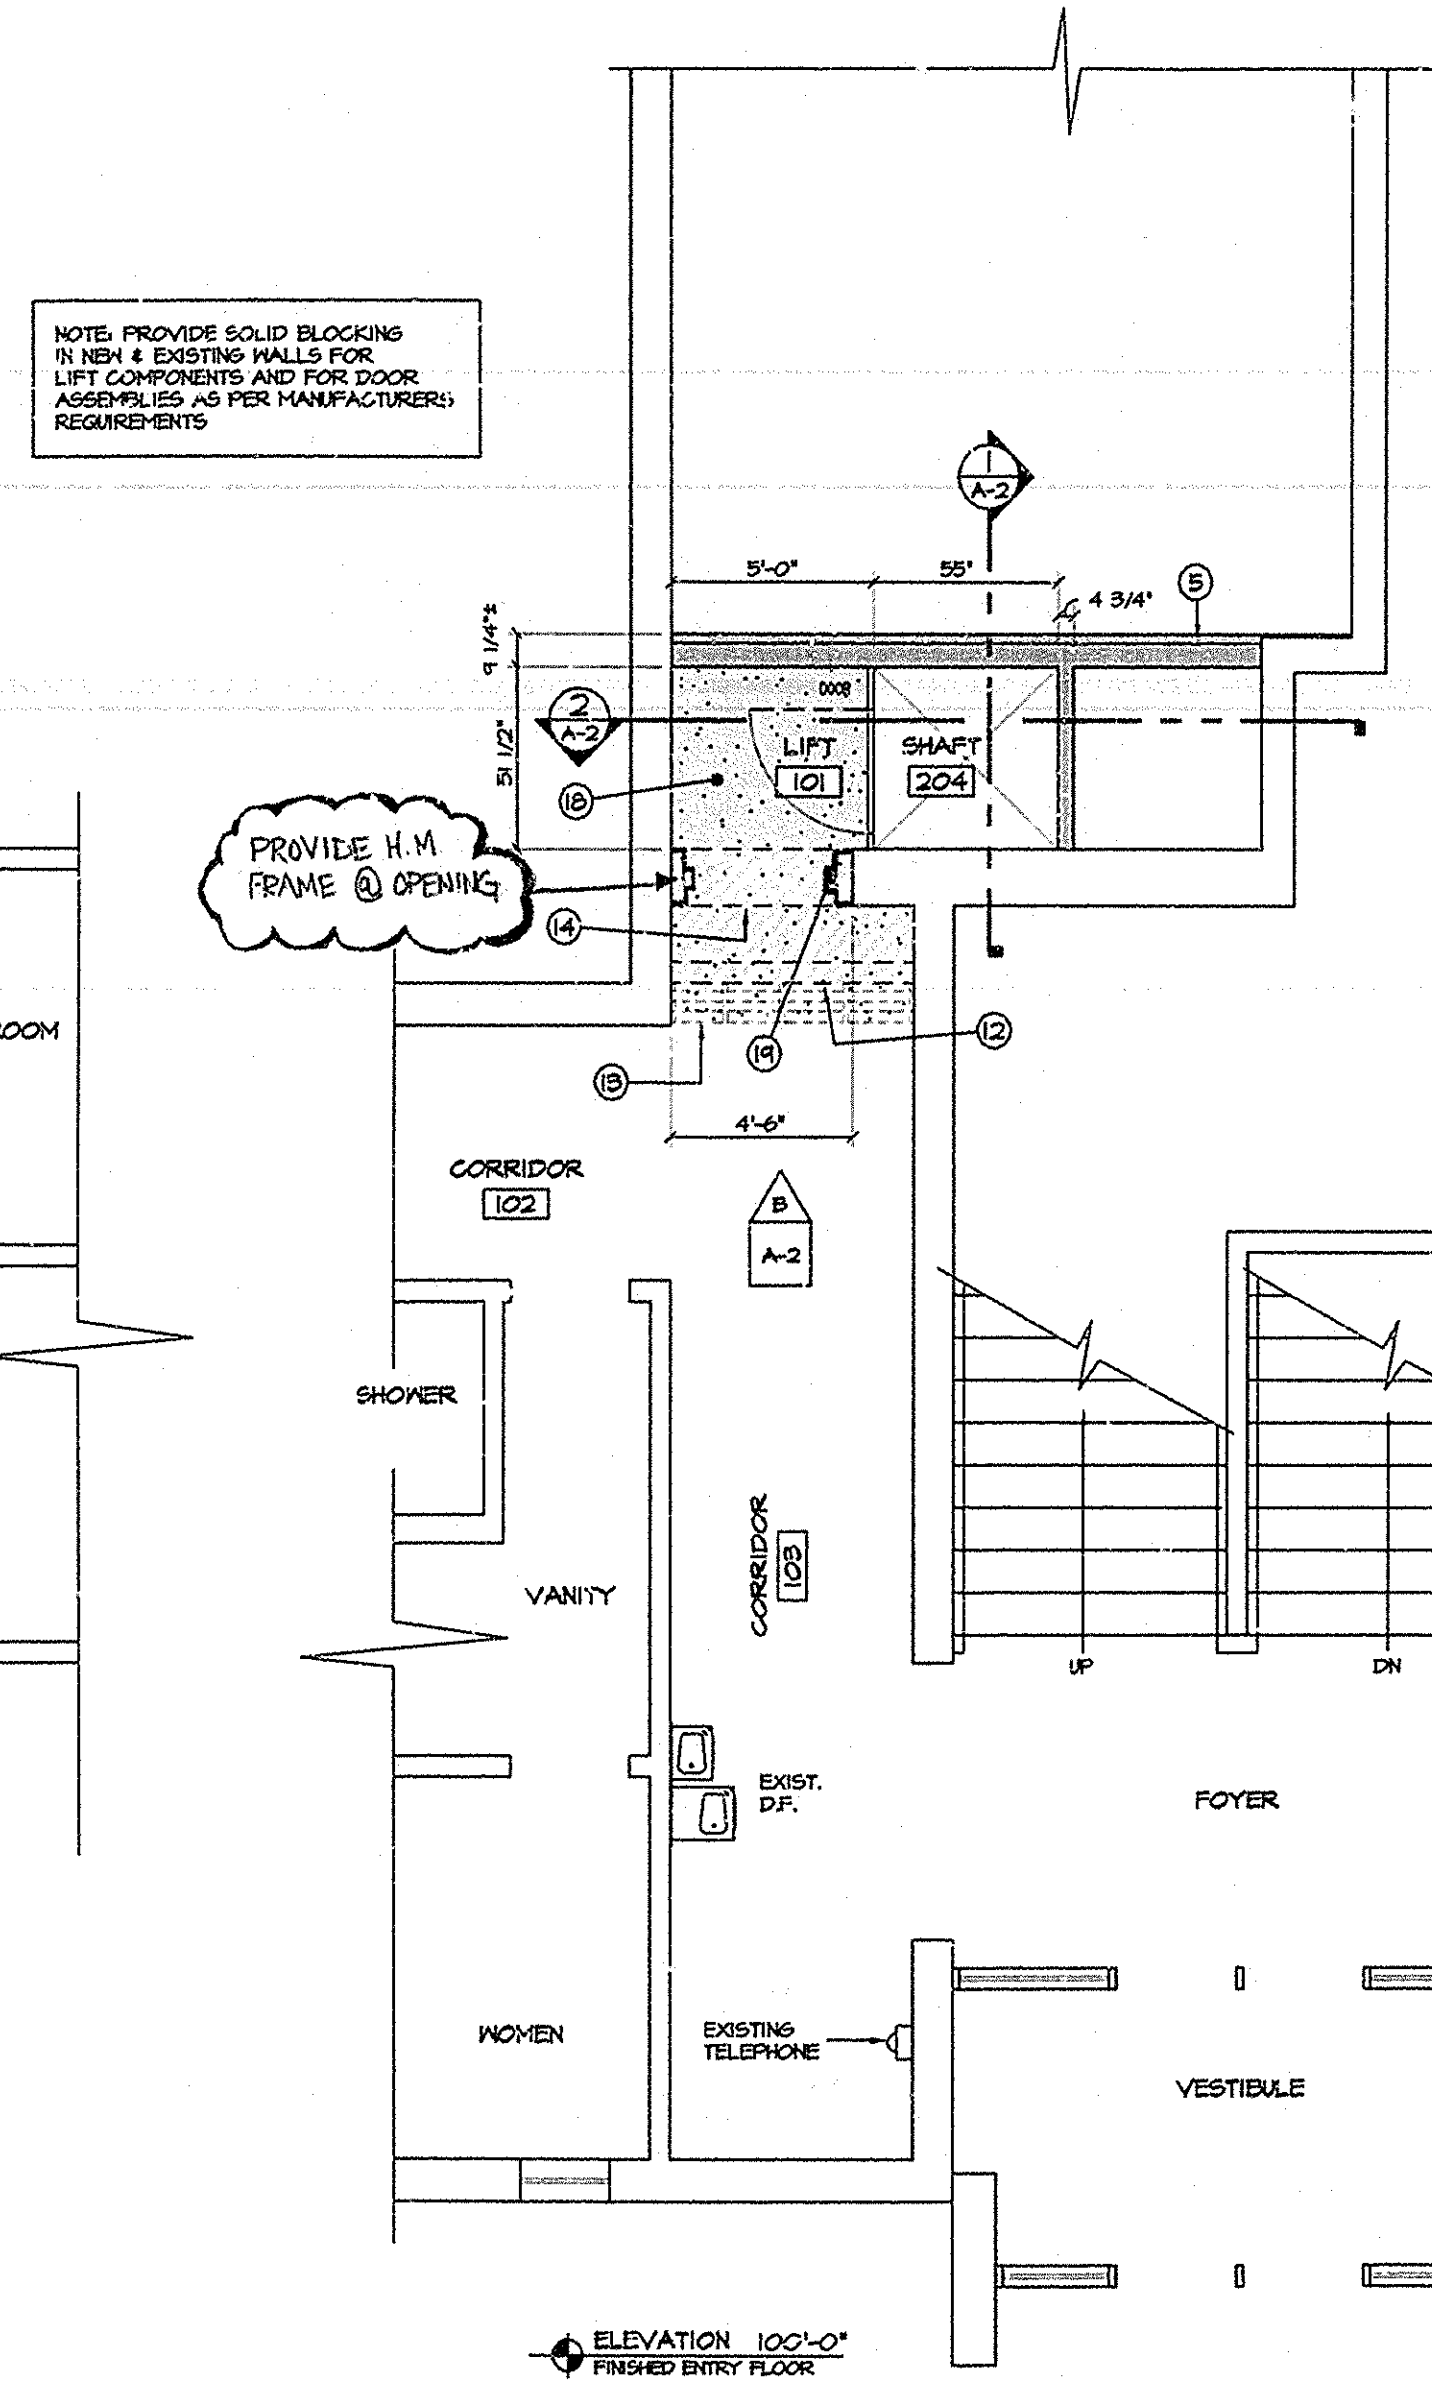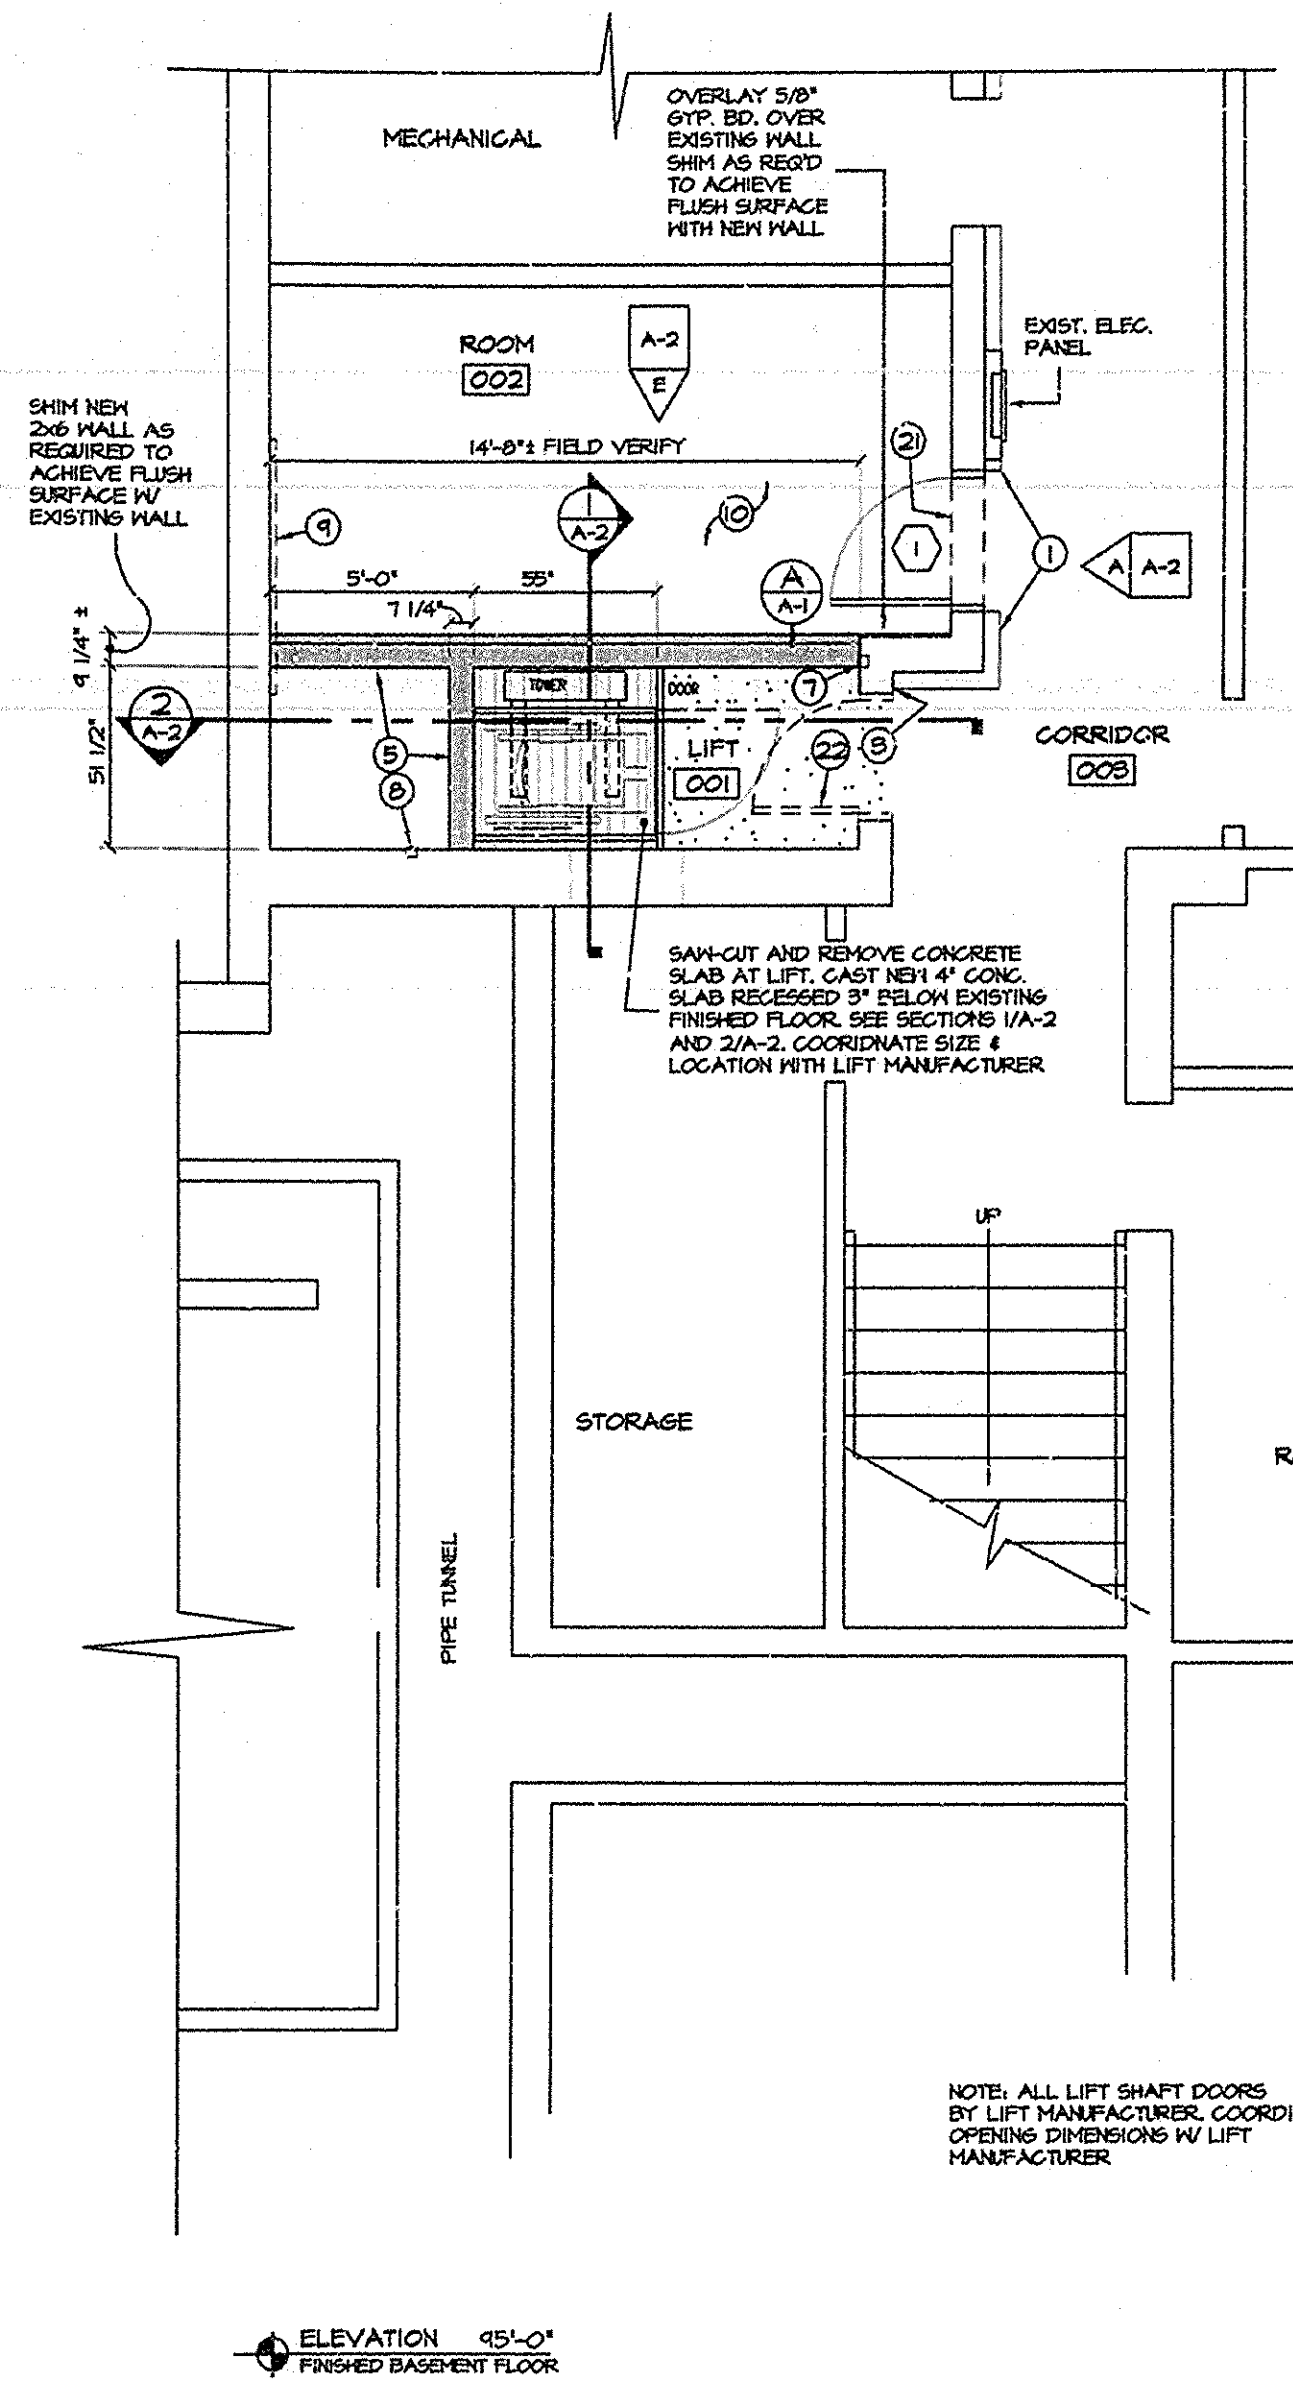

AS BUILT  
25 JULY 1996

NOTE: ALL LIFT SHAFT DOORS BY LIFT MANUFACTURER. COORDINATE OPENING DIMENSIONS W/ LIFT MANUFACTURER.

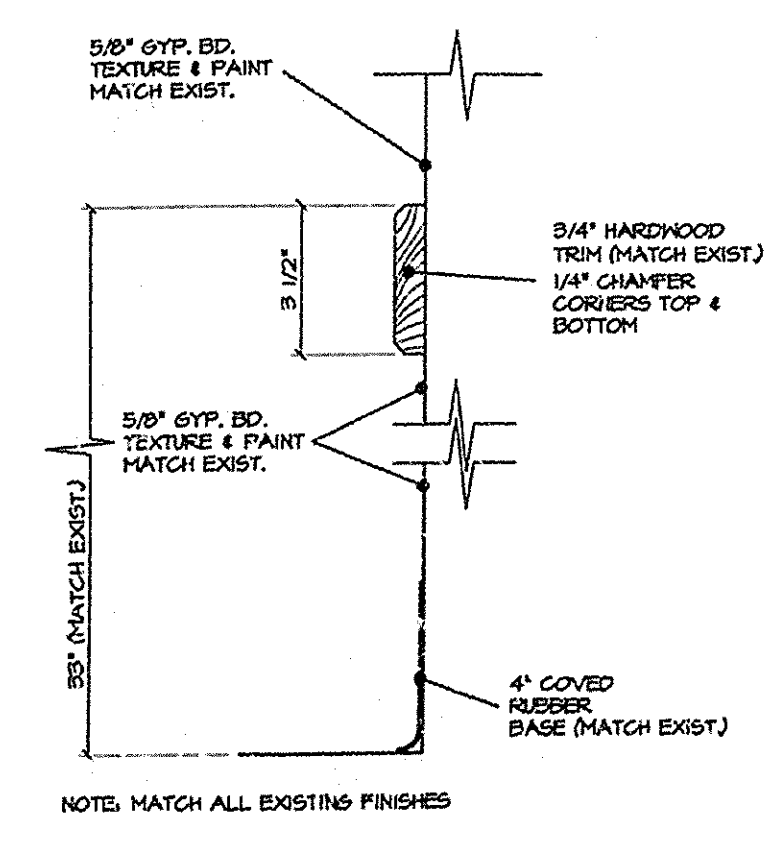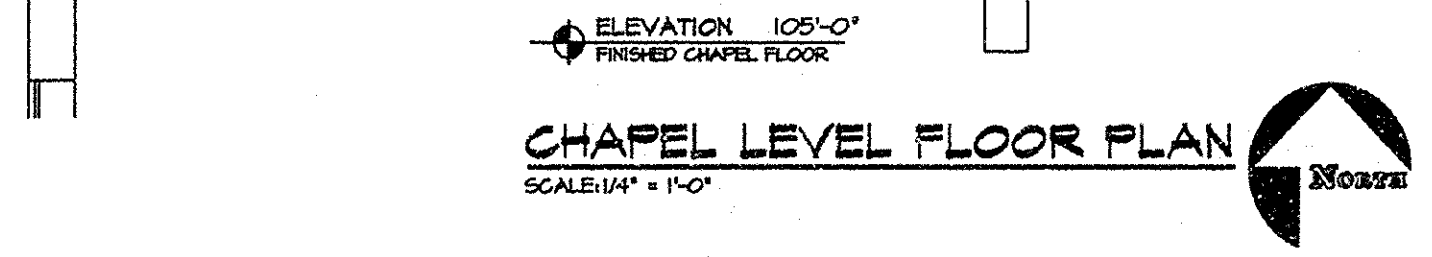


FLOOR FINISH LEGEND	
	NEW CARPET
	SEALED CONCRETE

- NOTES**
- PATCH & REPAIR EXISTING WAINSCOT AS REQUIRED MATCH EXISTING
  - REMOVE EXISTING WOOD DOOR & HARDWARE RETURN TO OWNER. EXISTING FRAME TO REMAIN RE-USE EXISTING HARDWARE
  - PATCH & REPAIR EXISTING WAINSCOT AS REQUIRED MATCH EXIST. SIM. TO DETAIL A/A-1
  - SAW - CUT OPENING IN EXISTING FRAMED WALL PATCH & REPAIR EXISTING WAINSCOT, CARPET & BASE AS REQ'D
  - 2"x6" STUDS AT 16" O/C
  - SAW CUT HOLE IN EXISTING WOOD FLOOR SYSTEM COORDINATE SIZE OF HOLE W/ LIFT MANUFACTURER HEADER AROUND OPENING W/ (2) 2x MEMBERS MATCH DEPTH OF EXISTING WOOD JOISTS (MAY BE NOTED OTHERWISE)
  - REMOVE EXISTING LIGHT SWITCH - SEE ELEC. PATCH & REPAIR HOLE TEXTURE AND PAINT TO MATCH EXIST.
  - REMOVE EXISTING FAN SWITCH SEE MECH.
  - RELOCATE EXISTING CHALK/TACK BOARD LOCATION BY OWNER
  - PATCH & REPAIR ALL EXISTING SURFACES AS REQ'D TO MATCH EXISTING
  - REMOVE EXISTING WOOD PANEL AND WALL
  - REMOVE EXISTING COAT RACK & RETURN TO OWNER

- NOTES**
- SAW-CUT OPENING IN EXISTING CONCRETE WALL PATCH & REPAIR TO RECEIVE PLASTER FINISH - TEXTURE & PAINT MATCH EXISTING
  - REMOVE EXISTING DOOR, FRAME & HARDWARE AND PORTION OF EXISTING WALL PATCH & REPAIR EXISTING WALLS & CEILING AS REQUIRED MATCH EXISTING FINISHES
  - REMOVE EXISTING LIGHT SWITCH - SEE ELEC.
  - REMOVE EXISTING ELEC. OUTLET - SEE ELEC. PATCH & REPAIR HOLE TEXTURE AND PAINT TO MATCH EXIST.
  - FLOOR: 1/4" T & G APA STURD - 1 - FLOOR OR 5/8" PARTICLE BD. TYPE I GRADE M-1 COVER 15# FELT OVER 15/32" APA PLYND. W/ EXT. GLUE EXPOSURE 1 - GLUE & NAIL TO JOISTS. JOISTS: 2x10'S AT 16" O/C
  - PATCH EXISTING FLOOR TO ACHIEVE LEVEL SURFACE TO ELEVATION 100'-0" - MATCH EXISTING FINISH (GROSS - MATCHED AREA)
  - REMOVE EXISTING VOLUME CONTROL - SEE ELEC.
  - SAW - CUT OPENING IN EXISTING CONCRETE WALL FOR NEW DOOR
  - REMOVE EXISTING DOOR & HOLLOW METAL FRAME & RETURN TO OWNER PATCH & REPAIR EXISTING CONCRETE WALL - PLASTER FINISH MATCH EXISTING - RE-USE EXISTING HARDWARE

PROPERTY NUMBER - 507-2638

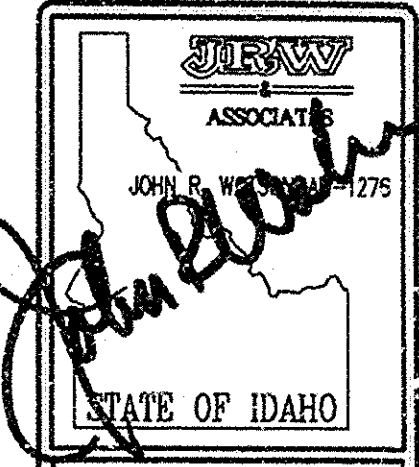

JOHN R. WATSON ARCHITECTURE & INTERIOR DESIGN

JOHN R. WATSON ARCHITECTURE & INTERIOR DESIGN

JOHN R. WATSON ARCHITECTURE & INTERIOR DESIGN

**CONSULTANTS:**

CIVIL ENGINEERING  
HARPER - LEAVITT  
815 W. COLE  
P.O. Box 50891  
1616 S.W. 1000 83405  
(208) 524-0212

MECHANICAL ENGINEERING  
ENGINEERING SYSTEMS ASSOC.  
315 West Center  
Pocatello, Idaho 83201  
(208) 233-0501  
Fax: (208) 233-0529

ELECTRICAL ENGINEERING  
ENGINEERING SYSTEMS ASSOC.  
315 West Center  
Pocatello, Idaho 83201  
(208) 233-0501  
Fax: (208) 233-0529

PROJECT: MENAN 1, 2 MENAN IDAHO STAKE IDAHO

DRAWING TITLE: FLOOR PLAN DETAILS

DATE: APRIL 95




CHECKED BY: JRW

DRAWING NO. A-1

OF 3



24X



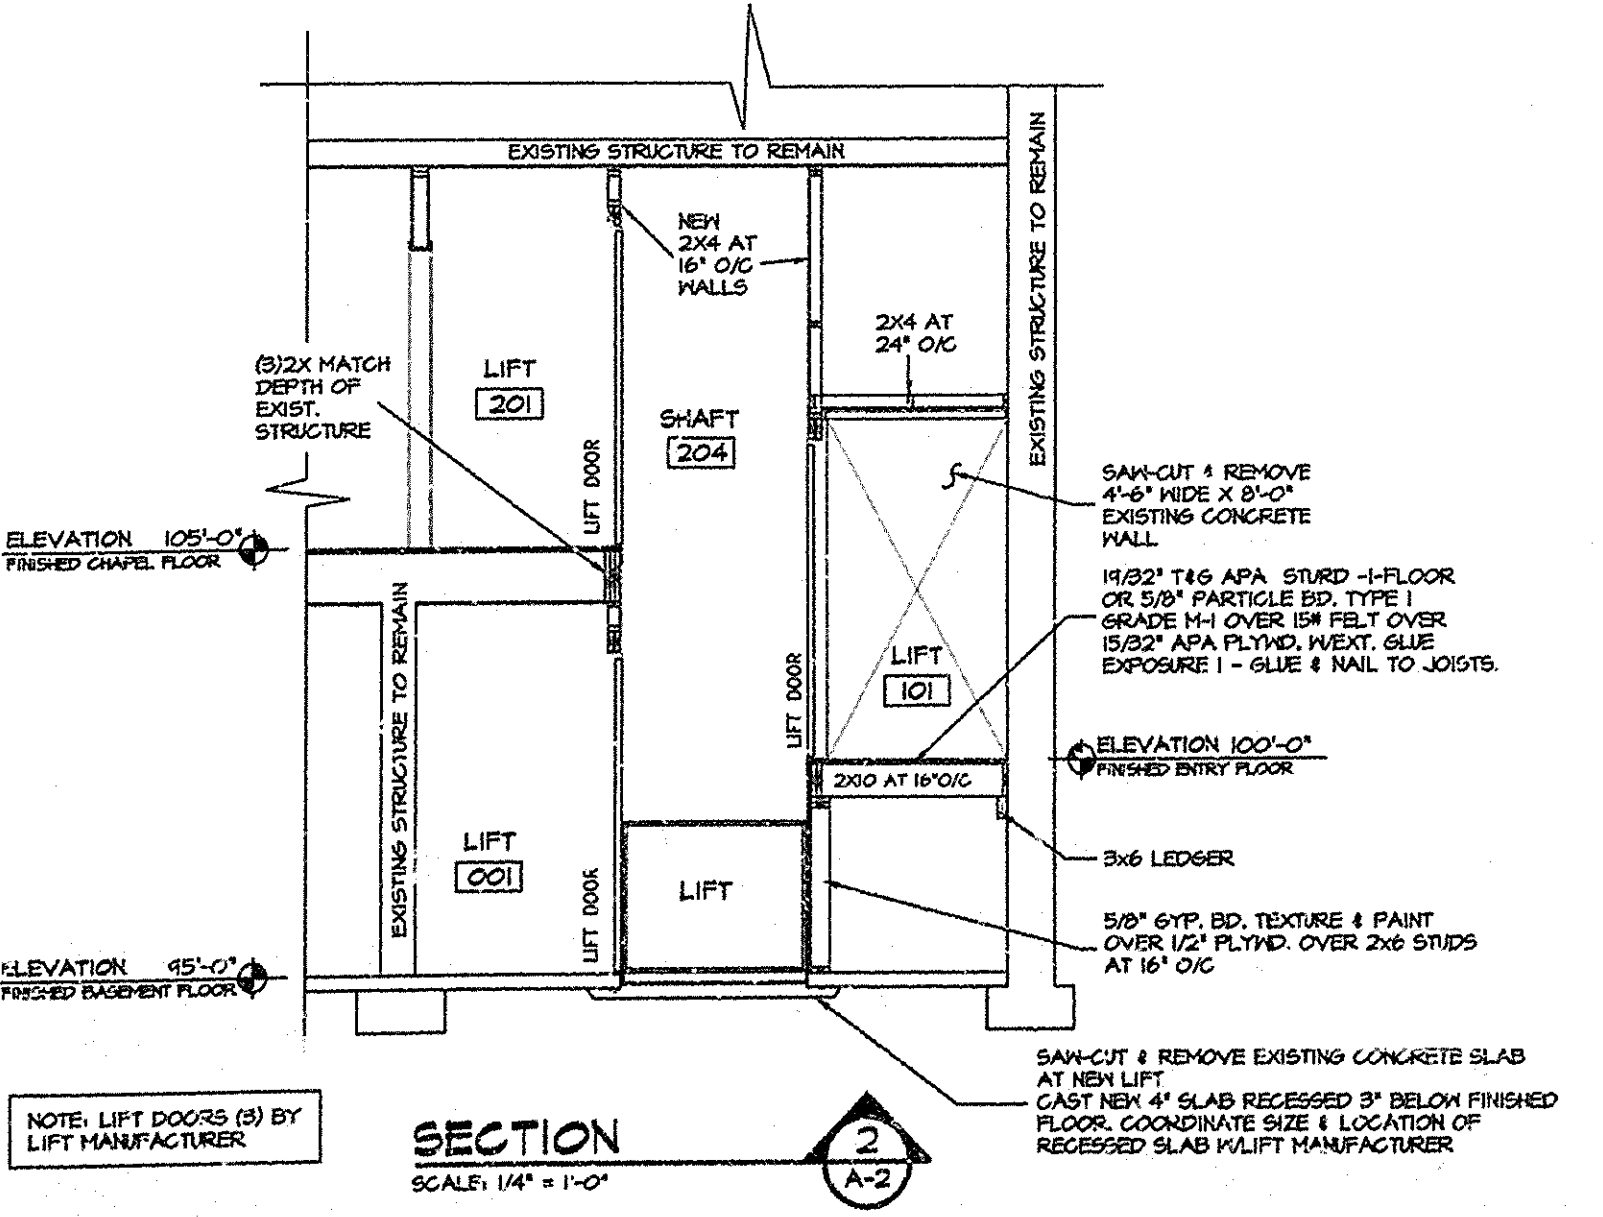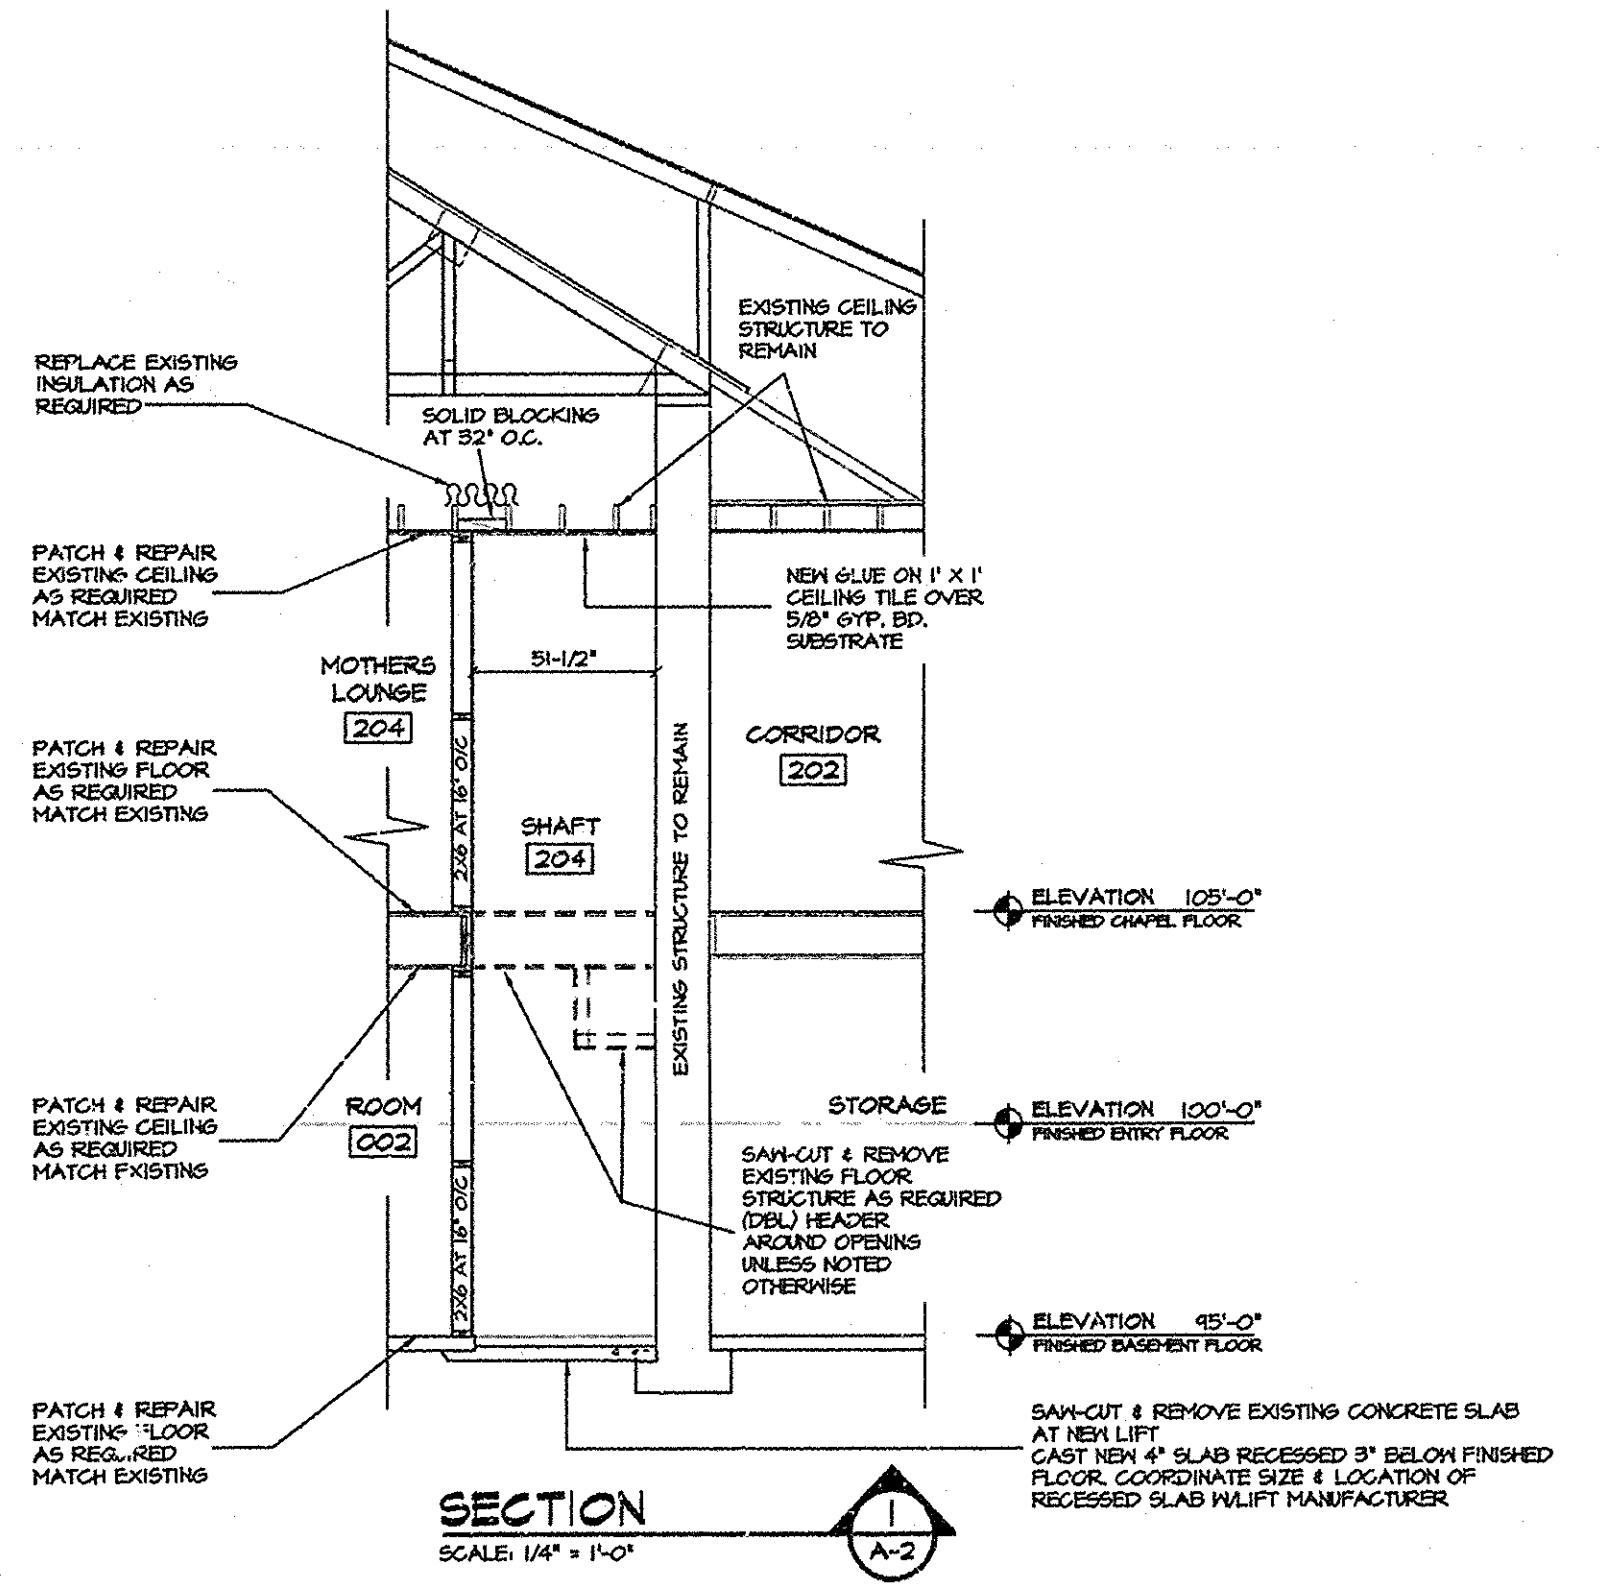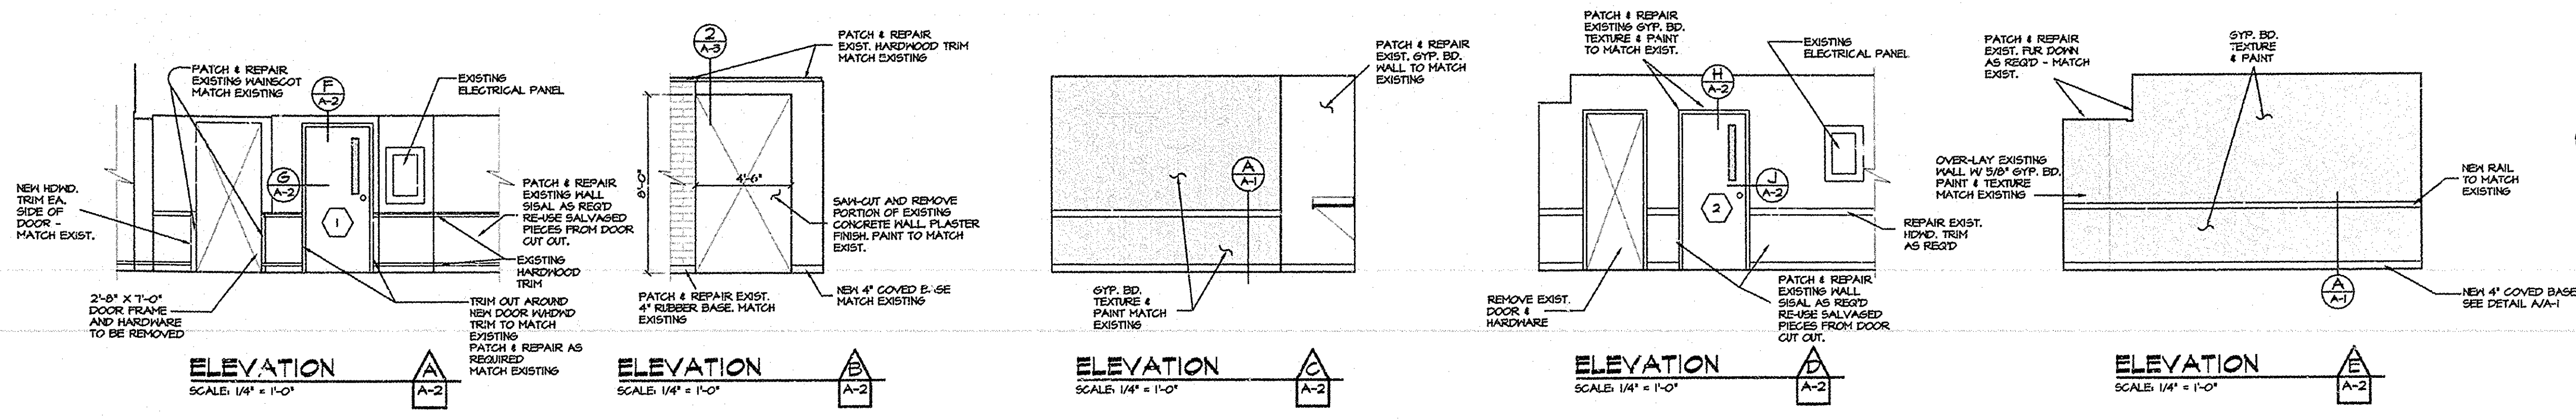

AS BUILT  
25 JULY 1996

DOOR SCHEDULE					
MARK	SQL or DBL	SIZE	TYPE	REMARKS	
1	SINGLE	3'-0\"/>			

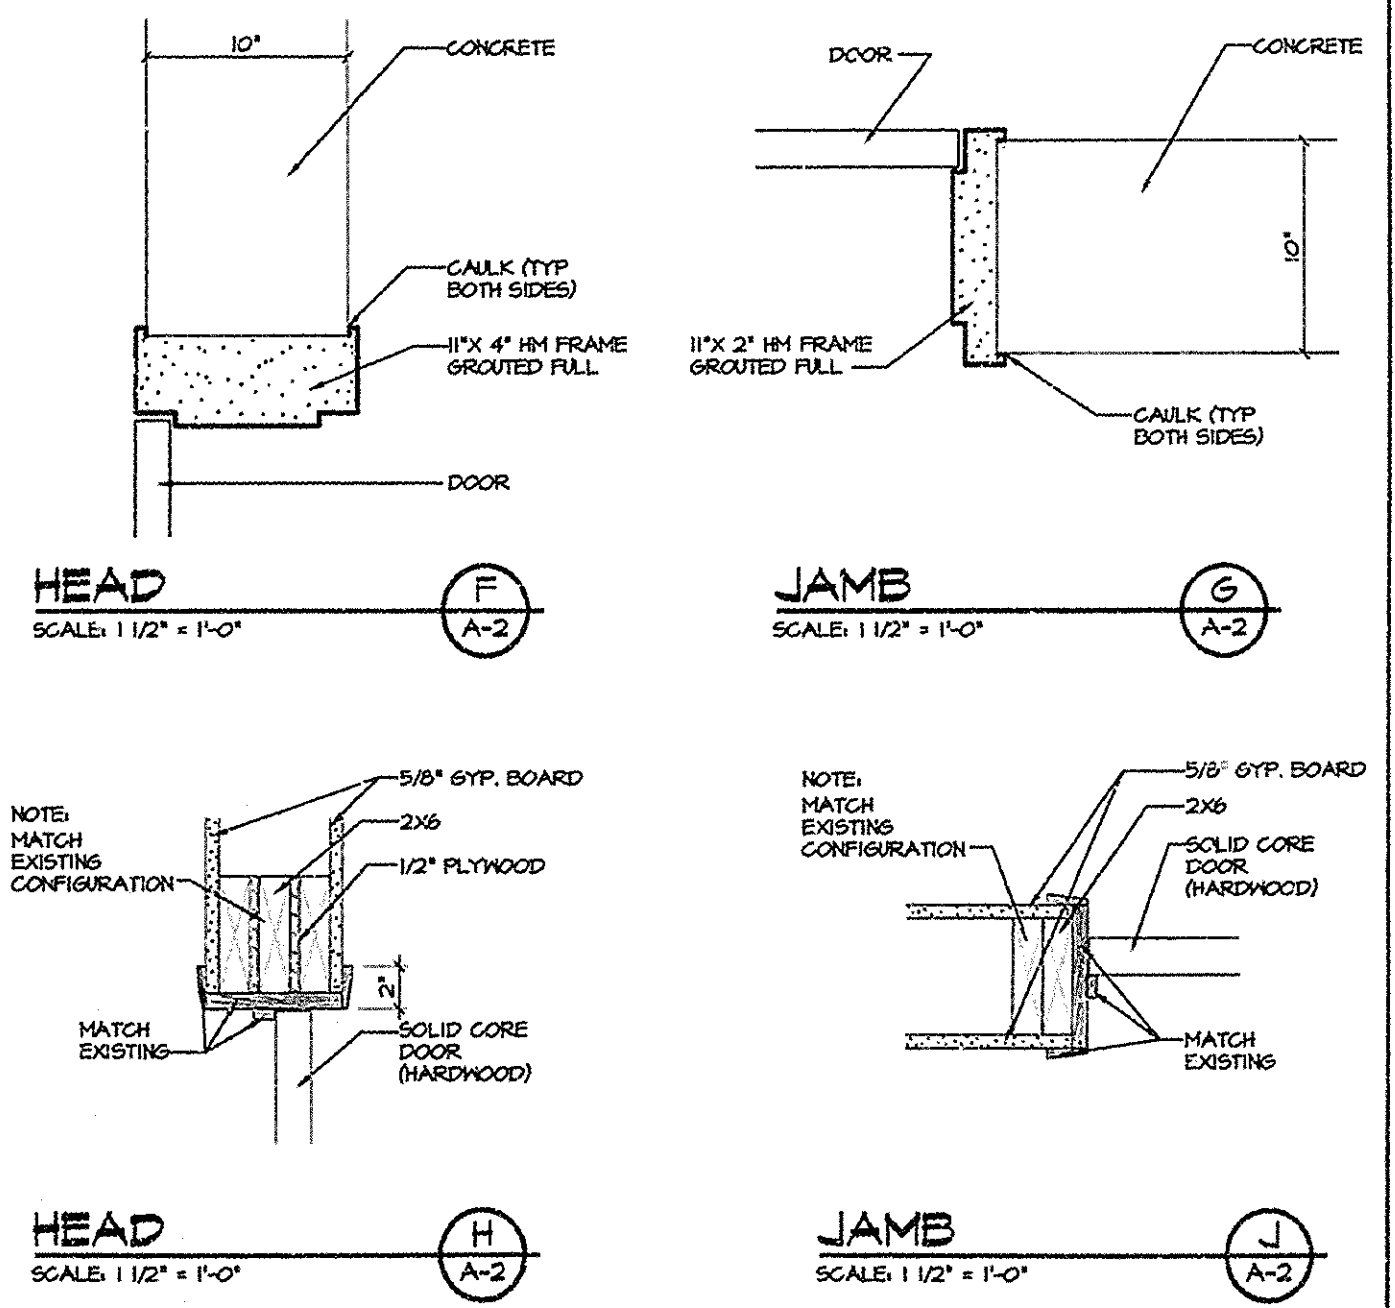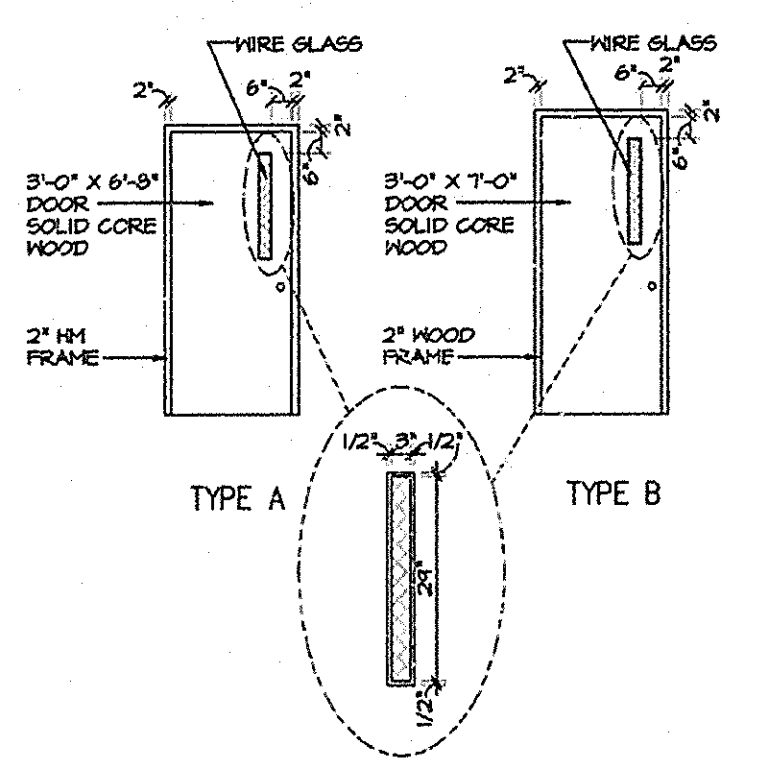

ROOM FINISH SCHEDULE

NO.	AREA NAME	FLOOR	BASE	MANSICOT	WALLS				CEILING	CLG. HT.	REMARKS
					NORTH	EAST	SOUTH	WEST			
001	LIFT										
002	ROOM										
003	CORRIDOR										
101	LIFT										
102	CORRIDOR										
103	CORRIDOR										
201	LIFT										
202	CORRIDOR										
203	MOTHERS LOUNGE										
204	SHAFT										

**JESW ASSOCIATES**  
JOHN R. WATSON, P.E. - 1276

STATE OF IDAHO

**JESW ASSOCIATES**  
ARCHITECTURE - ENGINEERING  
CONSTRUCTION MANAGEMENT

CONSULTANTS:  
CIVIL ENGINEERING  
HASSLER - LEAVITT  
895 No. Capitol  
P.O. Box 3491  
Motto Falls, Idaho 83405  
(208) 524-0212  
MECHANICAL ENGINEERING  
ENGINEERS SYSTEMS ASSOC.  
315 West Center  
Pocatello, Idaho 83201  
(208) 233-0201  
Fax (208) 233-0328  
ELECTRICAL ENGINEERING  
ENGINEERS SYSTEMS ASSOC.  
315 West Center  
Pocatello, Idaho 83201  
(208) 233-0201  
Fax (208) 233-0328




PROJECT: MENAN 1, 2  
DRAWING TITLE: MENAN IDAHO STAKE  
ELEVATIONS, DETAILS, SECTIONS, SCHEDULES

DATE: 04-13-01  
PROJECT NO.: 0413-01-013  
JOB NO.: 013  
DRAWN BY: RWS  
CHECKED BY: JWS  
DATE: APRIL 1996




DRAWING NO. 03-B-1  
A-2  
OF 3

24X



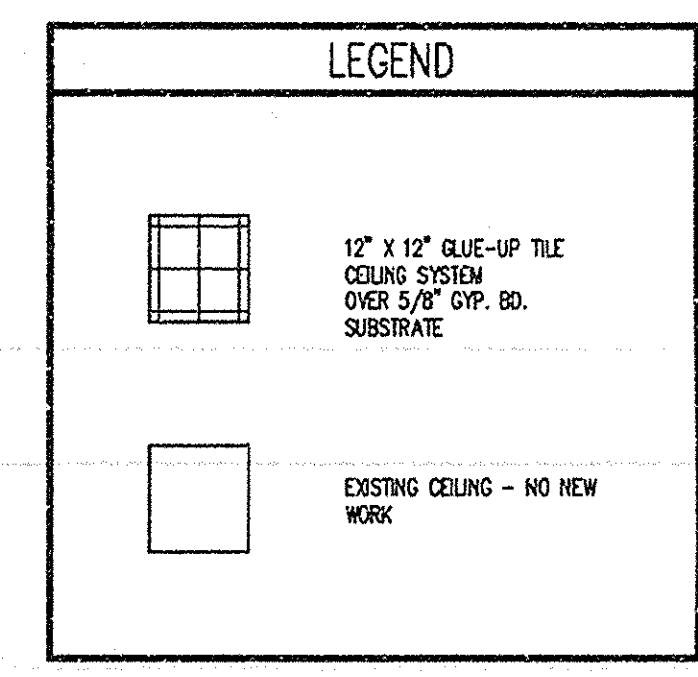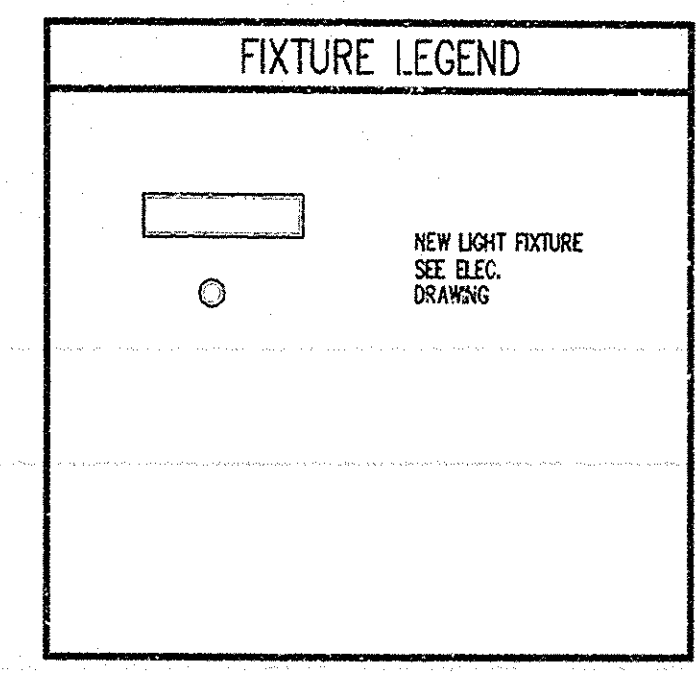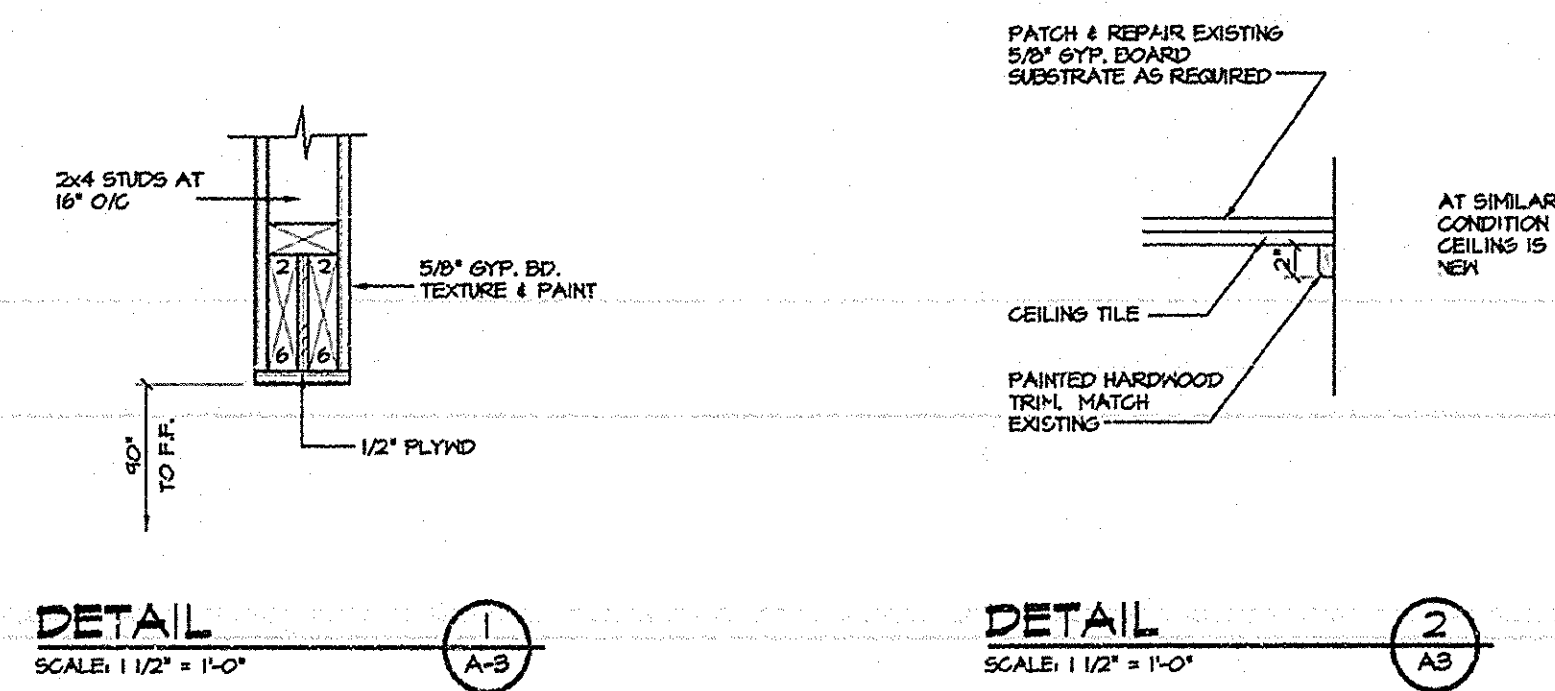

AS BUILT  
25 JULY 1996

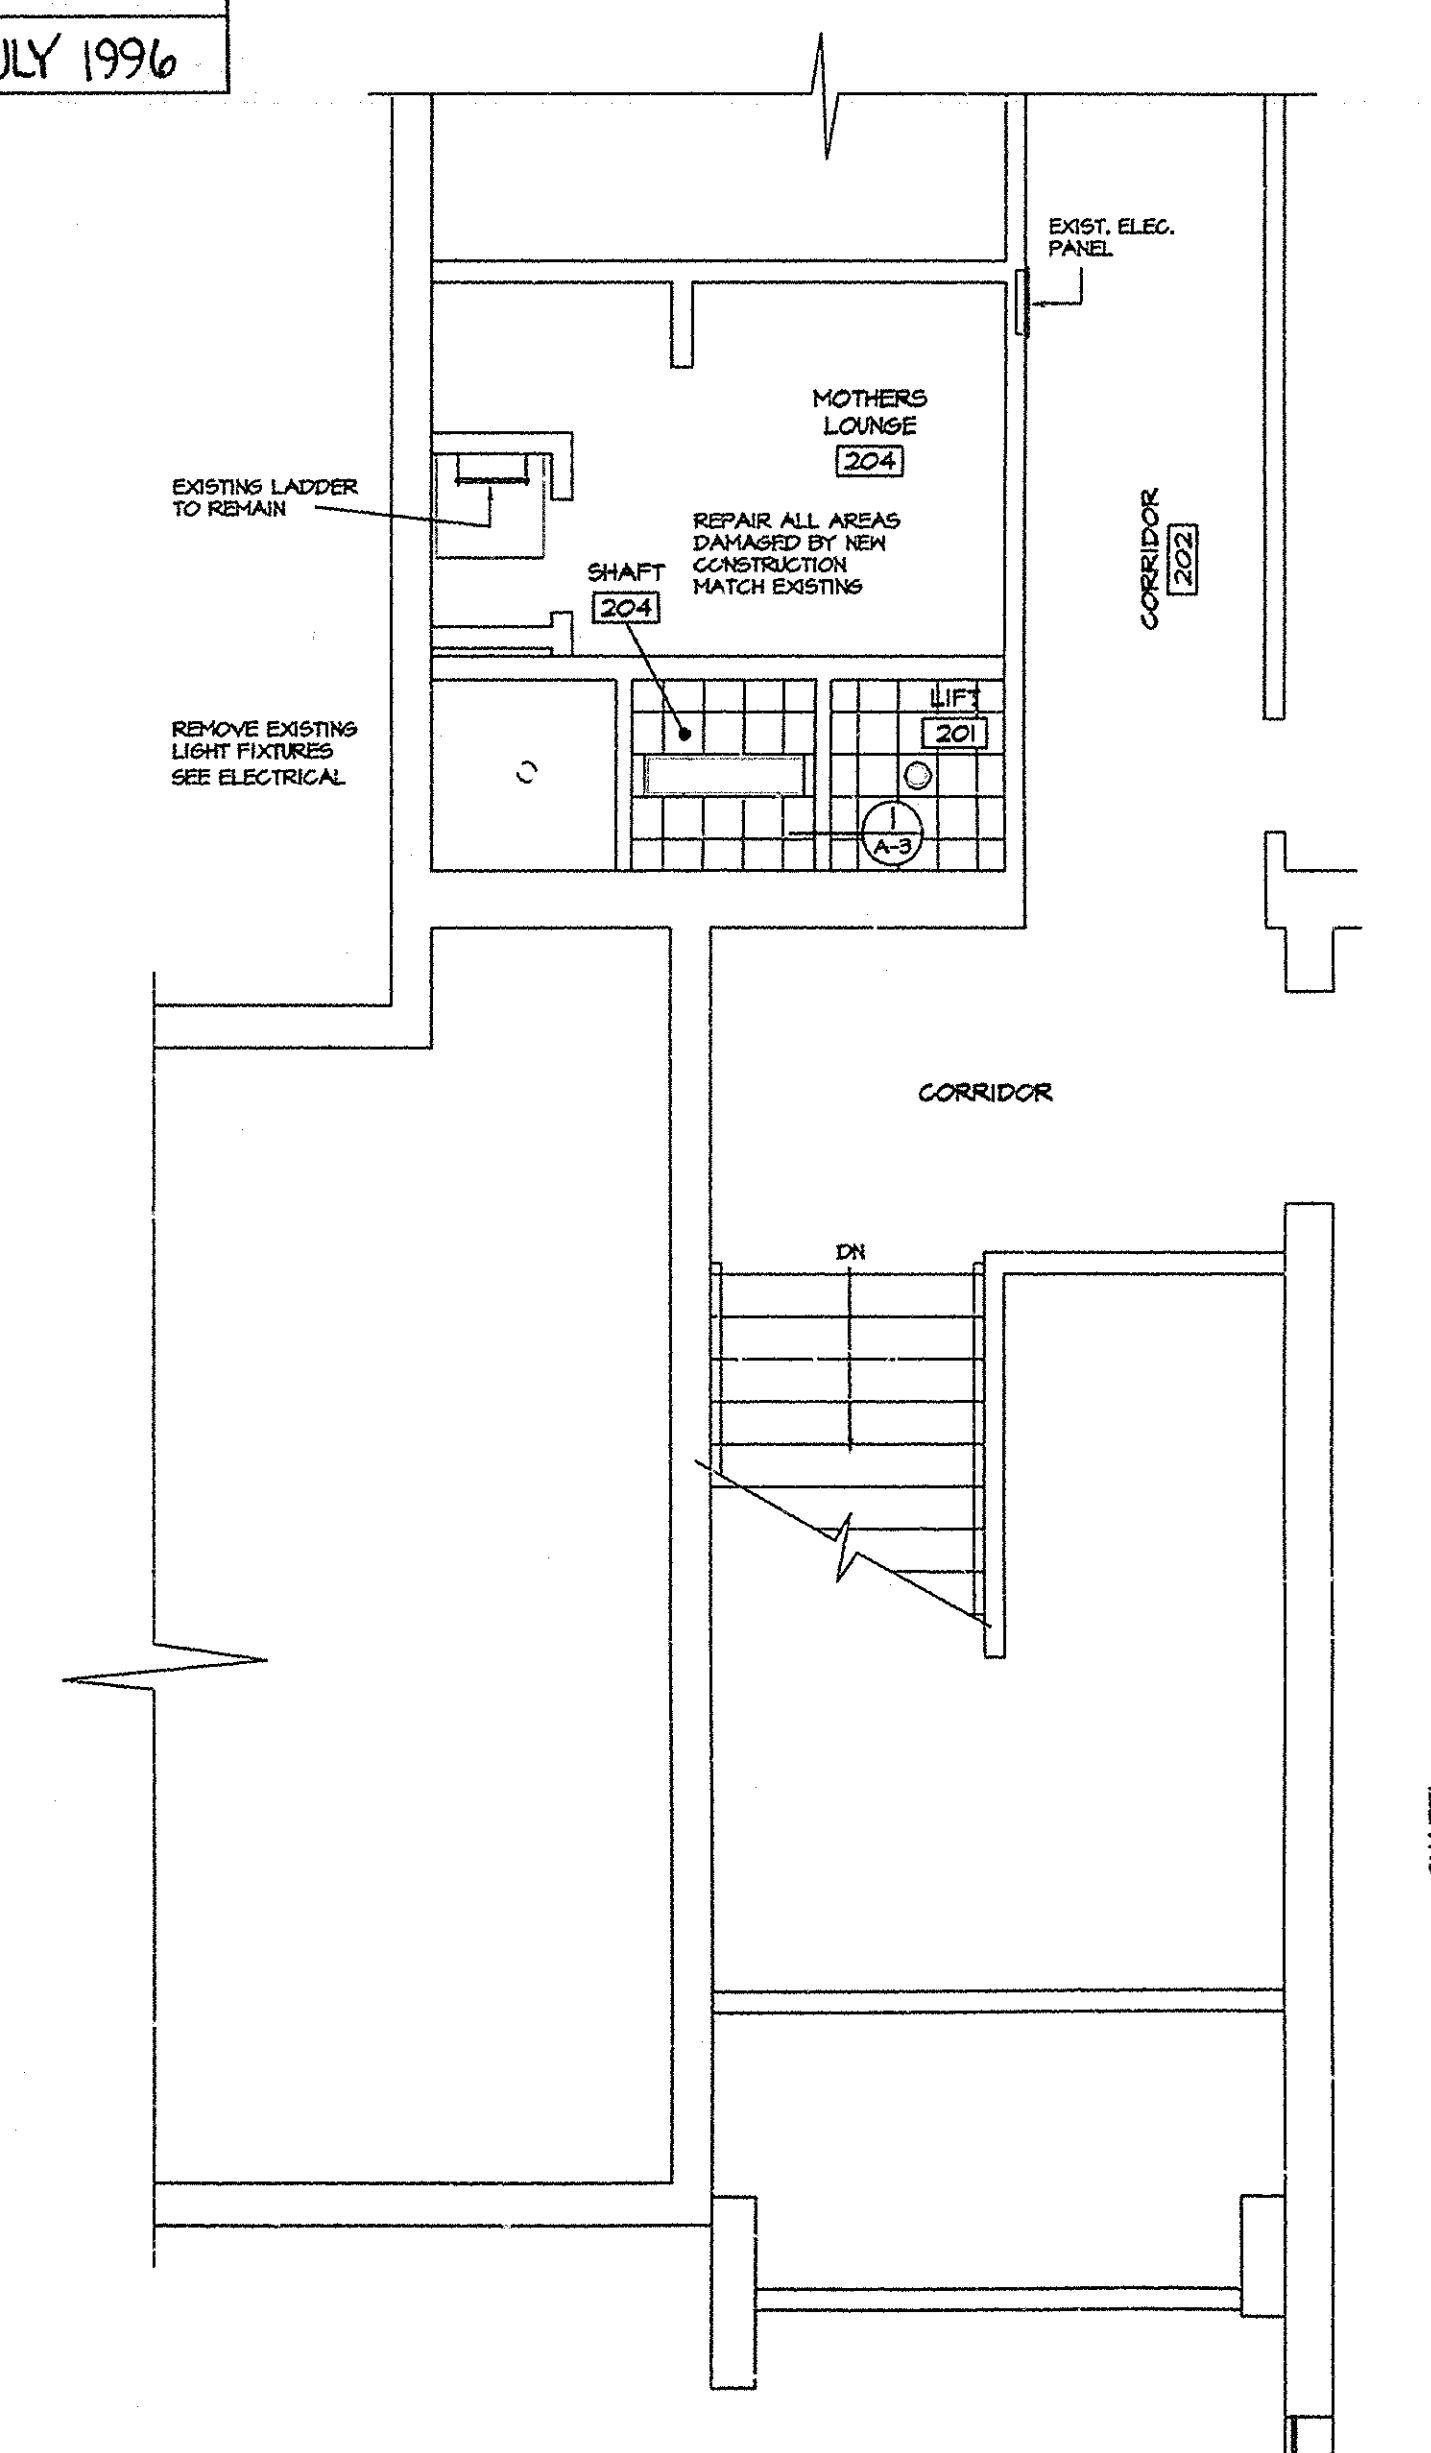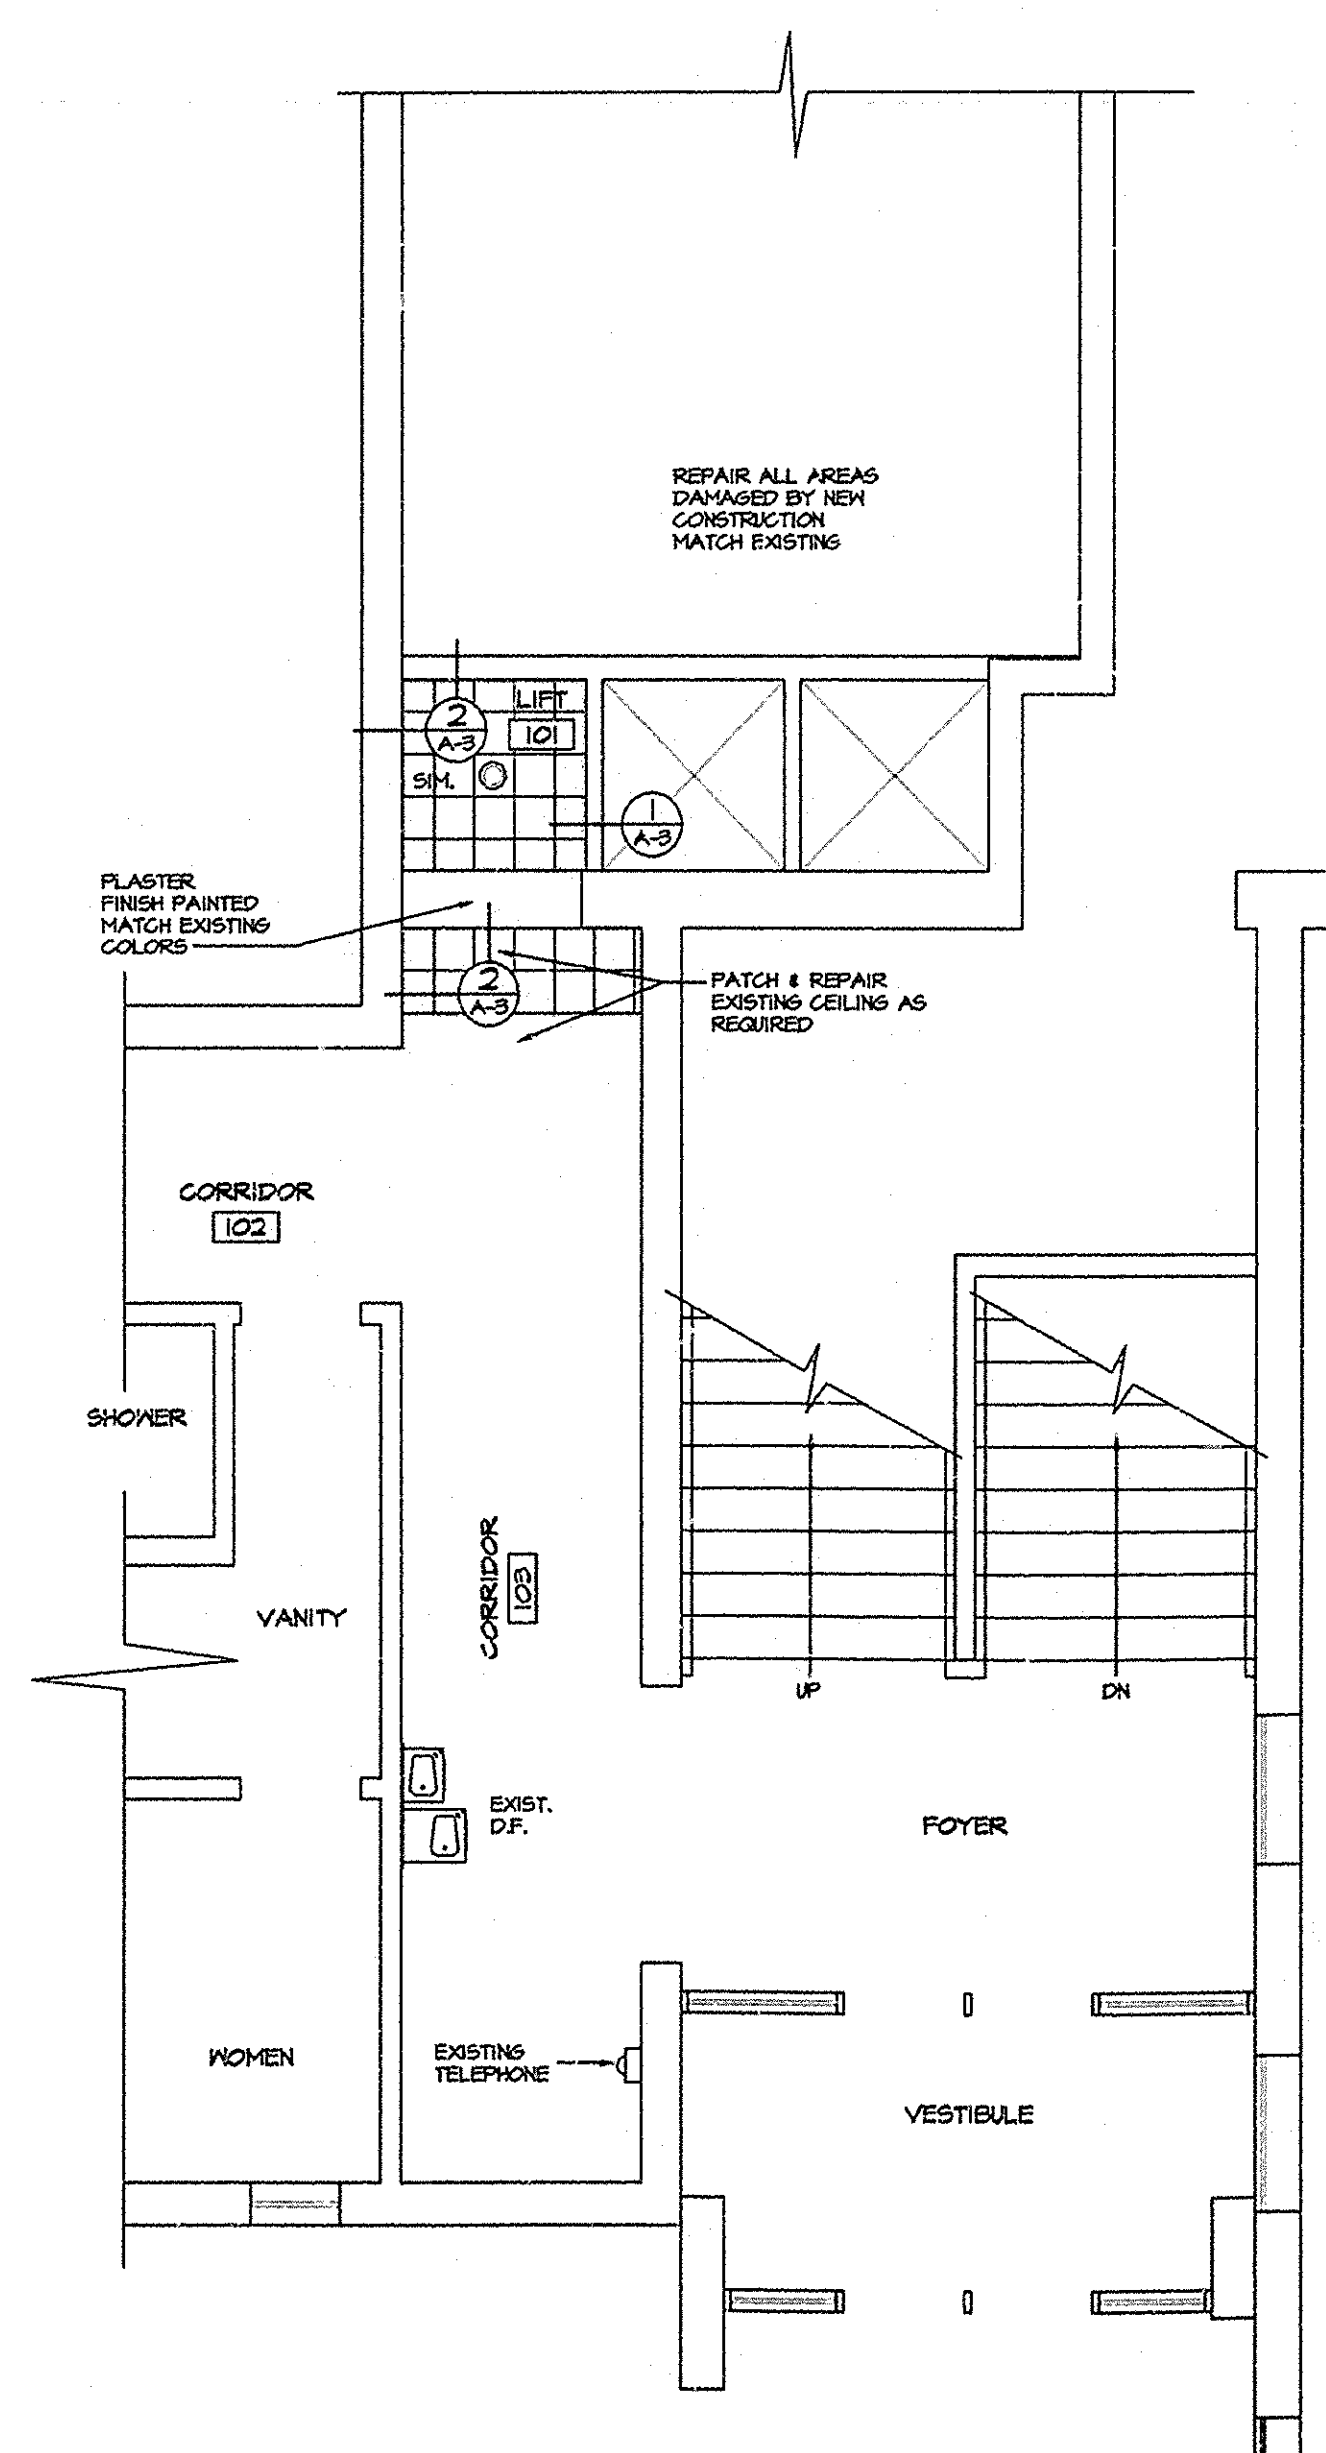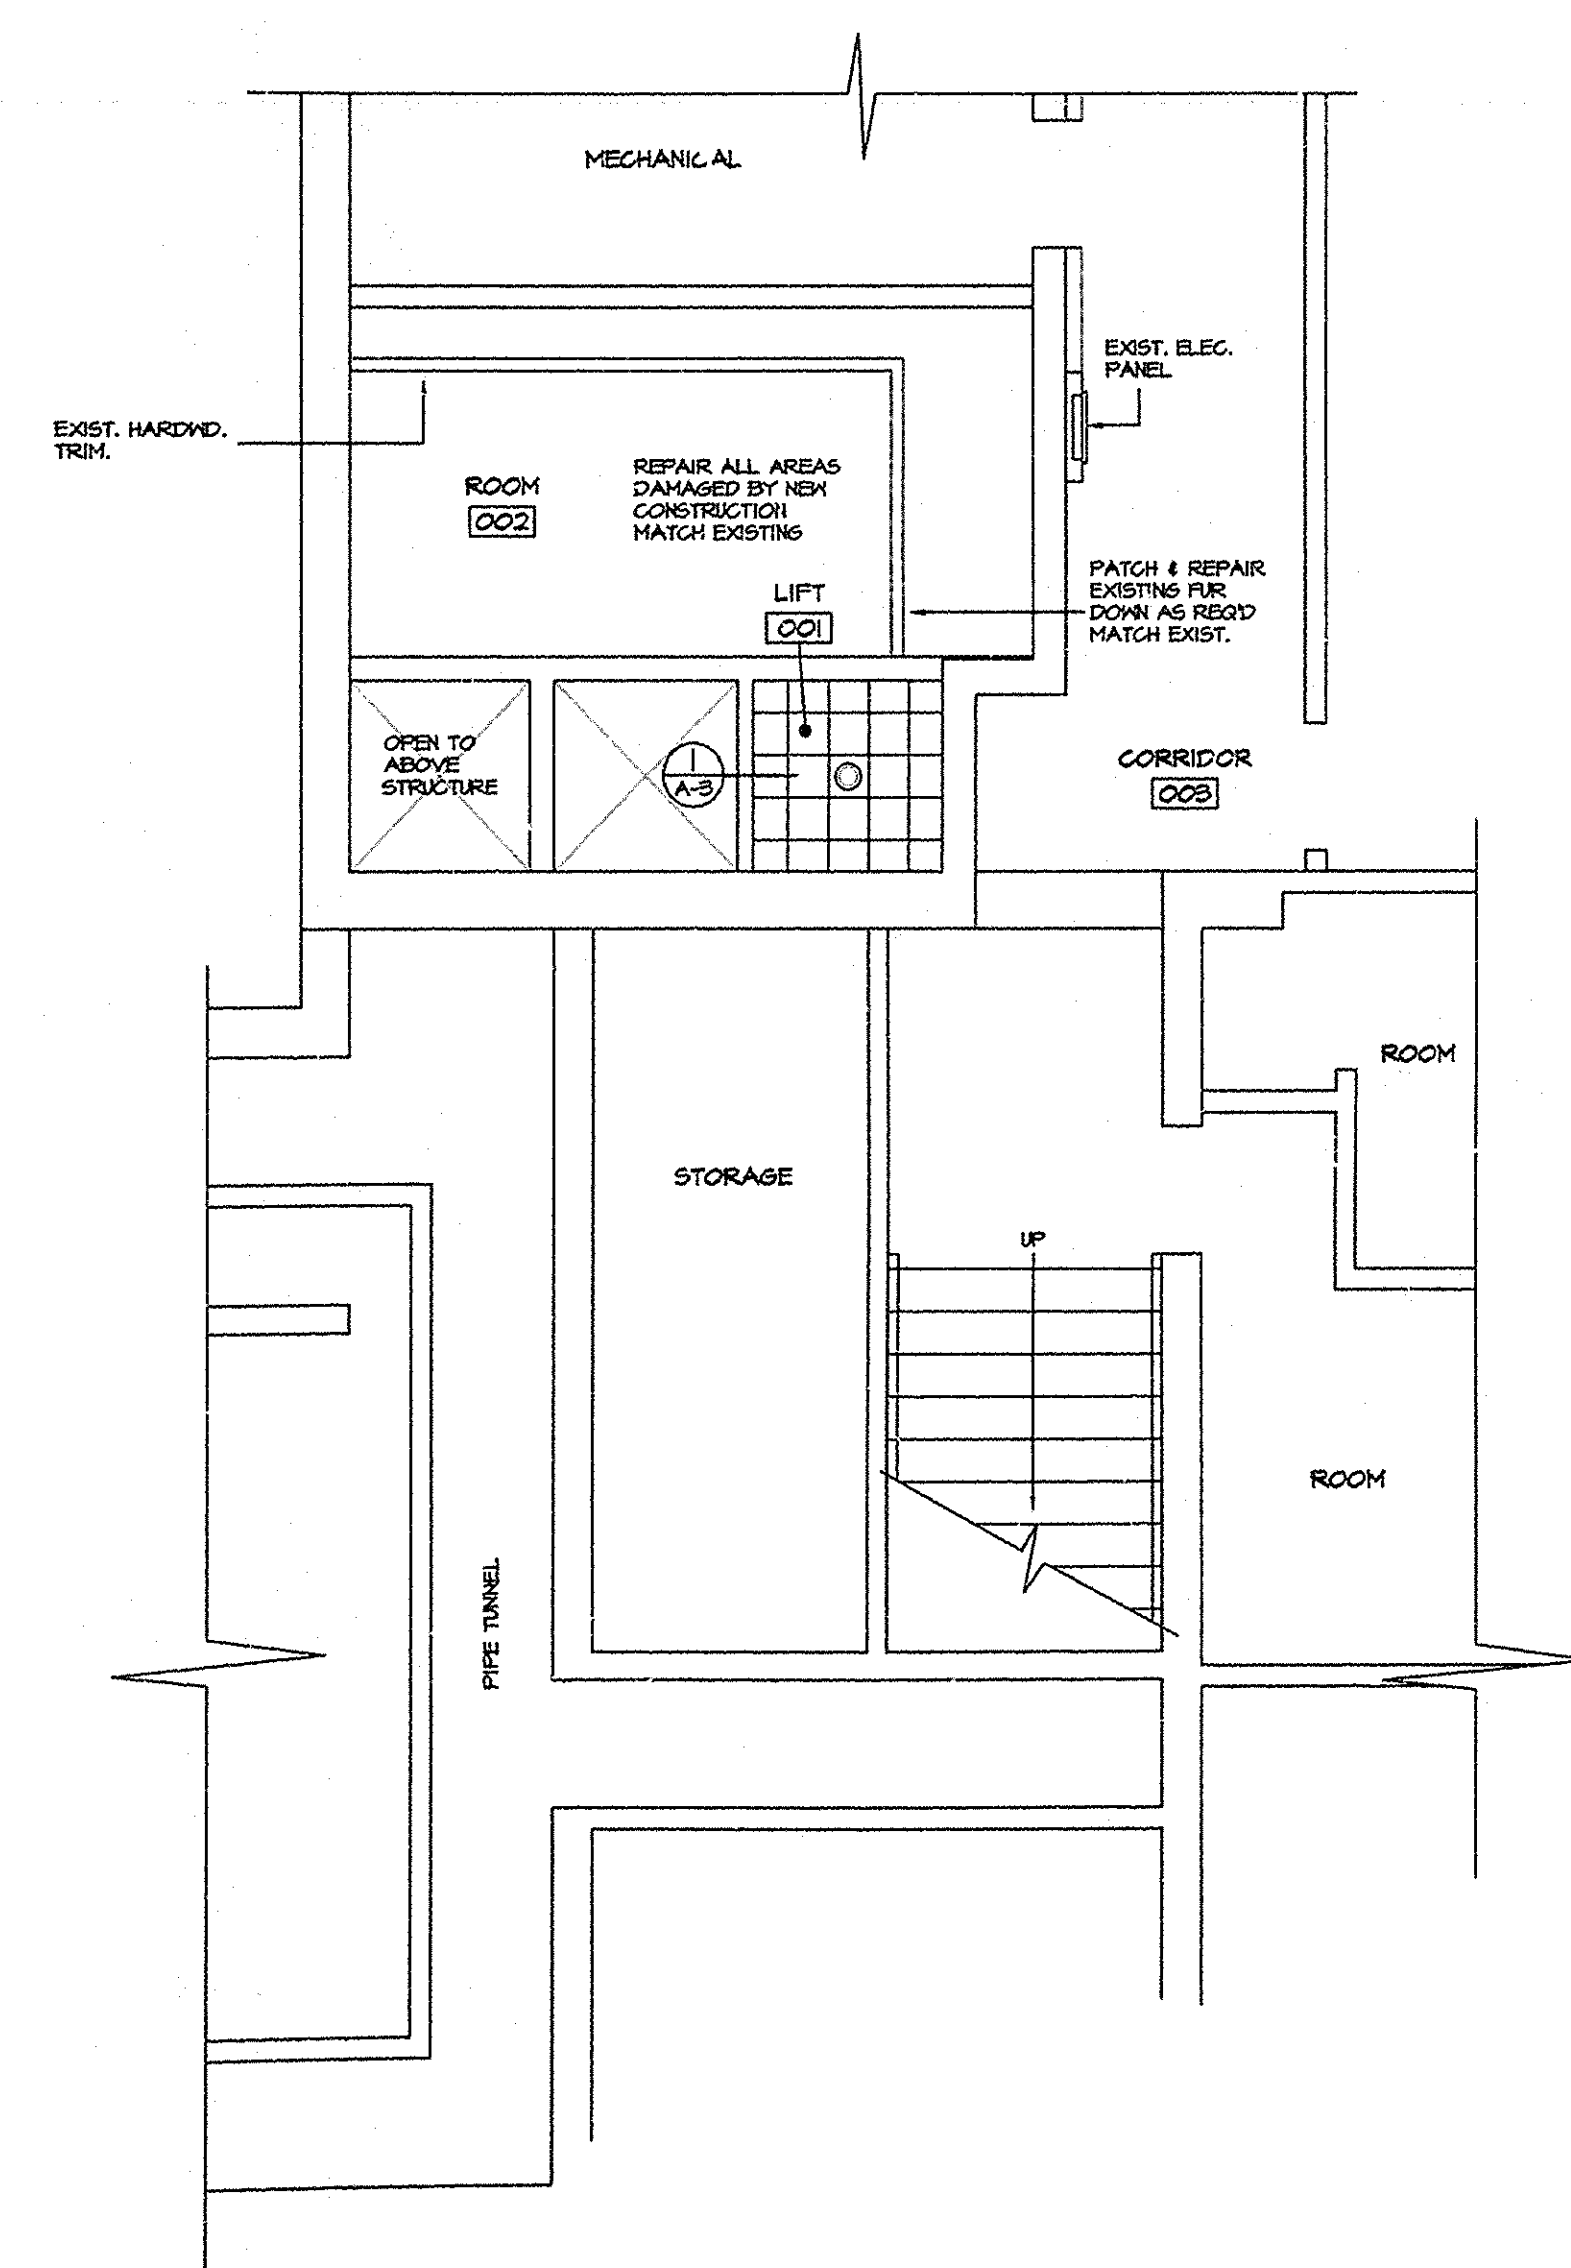

**JERW ASSOCIATES**  
ARCHITECTURE - ENGINEERING  
CONSTRUCTION MANAGEMENT

STATE OF IDAHO

JOHN R. WATSON  
ARCHITECT

JOHN R. WATSON  
ARCHITECT

CONSULTANTS:

**CIVIL ENGINEERING**  
HERRICK - LEIGHTY  
855 No. Capitol  
P.O. Box 55691  
1600 S. 16th, Idaho 83405  
(208) 524-0212

**MECHANICAL ENGINEERING**  
ENGINEERED SYSTEMS ASSOC.  
315 West Center  
Pocatello, Idaho 83201  
(208) 233-0501  
Fax: (208) 233-0529

**ELECTRICAL ENGINEERING**  
ENGINEERED SYSTEMS ASSOC.  
315 West Center  
Pocatello, Idaho 83201  
(208) 233-0501  
Fax: (208) 233-0529

PROJECT: MENAN, IDAHO  
DRAWING TITLE: REFLECTED CEILING PLAN

PLT DATE: 4-26-95  
PROJECT NO.: 9415-01-013  
PLT SCALE: 1/4" = 1'-0"

DRAWN BY: EWS  
JOB NO.: 018  
DATE: APRIL '95


CHECKED BY: JRW

DRAWING NO. A-3  
FILE: (15-100)  
OF 3


PROPERTY NUMBER - \* 507 - 2638

24X




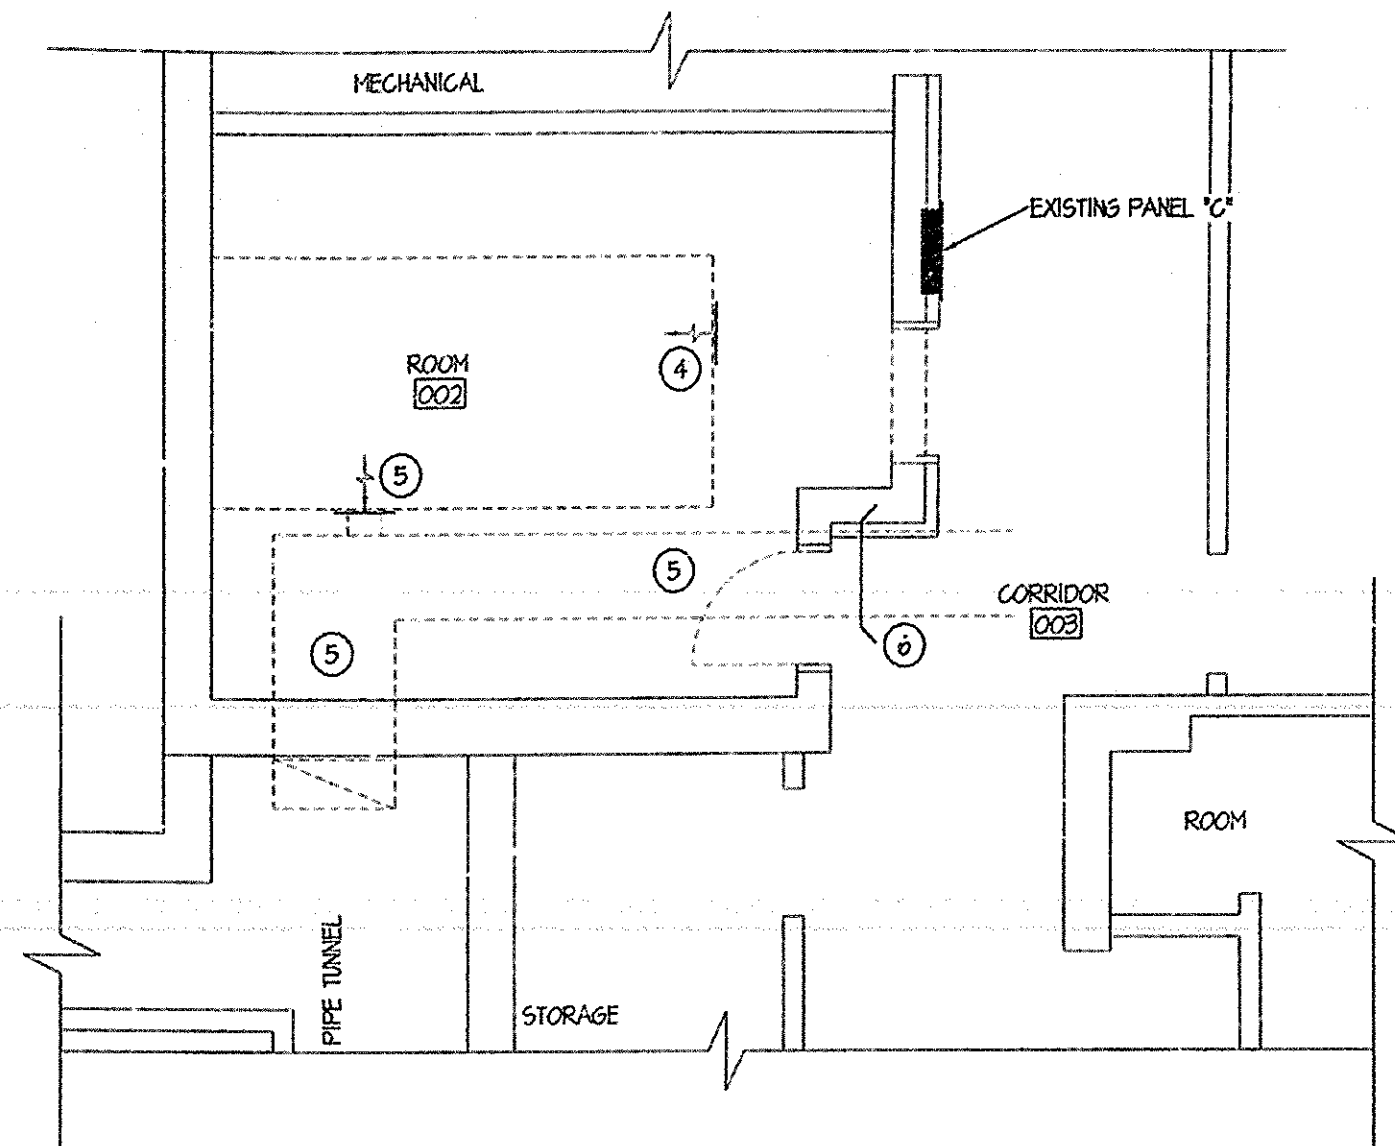


**BASEMENT FLOOR PLAN - DEMOLITION**  
SCALE: 1/4" = 1'-0"

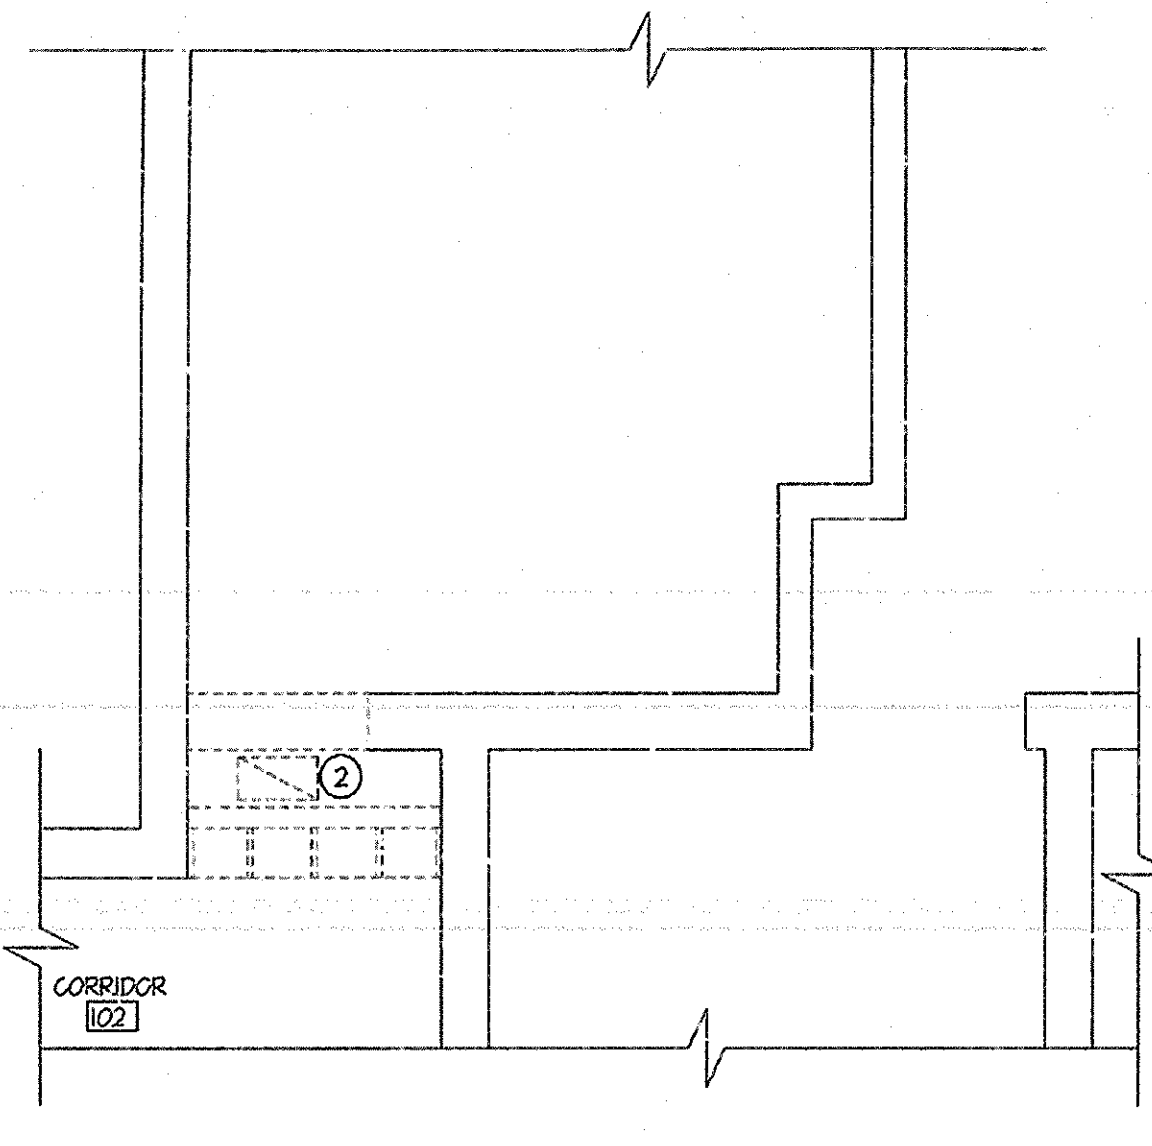

**ENTRY LEVEL FLOOR PLAN - DEMOLITION**  
SCALE: 1/4" = 1'-0"

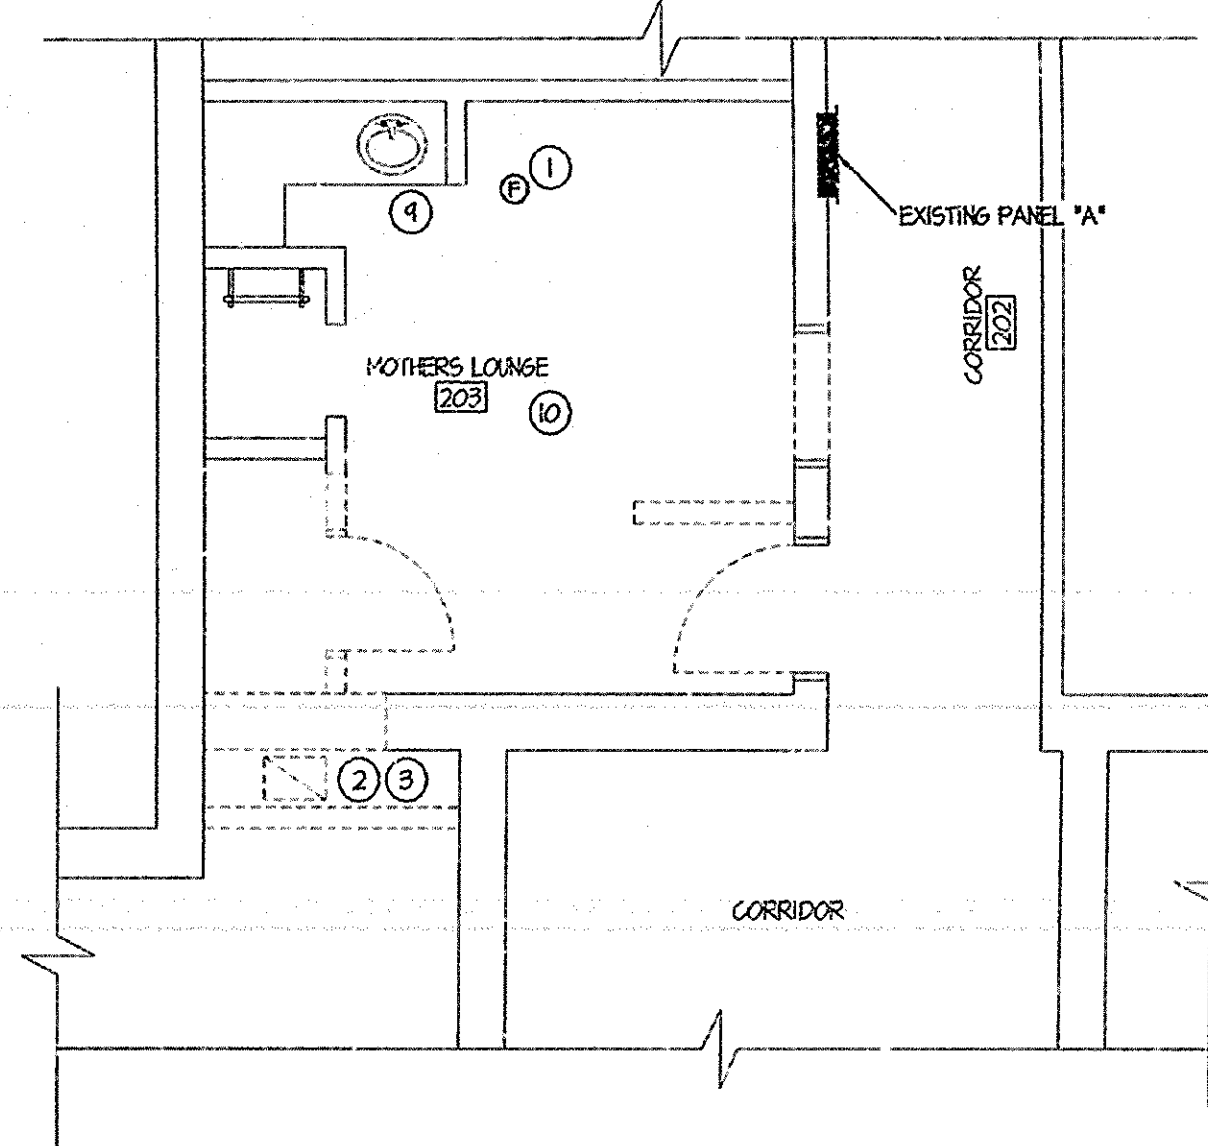


**CHAPEL LEVEL FLOOR PLAN - DEMOLITION**  
SCALE: 1/4" = 1'-0"

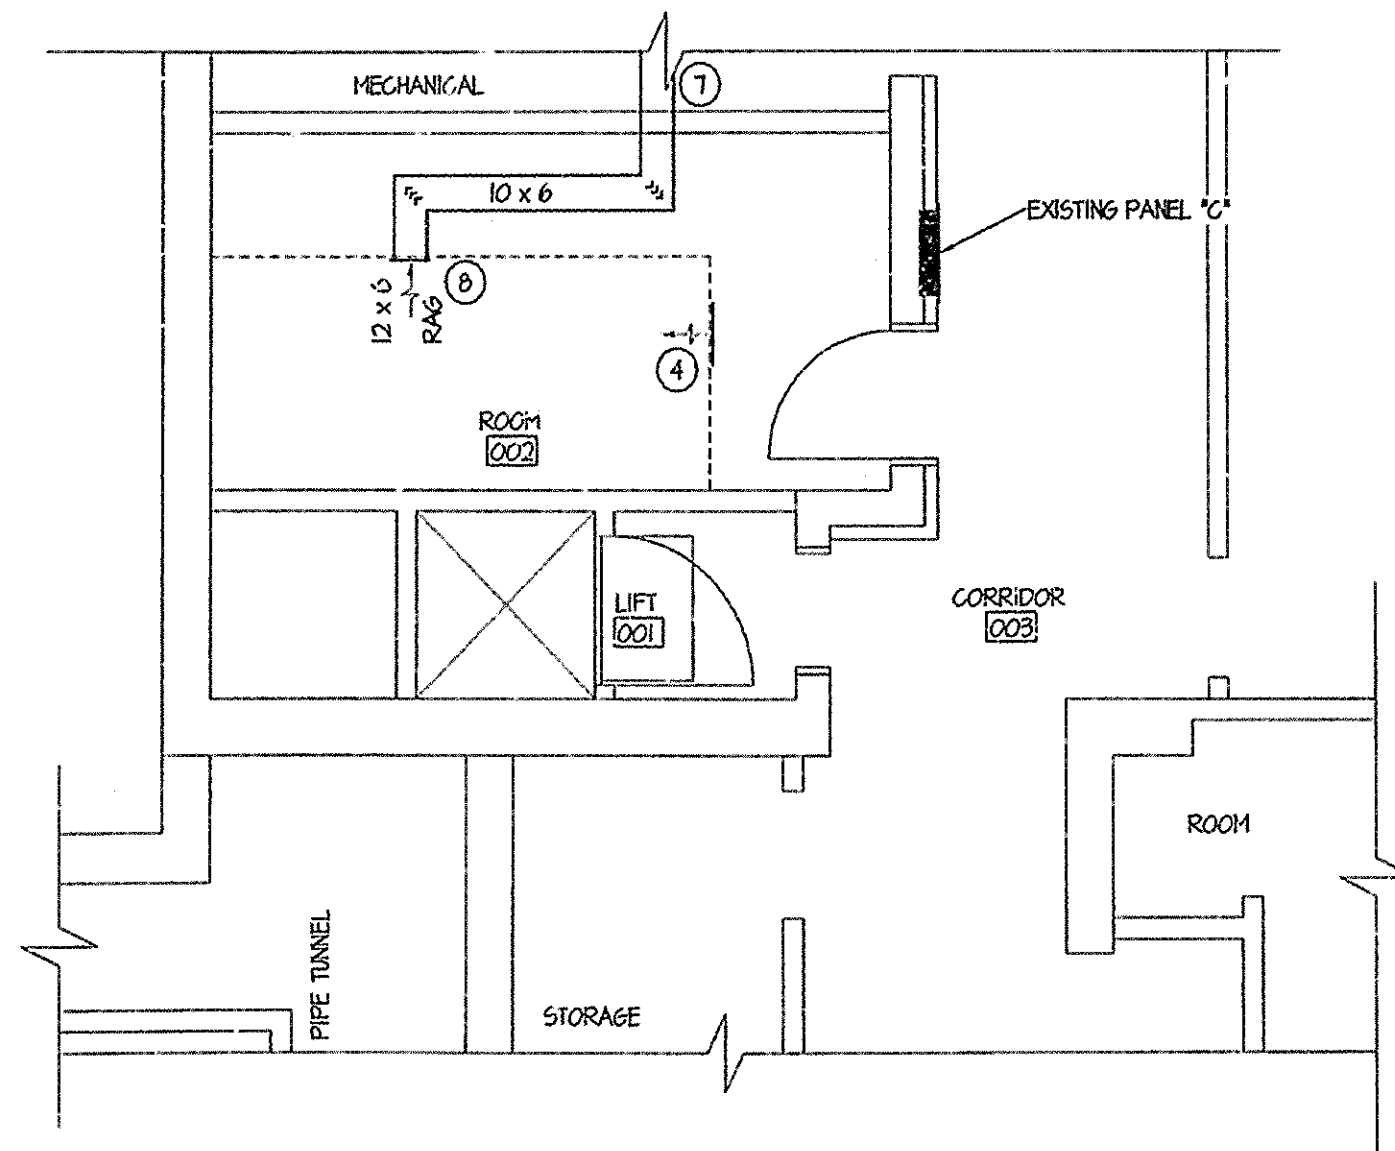

**BASEMENT FLOOR PLAN - MECHANICAL**  
SCALE: 1/4" = 1'-0"

AS BUILT  
25 JULY 1996

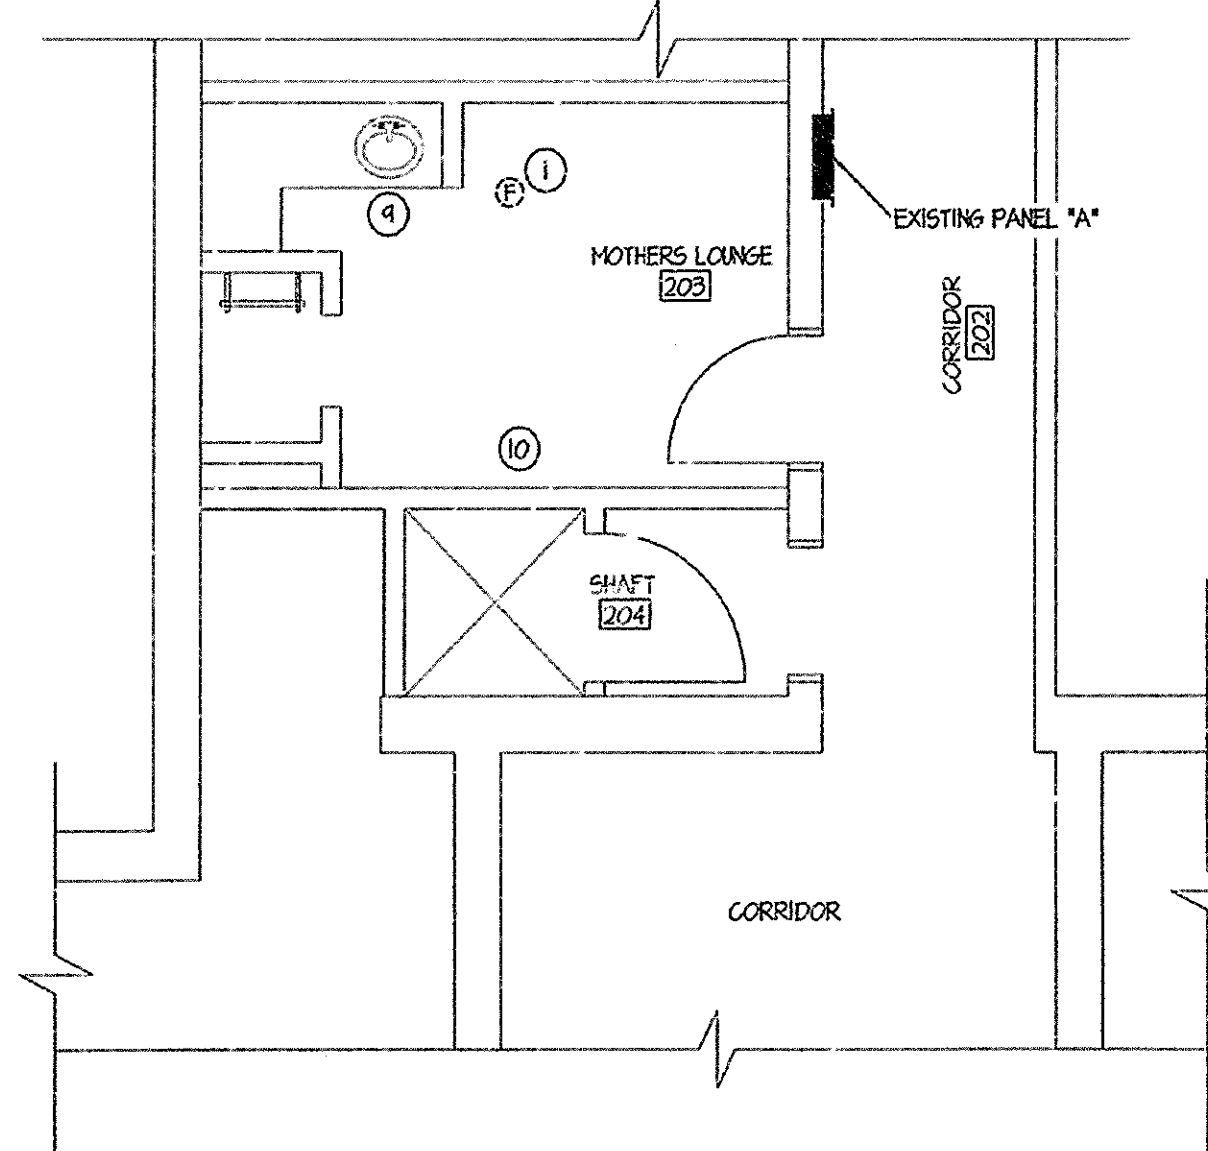

**CHAPEL LEVEL FLOOR PLAN - MECHANICAL**  
SCALE: 1/4" = 1'-0"

**NOTES:**

- 1 EXISTING EXHAUST FAN TO REMAIN.
- 2 REMOVE EXISTING EXHAUST DUCT IN CHASE.
- 3 REMOVE EXISTING EXHAUST FAN ON ROOF AND CAP CURB WITH SHEET METAL CAP.
- 4 EXISTING SUPPLY AIR DUCT, GRILLE TO REMAIN.
- 5 REMOVE EXISTING EXHAUST GRILLE AND DUCT.
- 6 CAP EXISTING RETURN DUCT IN CORRIDOR.
- 7 CONNECT NEW 10 x 6 RETURN DUCT TO EXISTING AIR HANDLER IN BOILER ROOM. CUT AND PATCH WALL AS REQUIRED.
- 8 INSTALL NEW TITUS #859RL 12 x 6 RAG IN EXISTING FUR SPACE CUT AND PATCH AS REQUIRED.
- 9 EXISTING PLUMBING TO REMAIN.
- 10 EXISTING CEILING DIFFUSER TO REMAIN. RELOCATE AS REQUIRED TO MISS NEW CONSTRUCTION.

**JRW ASSOCIATES**  
JOHN R. WATSON-1276  
STATE OF IDAHO  
CONSULTANTS:  
CIVIL ENGINEERING  
HARPER, LEAVITT  
855 No. Capitol  
P.O. Box 36891  
Idaho Falls, Idaho 83405  
(208) 524-0212  
MECHANICAL ENGINEERING  
ENGINEERED SYSTEMS ASSOC.  
315 West Center  
Pocatello, Idaho 83201  
(208) 233-0501  
Fax (208) 233-0529  
ELECTRICAL ENGINEERING  
ENGINEERED SYSTEMS ASSOC.  
315 West Center  
Pocatello, Idaho 83201  
(208) 233-0501  
Fax (208) 233-0529

CONSULTANTS:  
CIVIL ENGINEERING  
HARPER, LEAVITT  
855 No. Capitol  
P.O. Box 36891  
Idaho Falls, Idaho 83405  
(208) 524-0212  
MECHANICAL ENGINEERING  
ENGINEERED SYSTEMS ASSOC.  
315 West Center  
Pocatello, Idaho 83201  
(208) 233-0501  
Fax (208) 233-0529  
ELECTRICAL ENGINEERING  
ENGINEERED SYSTEMS ASSOC.  
315 West Center  
Pocatello, Idaho 83201  
(208) 233-0501  
Fax (208) 233-0529

PROJECT:  
MENAN 1/2  
MENAN IDAHO STAKE  
IDAHO  
DRAWING TITLE:  
FLOOR PLAN MECHANICAL


DATE: 04-18-95  
PROJECT NO: 94609  
SCALE: 1/4" = 1'-0"  
DRAWN BY: JHW  
CHECKED BY: QLS  
DATE: APRIL '95

**ES** ENGINEERED SYSTEMS ASSOCIATES  
315 WEST CENTER  
POCATELLO, IDAHO 83201  
PHONE: (208) 233-0501  
FAX: (208) 233-0529  
PLOT DATE: 04-18-95  
CSA JOB NUMBER: 94050


DRAWING NO. 940001  
**M-1**  
OF 1

24X




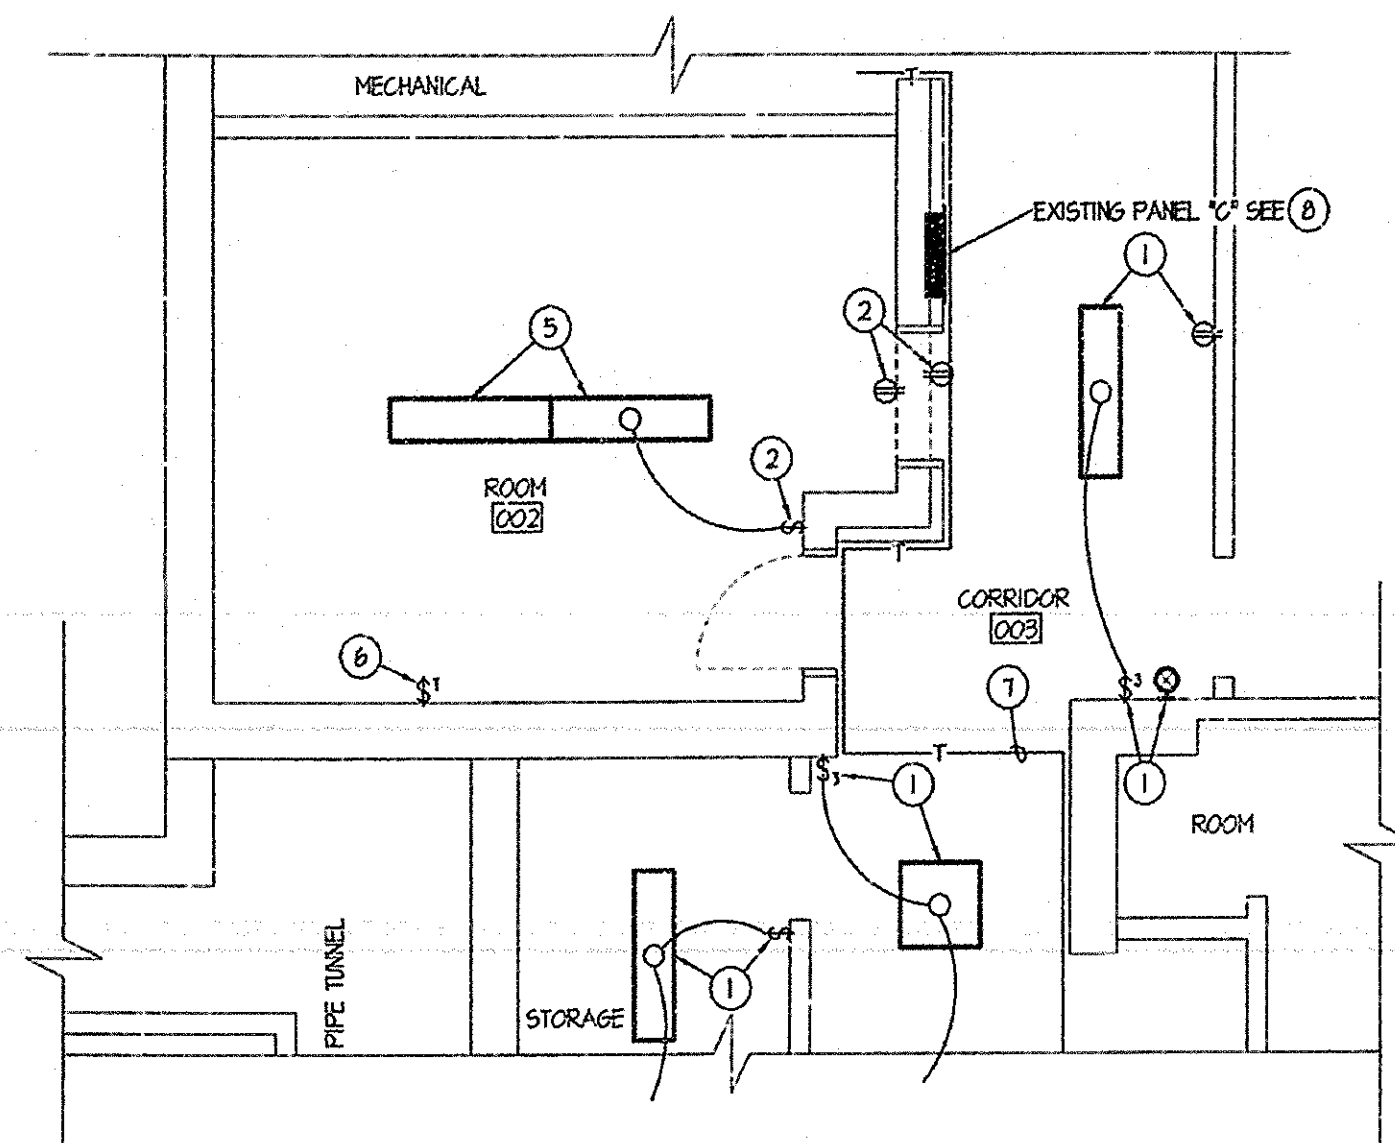


**BASEMENT FLOOR PLAN - DEMOLITION**  
SCALE: 1/4" = 1'-0"

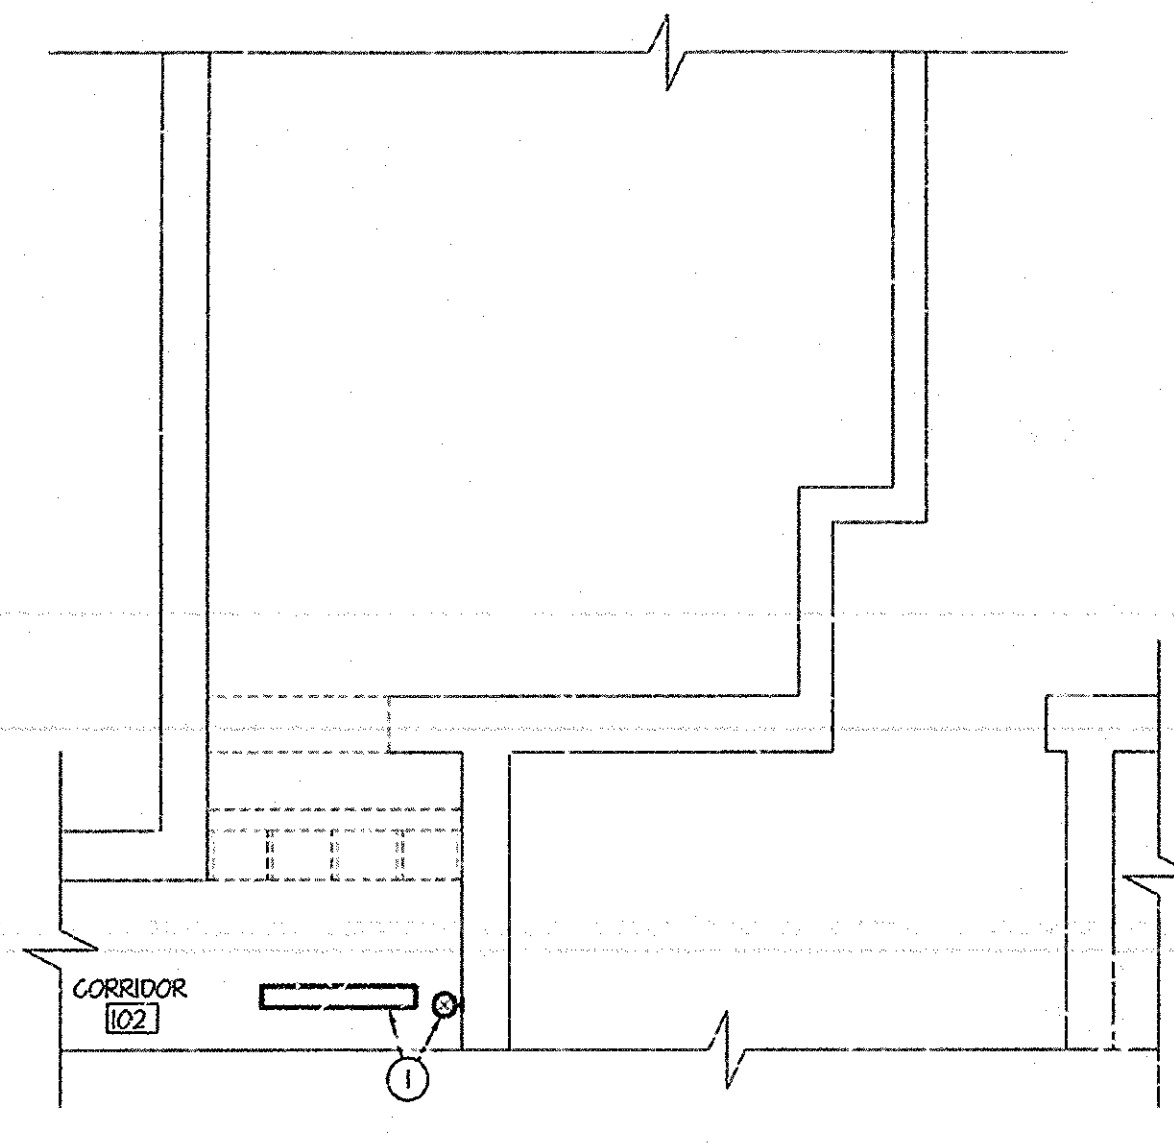


**ENTRY LEVEL FLOOR PLAN - DEMOLITION**  
SCALE: 1/4" = 1'-0"

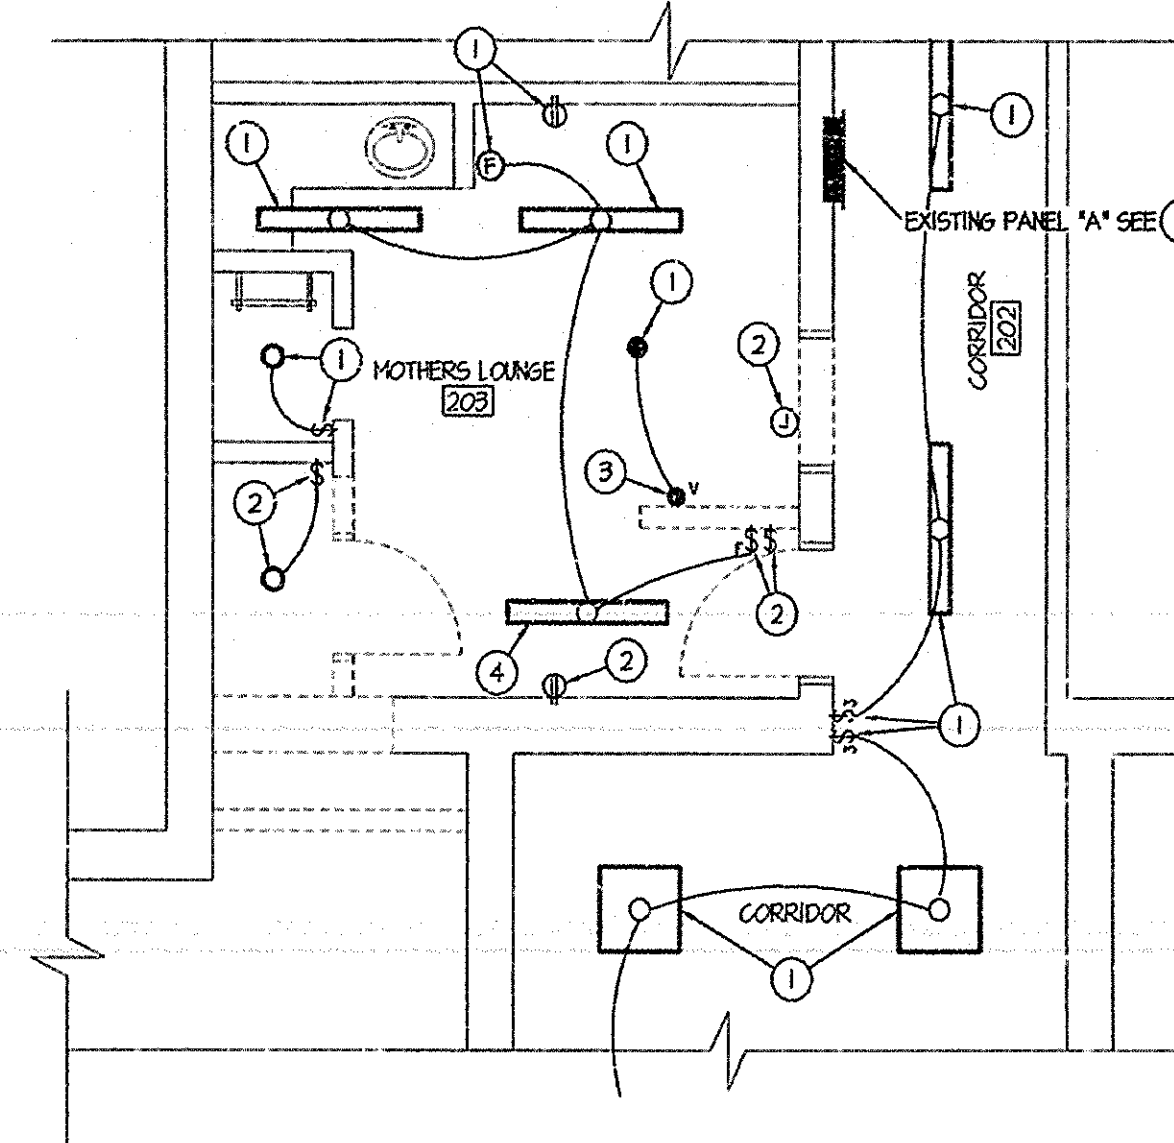


**CHAPEL LEVEL FLOOR PLAN - DEMOLITION**  
SCALE: 1/4" = 1'-0"

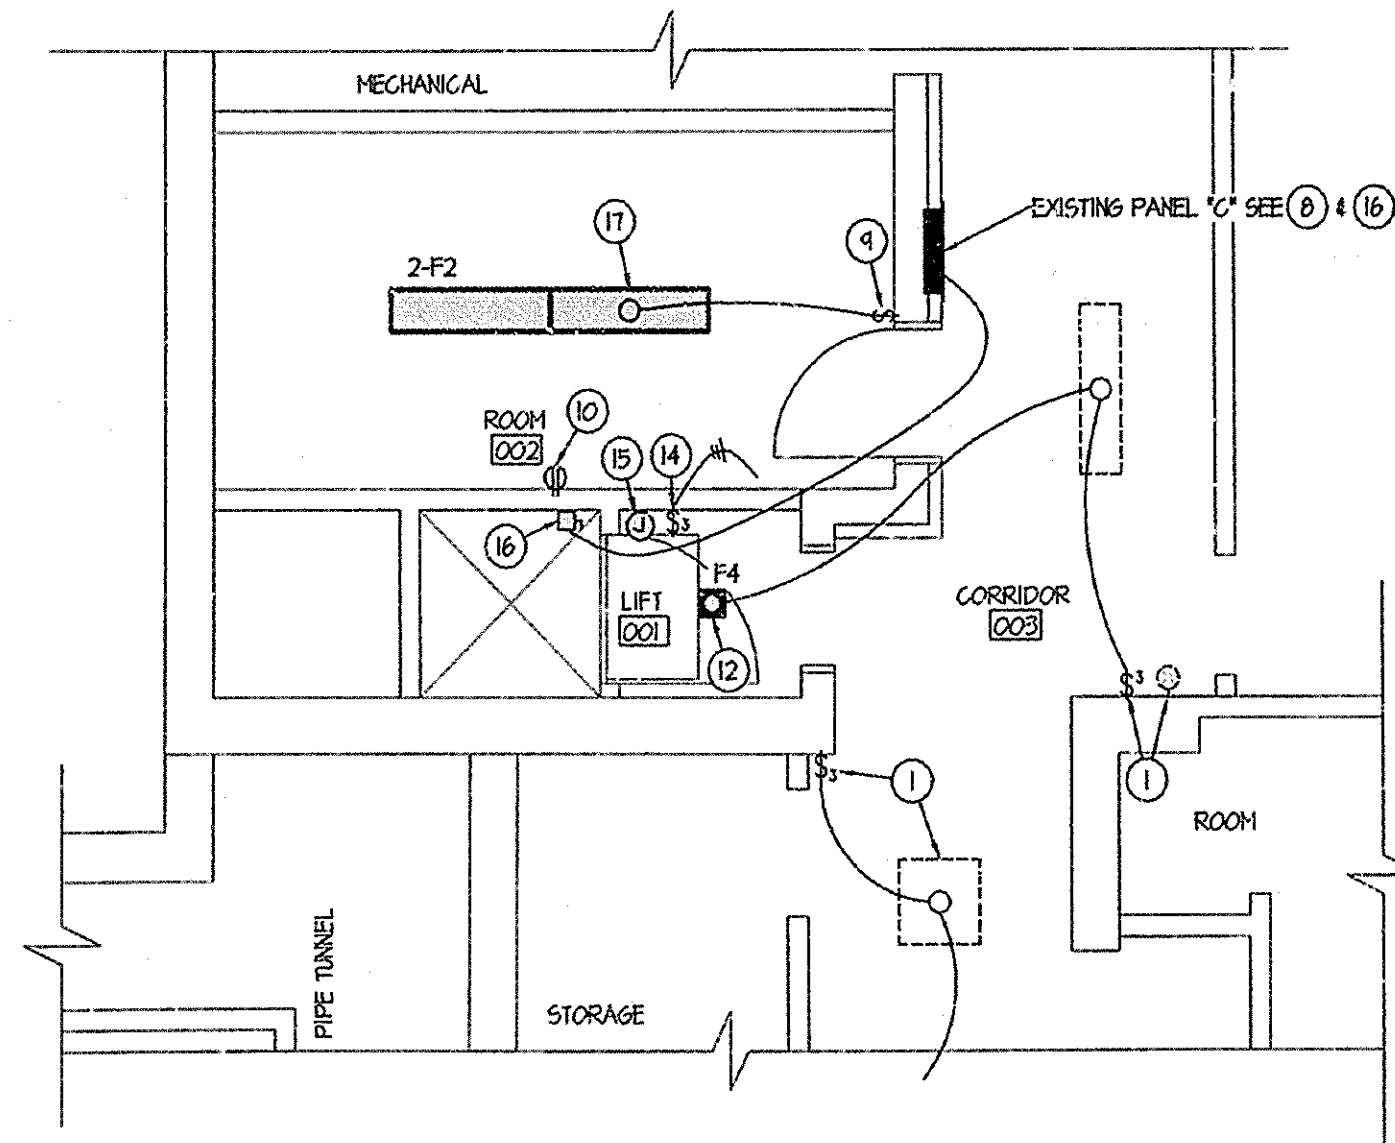

**BASEMENT FLOOR PLAN - ELECTRICAL**  
SCALE: 1/4" = 1'-0"

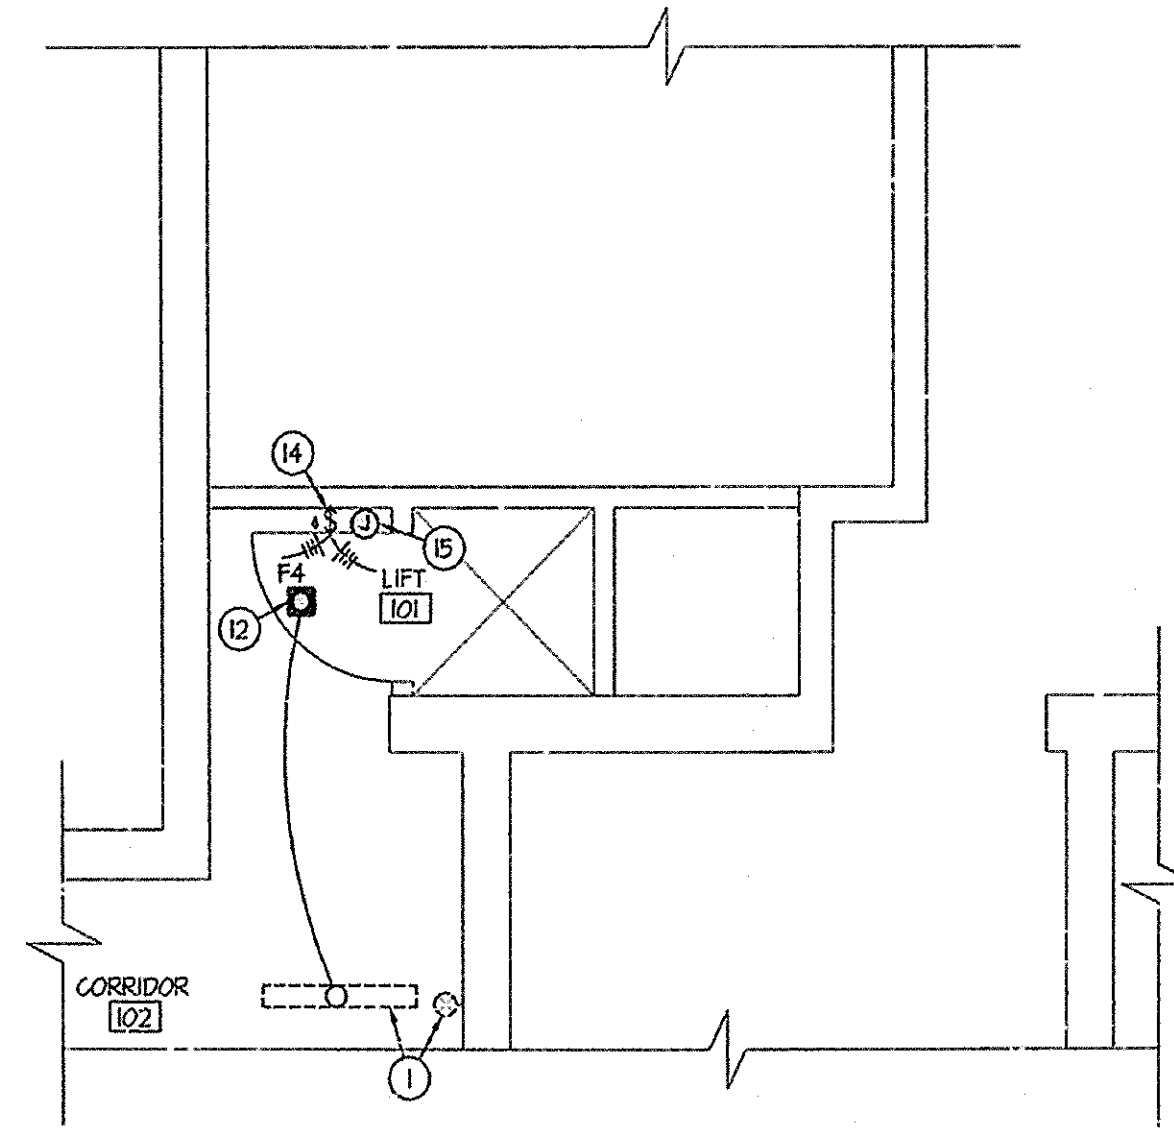

**ENTRY LEVEL FLOOR PLAN - ELECTRICAL**  
SCALE: 1/4" = 1'-0"

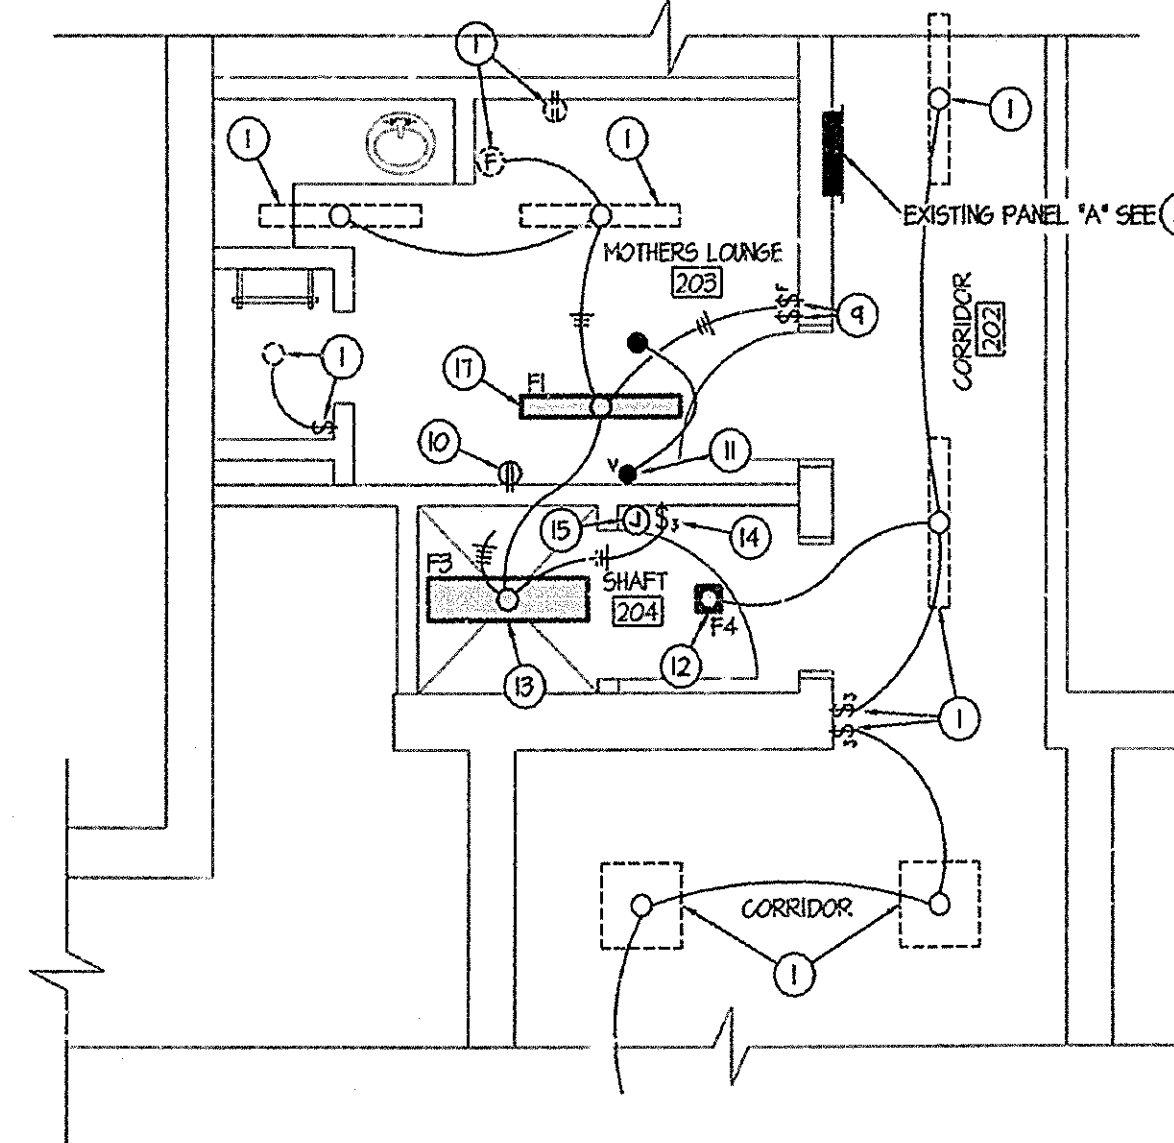

**CHAPEL LEVEL FLOOR PLAN - ELECTRICAL**  
SCALE: 1/4" = 1'-0"

**GENERAL NOTES:**

- REFER TO ARCHITECTS PLANS FOR EXTENT OF DEMOLITION REQUIRED FOR NEW WORK.
- REMOVE ALL ELECTRICAL AS REQUIRED FOR NEW CONSTRUCTION AND AS SHOWN ON THE PLANS.
- CONFIRM LOCATIONS OF EXISTING EQUIPMENT, ETC.
- CONCEAL ALL CONDUITS AND EQUIPMENT IN FINISHED AREAS.
- UTILIZE EXISTING RACEWAYS WHERE PRACTICAL.
- COORDINATE WIRING REQUIREMENTS FOR LIFT WITH EQUIPMENT SUPPLIER.

**PLAN NOTES:**

- EXISTING TO REMAIN - REMOVE ONLY AS NECESSARY FOR WIRING CHANGES.
- REMOVE ENTIRELY AS NECESSARY FOR NEW WORK. EXTEND EXISTING CIRCUITS AS REQUIRED.
- REMOVE VOLUME SWITCH AND RELOCATE AS SHOWN. EXTEND WIRING.
- REMOVE EXISTING FIXTURE AND RE-USE AS TYPE F1.
- REMOVE EXISTING FIXTURE AND RE-USE AS TYPE F2.
- REMOVE EXISTING SWITCH ENTIRELY AND WIRING TO EXHAUST FAN ON ROOF.
- REMOVE EXISTING SURFACE TELEPHONE CABLE AND RE-ROUTE ABOVE NEW CONSTRUCTION.
- EXISTING PANELS TO REMAIN.
- NEW SWITCHES AND COVER PLATE - (5 MIN. TIMER FOR EXHAUST FAN)
- NEW RECEPTACLE AND COVER PLATE, CONNECT TO EXISTING RECEPTACLE CIRCUIT.
- NEW LOCATION OF EXISTING VOLUME SWITCH - RECONNECT TO SOUND SPEAKER.
- CONNECT NEW FIXTURE TO EXISTING CIRCUIT AND CONTROL.
- CONNECT TO EXISTING LIGHTING CIRCUIT.
- 3 AND 4 WAY SWITCH AT EACH LEVEL FOR F3 FIXTURE CONTROL.
- LOCATE "N" BOX AT EACH LEVEL WITH 3/4" CONDUIT BETWEEN (FOR LIFT CONTROL) AS DIRECTED BY LIFT SUPPLIER. FROM BASEMENT LEVEL INSTALL CONDUIT TO EQUIPMENT LOCATION AS DIRECTED.
- 20 AMP, 2 POLE FUSED DISCONNECT SWITCH FOR LIFT POWER SUPPLY. LOCATION AS DIRECTED BY LIFT SUPPLIER. CIRCUIT TO NEW 20 AMP, 1 POLE BREAKER INSTALLED IN EXISTING PANEL "C".
- NEW LOCATION OF EXISTING FIXTURE(S) UTILIZE EXISTING CIRCUIT.

LIGHT FIXTURE SCHEDULE					
TYPE	MANUFACTURER	CATALOG #	MOUNTING	LAMPS	REMARKS
F1	EXISTING FIXTURE TO BE RE-USED		SURFACE ON CEILING	1-F40/SP30	CLEAN AND RELAMP
F2	EXISTING FIXTURE TO BE RE-USED		SURFACE ON CEILING	2-F40/SP30	CLEAN AND RELAMP
F3	LITHONIA	LB-240 A-120	SURFACE ON CEILING	2-F40/SP30	
F4	PRESCOLITE	PKX-T0945	RECESSED	2-F40X51/21	

ELECTRICAL SYMBOL SCHEDULE			
○	FLUORESCENT FIXTURE (TYPICAL)	—	PANELBOARD
⊙	EXIT LIGHT (DIRECTIONAL ARROWS ON DRAWINGS)	—	BRANCH CIRCUIT - CONCEALED
○	CEILING MOUNTED INCAN OR HID FIXTURE	—	BRANCH CIRCUIT - IN FLOOR OR UNDERGROUND
⊞	RECESSED FIXTURE	—	BRANCH CIRCUIT - HOME-RUN TO PANEL
⊞	SINGLE POLE SWITCH	—	CROSS LINES SHOW # OF WIRES IF MORE THAN 2
⊞	3-WAY SWITCH	—	DRAWING NOTE (ON THE SHEET WHERE SUCH)
⊞	4-WAY SWITCH	—	MECHANICAL EQUIPMENT OR DETAIL SYMBOL
⊞	EXHAUST FAN (TIMER) SWITCH	—	FAN MOTOR CONNECTION POINT
⊞	THERMAL OVERLOAD SWITCH (MOTOR) LIGHT	—	INDICATES EXISTING EQUIPMENT
⊞	JUNCTION BOX	—	DISCONNECT SWITCH (FUSED)
⊞	DUPLEX RECEPTACLE (120V/15AMP, GFCI-GRND FLT)		

AS BUILT  
25 JULY 1996

REGISTERED PROFESSIONAL ENGINEER  
STATE OF IDAHO  
L. SUNDERS  
4/19/95

ESA ENGINEERED SYSTEMS ASSOCIATES  
315 WEST CENTER POCAHELLO, IDAHO 83204  
PHONE: (208) 233-0501  
FAX: (208) 233-0529  
PLOT DATE: 04-18-95  
ESA JOB NUMBER: 94050

DRAWING NO. E-1  
OF 1

DATE: APRIL '95

**JEW ASSOCIATES**  
JOHN R. WATSON ARCHITECTS  
STATE OF IDAHO

CONSULTANTS:  
CIVIL ENGINEERING  
HARPER LEAVITT  
395 No. Capitol  
P.O. Box 25001  
Boise, Idaho 83745  
(208) 524-0212

MECHANICAL ENGINEERING  
ENGINEERED SYSTEMS ASSOC.  
315 West Center  
Pocatello, Idaho 83201  
(208) 233-0501  
Fax: (208) 233-0529

ELECTRICAL ENGINEERING  
ENGINEERED SYSTEMS ASSOC.  
315 West Center  
Pocatello, Idaho 83201  
(208) 233-0501  
Fax: (208) 233-0529

PROJECT: MENAN 12 MENAN IDAHO STAKE IDAHO  
DRAWING TITLE: FLOOR PLAN ELECTRICAL

24X




**GENERAL NOTES**


- (A) CONTRACTOR & SUBCONTRACTOR SHALL FIELD VERIFY DIMENSIONS, EXISTING CONDITIONS & AREAS AFFECTED BY CONSTRUCTION PRIOR TO SUBMISSION OF BIDS & BEFORE COMMENCING WORK. NOTIFY ARCHITECT IMMEDIATELY OF CONDITIONS OR PROBLEMS NOT IN ACCORDANCE WITH CONTRACT DOCUMENTS.
- (B) CONTRACTOR IS RESPONSIBLE FOR REPAIRS DUE TO DAMAGE OF EXISTING WORK AS A RESULT OF NEW WORK. MATCH EXISTING MATERIALS / FINISHES WHERE REPAIRS ARE NECESSARY & AS DIRECTED BY ARCHITECT.
- (C) REMOVE RUBBISH / DEBRIS FROM PROPERTY. DISPOSE OF TRASH PROPERLY USING APPROVED DISPOSAL SITES FOR TYPE OF MATERIAL ENCOUNTERED. CONSULT LOCAL AUTHORITIES AS REQUIRED.
- (D) VERIFY LOCATION OF EXISTING UTILITIES WITH LOCAL AUTHORITIES. UNDERGROUND UTILITIES HAVE NOT BEEN INDEPENDENTLY VERIFIED BY OWNER OR ITS REPRESENTATIVE. CONTRACTOR SHALL DETERMINE LOCATION OF EXISTING UTILITIES BEFORE COMMENCING WORK AND SHALL BE RESPONSIBLE FOR DAMAGES OCCASIONED BY FAILURE TO LOCATE AND PRESERVE UTILITY LINES.
- (E) BASE BID TO INCLUDE 1500 LINEAL FEET OF CRACK REPAIR.

**PLAN NOTES**


- (1) EXTEND ASPHALT PAVING
- (2) PAINT STRIPES TO BE 4" WIDE - TYPICAL
- (3) SHADED AREA INDICATES EXTENT OF PARKING AREA TO BE SEALED, CRACK REPAIRED & RE-STRIPED
- (4) REMOVE EXISTING DAMAGED PAVEMENT AND BASE TO 30" BELOW ASPHALT. INSTALL COMPACTED SUB-BASE & BASE. INSTALL NEW ASPHALT.
- (5) REMOVE EXISTING CONC. CURB (APPROX. ? LN. FT.)
- (6) NEW CONCRETE CURB - SEE ASD1
- (7) PAINT STRIPES 4" WIDE AND 2'-0" O.C. DIAGONAL LINES.
- (8) STRIP EXISTING VEGETATION LAYER & TOP SOIL LAYER AS REQUIRED.
- (9) NOT USED
- (10) REMOVE EXISTING TREE STUMP
- (11) REPAIR EXISTING PAVEMENT CUT & FILL IN WITH NEW ASPHALT.
- (12) MATCH EXISTING ELEVATION
- (13) BUILD UP NEW ASPHALT GRADE ELEVATION 5" ABOVE EXISTING.

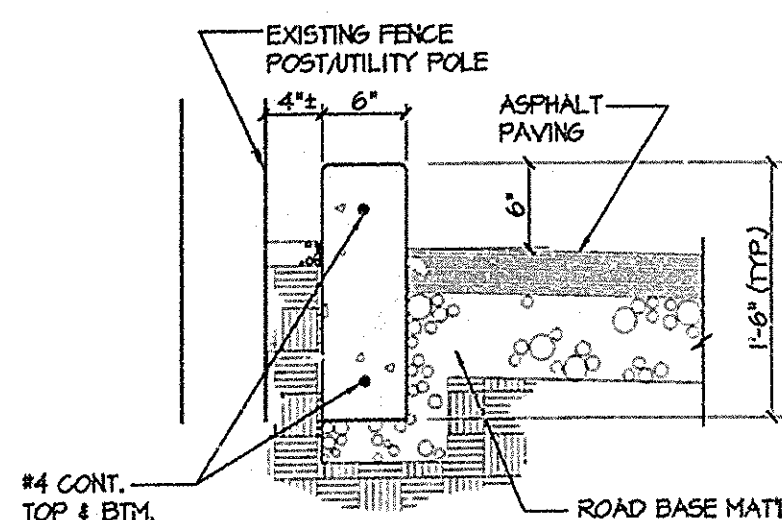

**CURB DETAIL**  
SCALE: 1" = 10"

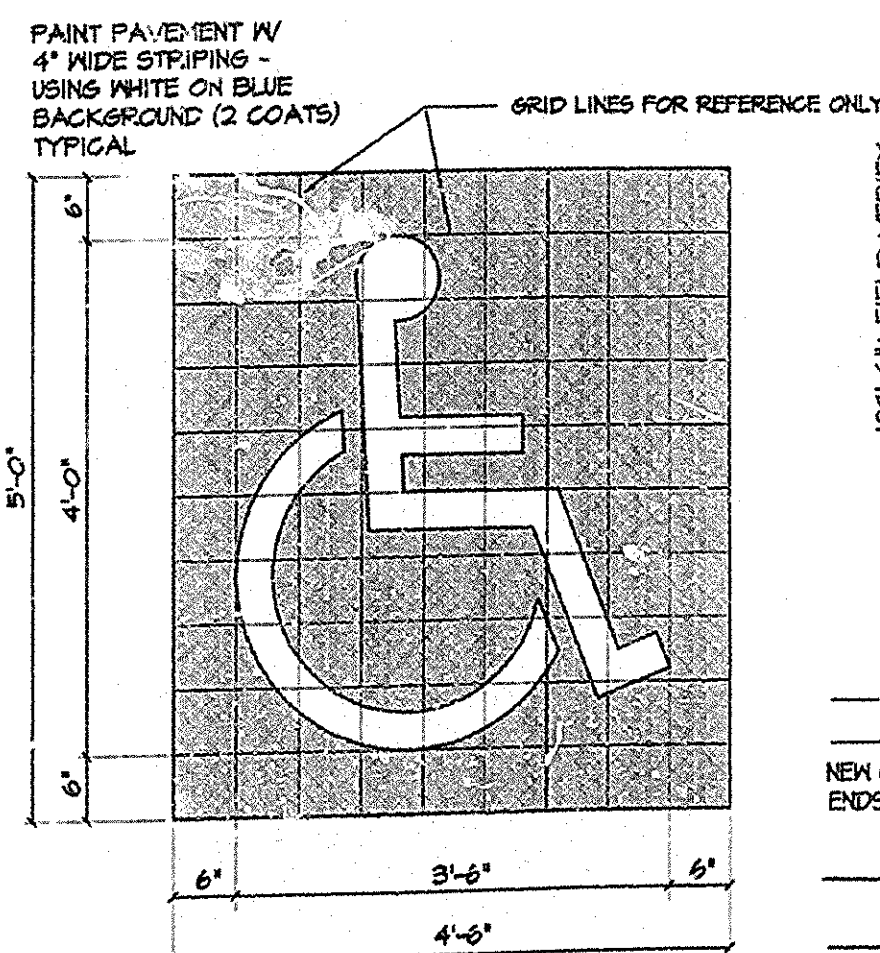

**BARRIER FREE SYMBOL**  
SCALE: N.T.S.

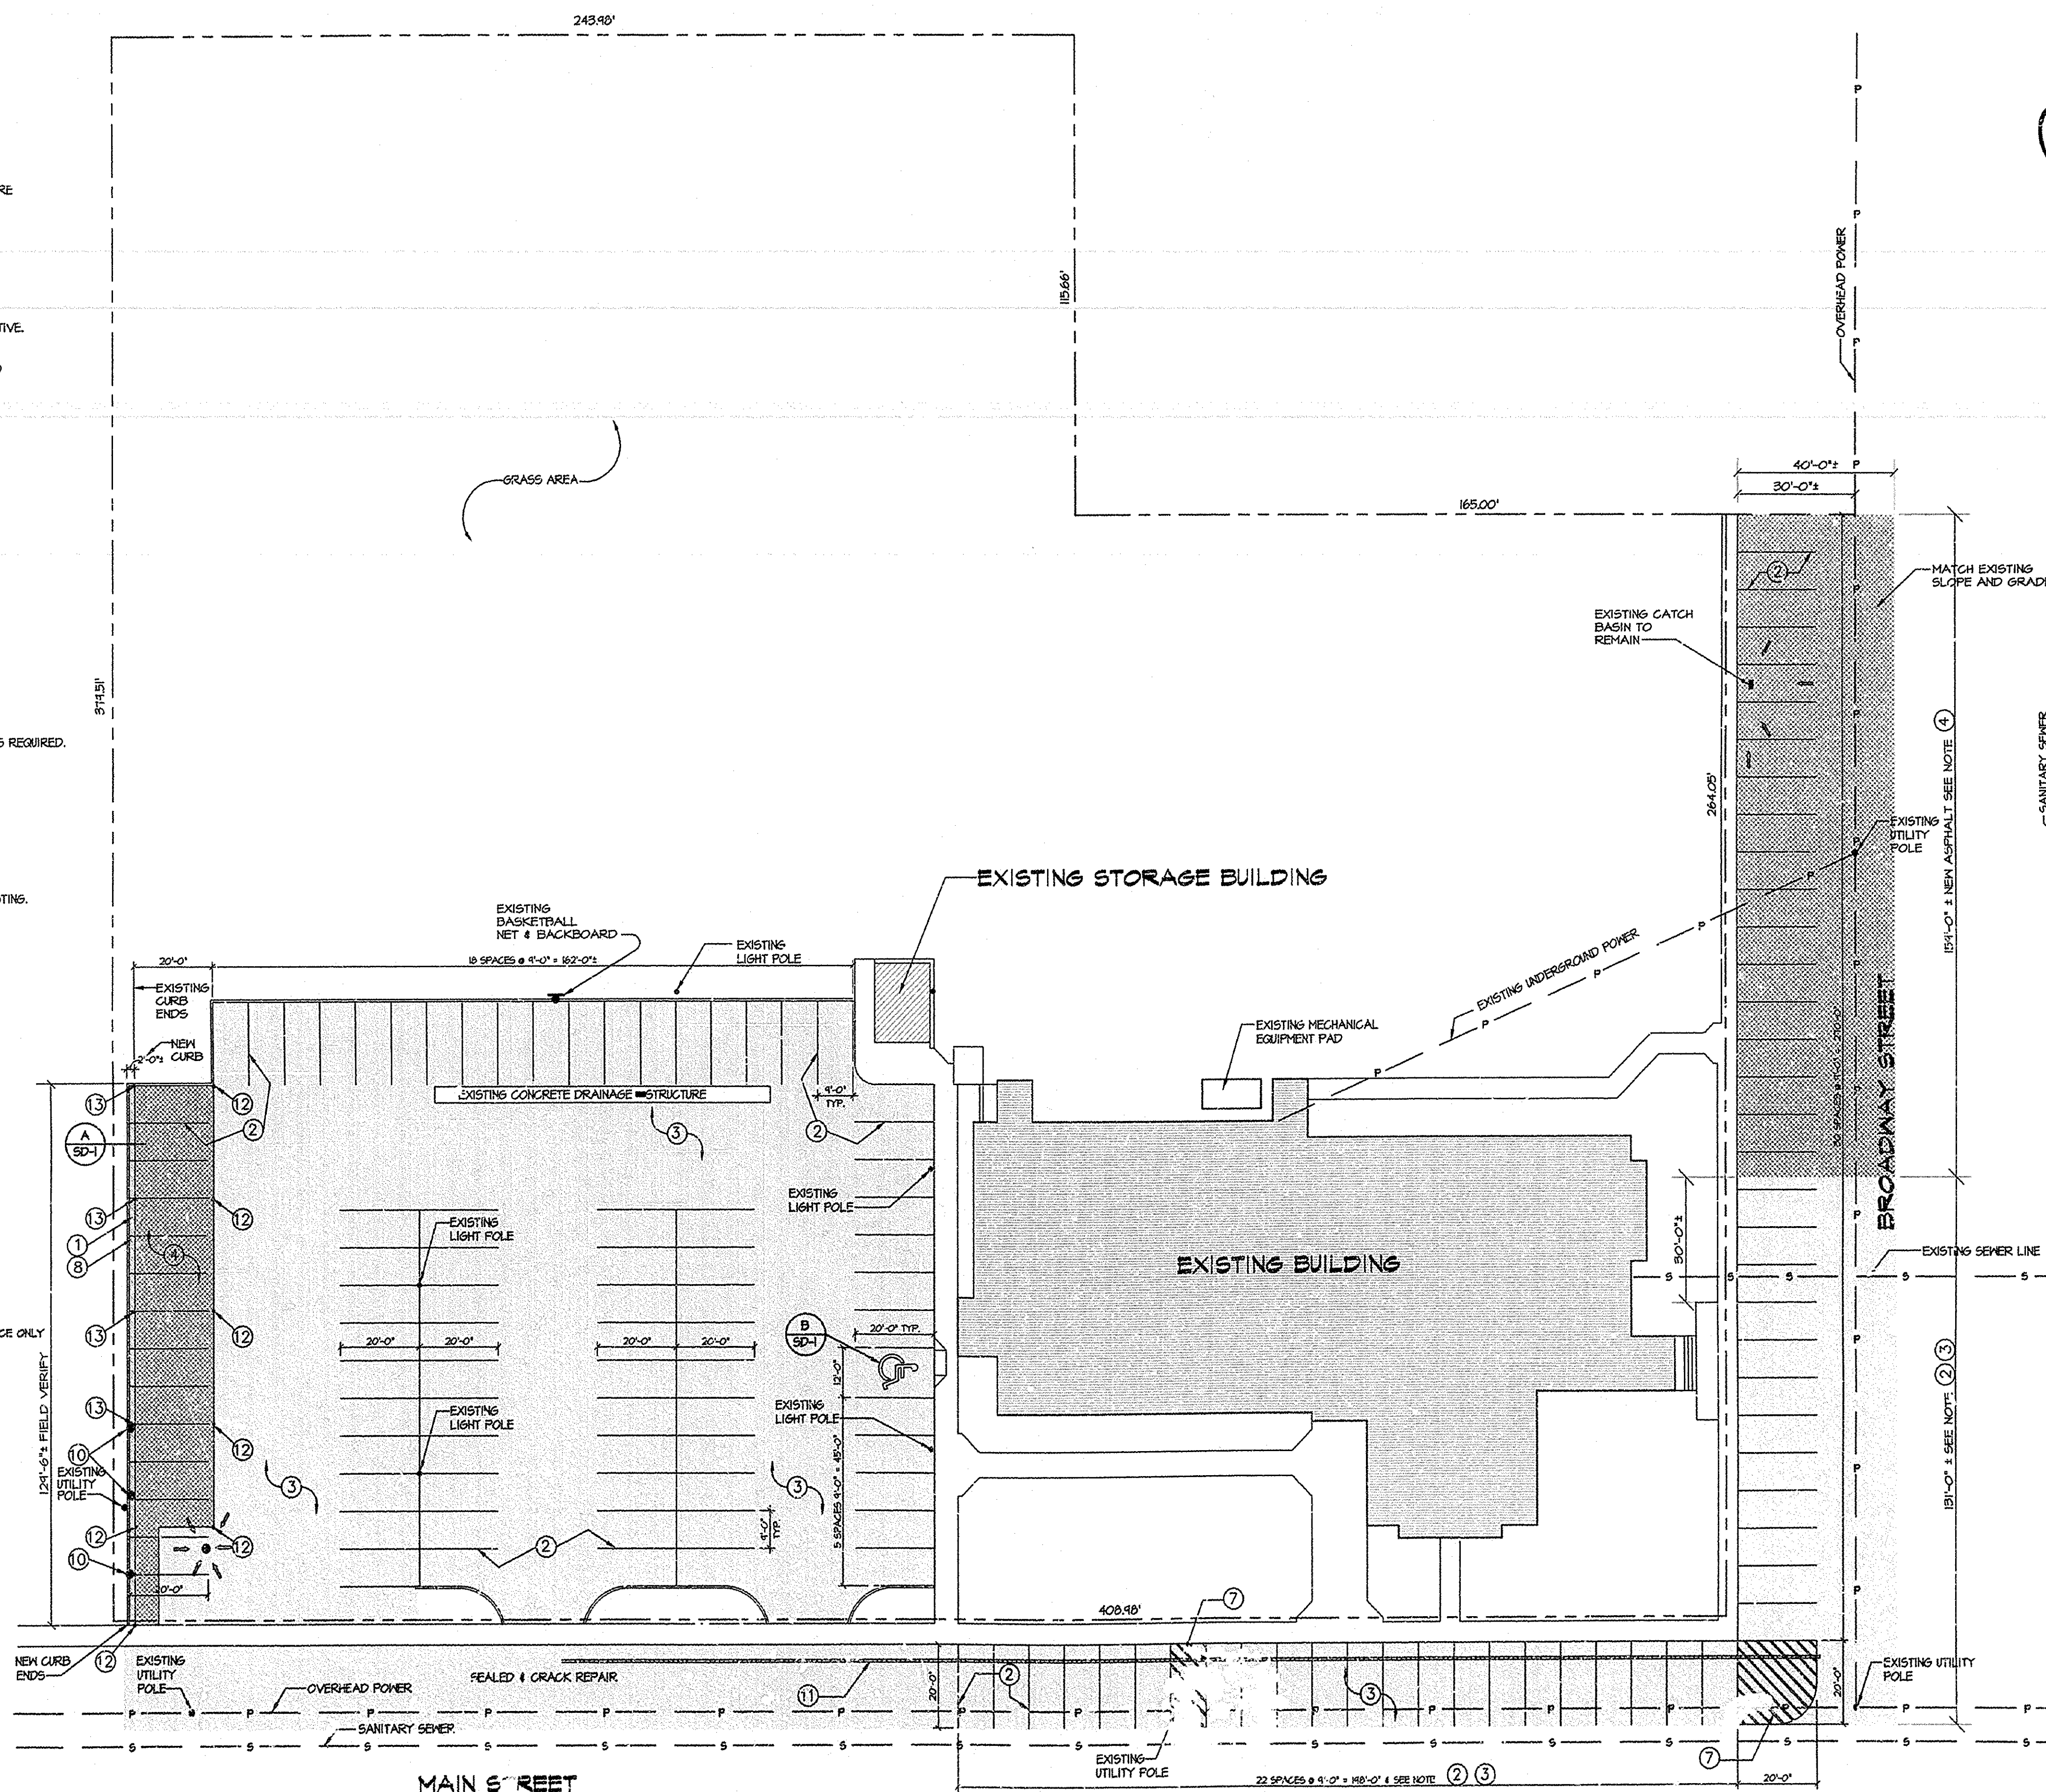

**SITE PLAN**  
SCALE: 1" = 20'-0"

PROPERTY NUMBER - \*507-2638

**JRW ASSOCIATES**  
JOHN R. WATSON, P.E. 1276  
STATE OF IDAHO

**JRW ASSOCIATES**  
ARCHITECTURE - ENGINEERING  
CONSTRUCTION MANAGEMENT  
JOHN R. WATSON, P.E. 1276  
STATE OF IDAHO

**CONSULTANTS:**  
CIVIL ENGINEERING  
HARPER - LEWITT  
205 N. 2nd St.  
P.O. Box 50691  
Boise, Idaho 83720  
Phone: (208) 333-0502  
Fax: (208) 333-0529  
MECHANICAL ENGINEERING  
ENGINEERED SYSTEMS ASSOC.  
315 West Center  
Pocahontas, Idaho 83201  
Phone: (208) 233-0501  
Fax: (208) 233-0529  
ELECTRICAL ENGINEERING  
ENGINEERED SYSTEMS ASSOC.  
315 West Center  
Pocahontas, Idaho 83201  
Phone: (208) 233-0501  
Fax: (208) 233-0529

**PROJECT:**  
MENAN, 1, 2  
MENAN IDAHO STAKE  
IDAHO  
DRAWING TITLE:  
SITE PLAN

PROJECT No. 843-01-013  
DATE: APRIL '98  
DRAWN BY: ERV  
CHECKED BY: JES

**DRAWING NO.**  
SD-1  
OF 1

5-009

24X






**GENERAL NOTES**

- A CONTRACTOR & SUBCONTRACTOR SHALL FIELD VERIFY DIMENSIONS, EXISTING CONDITIONS & AREAS AFFECTED BY CONSTRUCTION PRIOR TO SUBMISSION OF BIDS & BEFORE COMMENCING WORK. NOTIFY ARCHITECT IMMEDIATELY OF CONDITIONS OR PROBLEMS NOT IN ACCORDANCE WITH CONTRACT DOCUMENTS.
- B CONTRACTOR IS RESPONSIBLE FOR REPAIRS DUE TO DAMAGE OF EXISTING WORK AS A RESULT OF NEW WORK. MATCH EXISTING MATERIALS / FINISHES WHERE REPAIRS ARE NECESSARY & AS DIRECTED BY ARCHITECT.
- C REMOVE RUBBISH / DEBRIS FROM PROPERTY. DISPOSE OF TRASH PROPERLY USING APPROVED DISPOSAL SITES FOR TYPE OF MATERIAL ENCOUNTERED. CONSULT LOCAL AUTHORITIES AS REQUIRED.
- D VERIFY LOCATION OF EXISTING UTILITIES WITH LOCAL AUTHORITIES. UNDERGROUND UTILITIES HAVE NOT BEEN INDEPENDENTLY VERIFIED BY OWNER OR ITS REPRESENTATIVE. CONTRACTOR SHALL DETERMINE LOCATION OF EXISTING UTILITIES BEFORE COMMENCING WORK AND SHALL BE RESPONSIBLE FOR DAMAGES OCCASIONED BY FAILURE TO LOCATE AND PRESERVE UTILITY LINES.
- E BASE BID TO INCLUDE 1500 LINEAL FEET OF CRACK REPAIR.

**PLAN NOTES**

- 1 EXTEND ASPHALT PAVING
- 2 PAINT STRIPES TO BE 4" WIDE - TYPICAL.
- 3 SHADED AREA INDICATES EXTENT OF PARKING AREA TO BE SEALED, CRACK REPAIRED & RE-STRIPED
- 4 REMOVE EXISTING DAMAGED PAVEMENT AND BASE TO 30" BELOW ASPHALT. INSTALL COMPACTED SUB-BASE & BASE. INSTALL NEW ASPHALT.
- 5 NOT USED
- 6 NOT USED
- 7 PAINT STRIPES 4" WIDE AND 2'-0" O.C. DIAGONAL LINES.
- 8 STRIP EXISTING VEGETATION LAYER & TOP SOIL LAYER AS REQUIRED.
- 9 NOT USED
- 10 REMOVE EXISTING TREE STUMP
- 11 REPAIR EXISTING PAVEMENT CUT & FILL IN WITH NEW ASPHALT.
- 12 MATCH EXISTING ELEVATION.
- 13 BUILD UP NEW ASPHALT GRADE ELEVATION 5" ABOVE EXISTING.

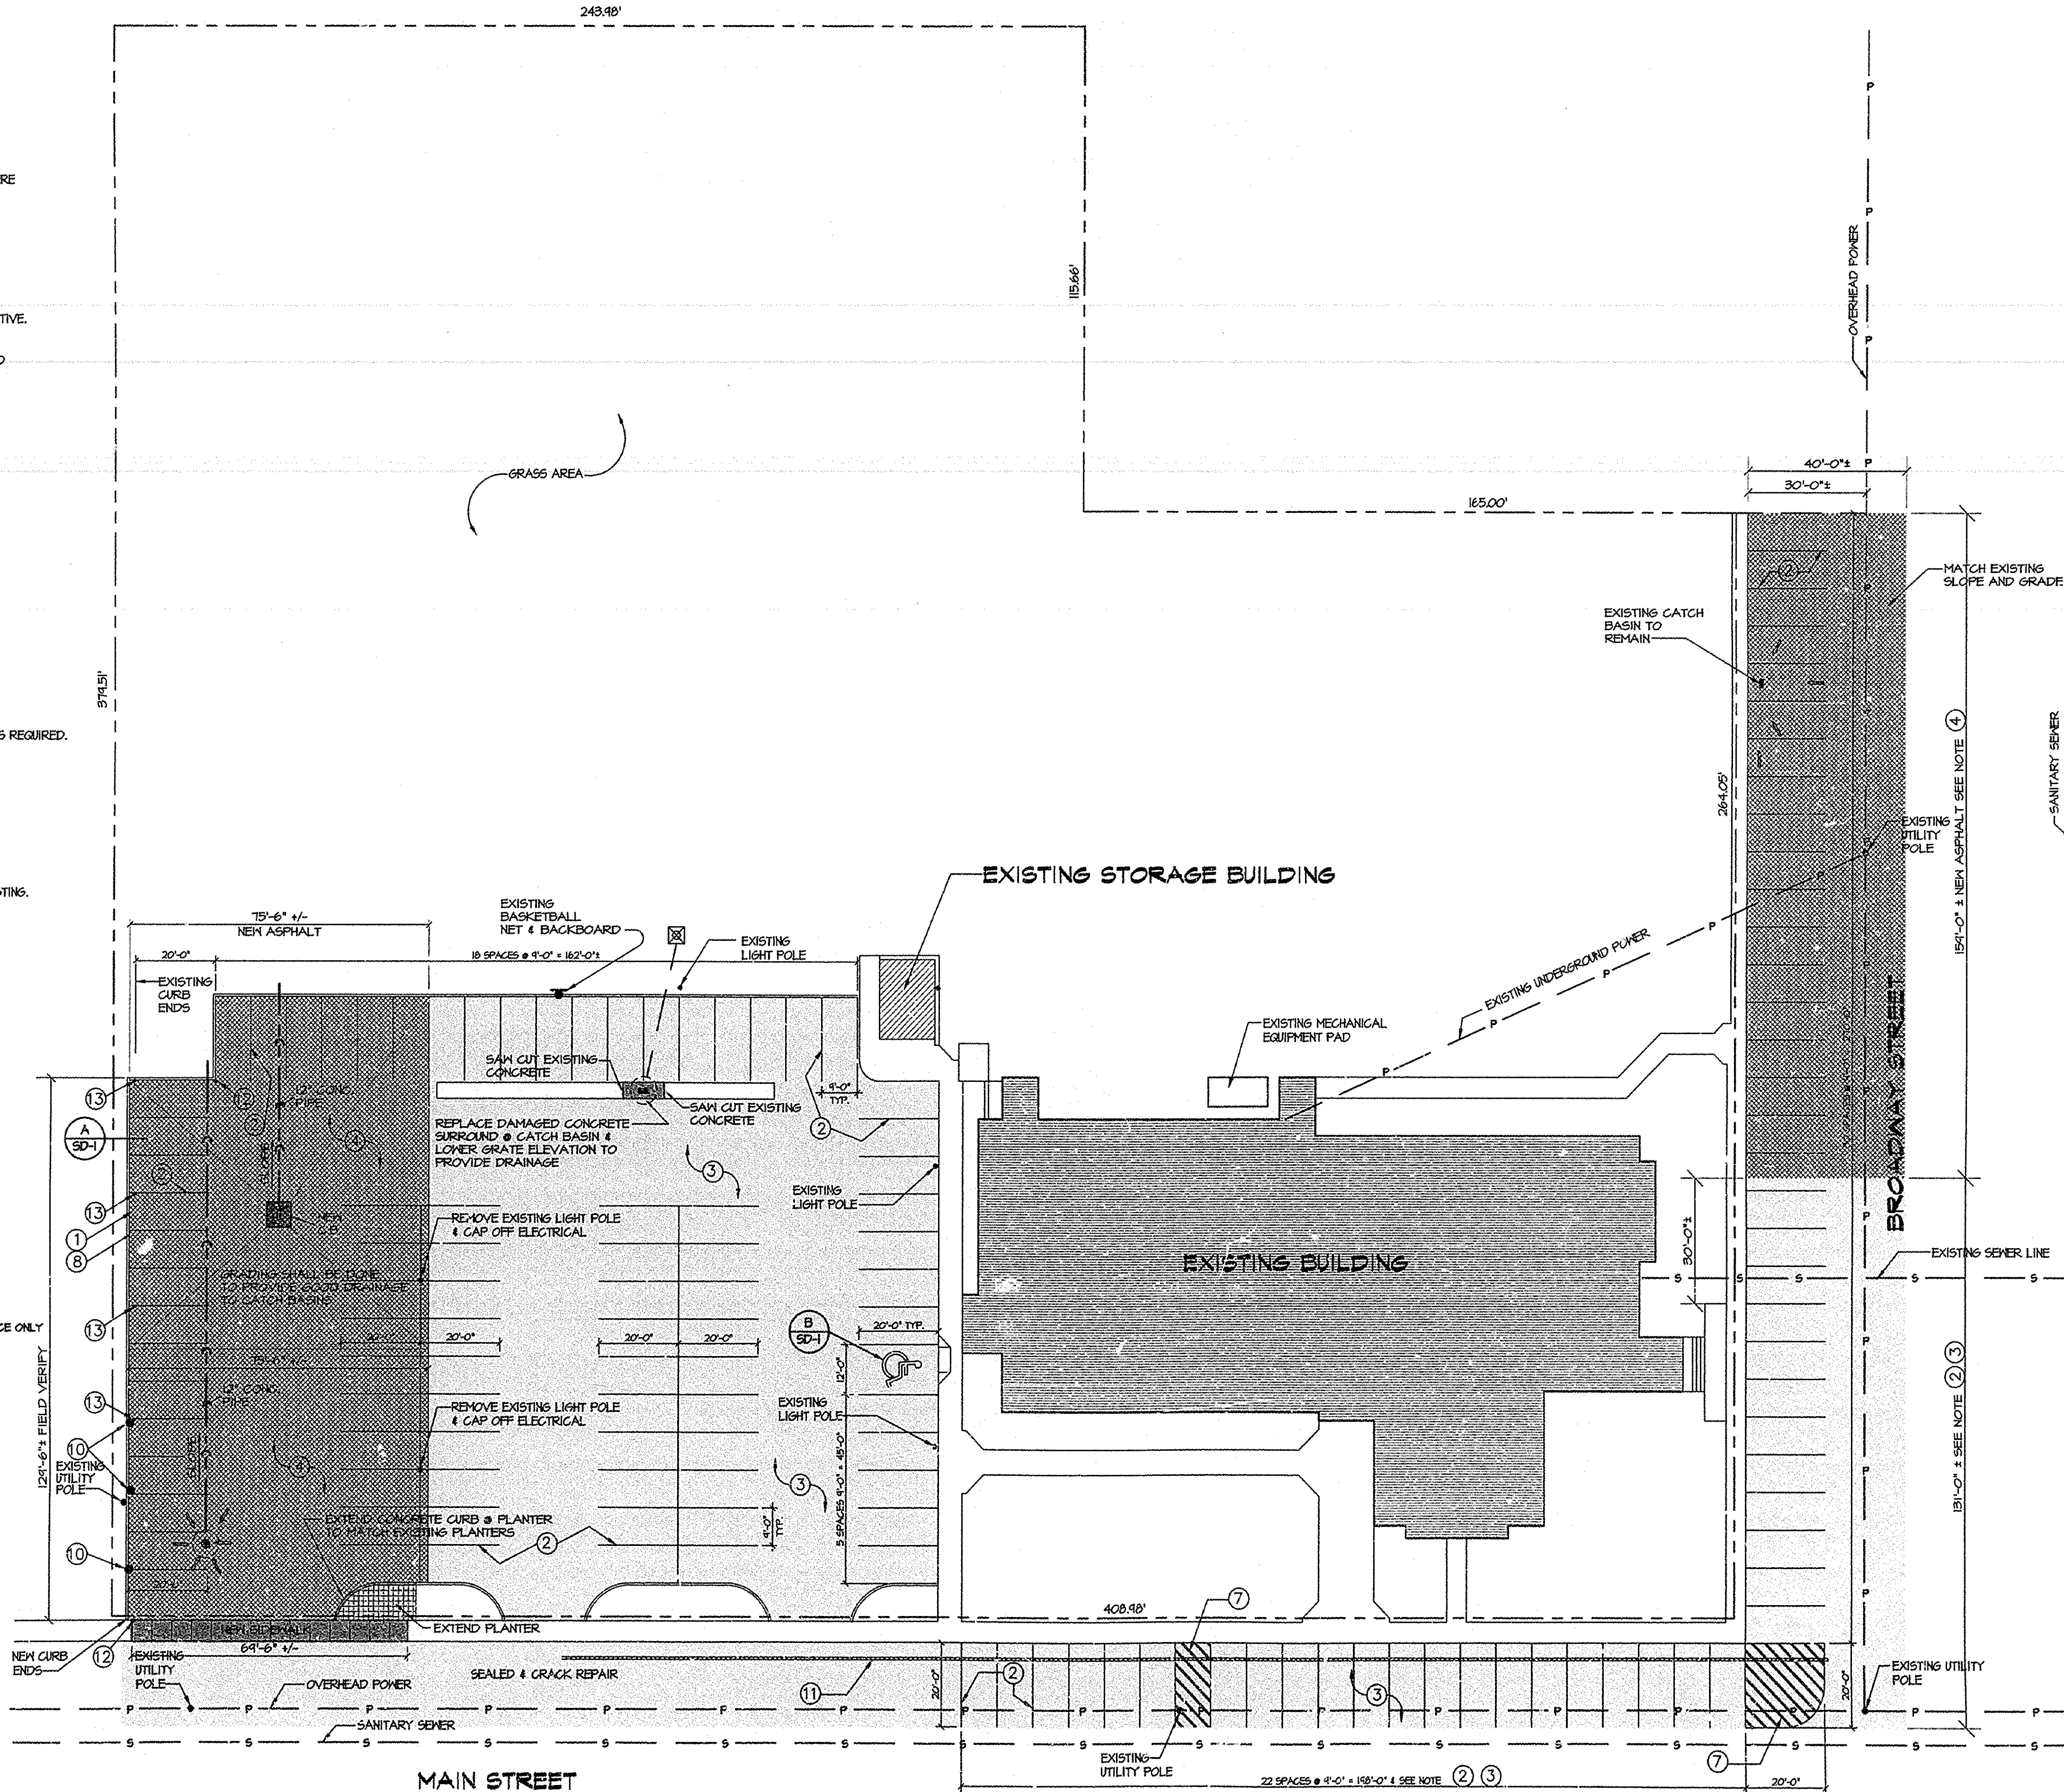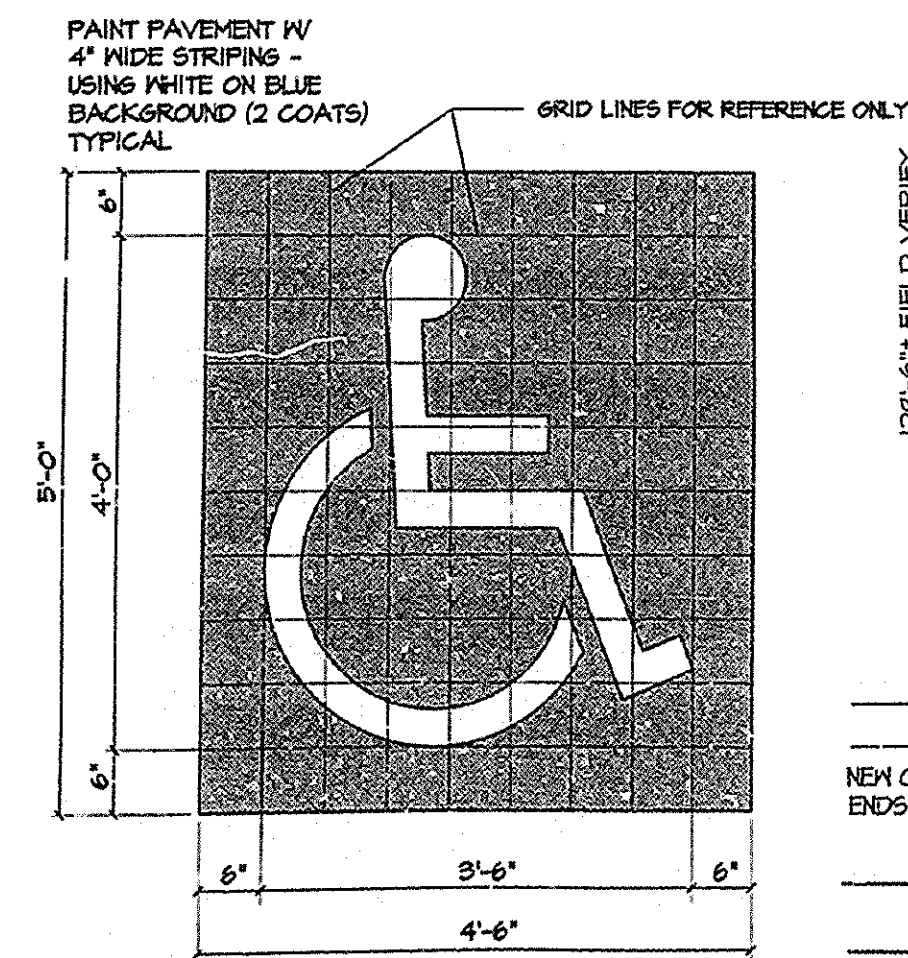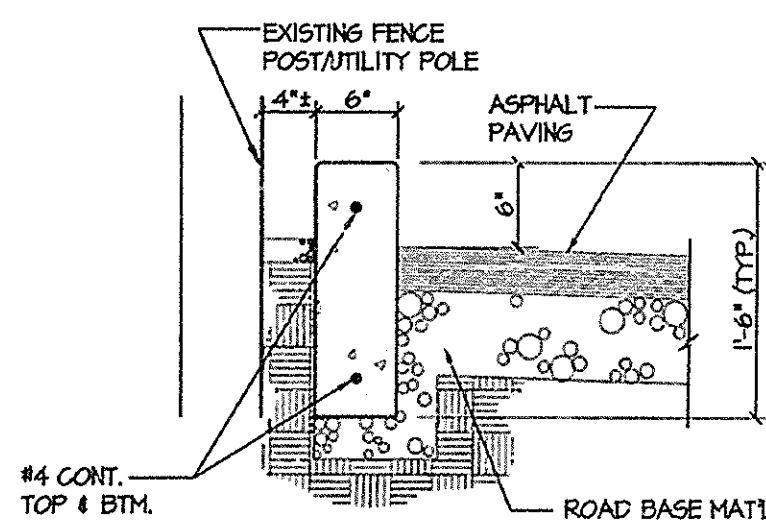

**JRW ASSOCIATES**

JOHN R. WATSON AR-1276

---

STATE OF IDAHO

---

**JRW ASSOCIATES**

ARCHITECTS-ENGINEERS-CONSTRUCTION MANAGEMENT

JOHN R. WATSON ARCHITECT, BOARD #2448

---

CONSULTANTS:

**CIVIL ENGINEERING**  
HARPER - LEVITT  
955 1st. Center  
P.O. Box 56691  
Boise Falls, Idaho 83405  
(208) 324-0212

**MECHANICAL ENGINEERING**  
ENGINEERED SYSTEMS ASSOC.  
315 West Center  
Pocatello, Idaho 83201  
(208) 233-0509  
Fax (208) 233-0529

**ELECTRICAL ENGINEERING**  
ENGINEERED SYSTEMS ASSOC.  
315 West Center  
Pocatello, Idaho 83201  
(208) 233-0509  
Fax (208) 233-0529

---

**MENAN, IDAHO**

**MENAN IDAHO STAKE**

**SITE PLAN**

---

PROJECT: MENAN, IDAHO

DRAWING TITLE: SD-1

---

REV DATE PROJECT NO. FOR SCALE JOB NO. DATE APRIL '05

DRAWN BY: JRW CHECKED BY: JRW

---

DRAWING NO. 013901

**SD-1**

OF 1




PROPERTY NUMBER - #507-2638

E:\013\013501.dwg Thu Oct 31 14:00:03 1995 GUR


15-010

24X





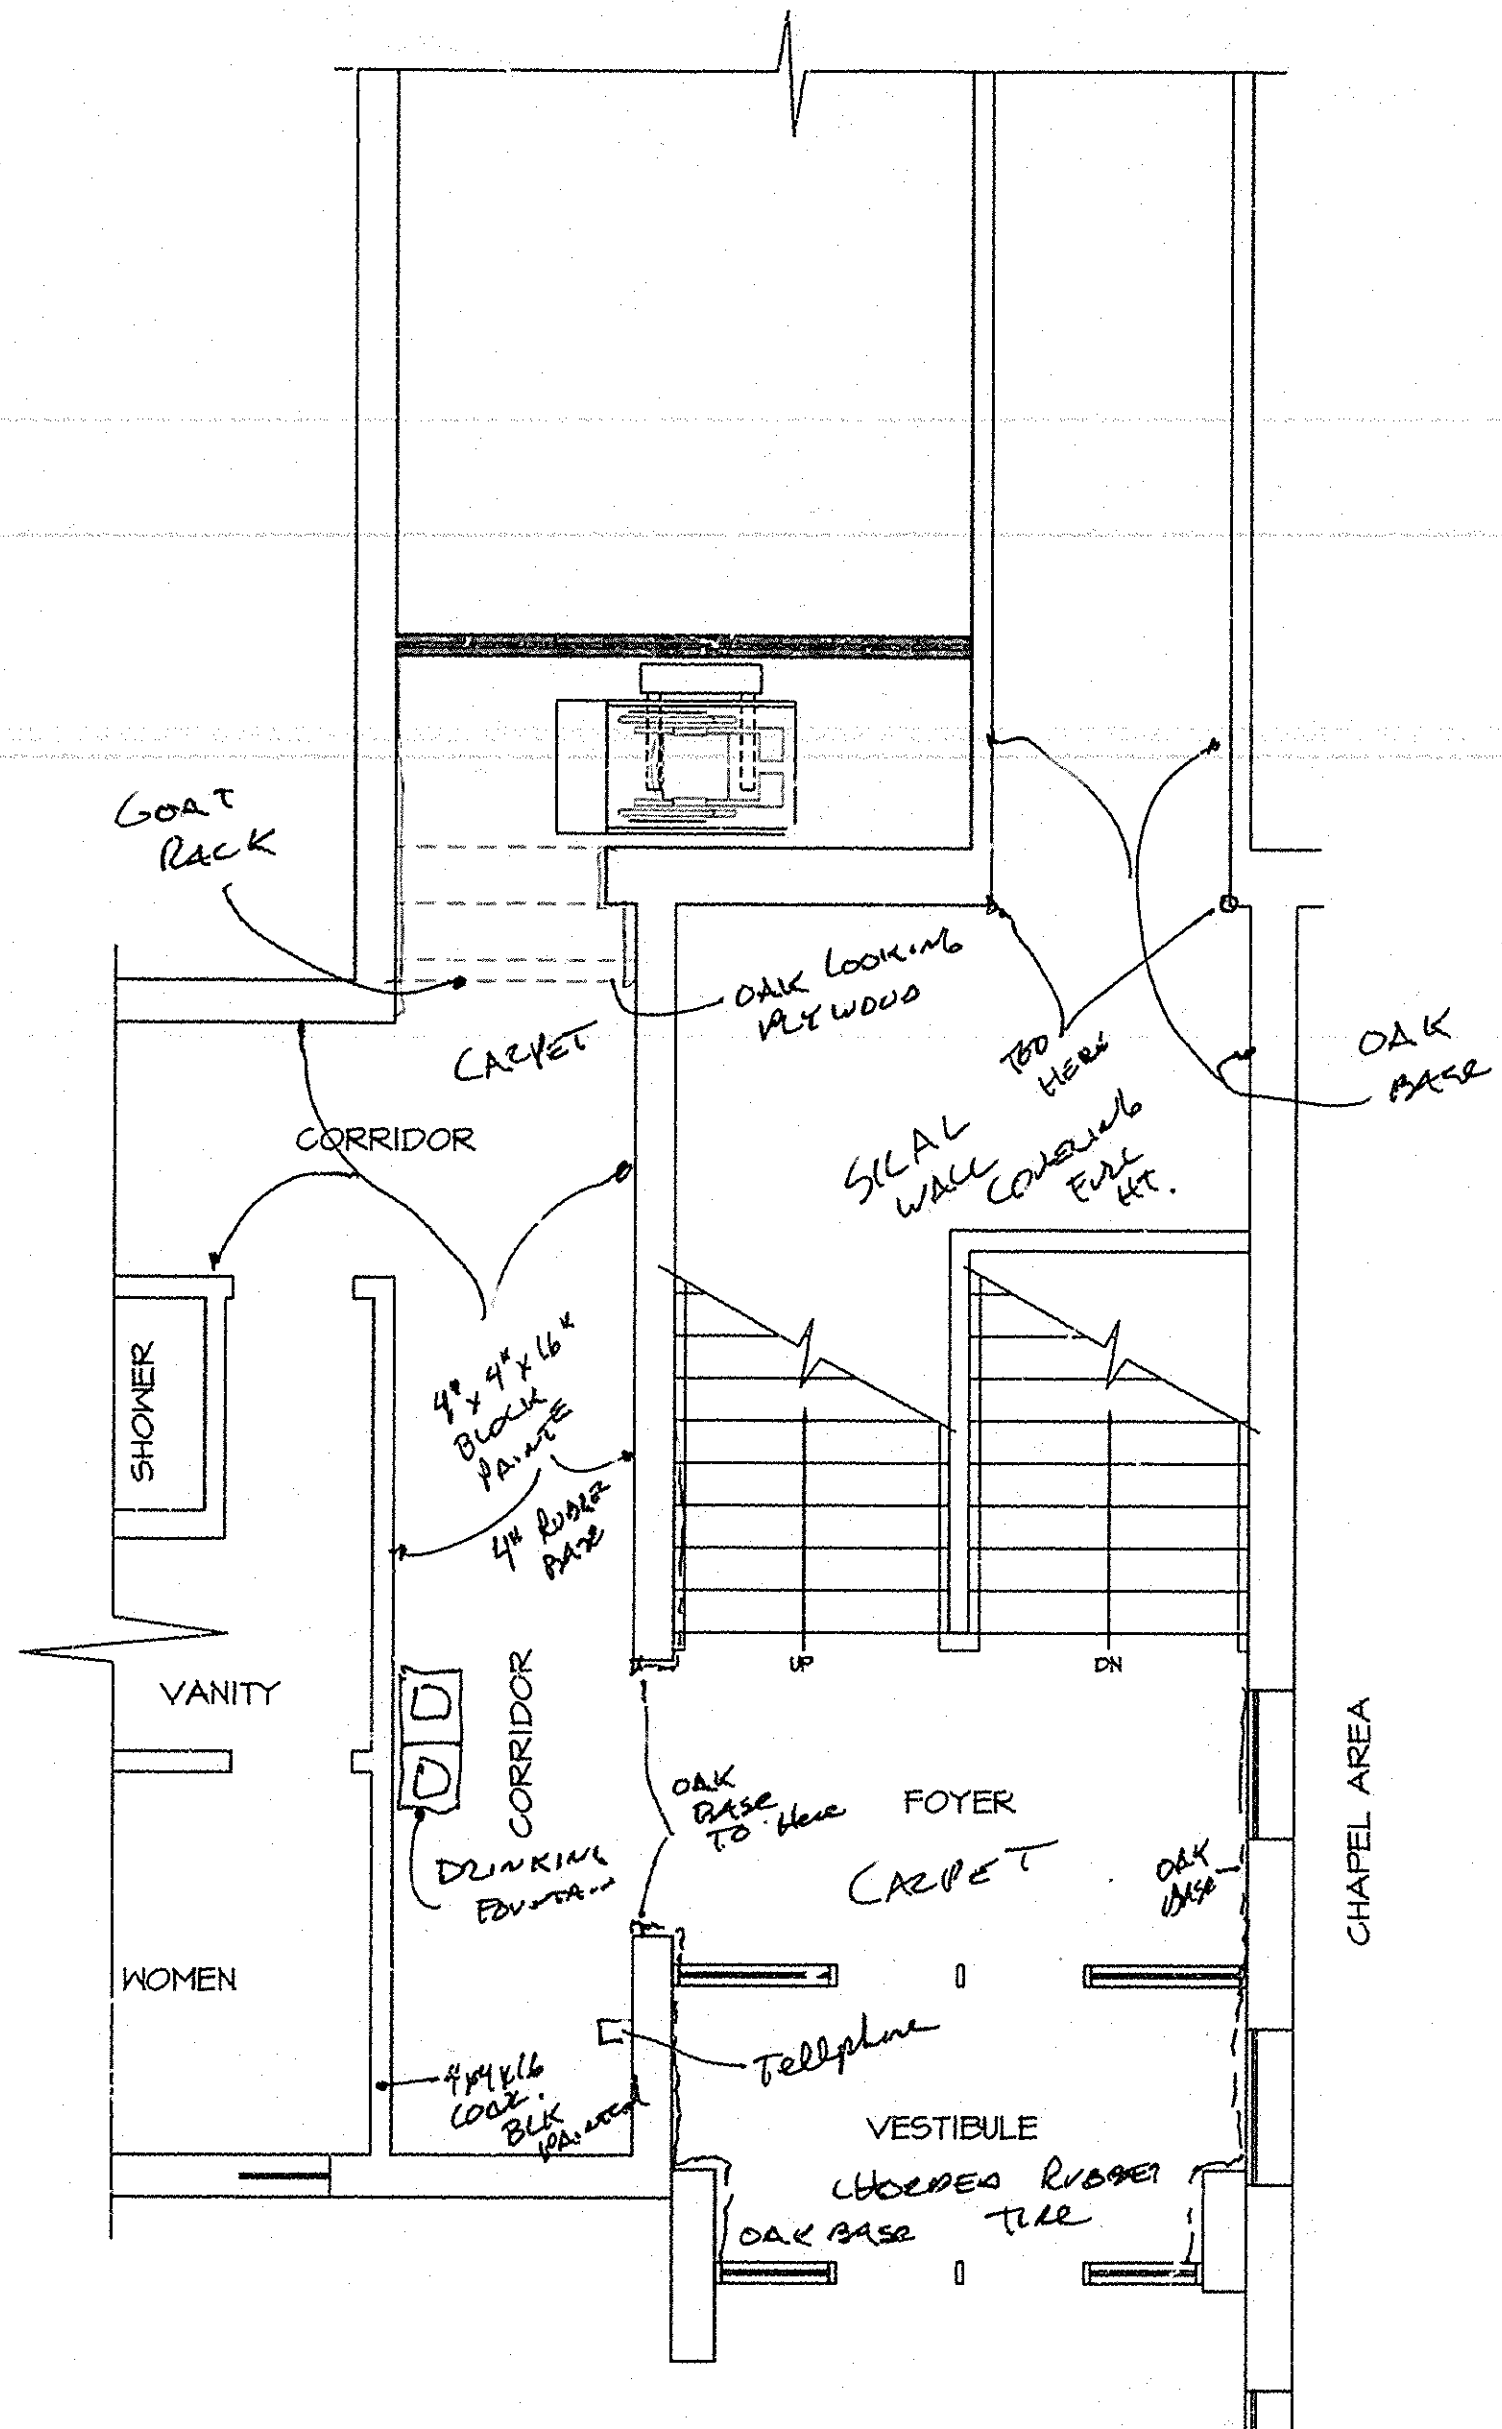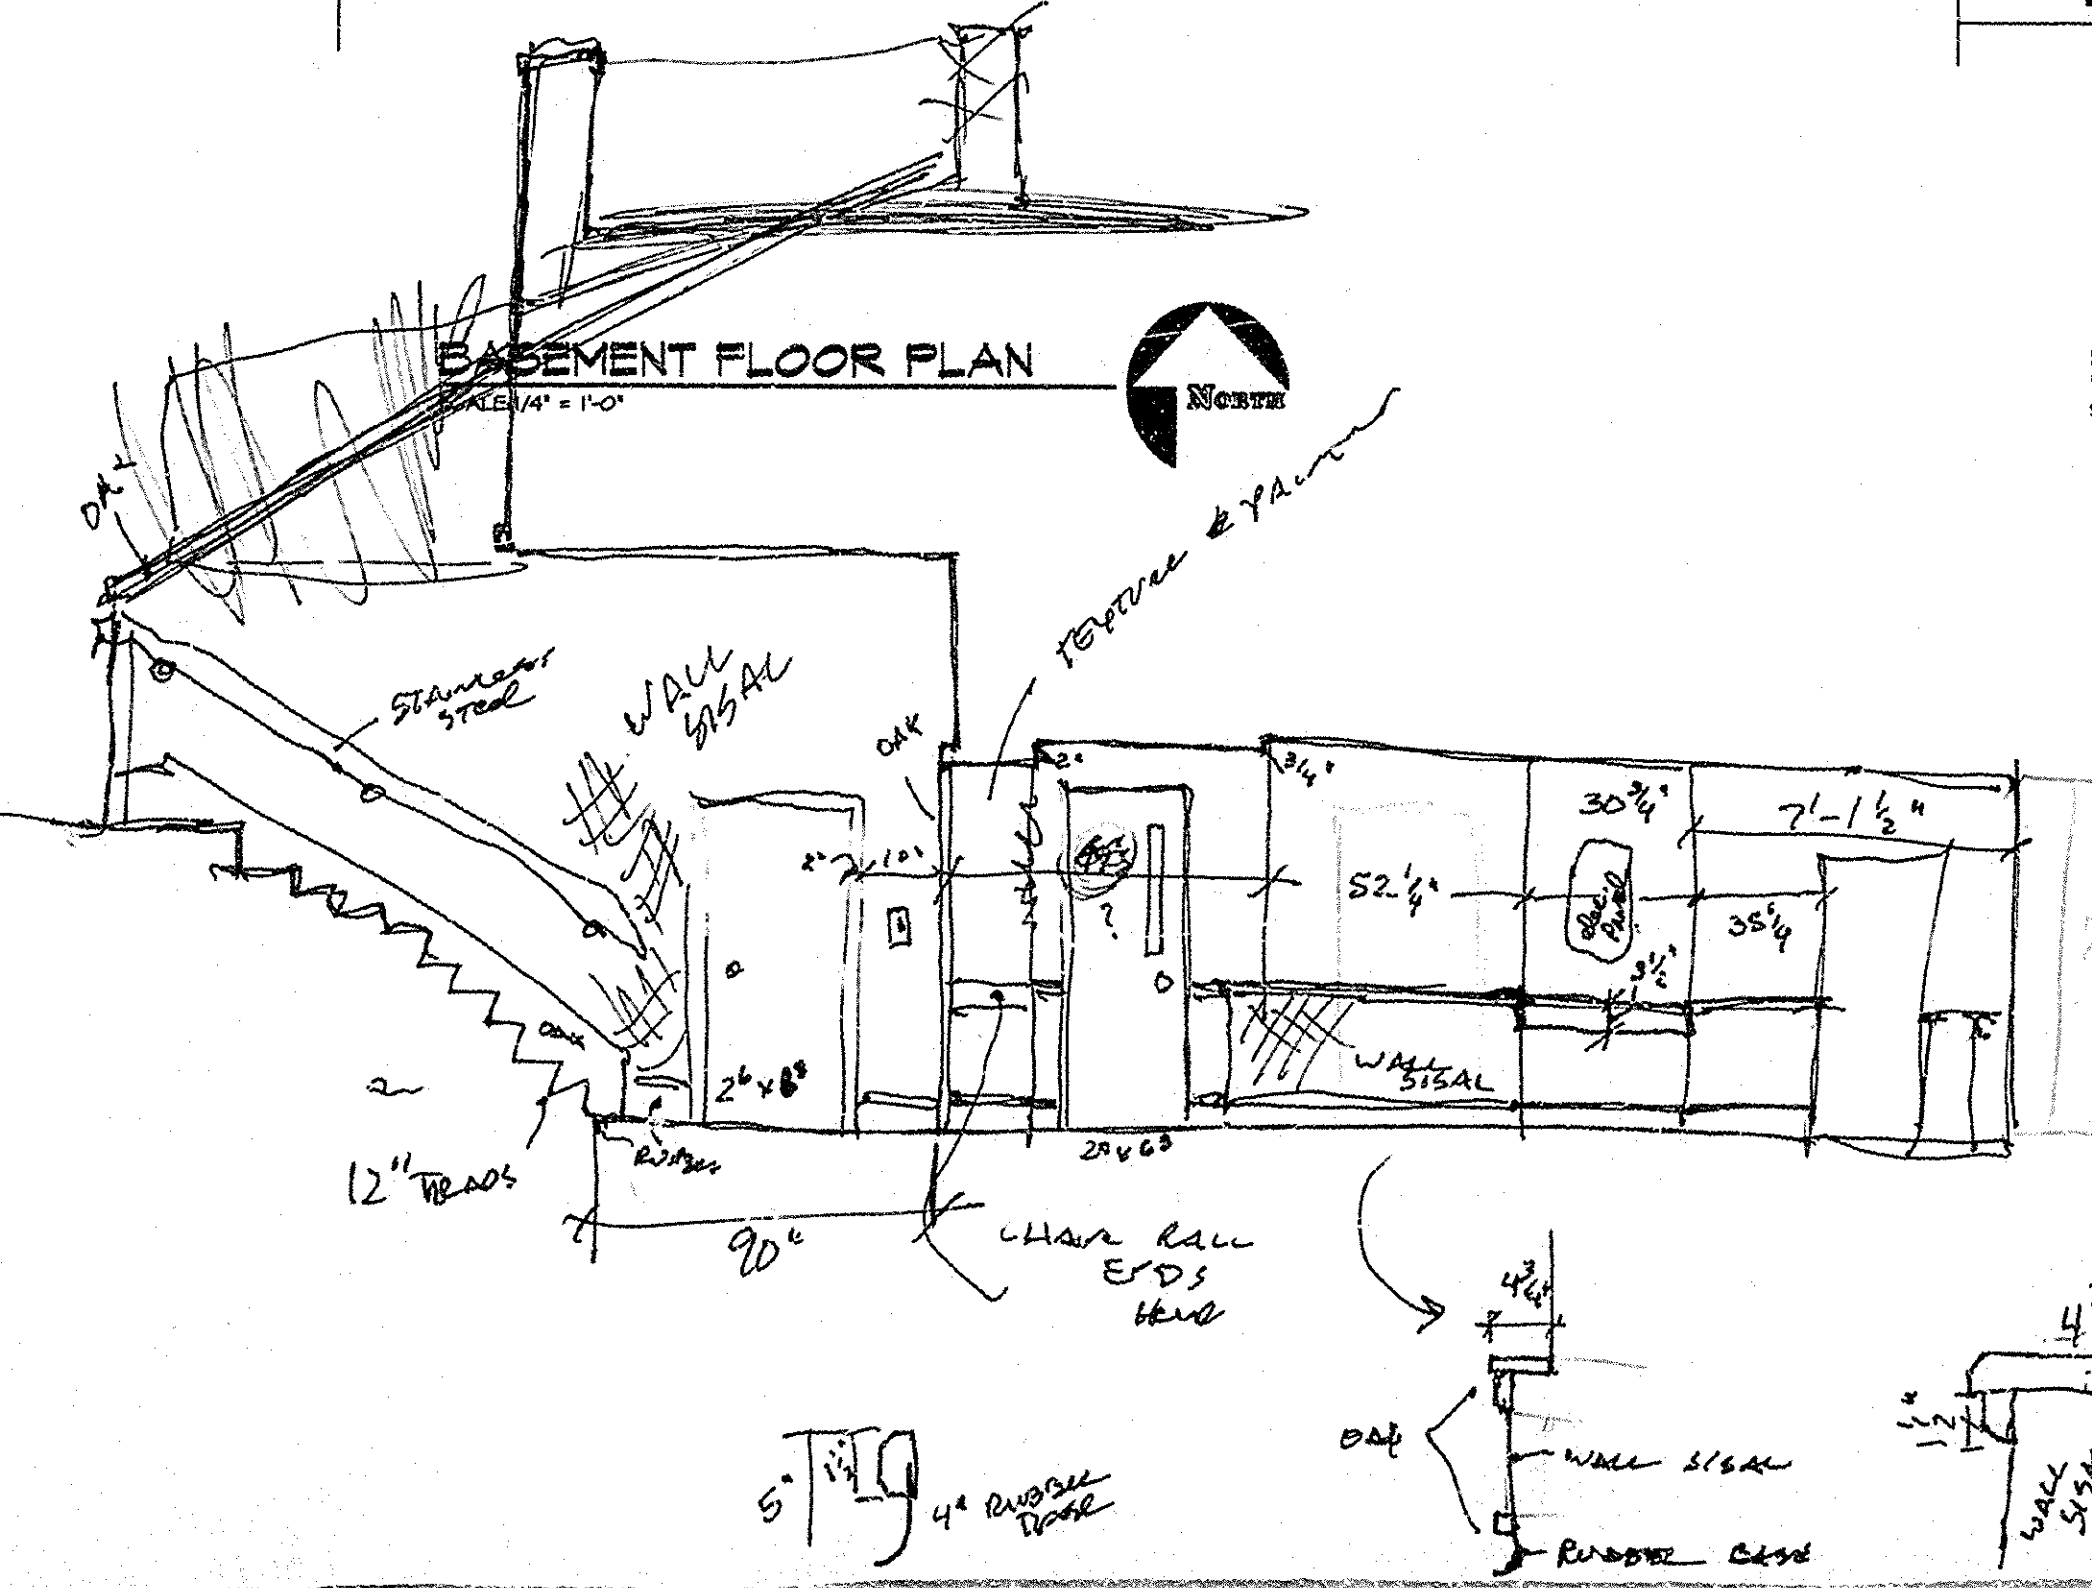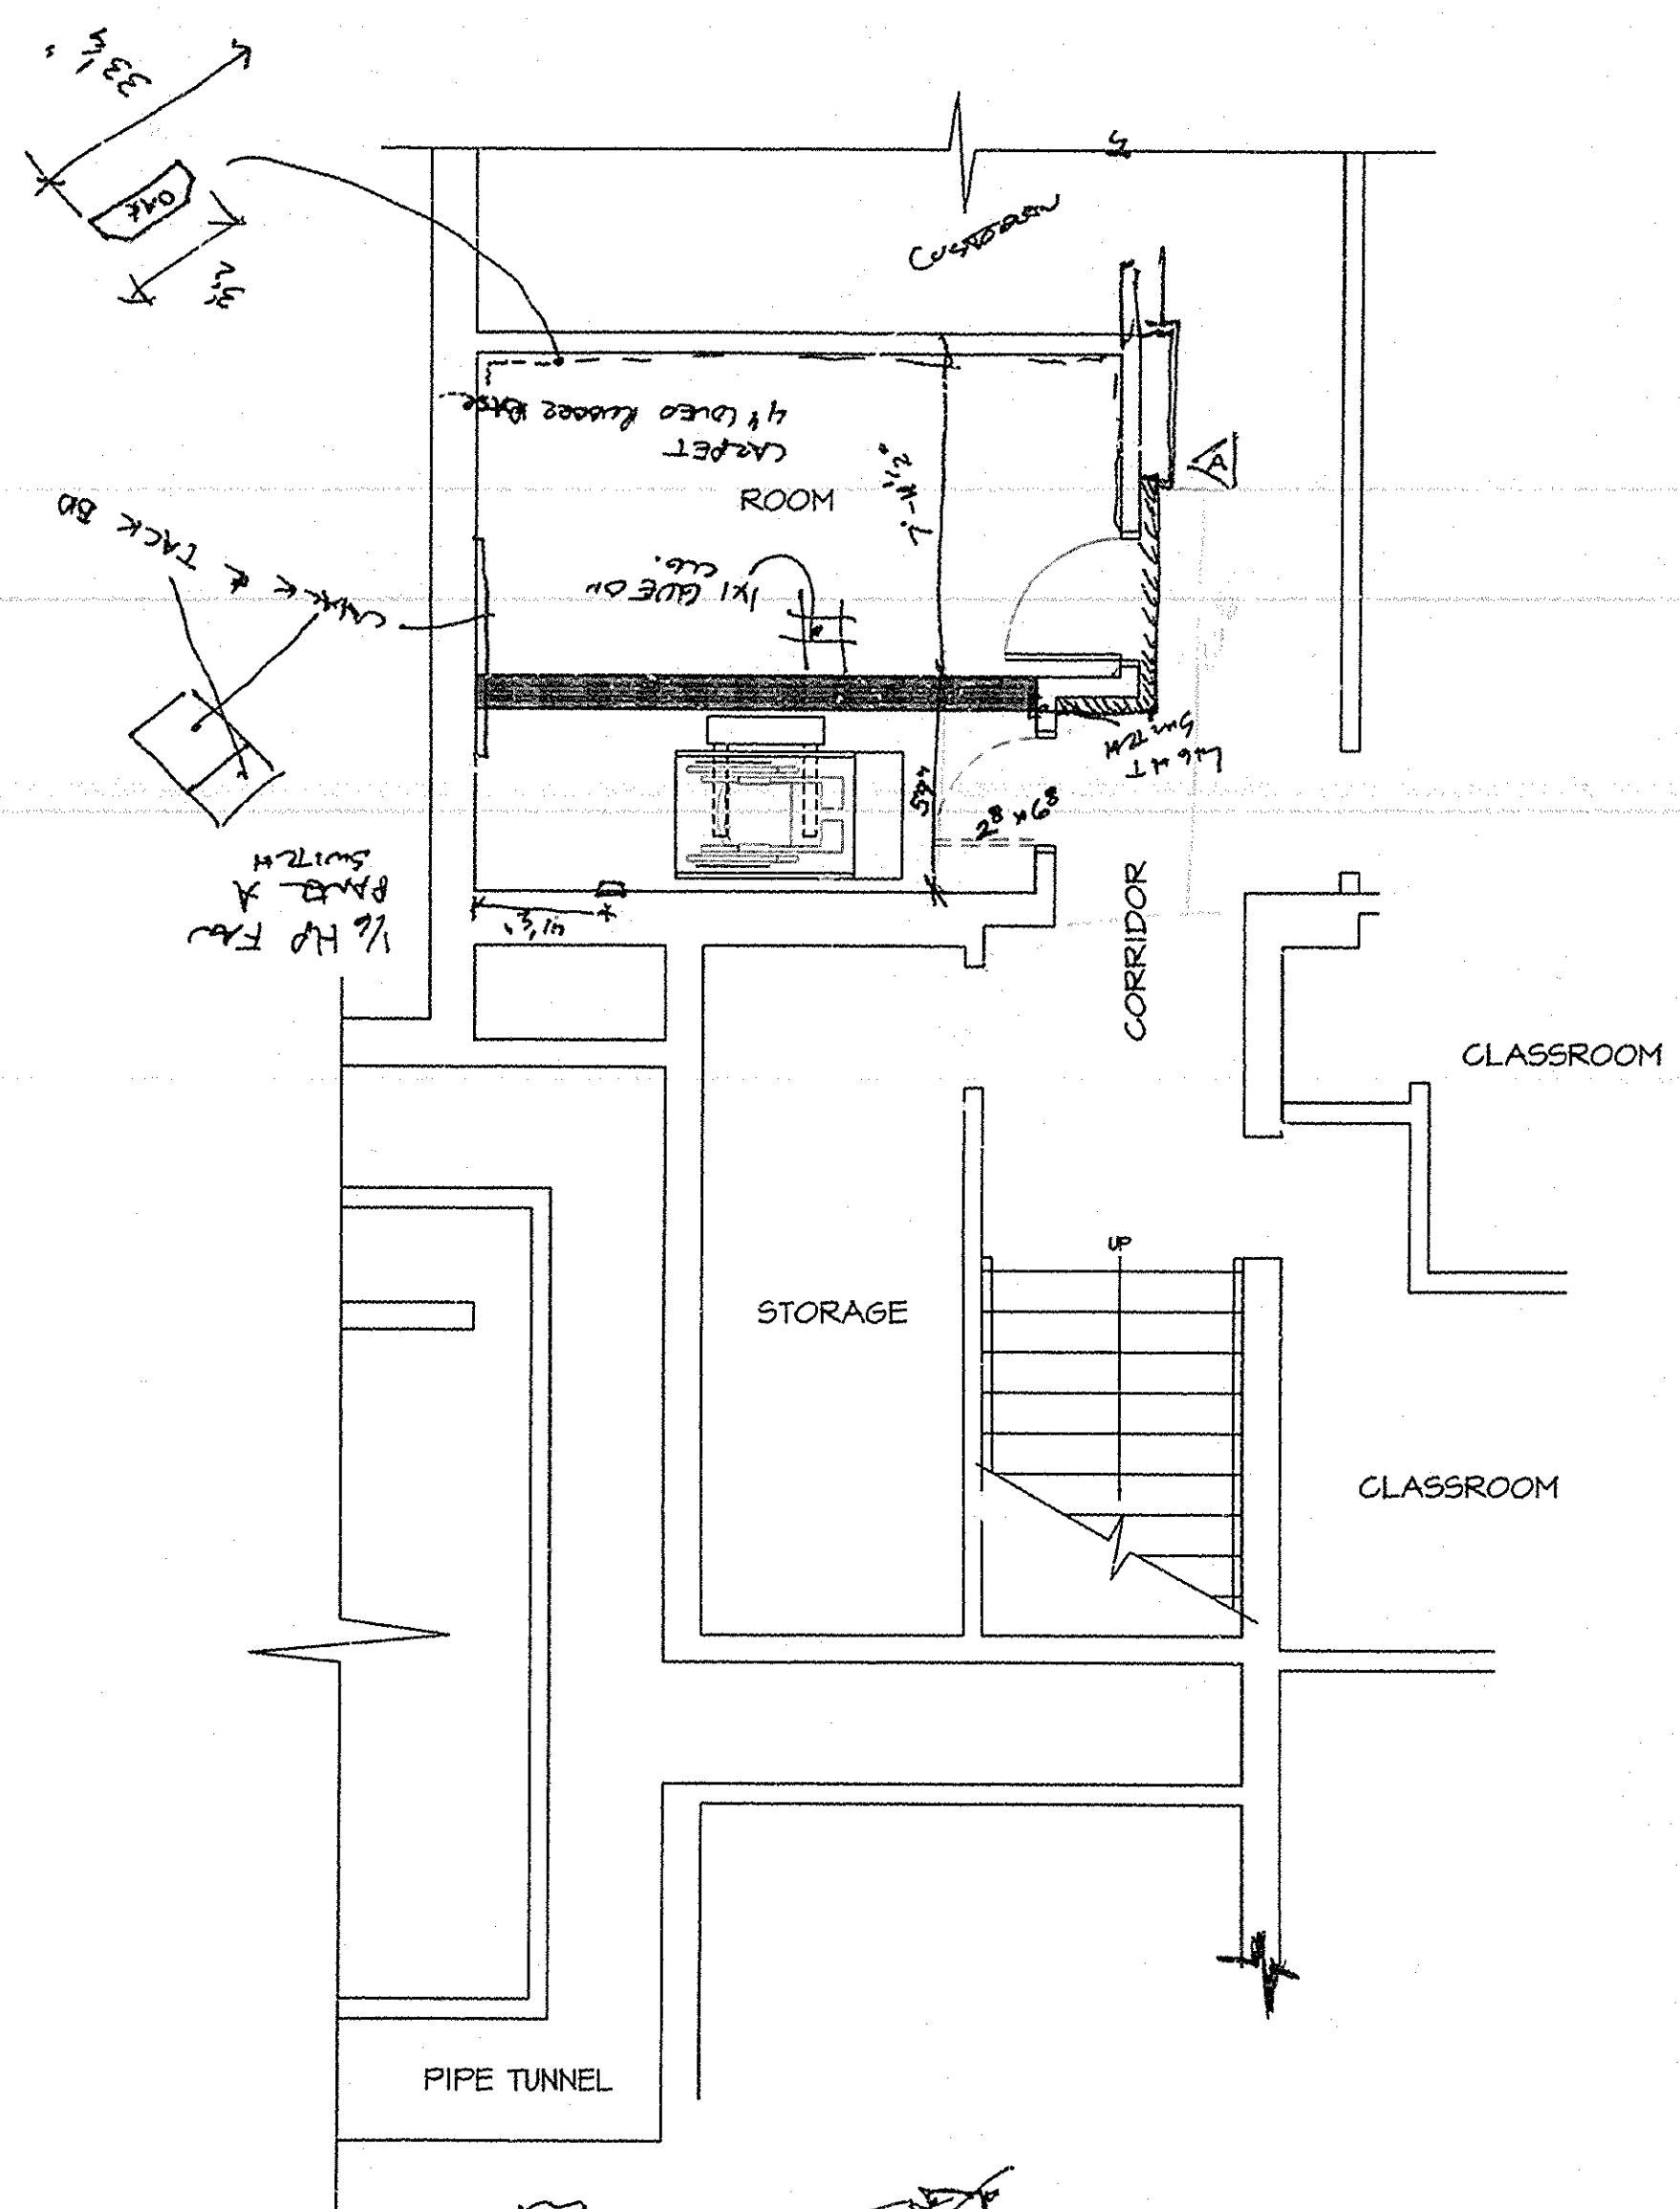

ENTRY LEVEL FLOOR PLAN  
SCALE 1/4" = 1'-0"

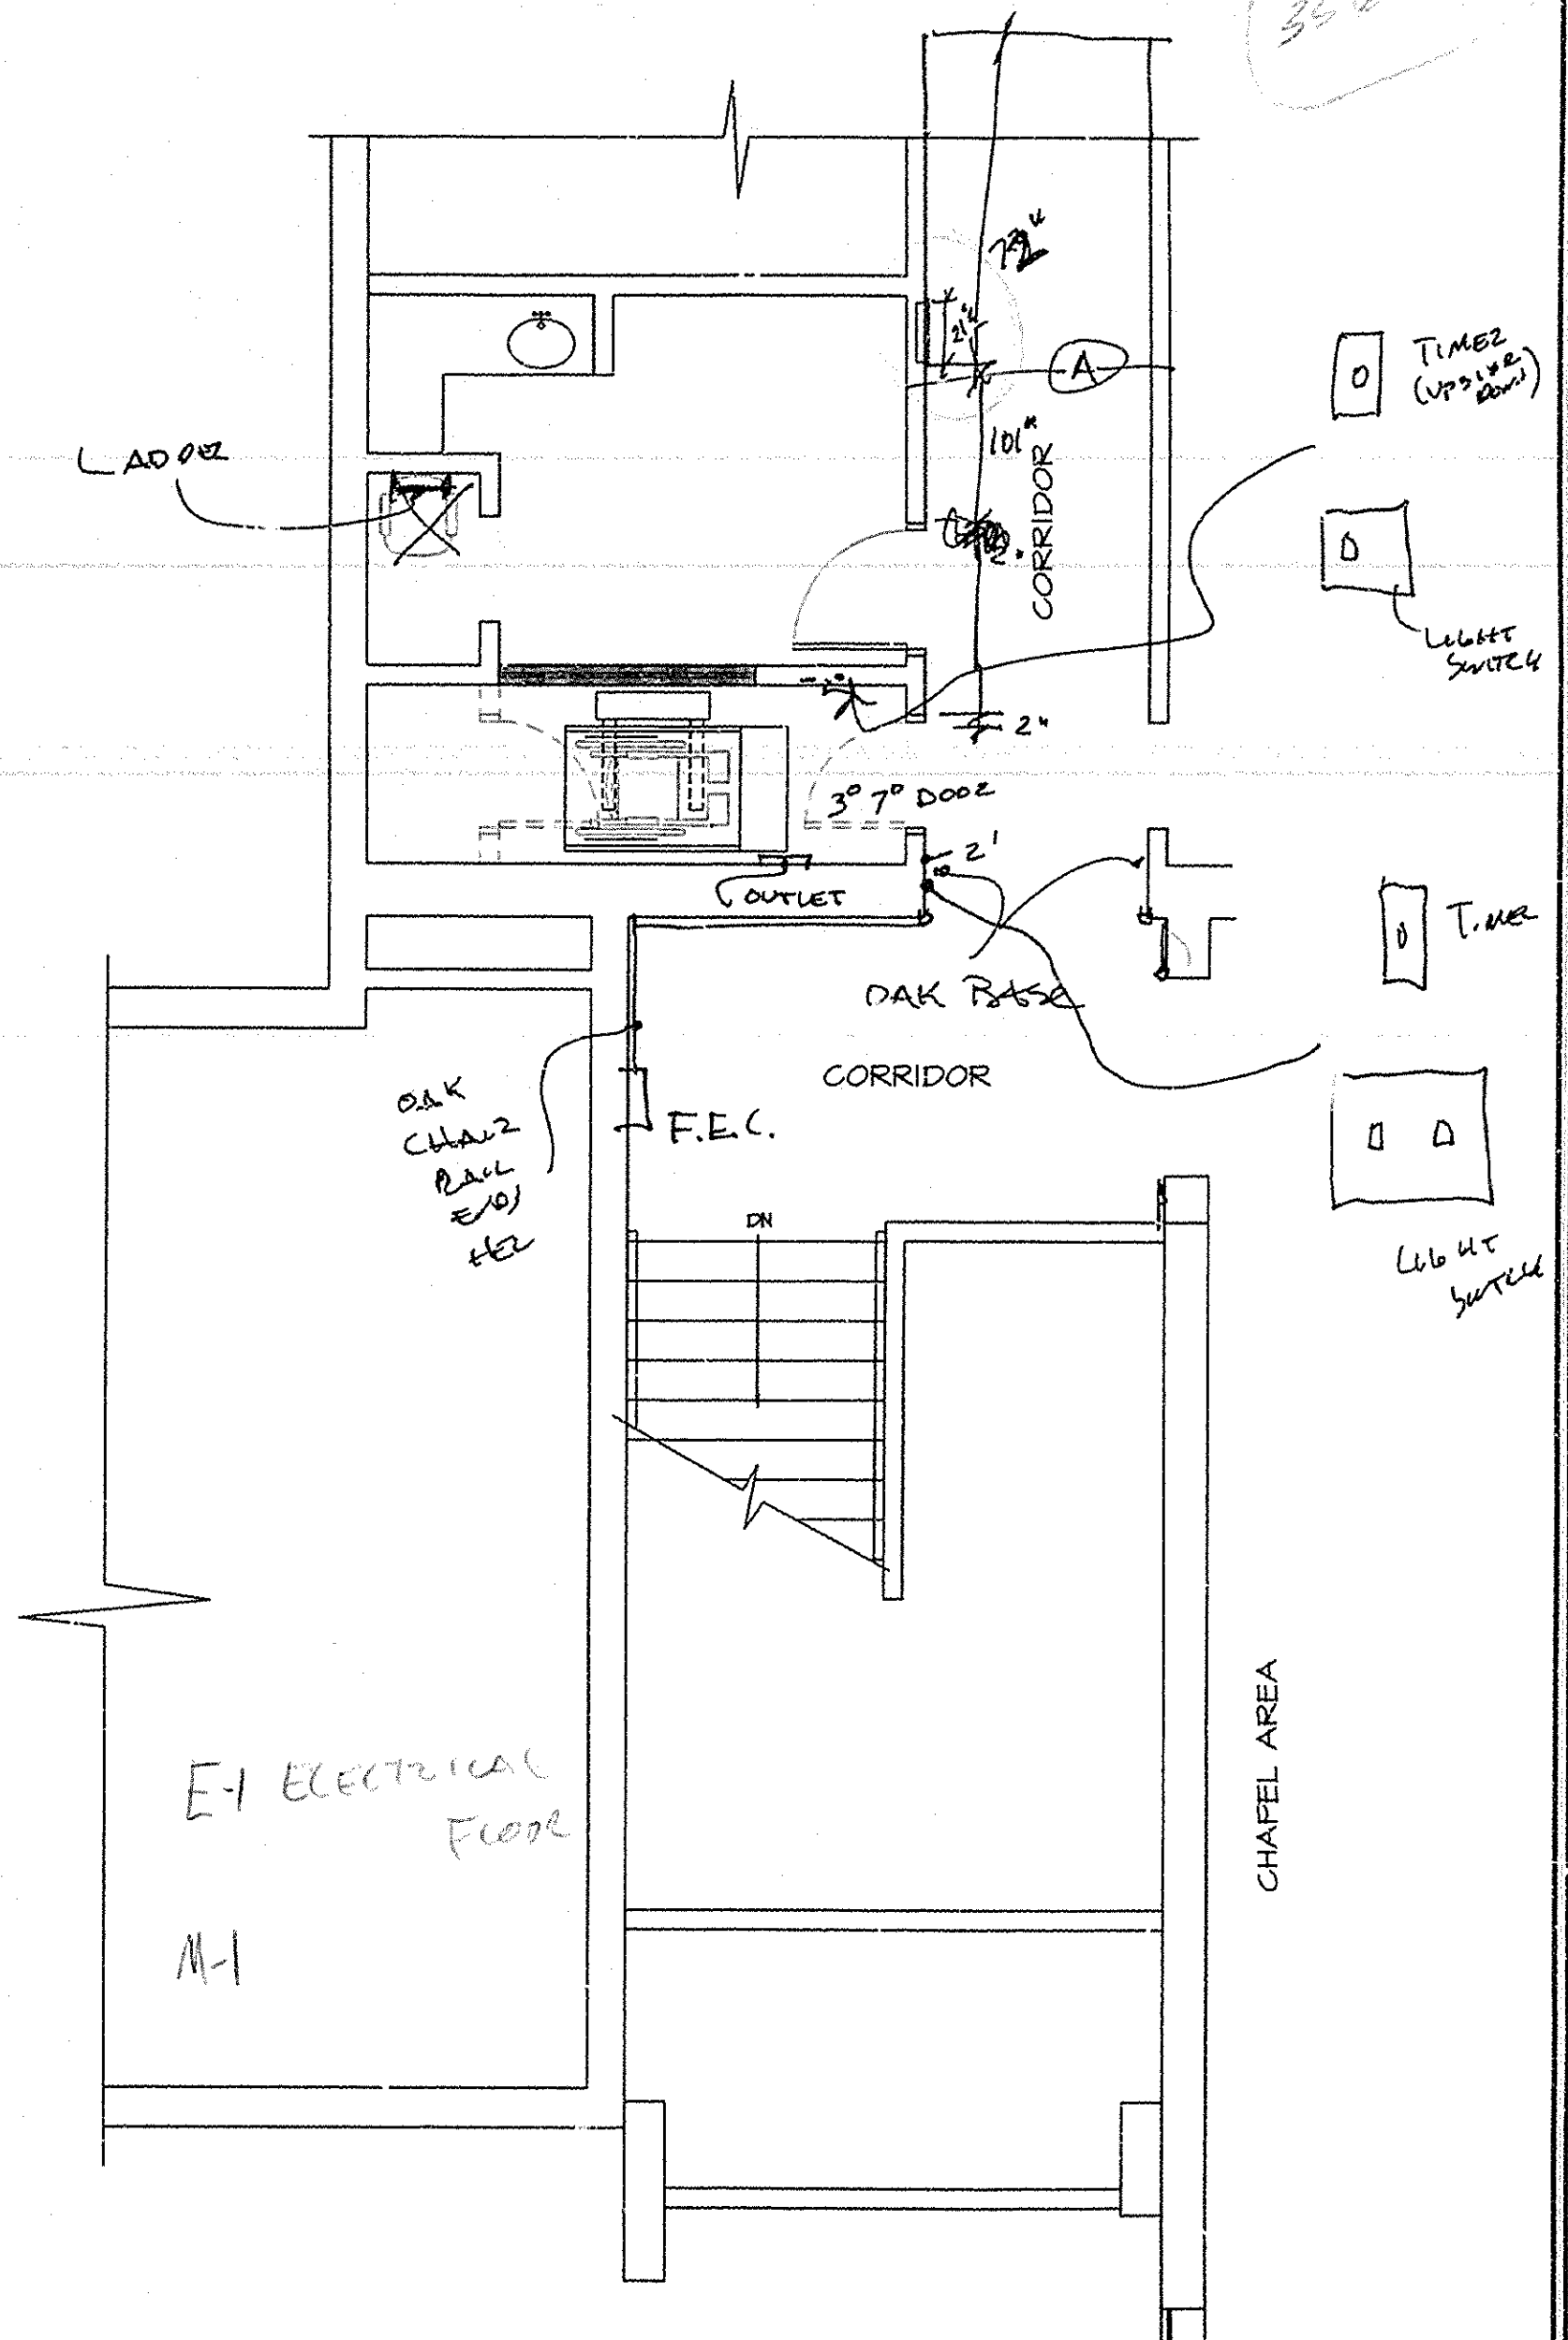

CHAPEL LEVEL FLOOR PLAN  
SCALE 1/4" = 1'-0"

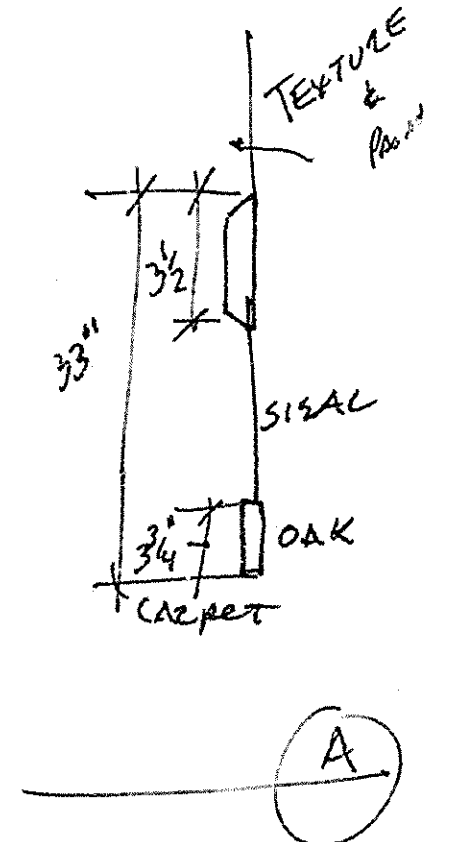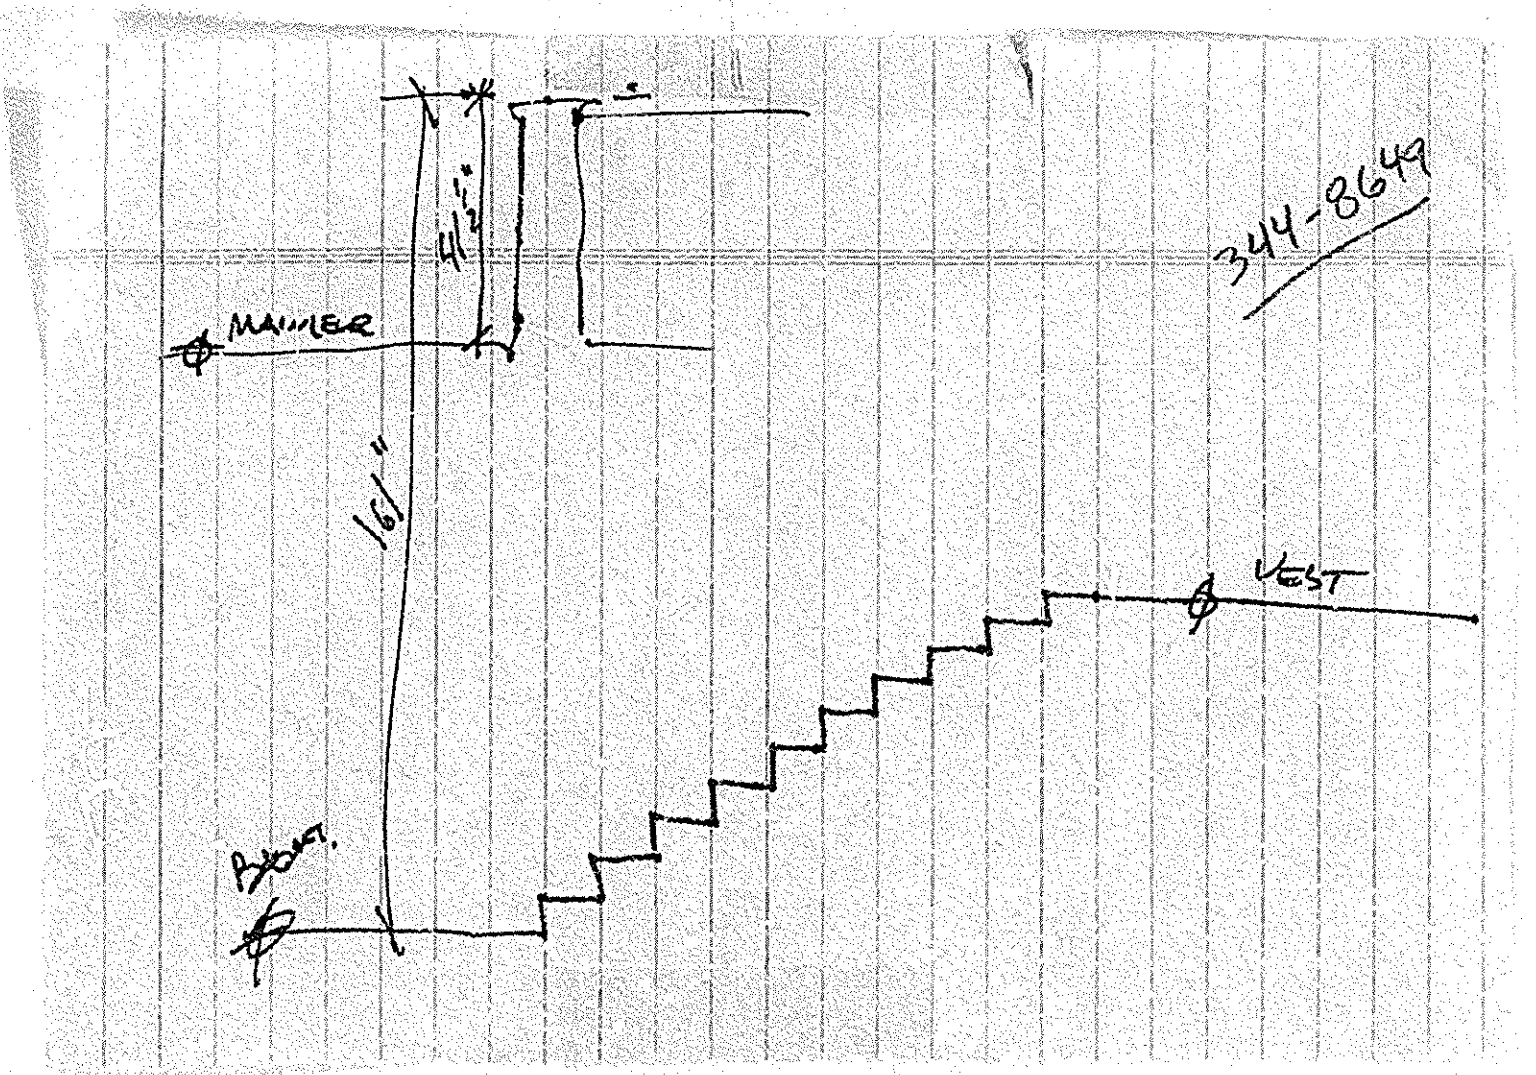

JACOBS  
356-5851

**JRW**  
ASSOCIATES  
JOHN R. WATSON AR-1276  
STATE OF IDAHO  
JOHN R. WATSON  
ARCHITECT  
JOHN R. WATSON  
CONSTRUCTION MANAGEMENT  
JOHN R. WATSON  
REGISTERED ARCHITECT  
IDaho 1276



CONSULTANTS:  
CIVIL ENGINEERING  
NUMBER - LEAVITT  
855 No. Colfax  
P.O. Box 50891  
1800 Fair, Idaho 83405  
(208) 524-0212  
MECHANICAL ENGINEERING  
ENGINEERED SYSTEMS ASSOC.  
313 West Center  
Pocatello, Idaho 83201  
(208) 233-0501  
ELECTRICAL ENGINEERING  
ENGINEERED SYSTEMS ASSOC.  
313 West Center  
Pocatello, Idaho 83201  
(208) 233-0501  
Fax (208) 233-0529

PROJECT: MENAN, IDAHO  
DRAWING TITLE: FLOOR PLAN DETAILS  
MENAN, IDAHO



DATE: APRIL 1985  
JOB NO: 018  
DRAWN BY: RANGLER  
CHECKED BY: JRW  
DRAWING NO. 03701  
A-1  
OF

24X



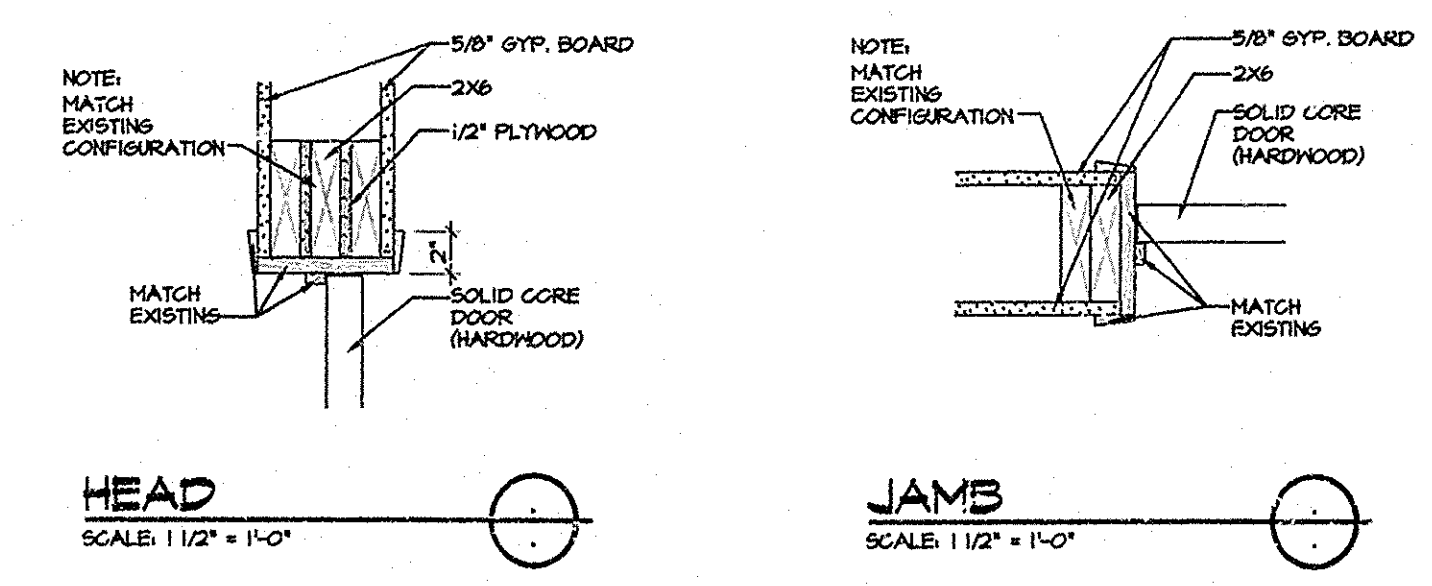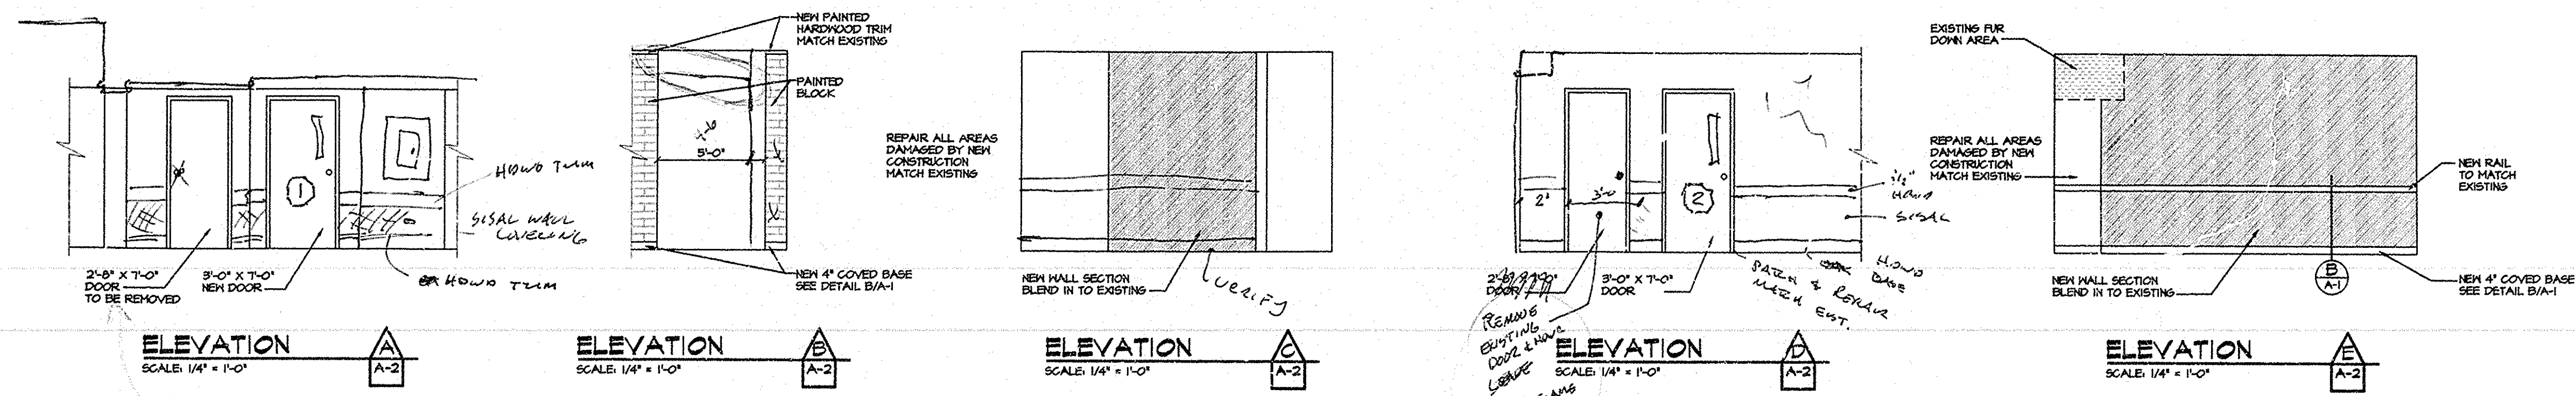

DOOR SCHEDULE					
MARK	SGL or DBL	SIZE	TYPE	REMARKS	
1	SINGLE	3'-0" X 6'-8"	A		
2	SINGLE	3'-0" X 7'-0"	B		

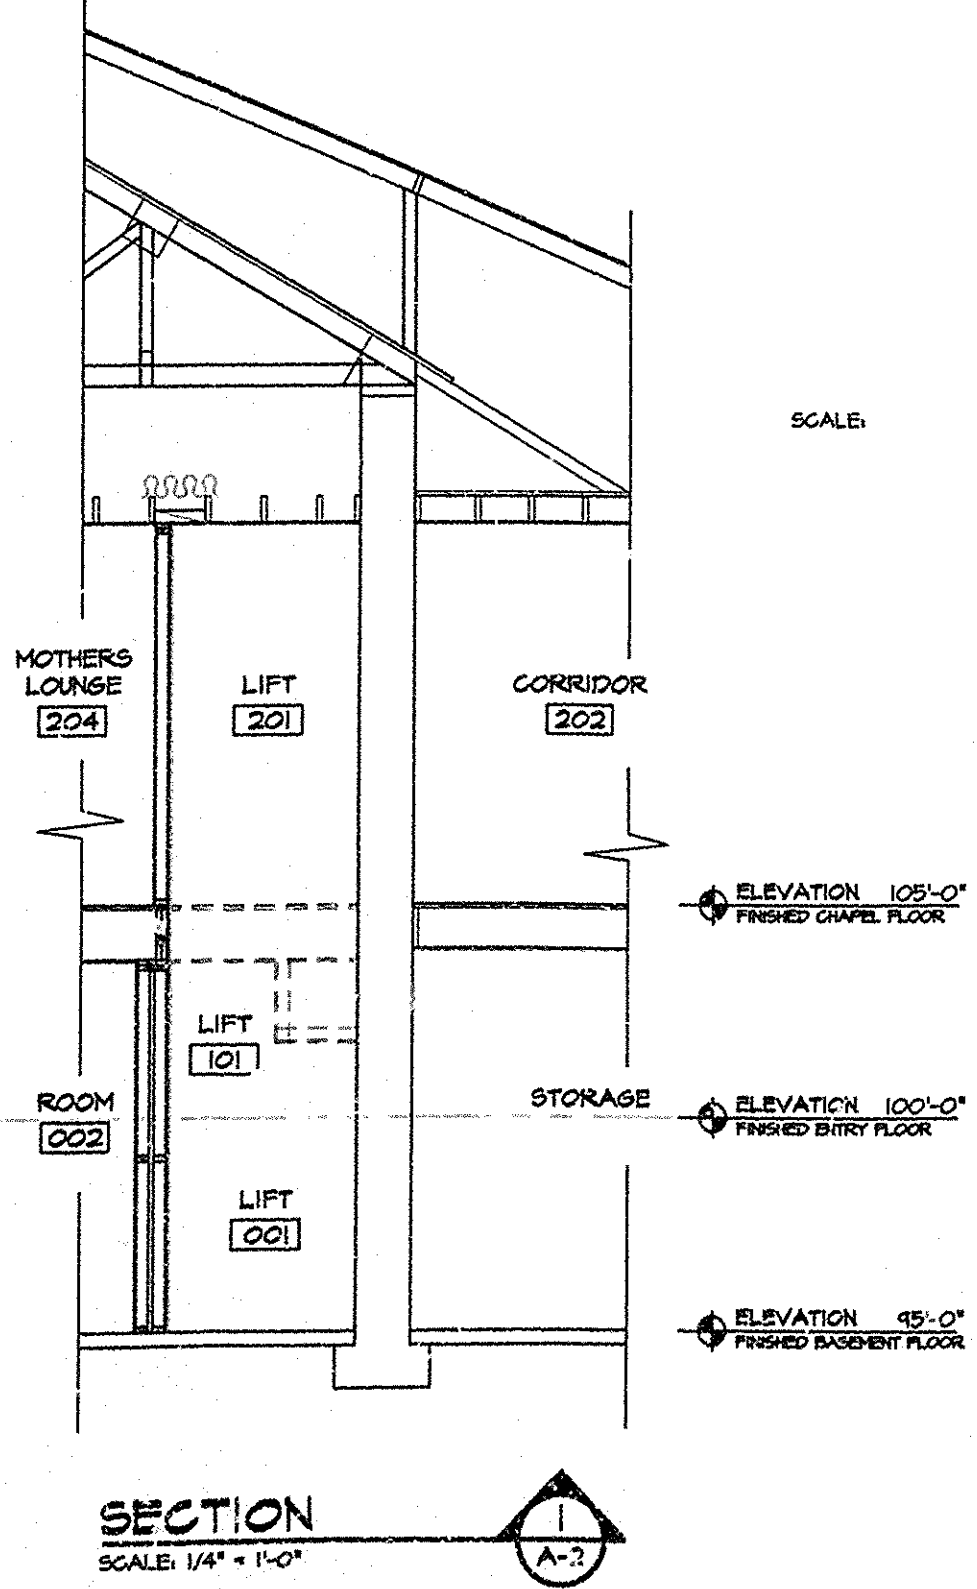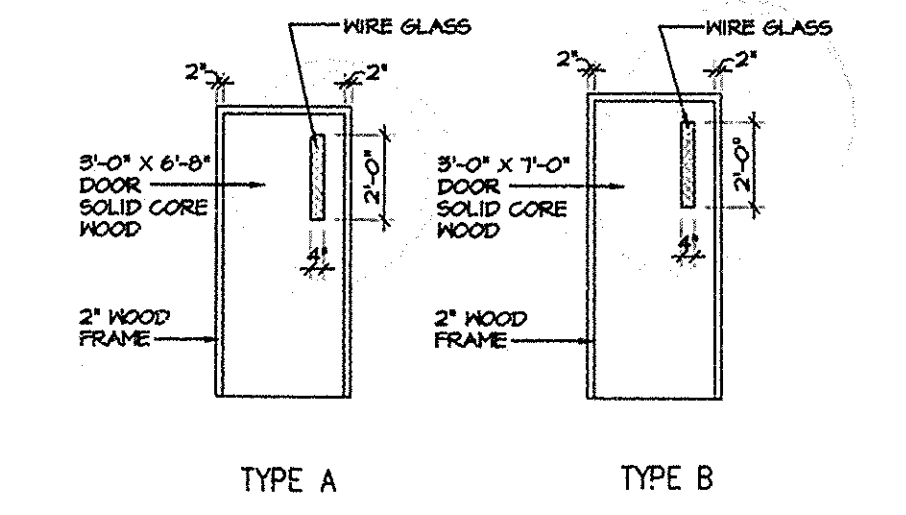

ROOM FINISH SCHEDULE												
NO.	AREA NAME	FLOOR	BASE	WAINSCOT	WALLS				CEILING	CLG. HT.	REMARKS	
					NORTH	EAST	SOUTH	WEST				
001	LIFT											
002	ROOM											
008	CORRIDOR											
101	LIFT											
102	CORRIDOR											
108	CORRIDOR											
201	LIFT											
202	CORRIDOR											
208	NOT USED											
204	MOTHERS LOUNGE											

**JRW ASSOCIATES**  
 JOHN R. WATSON AR-1276  
 STATE OF IDAHO  
 JOHN R. WATSON ARCHITECTURE-ENGINEERING-CONSTRUCTION MANAGEMENT  
 JOHN R. WATSON ARCHITECTURE-ENGINEERING-CONSTRUCTION MANAGEMENT  
 JOHN R. WATSON ARCHITECTURE-ENGINEERING-CONSTRUCTION MANAGEMENT  
 JOHN R. WATSON ARCHITECTURE-ENGINEERING-CONSTRUCTION MANAGEMENT


**CONSULTANTS:**  
 CIVIL ENGINEERING  
 ROOPER - LEVITT  
 899 No. Capitol  
 P.O. Box 50691  
 Idaho Falls, Idaho 83405  
 (208) 524-0212  
 MECHANICAL ENGINEERING  
 ENGINEERED SYSTEMS ASSOC.  
 315 West Center  
 Pocatello, Idaho 83201  
 (208) 233-0501  
 ELECTRICAL ENGINEERING  
 ENGINEERED SYSTEMS ASSOC.  
 315 West Center  
 Pocatello, Idaho 83201  
 (208) 233-0501  
 Fax: (208) 233-0529

PROJECT: **MENAN 1, 2**  
**MENAN IDAHO STAKE**  
 DRAWING TITLE: **INTERIOR ELEVATIONS**

DATE: 11-28-03  
 PROJECT NO.: 3411-01-013  
 JOB NO.: OIB  
 DRAWN BY: RWS  
 CHECKED BY: JWS  
 DATE: APRIL 05  
 DRAWING NO.: 03-D-1  
 FILE: **A-2**

24X




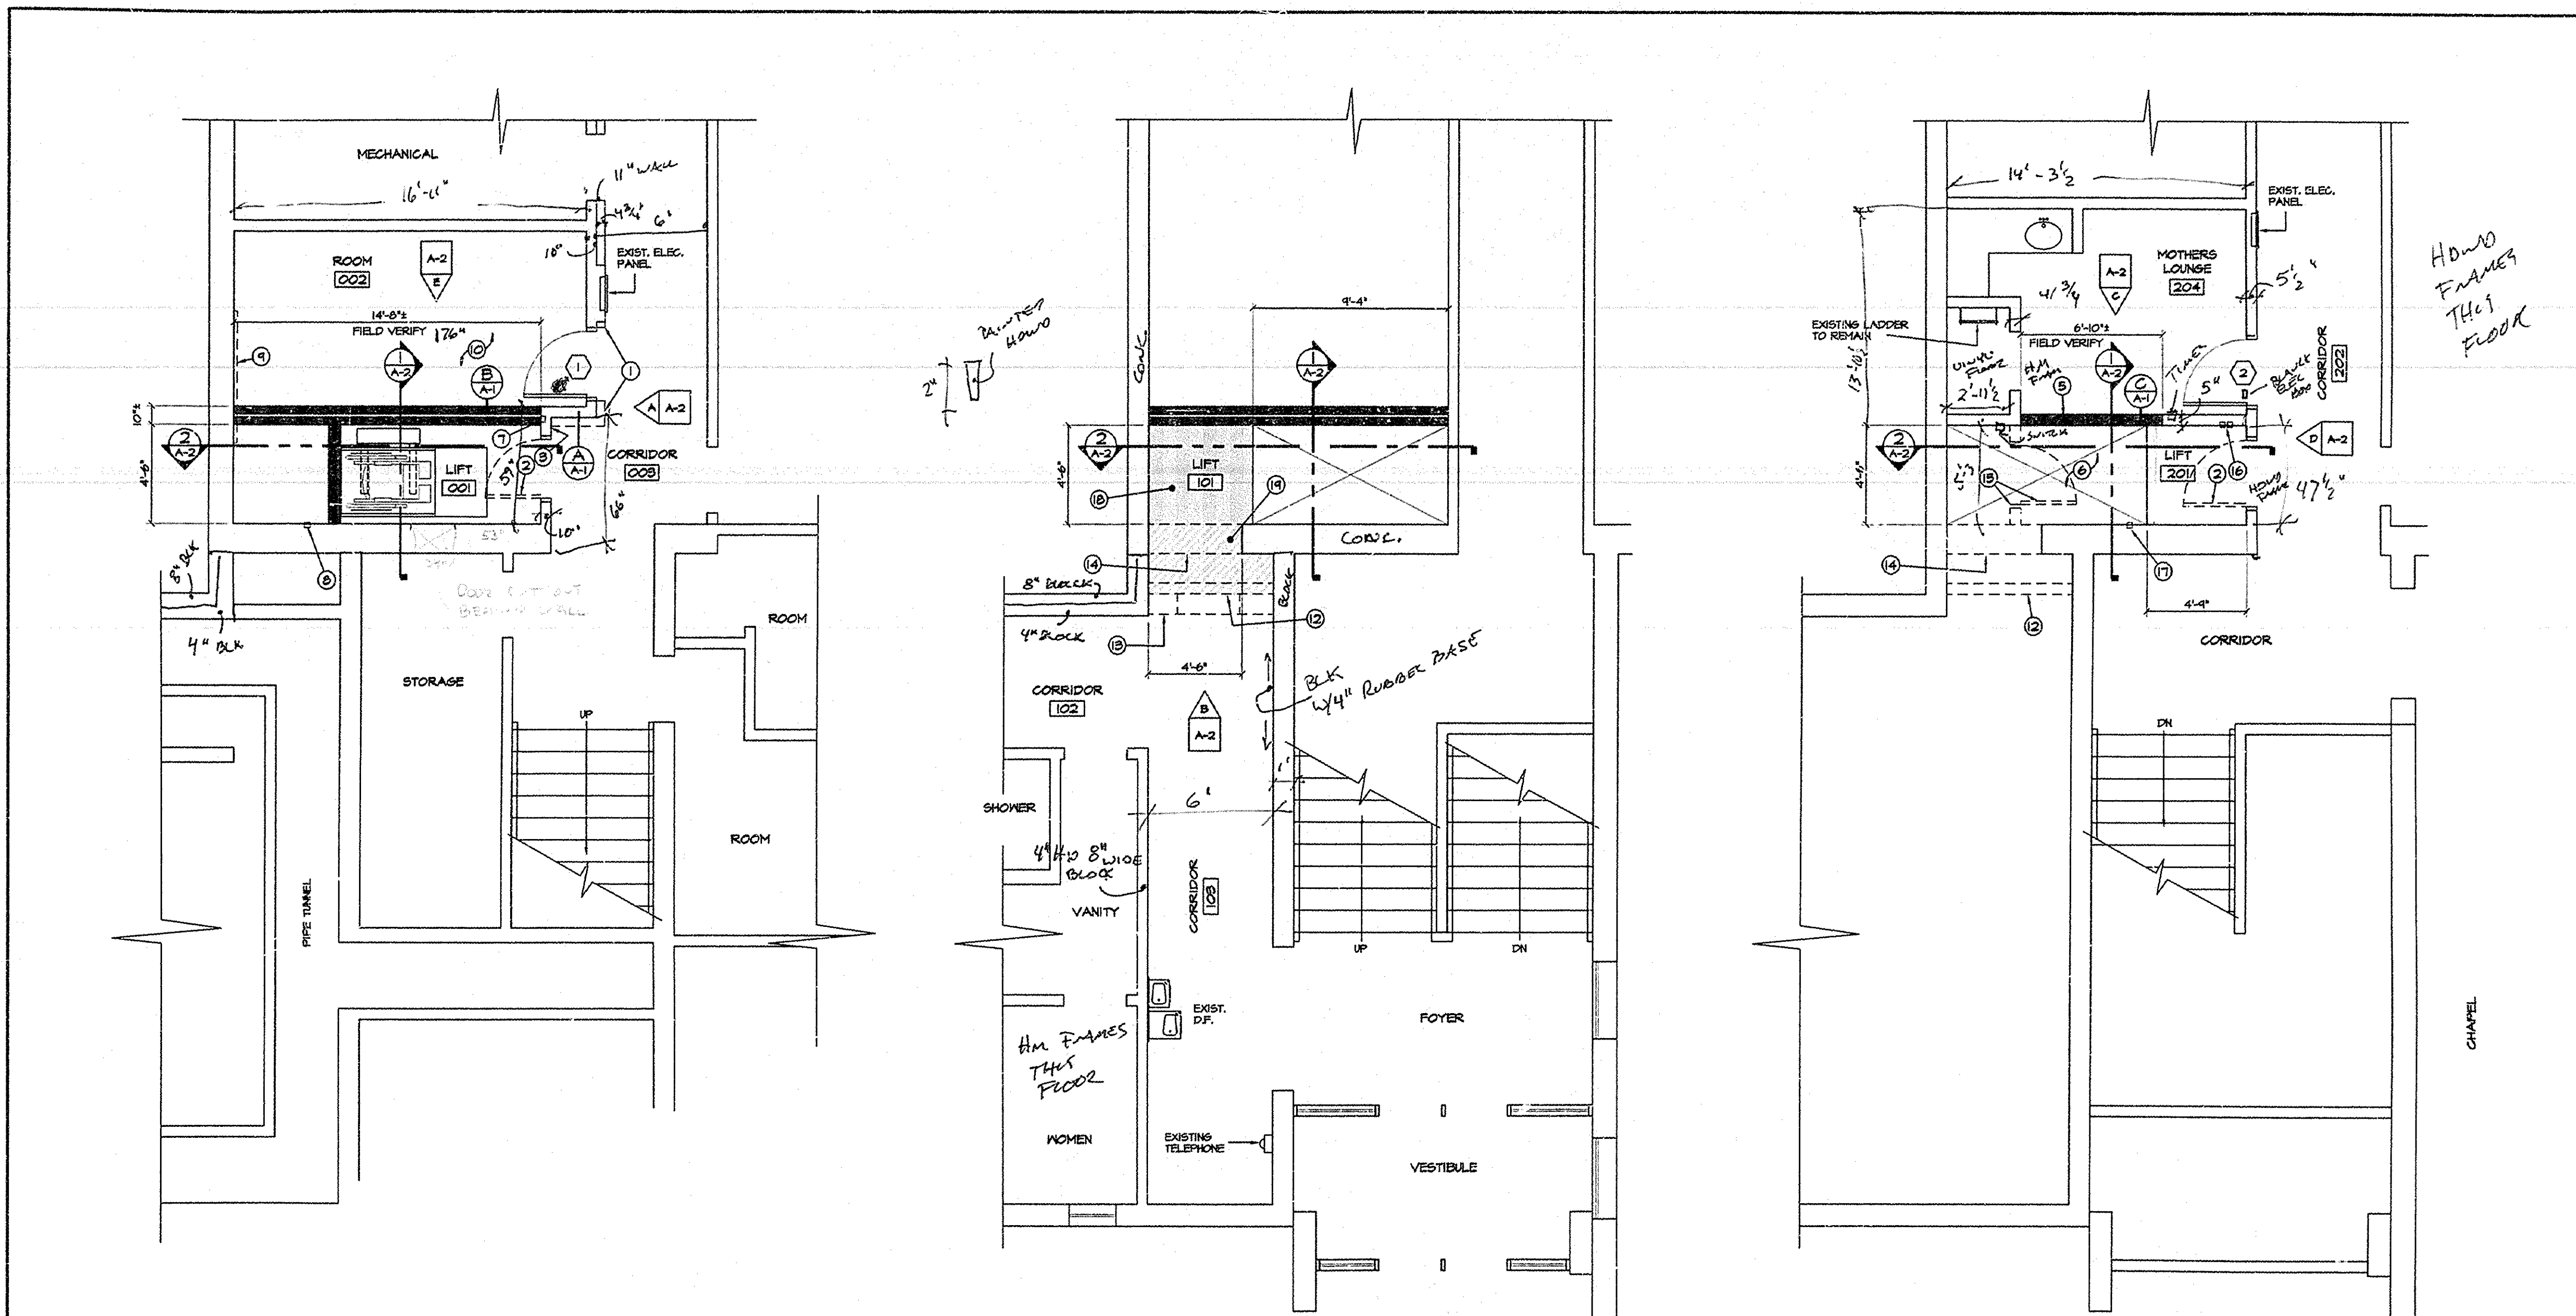


**BASEMENT FLOOR PLAN**  
SCALE: 1/4" = 1'-0"  
ELEVATION 15'-0"  
FINISHED BASEMENT FLOOR

**ENTRY LEVEL FLOOR PLAN**  
SCALE: 1/4" = 1'-0"  
ELEVATION 100'-0"  
FINISHED ENTRY FLOOR


**CHAPEL LEVEL FLOOR PLAN**  
SCALE: 1/4" = 1'-0"  
ELEVATION 105'-0"  
FINISHED CHAPEL FLOOR

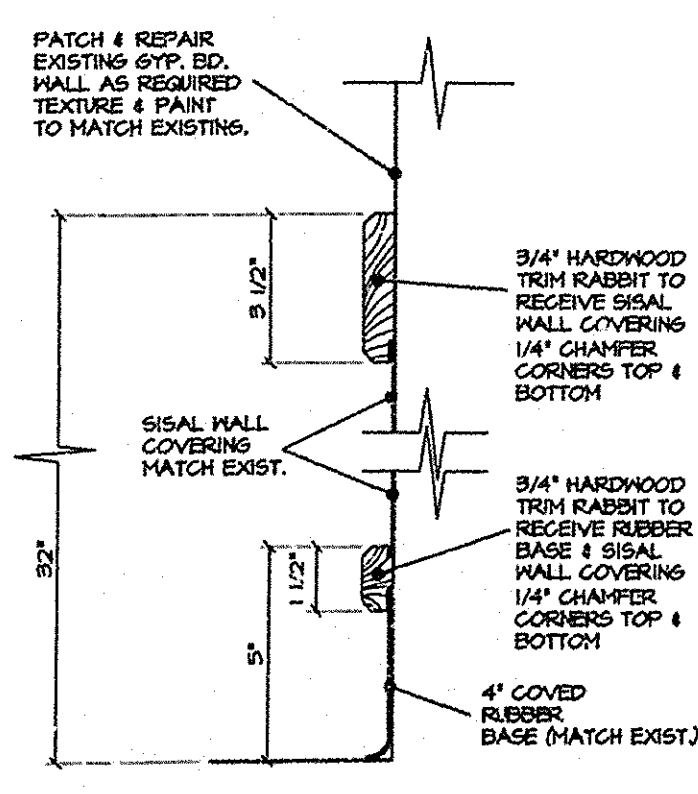

**DETAIL A** MAINSCOT  
SCALE: 3" = 1'-0"

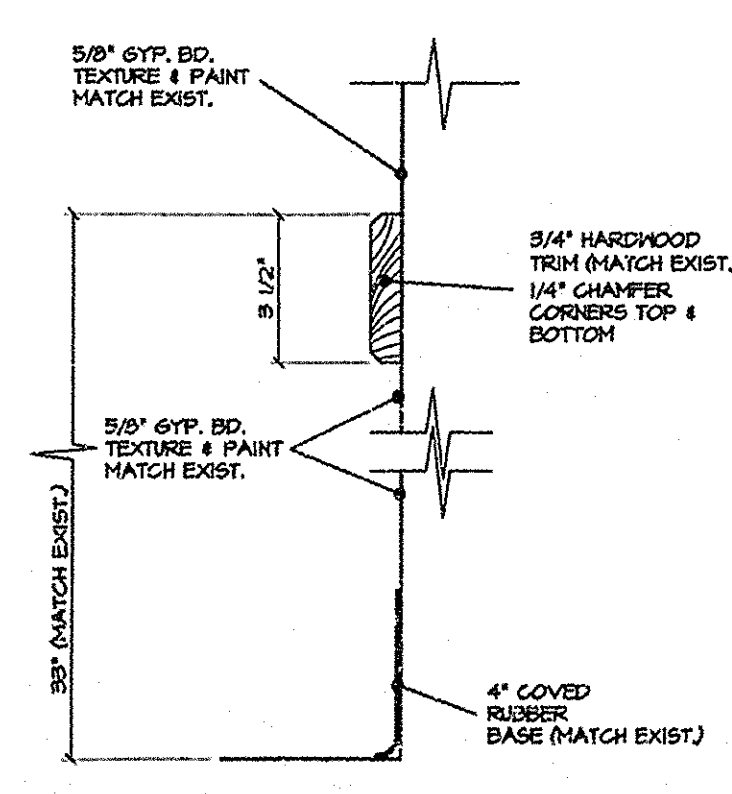

**DETAIL B** MAINSCOT  
SCALE: 3" = 1'-0"

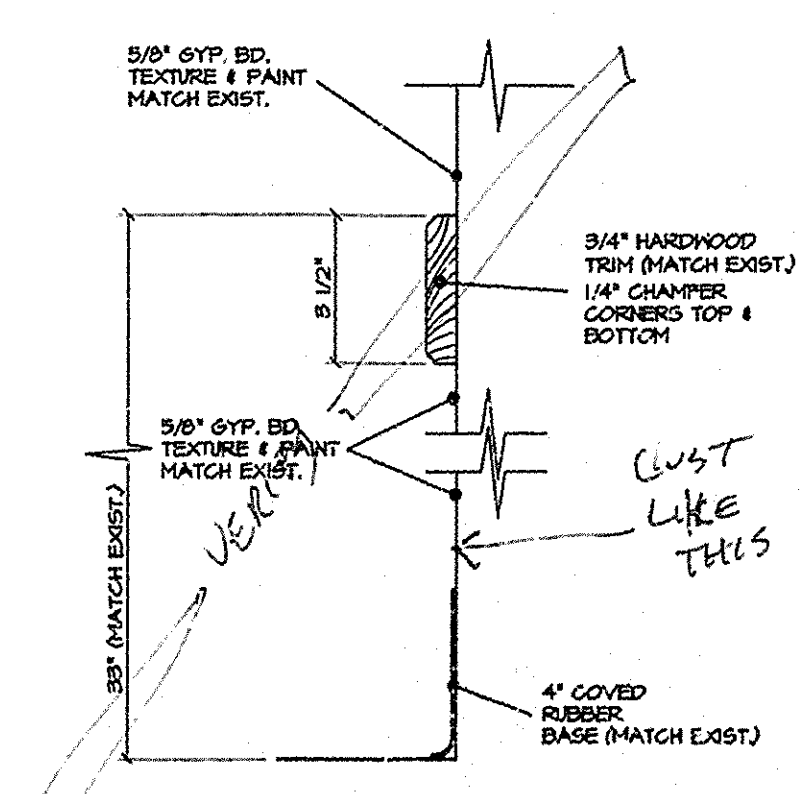

**DETAIL C** MAINSCOT  
SCALE: 3" = 1'-0"

**NOTES**

- 1 REMOVE EXISTING 'FUR OUT' WAINSCOT REPLACE AS PER DETAIL A/A-1
- 2 REMOVE EXISTING WOOD DOOR & HARDWARE RETURN TO OWNER. EXISTING FRAME TO REMAIN
- 3 PATCH & REPAIR EXISTING MAINSCOT AS REQUIRED MATCH EXIST. SIM. TO DETAIL A/A-1
- 4 REMOVE EXISTING DOOR & FRAME (RETURN TO OWNER) FILL HOLE 1/4" 2x4 STUDS 1/4" 5/8" GYP. BD. TEXTURE & PAINT MATCH EXISTING
- 5 2"x4" STUDS AT 16" O/C
- 6 SAW CUT HOLE IN EXISTING WOOD FLOOR SYSTEM COORDINATE SIZE OF HOLE W/ LIFT MANUFACTURER HEADER AROUND OPENING W/ (2) 2x MEMBERS MATCH DEPTH OF EXISTING WOOD JOISTS
- 7 RELOCATE EXISTING LIGHT SWITCH SEE ELEC.
- 8 RELOCATE EXISTING FAN SWITCH SEE MECH.
- 9 RELOCATE EXISTING CHALK/TACK BOARD LOCATION BY OWNER
- 10 PATCH & REPAIR ALL EXISTING SURFACES TO MATCH EXISTING

**NOTES**

- 11 REMOVE EXISTING WOOD PANEL AND WALL
- 12 REMOVE EXISTING COAT RACK & RETURN TO OWNER
- 13 SAW-CUT OPENING IN EXISTING WALL PATCH & REPAIR TO RECEIVE PLASTER FINISH - TEXTURE & PAINT MATCH EXISTING
- 14 REMOVE EXISTING DOOR, FRAME & HARDWARE AND PORTION OF EXISTING WALL PATCH & REPAIR EXISTING WALLS & CEILING AS REQUIRED MATCH EXISTING FINISHES
- 15 REMOVE EXISTING LIGHT SWITCH & TIMER SWITCH - SEE ELEC. PATCH & REPAIR HOLE TEXTURE AND PAINT TO MATCH EXIST.
- 16 NEW FLOOR FRAME 1/4" 2x10's AT 24" O/C - SEE SECTION 2/A-2 (SHADED AREA)
- 17 PATCH EXISTING FLOOR TO ACHIEVE LEVEL SURFACE TO ELEVATION 100'-0" - MATCH EXISTING FINISH (CROSS-HATCHED AREA)

**JRW ASSOCIATES**  
JOHN R. WATSON 18-1276  
STATE OF IDAHO

JOHN R. WATSON  
REGISTERED PROFESSIONAL ENGINEER  
IDaho No. 83201  
P.O. Box 20911  
Idaho Falls, Idaho 83405  
(208) 324-0211  
Fax (208) 333-0529

**CONSULTANTS:**

**CIVIL ENGINEERING**  
HARPER - LEAVITT  
895 No. Capitol  
P.O. Box 20911  
Idaho Falls, Idaho 83405  
(208) 324-0211

**MECHANICAL ENGINEERING**  
ENGINEERED SYSTEMS ASSOC.  
315 West Centre  
Pocatello, Idaho 83201  
(208) 233-0501  
Fax (208) 233-0529

**ELECTRICAL ENGINEERING**  
ENGINEERED SYSTEMS ASSOC.  
315 West Centre  
Pocatello, Idaho 83201  
(208) 233-0501  
Fax (208) 233-0529

PROJECT: **MENAN 1, 2**  
IDAHO  
**MENAN IDAHO STAKE**


DRAWING TITLE: **FLOOR PLAN DETAILS**

DATE: 4-11-85	PROJECT NO.: 9413-01-01-5	DATE: APRIL 1985
DRAWN BY: R. WATSON	JOB NO.: 018	CHECKED BY: JRW


DRAWING NO. **A-1**  
OF **3**

24X




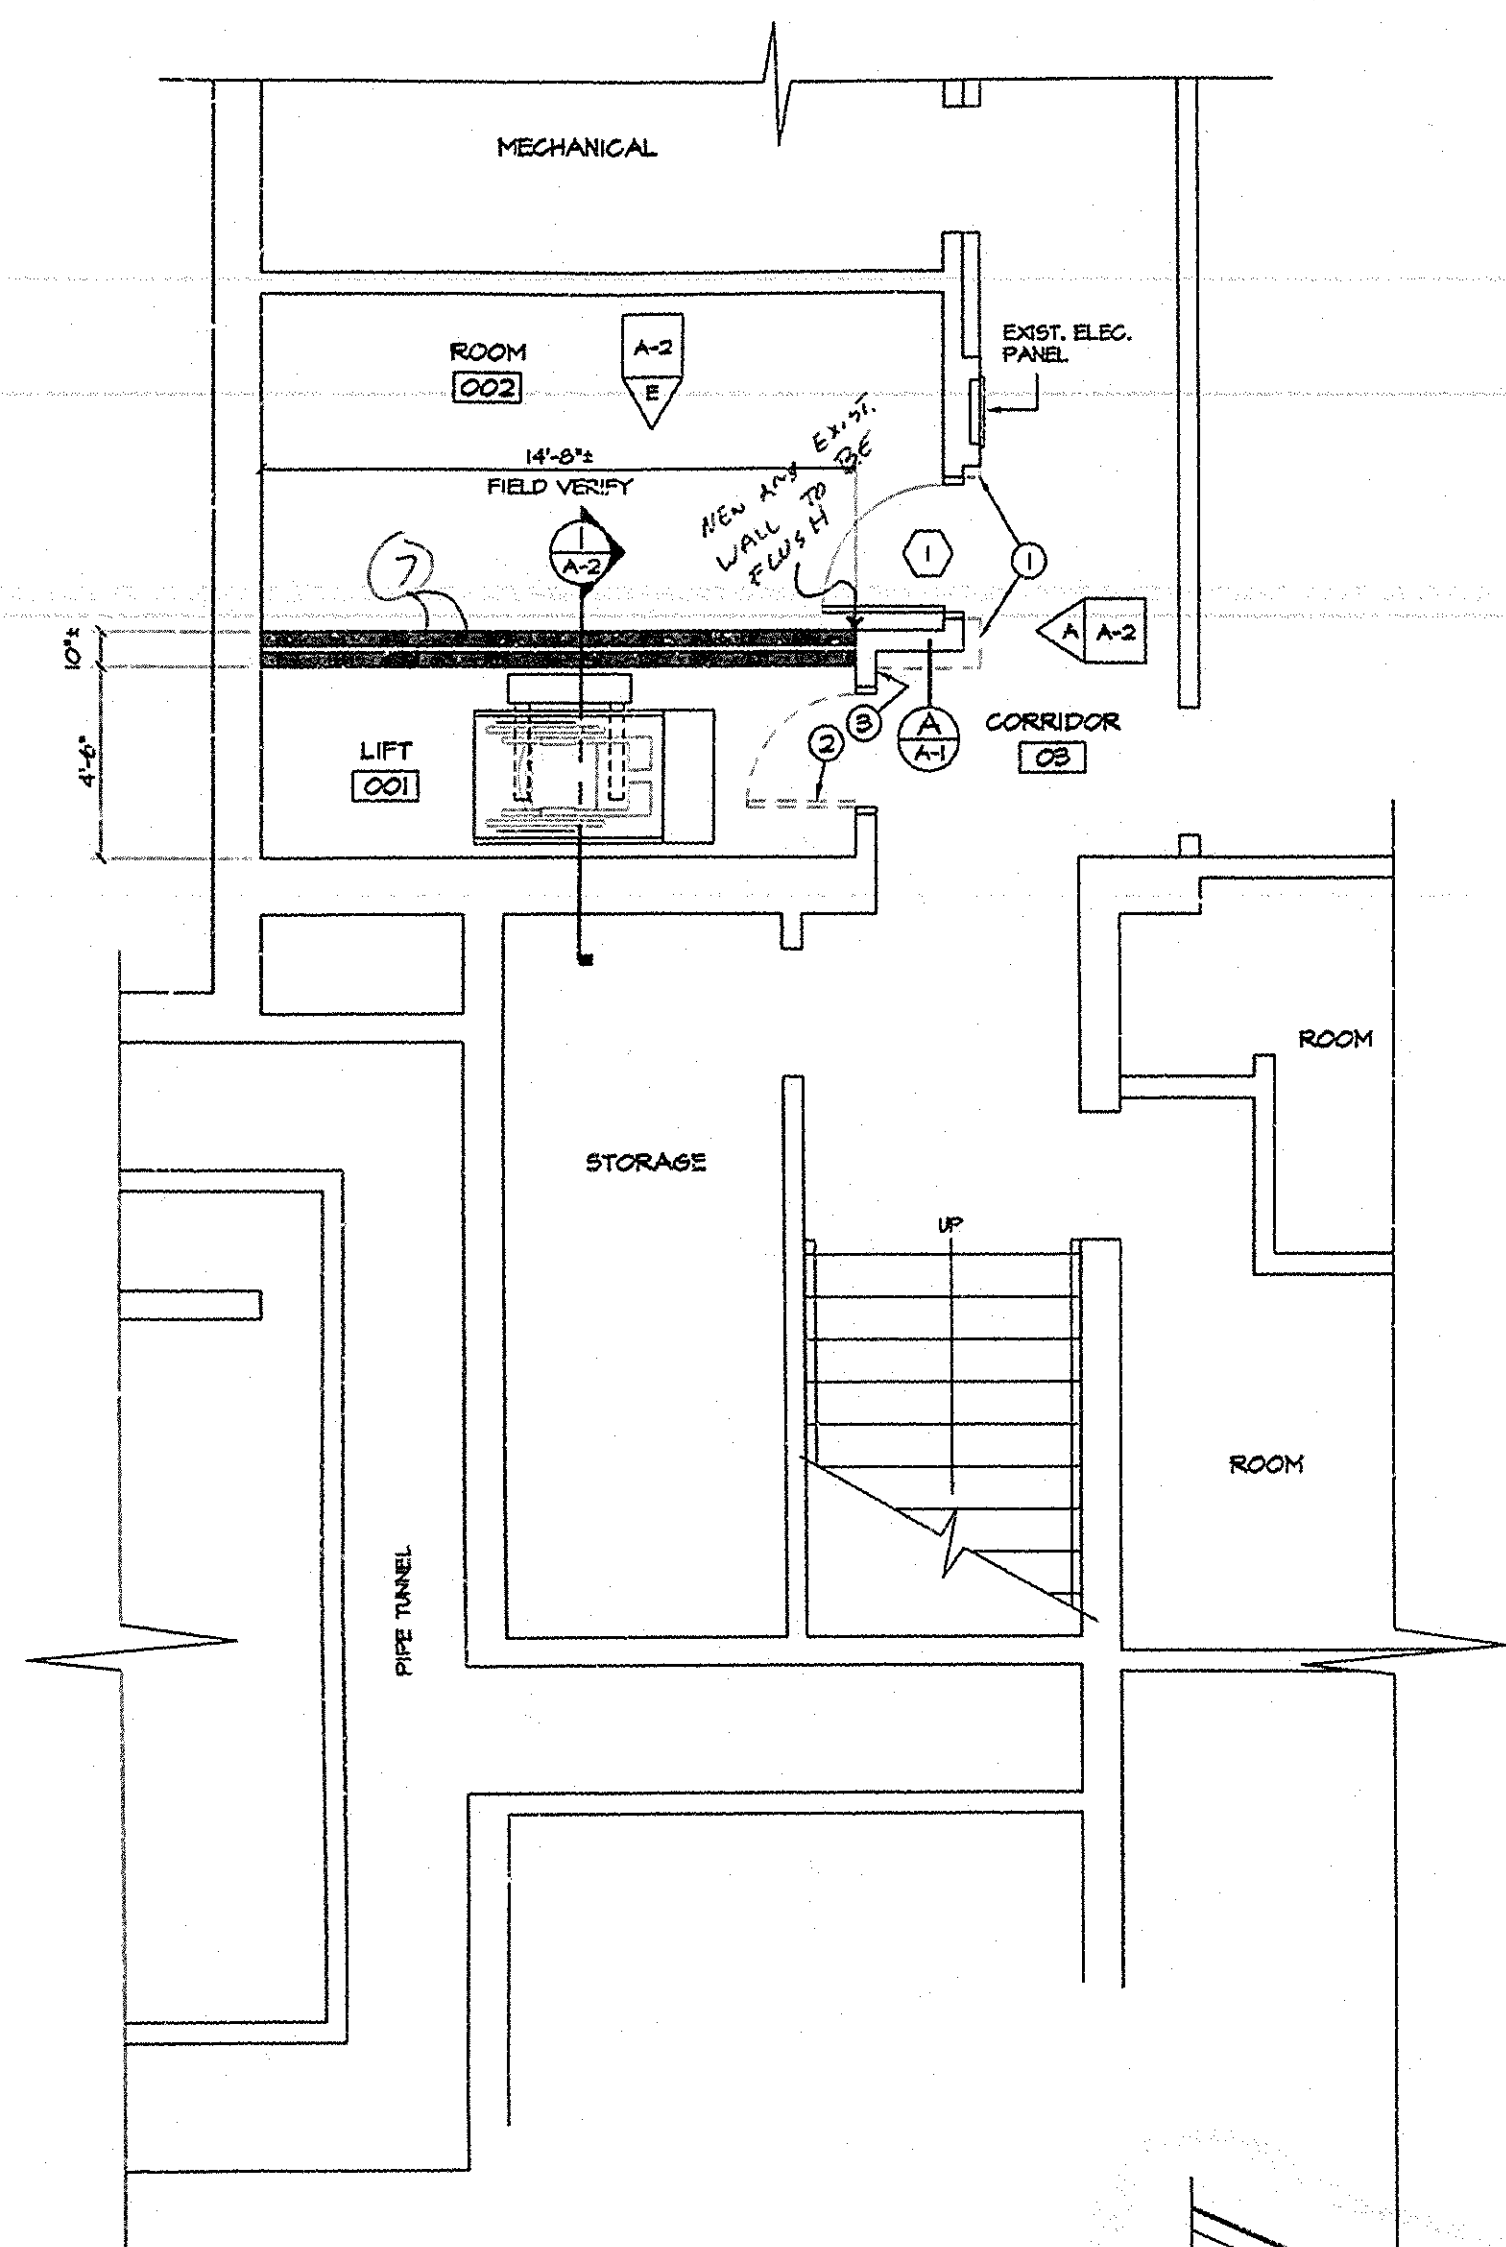


**BASEMENT FLOOR PLAN**  
SCALE: 1/4" = 1'-0"

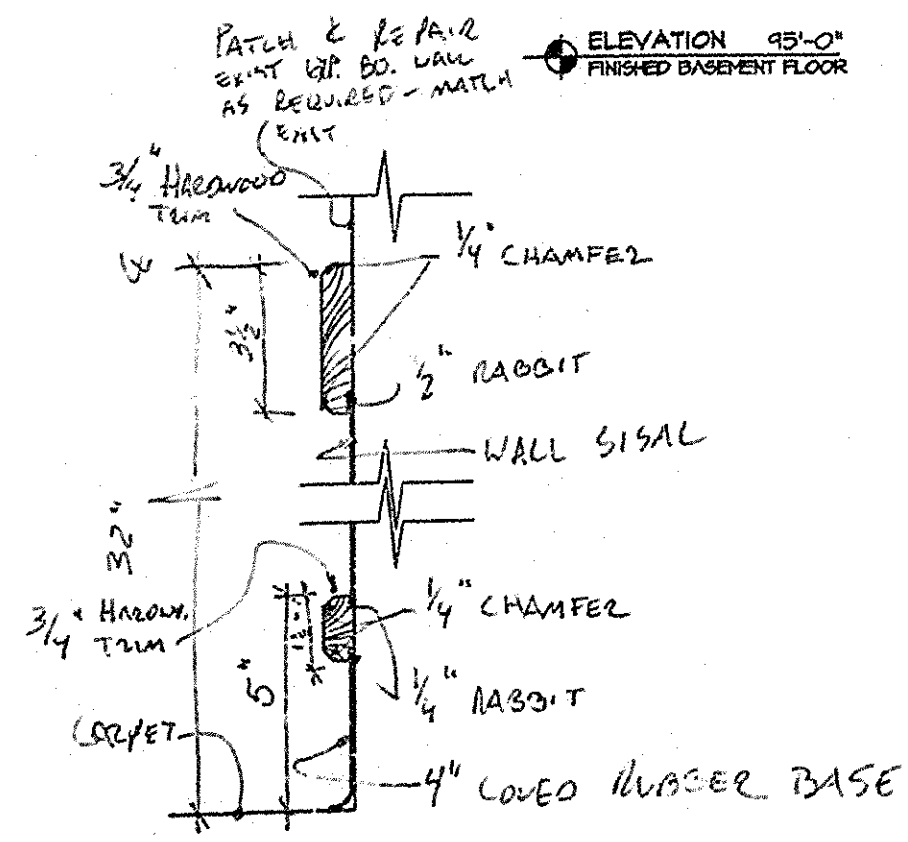


**DETAIL**  
SCALE: 5/8" = 1'-0"

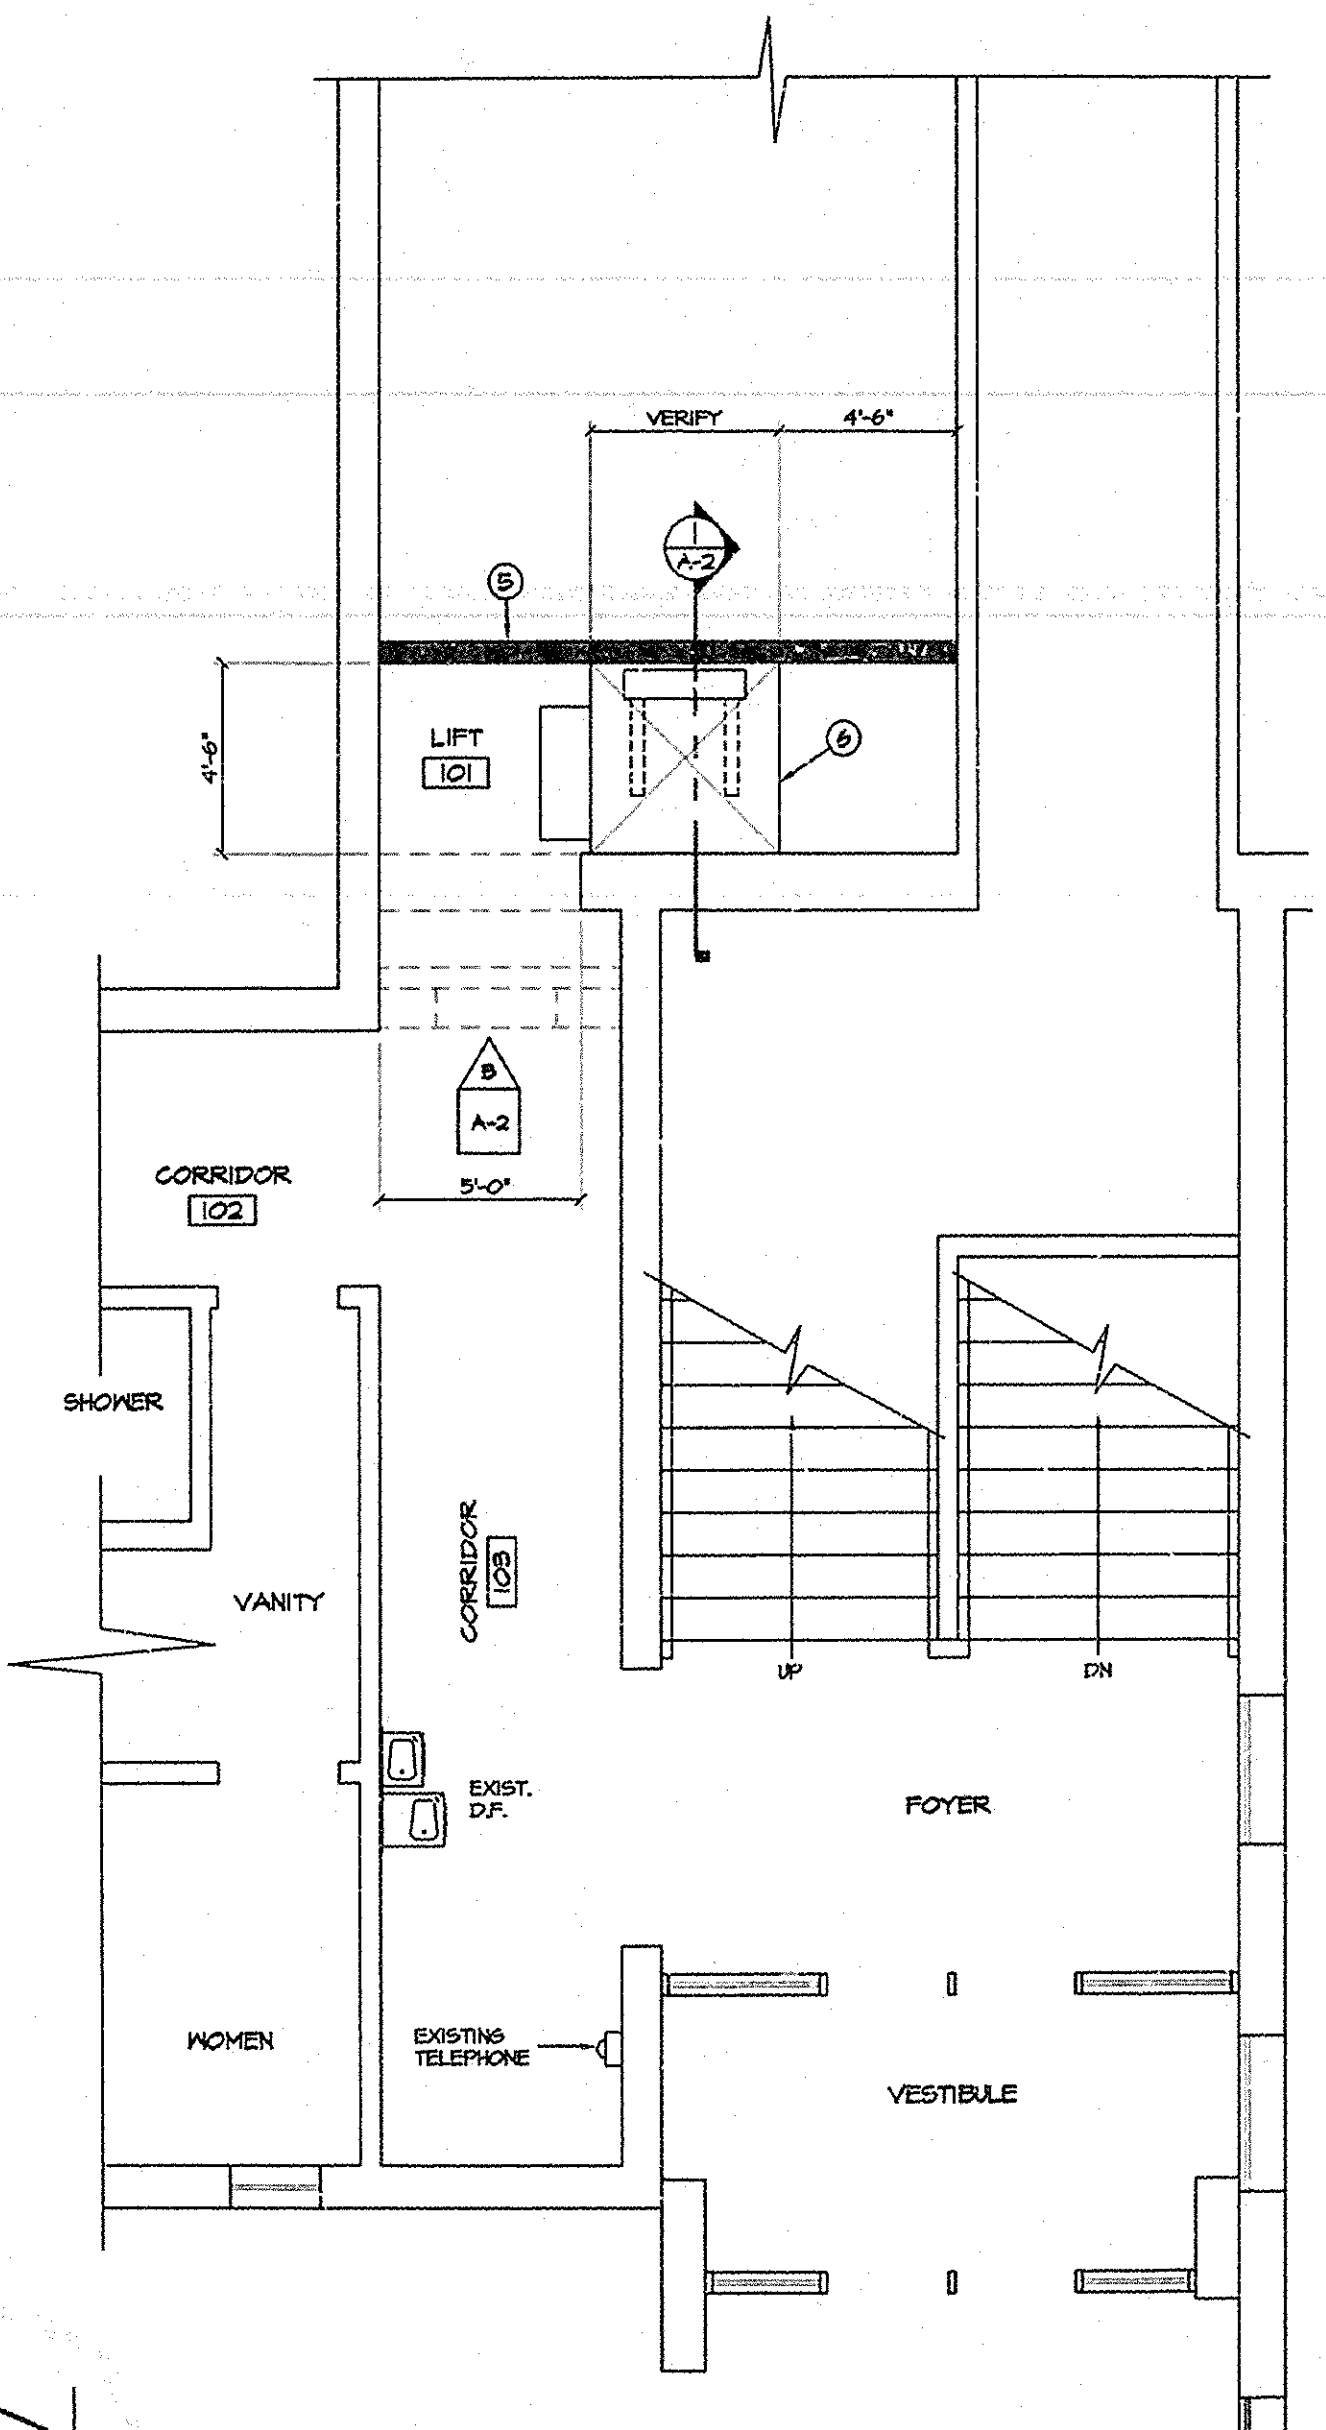

**ENTRY LEVEL FLOOR PLAN**  
SCALE: 1/4" = 1'-0"

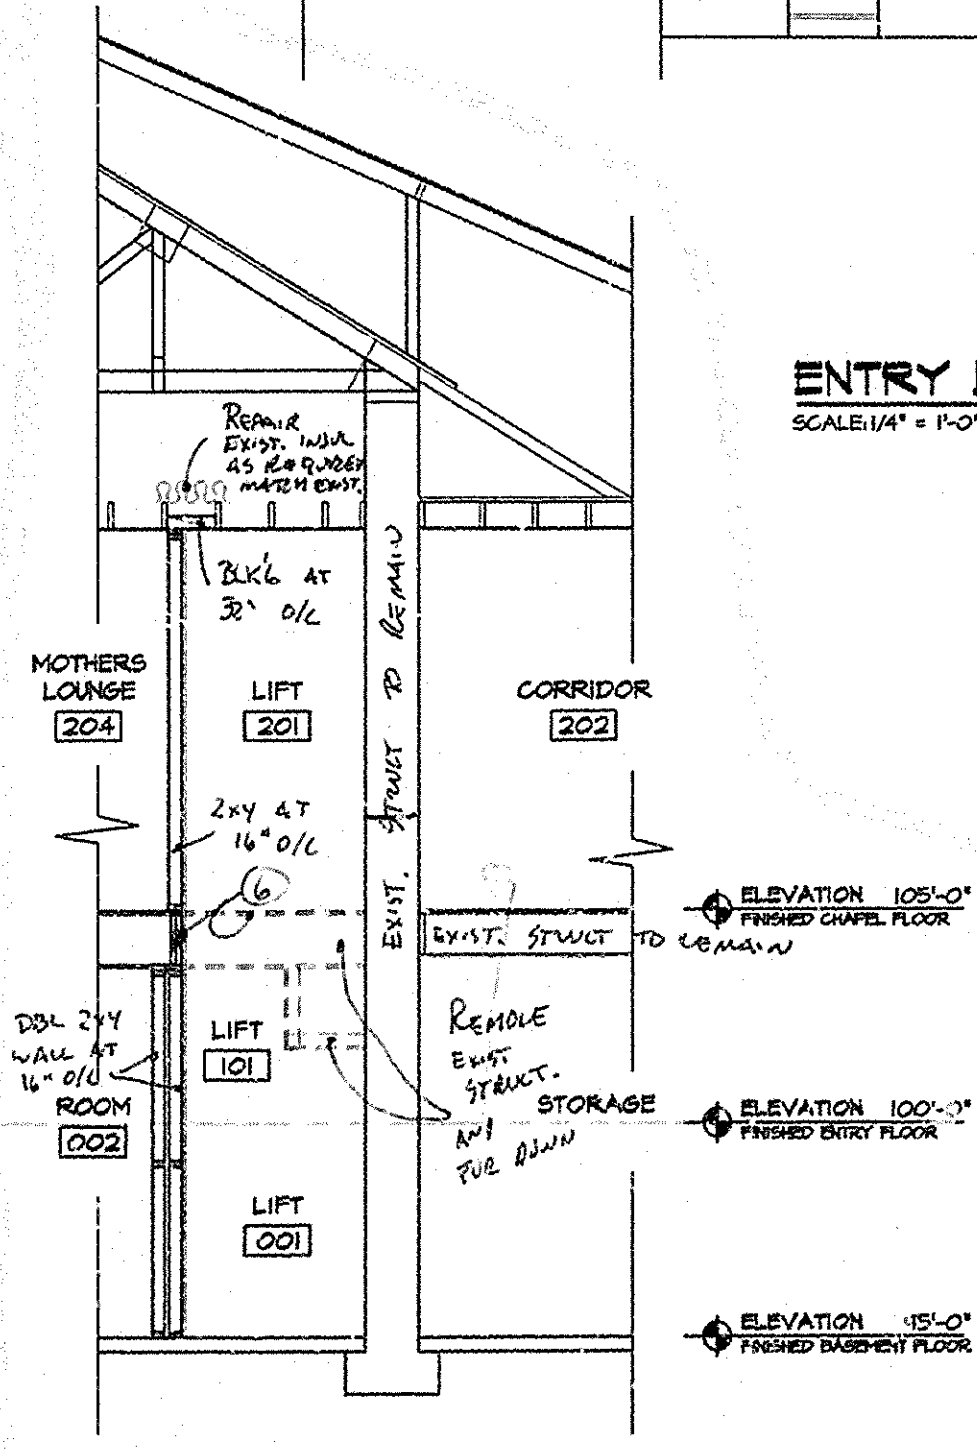

**SECTION**  
SCALE: 1/4" = 1'-0"

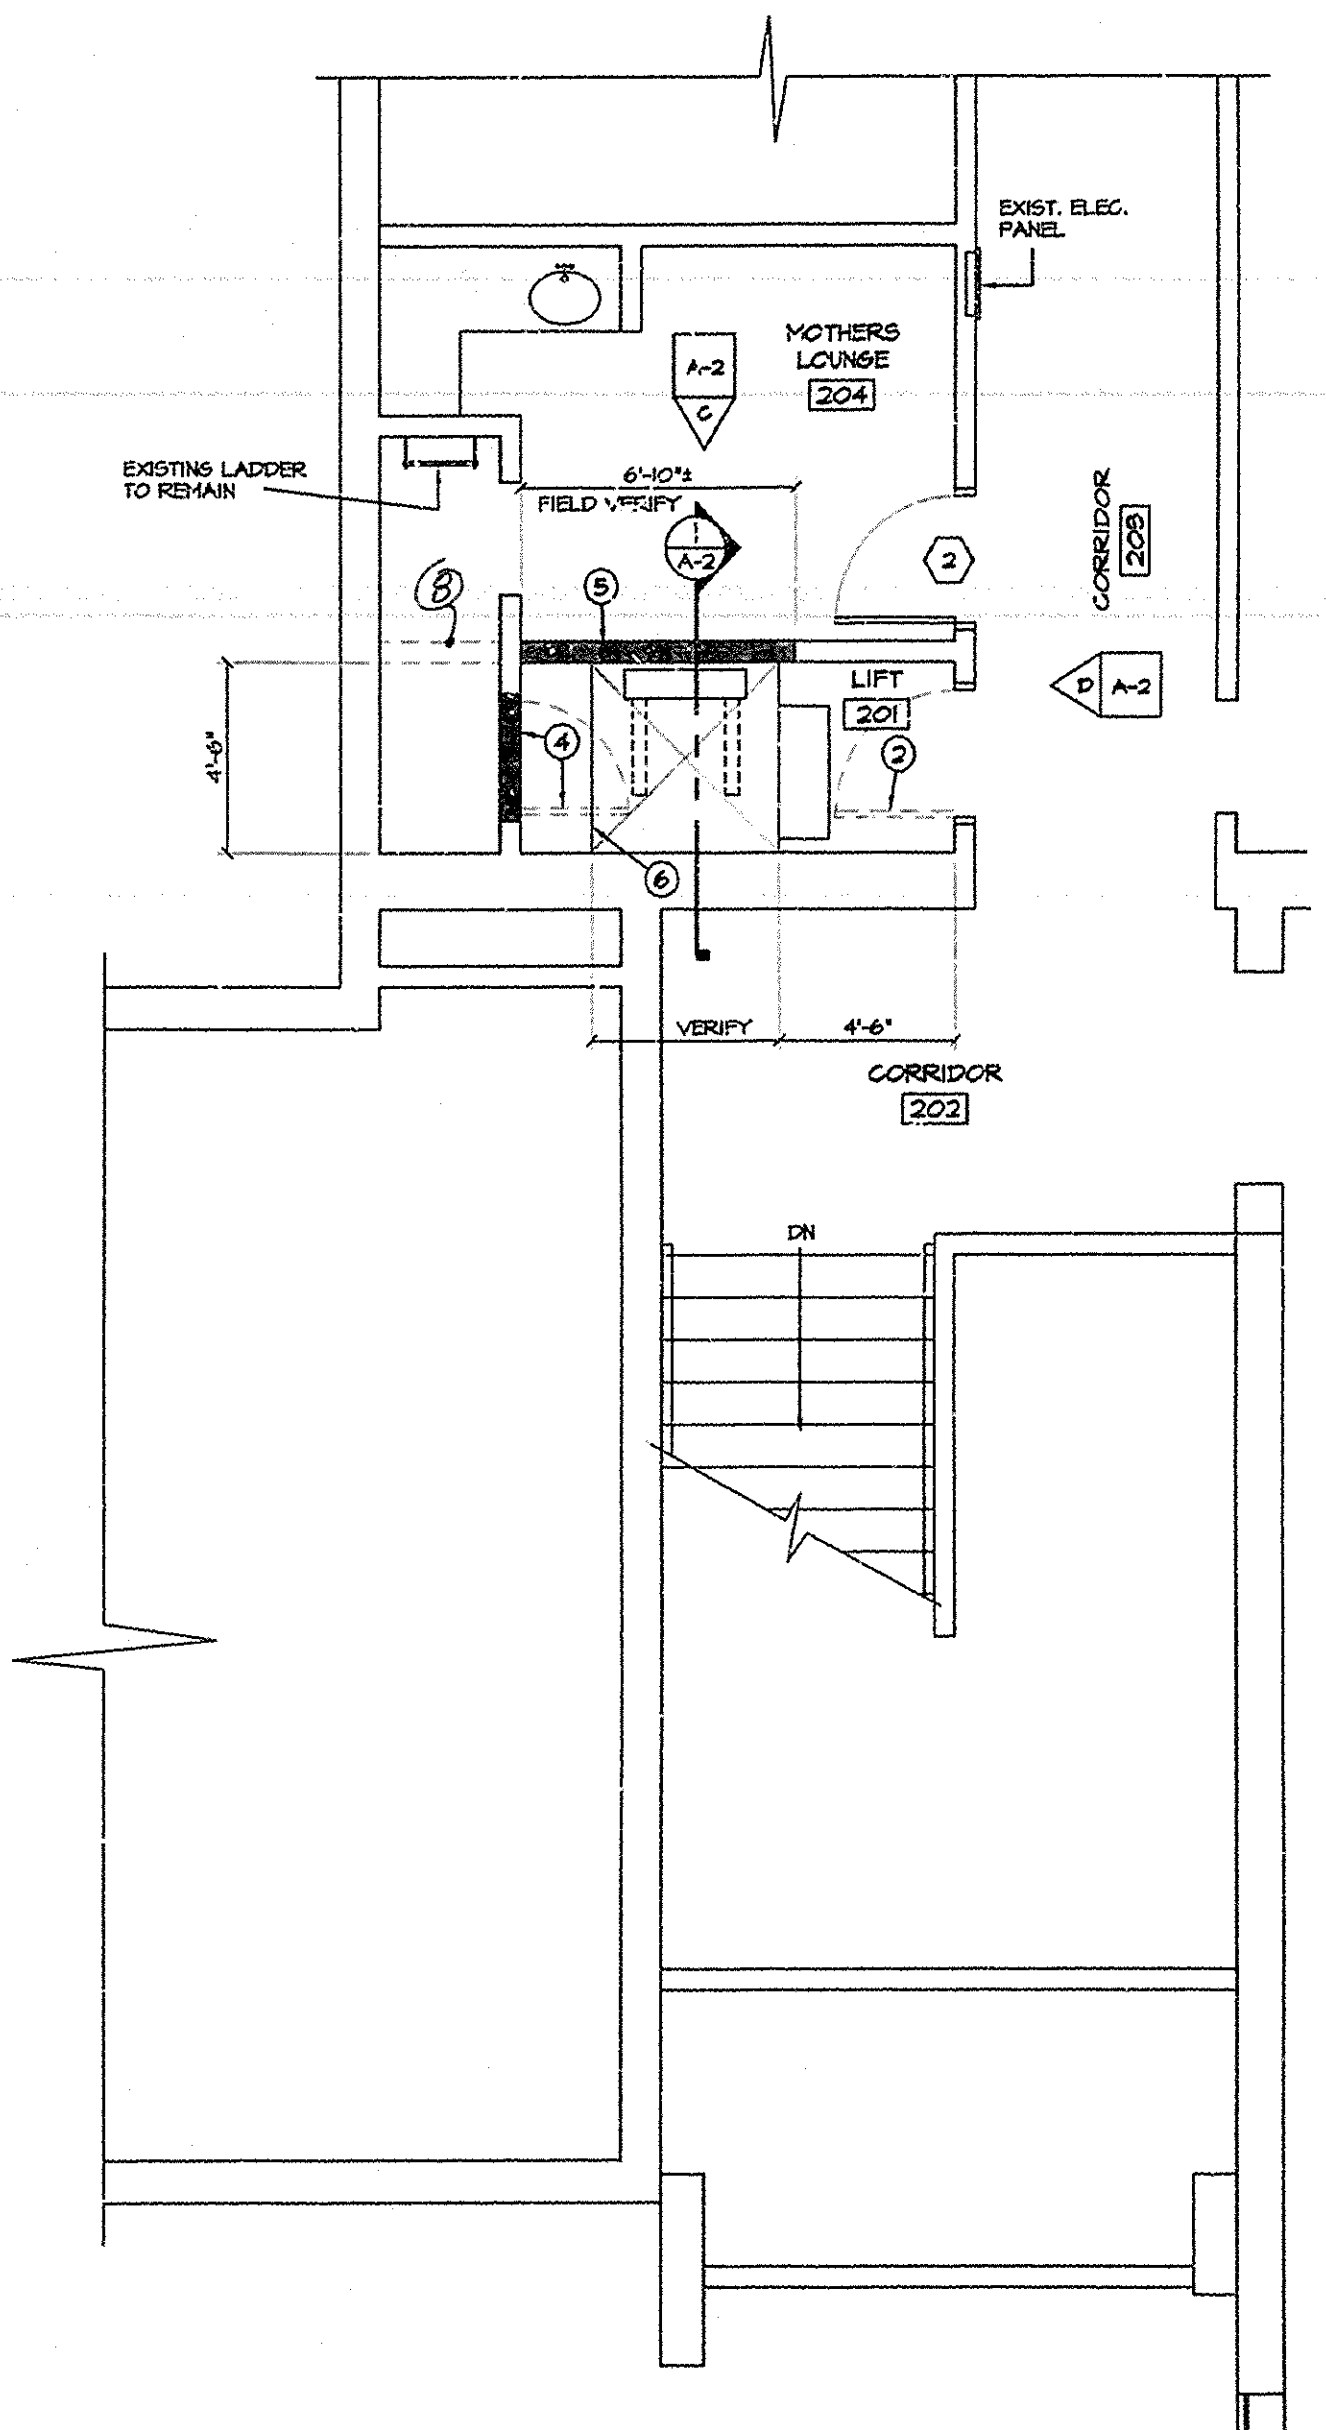

**CHAPEL LEVEL FLOOR PLAN**  
SCALE: 1/4" = 1'-0"

- ① PATCH & REPAIR EXIST. STUD WALL AS REQUIRED - MATCH EXIST.
- ② SAW CUT & REMOVE PORTION OF EXIST. WALL.

**NOTES**

- ① REMOVE EXISTING 'FUR CUT' MAINSCOT REPLACE AS PER DETAIL A/A-1
- ② REMOVE EXISTING WOOD DOOR & HARDWARE RETURN TO OWNER EXISTING FRAME TO REMAIN
- ③ PATCH & REPAIR EXISTING MAINSCOT AS REQUIRED MATCH EXIST. SIM. TO DETAIL A/A-1
- ④ REMOVE EXISTING DOOR & FRAME (RETURN TO OWNER) FILL HOLE W/ 2x4 STUDS W/ 5/8" GYP. ED. TEXTURE & PAINT MATCH EXISTING
- ⑤ 2x4 STUDS AT 16" O/C
- ⑥ SAW CUT HOLE IN EXISTING WOOD FLOOR SYSTEM COORDINATE SIZE OF HOLE W/ LIFT MANUFACTURER HEADER AROUND OPENING W/ (2) 2x4 MEMBERS MATCH DEPTH OF EXISTING WOOD JOISTS
- ⑦ REMOVE 2x4 WOOD STUD WALL AT 16" O/C. W/ 5/8" GYP. ED. TEXTURE AND PAINT ON NORTH SIDE & 1/2" PLYWOOD SHEATHING & 5/8" GYP. ED. TEXTURE AND PAINT ON SOUTH SIDE.

**JRW ASSOCIATES**  
JOHN R. WATSON AR-1276  
STATE OF IDAHO

**JRW ASSOCIATES**  
ARCHITECTURE-ENGINEERING  
CONSTRUCTION MANAGEMENT  
JOHN R. WATSON  
PROFESSIONAL PRACTICE  
LICENSED ARCHITECT  
LICENSED ENGINEER  
LICENSED CONSTRUCTION MANAGER

**CONSULTANTS:**  
CIVIL ENGINEERING  
HASKELL - LEVITT  
895 No. Capital  
P.O. Box 58991  
Idaho Falls, Idaho 83405  
(208) 534-0212  
MECHANICAL ENGINEERING  
ENGINEERED SYSTEMS ASSOC.  
315 West Center  
Pocatello, Idaho 83201  
(208) 233-0501  
Fax: (208) 233-0529  
ELECTRICAL ENGINEERING  
ENGINEERED SYSTEMS ASSOC.  
315 West Center  
Pocatello, Idaho 83201  
(208) 233-0501  
Fax: (208) 233-0529

PROJECT: MENAN, IDAHO		DRAWING TITLE: FLOOR PLAN DETAILS	
DATE: 4-13-95	PROJECT NO: 8413-01-013	DRAWN BY: OIB	DATE: APRIL '95
PROJECT NO: 8413-01-013	DATE: 4-13-95	CHECKED BY: JRP	DATE: APRIL '95
DRAWING NO. 03901		OF 3	






**GENERAL NOTES**

- (A) CONTRACTOR & SUBCONTRACTOR SHALL FIELD VERIFY DIMENSIONS, EXISTING CONDITIONS & AREAS AFFECTED BY CONSTRUCTION PRIOR TO SUBMISSION OF BIDS & BEFORE COMMENCING WORK. NOTIFY ARCHITECT IMMEDIATELY OF CONDITIONS OR PROBLEMS NOT IN ACCORDANCE WITH CONTRACT DOCUMENTS.
- (B) CONTRACTOR IS RESPONSIBLE FOR REPAIRS DUE TO DAMAGE OF EXISTING WORK AS A RESULT OF NEW WORK. MATCH EXISTING MATERIALS / FINISHES WHERE REPAIRS ARE NECESSARY & AS DIRECTED BY ARCHITECT.
- (C) REMOVE RUBBISH / DEBRIS FROM PROPERTY. DISPOSE OF TRASH PROPERLY USING APPROVED DISPOSAL SITES FOR TYPE OF MATERIAL ENCOUNTERED. CONSULT LOCAL AUTHORITIES AS REQUIRED.
- (D) VERIFY LOCATION OF EXISTING UTILITIES WITH LOCAL AUTHORITIES. UNDERGROUND UTILITIES HAVE NOT BEEN INDEPENDENTLY VERIFIED BY OWNER OR ITS REPRESENTATIVE. CONTRACTOR SHALL DETERMINE LOCATION OF EXISTING UTILITIES BEFORE COMMENCING WORK AND SHALL BE RESPONSIBLE FOR DAMAGES OCCASIONED BY FAILURE TO LOCATE AND PRESERVE UTILITY LINES.
- (E) BASE BID TO INCLUDE 1500 LINEAL FEET OF CRACK REPAIR.

**PLAN NOTES**

- (1) EXTEND ASPHALT PAVING
- (2) PAINT STRIPES TO BE 4" WIDE - TYPICAL.
- (3) SHADED AREA INDICATES EXTENT OF PARKING AREA TO BE SEALED, CRACK REPAIRED & RE-STRIPED
- (4) REMOVE EXISTING DAMAGED PAVEMENT AND BASE TO 30" BELOW ASPHALT. INSTALL COMPACTED SUB-BASE & BASE. INSTALL NEW ASPHALT.
- (5) REMOVE EXISTING CONC. CURB (APPROX. 7' L.I. W.)
- (6) NEW CONCRETE CURB - SEE A/SD1
- (7) PAINT STRIPES 4" WIDE AND 2'-0" O.C. DIAGONAL LINES.
- (8) STRIP EXISTING VEGETATION LAYER & TOP SOIL LAYER AS REQUIRED.
- (9) NOT USED
- (10) REMOVE EXISTING TREE STUMP
- (11) REPAIR EXISTING PAVEMENT CUT & FILL IN WITH NEW ASPHALT.
- (12) MATCH EXISTING ELEVATION.
- (13) BUILD UP NEW ASPHALT GRADE ELEVATION 5' ABOVE EXISTING.

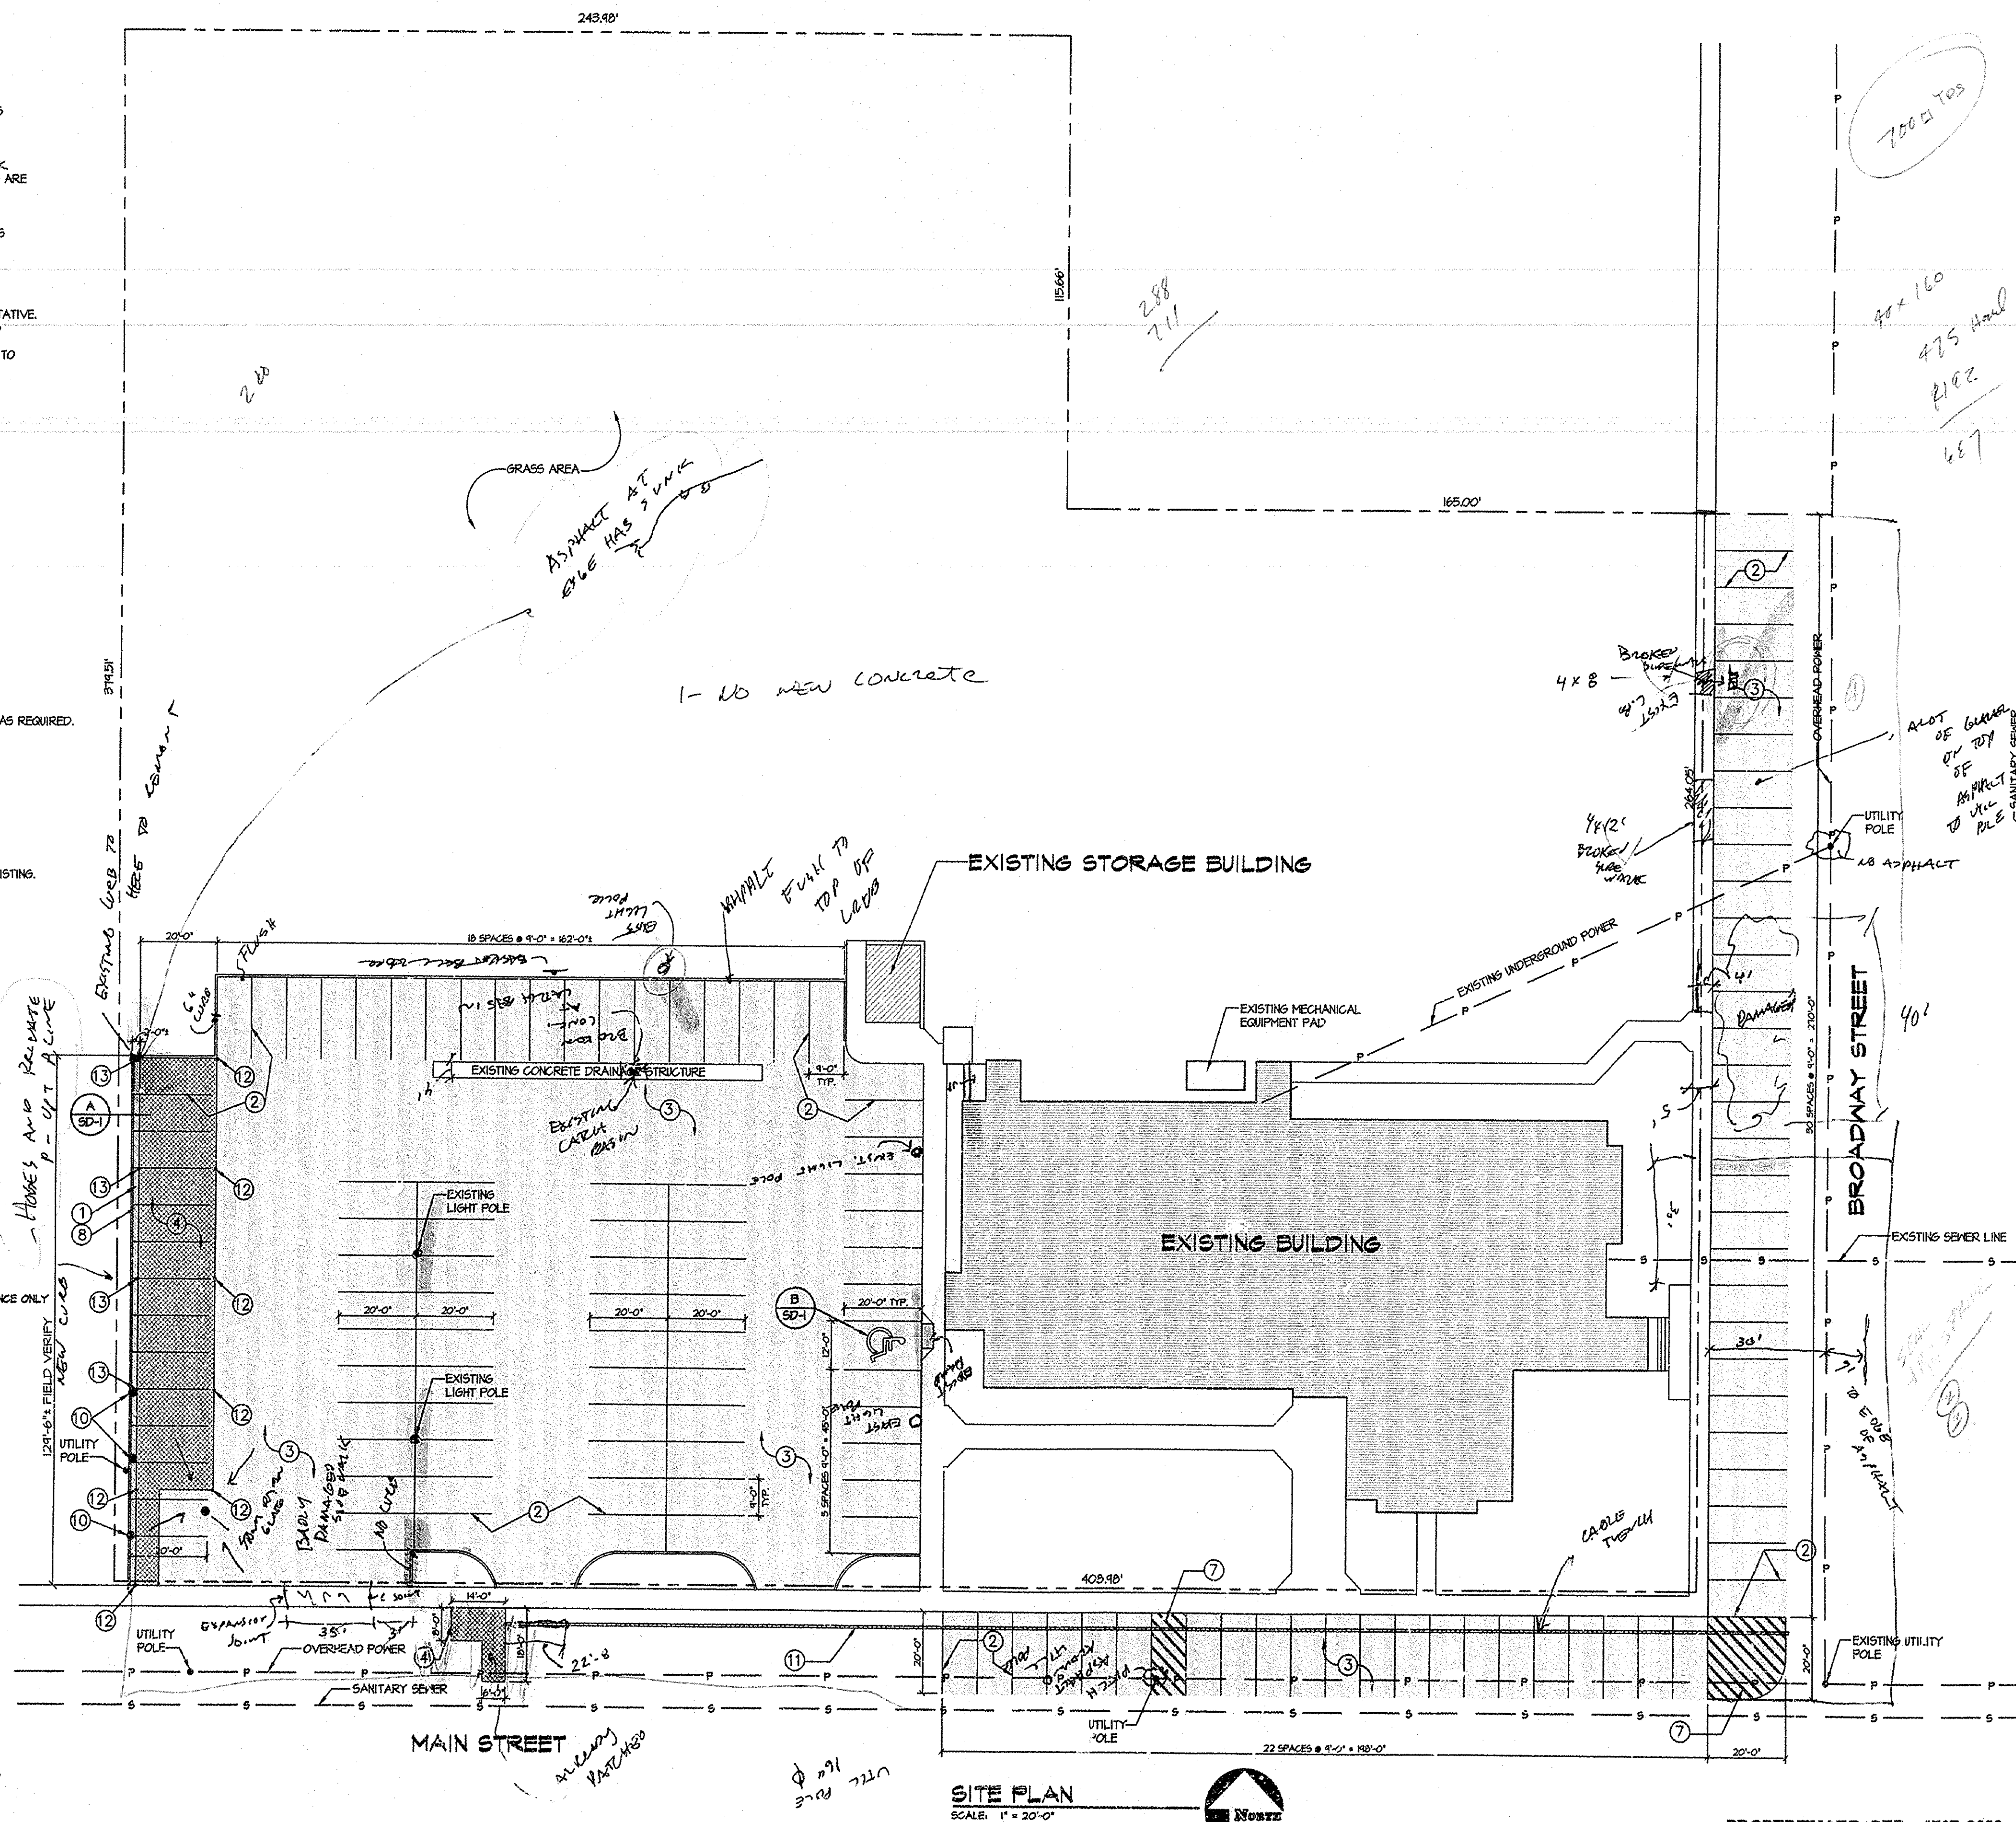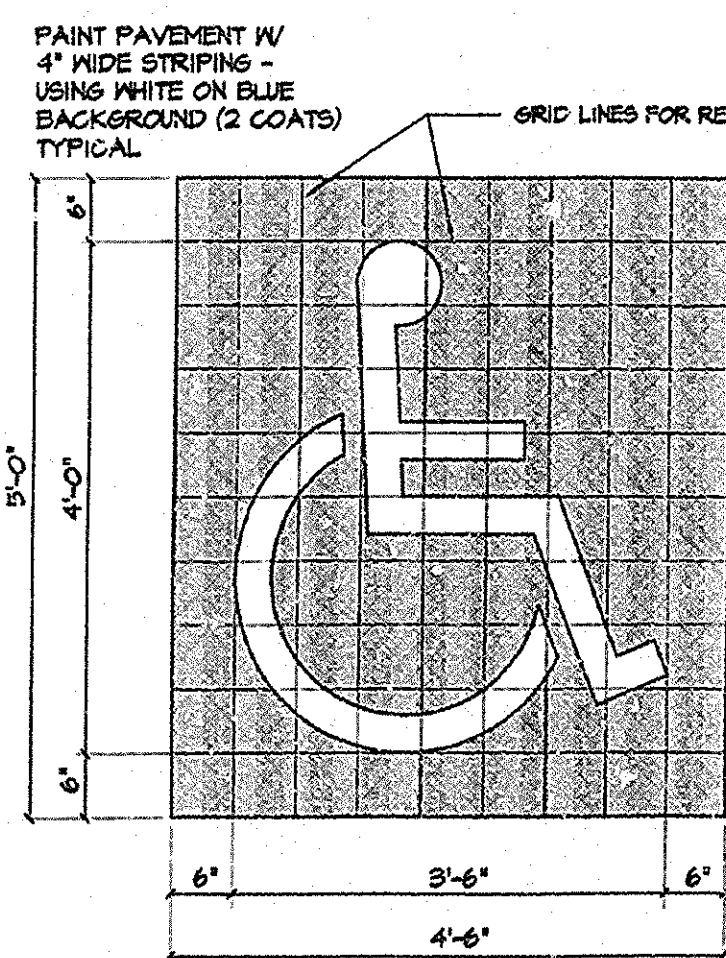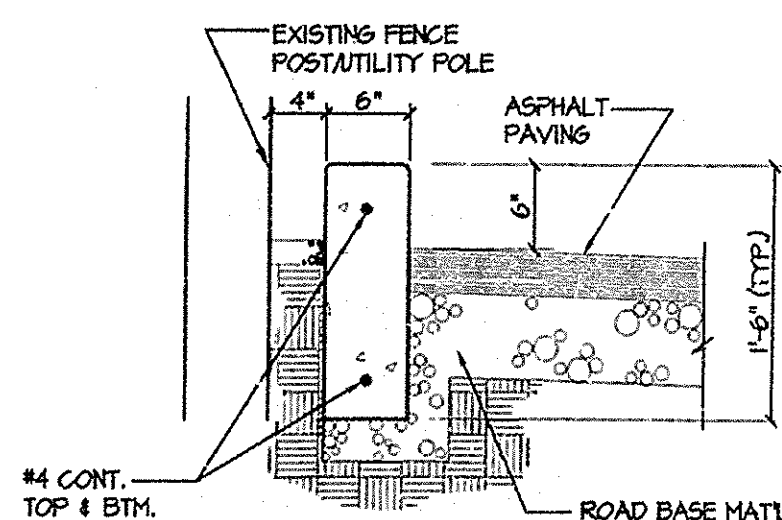

**JRW ASSOCIATES**  
JOHN R. WATSON AR-1276  
STATE OF IDAHO

**JRW ASSOCIATES**  
ARCHITECTURE - ENGINEERING  
CONSULTANTS  
JOHN R. WATSON  
JERRY R. WATSON  
JIMMY R. WATSON  
1501 W. 10TH ST. SUITE 201  
BOISE, IDAHO 83725  
PH: (208) 333-2271  
FAX: (208) 333-2271

**CONSULTANTS:**

**CIVIL ENGINEERING**  
ROBERT L. LEIGHT  
891 No. Capitol  
P.O. Box 50849  
Coeville, Idaho 83405  
(208) 524-0212

**MECHANICAL ENGINEERING**  
ENGINEERED SYSTEMS ASSOC.  
315 West Center  
Pocatello, Idaho 83201  
(208) 233-0501  
Fax: (208) 233-0509

**ELECTRICAL ENGINEERING**  
ENGINEERED SYSTEMS ASSOC.  
315 West Center  
Pocatello, Idaho 83201  
(208) 233-0501  
Fax: (208) 233-0509

**PROJECT:** MENAN I, 2  
MENAN IDAHO STAKE

**DRAWING TITLE:** SITE PLAN

DATE: 4-16-95	JOB NO: 018	DATE: APRIL '95
REVISED: 11-30-01-013	DATE: 1/95	
DRAWN BY: EVANS	CHECKED BY: JRW	

**DRAWING NO.:** SD-1  
FILE: 030901

24X



# IMPROVEMENTS FOR MENAN 1ST. & 2ND WARDS

THE CHURCH OF  
JESUS CHRIST  
OF LATTER-DAY  
SAINTS



**MENAN,**

**IDAHO**

**REVIEWED AND APPROVED**

THIS IS TO CERTIFY THAT THE  
STAKE/MISSION PRESIDENT HAS  
REVIEWED THESE DRAWINGS AND  
SPECIFICATIONS AND FINDS THEM  
ACCEPTABLE AND IS IN CONCURRENCE

\_\_\_\_\_  
STAKE/MISSION PRESIDENT      DATE

**ASSOCIATES**

ARCHITECTURE - ENGINEERING  
CONSTRUCTION MANAGEMENT

(208) 359-2309      49 PROFESSIONAL PLAZA  
Fax (208) 359-2271      REXBURG, IDAHO 83440

DRAWING INDEX	
ARCHITECTURAL	
C-1	COVER SHEET
SD-1	SITE DETAIL
A-1	FLOOR PLAN

**PROPERTY # 507-2638**

**JRW**  
ASSOCIATES

JOHN R. WATSON  
JOHNNY R. WATSON  
JENICA R. WATSON  
GARY D. RICHARDSON  
ROYAL W. GARDNER


49 PROFESSIONAL PLAZA  
REXBURG, IDAHO  
83440

(208) 359-2309

Qualifications Certified By:  
**N.C.A.R.B.**  
NATIONAL COUNCIL  
OF  
ARCHITECTURAL REGISTRATION  
BOARDS

**JRW**  
ASSOCIATES

JOHN R. WATSON AR-1276

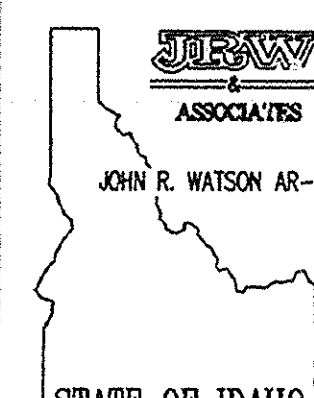

STATE OF IDAHO

CONSULTANTS:

PROJECT:  
IMPROVEMENTS  
FOR  
MENAN  
1ST. & 2ND WARDS  
MENAN IDAHO STAKE  
MENAN, IDAHO

DRAWING TITLE:  
COVER SHEET  
AND  
INDEX TO  
DRAWINGS

PLOT DATE: 5/9/94  
PROJECT No. 1-90  
PLOT SCALE:


DRAWN BY: RWS      JOB NO.:

CHECKED BY: JRW      SHEET NO. C-1  
FILE COVER


DATE:      OF

24X



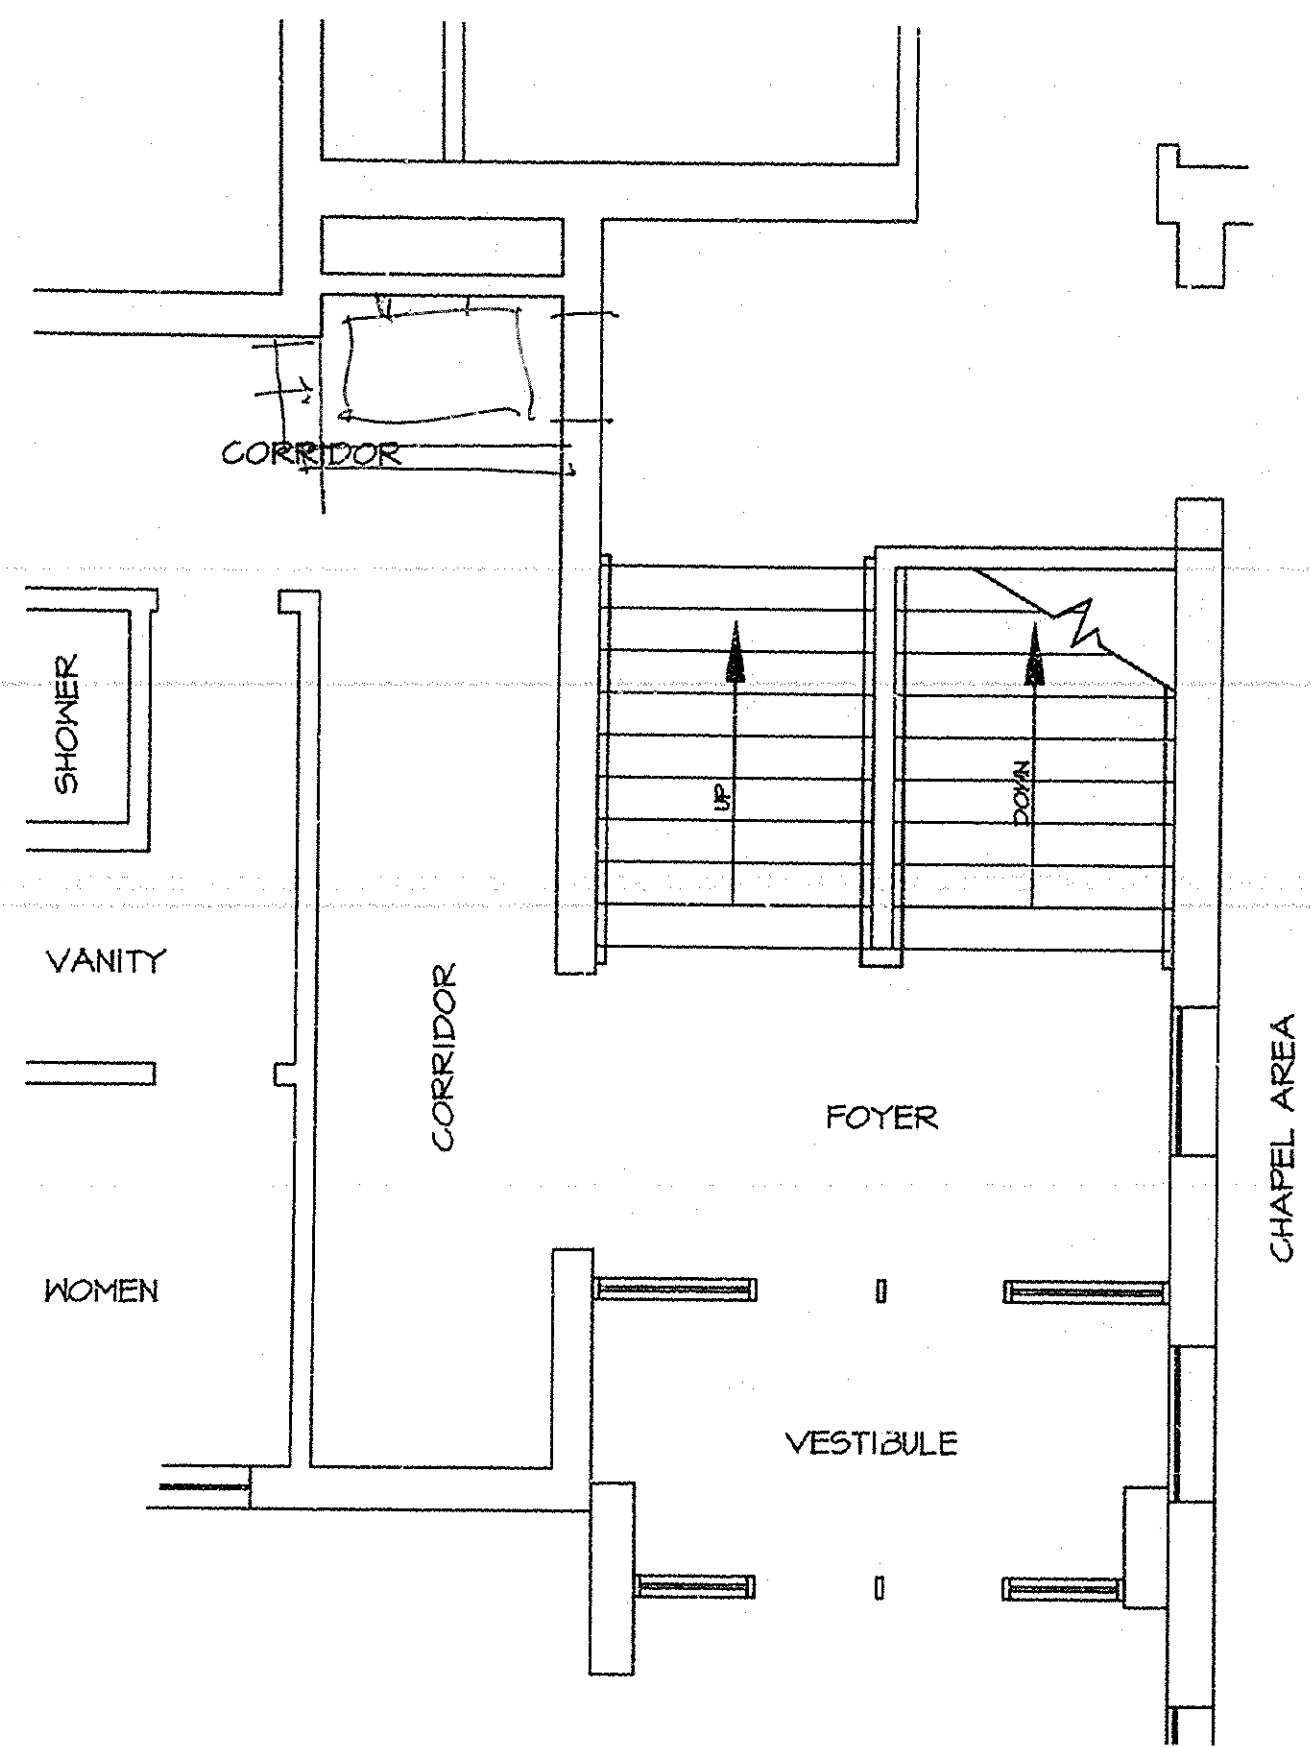

**MAIN LEVEL FLOOR PLAN**  
SCALE: 1/4" = 1'-0"

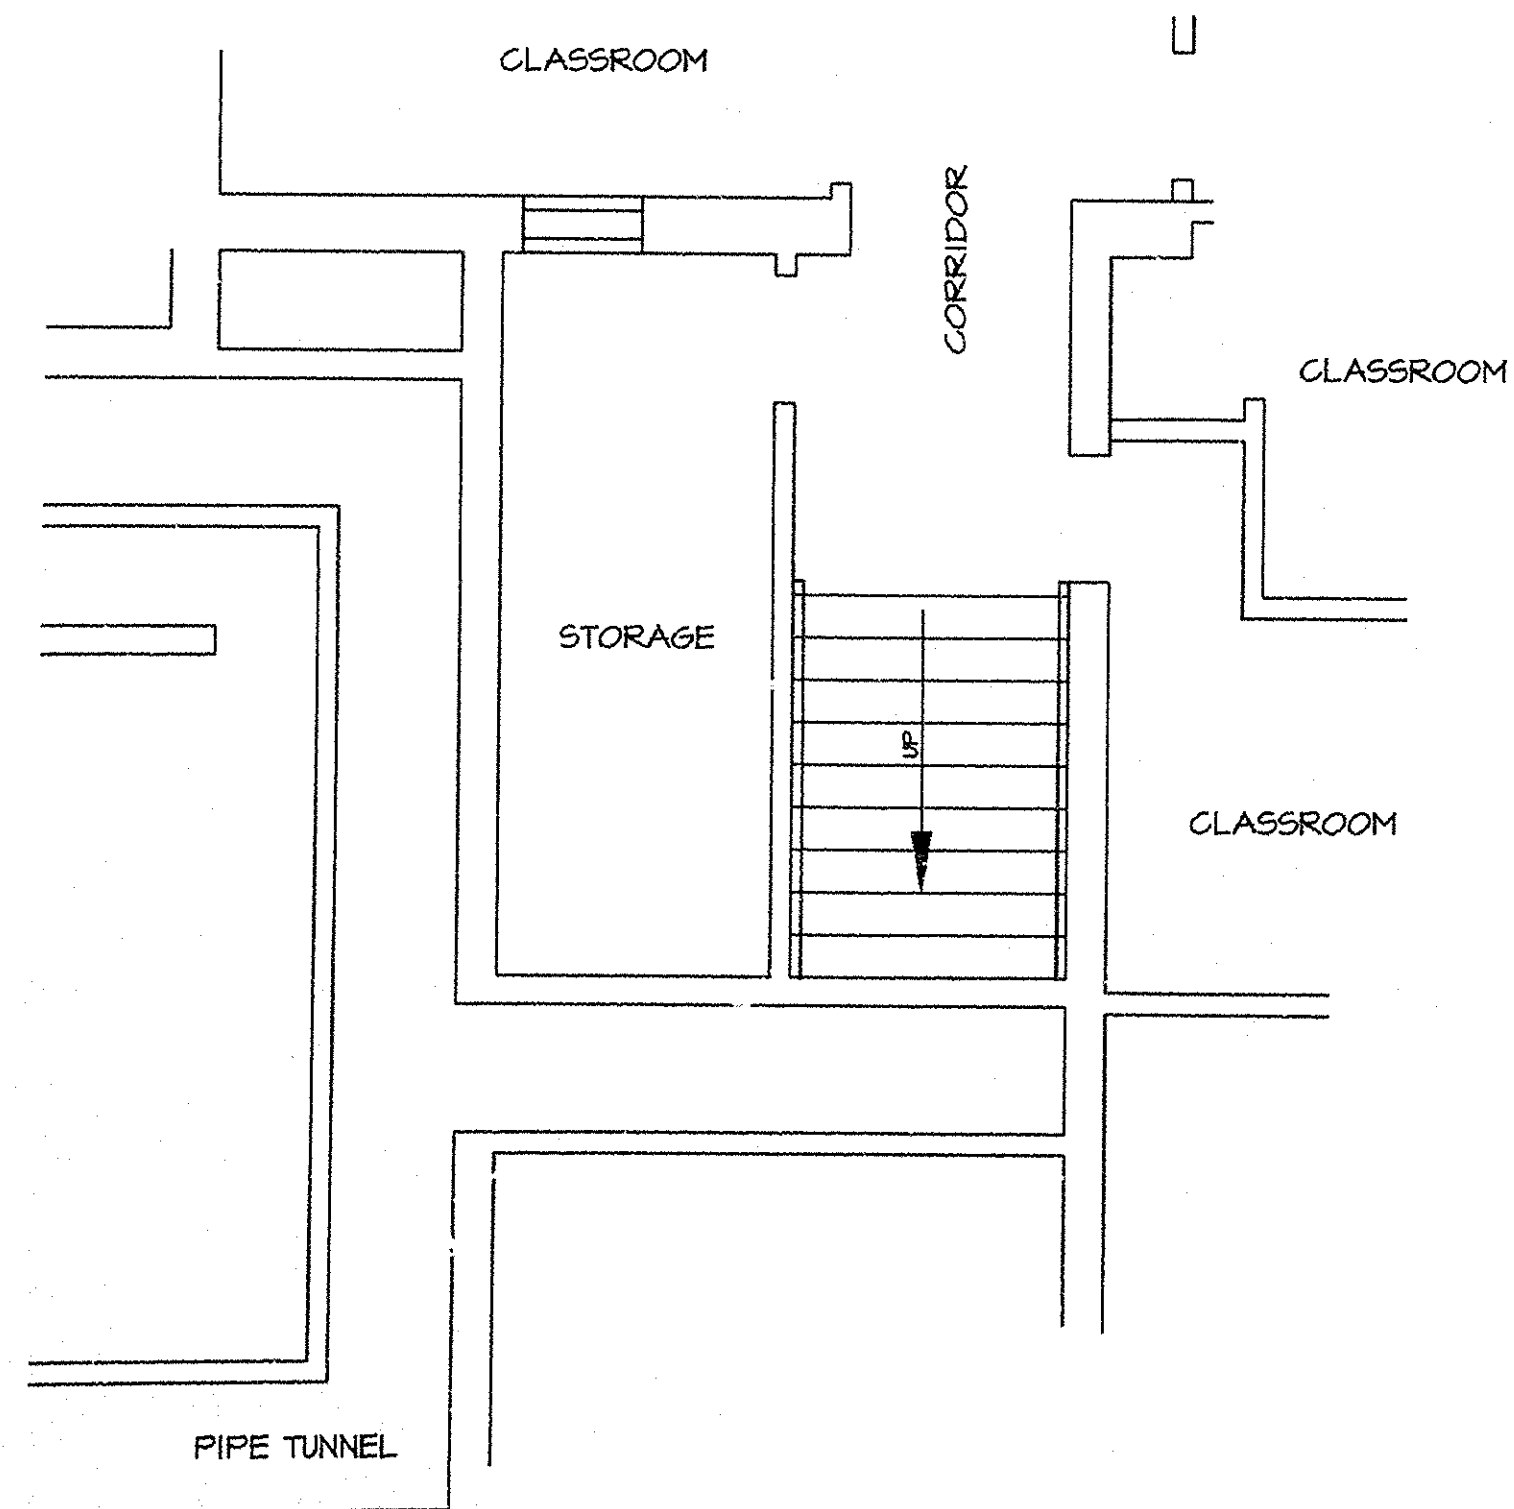


**BASEMENT FLOOR PLAN**  
SCALE: 1/4" = 1'-0"



**JRW**  
ASSOCIATES

JOHN R. WATSON  
JOHNNY R. WATSON  
JENNICA R. WATSON  
GARY D. RICHARDSON  
ROYAL W. GARDNER  
  
49 PROFESSIONAL PLAZA  
REXBURG, IDAHO  
83440  
  
(208) 359-2308

Qualifications Certified By:  
**N.C.A.R.B.**  
NATIONAL COUNCIL  
OF  
ARCHITECTURAL REGISTRATION  
BOARDS

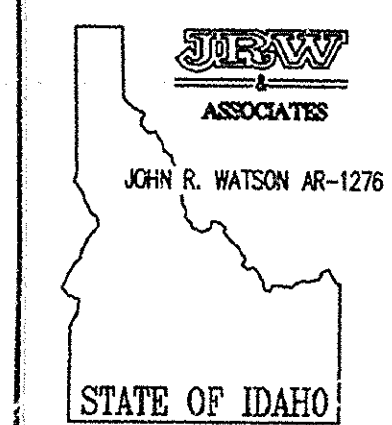

CONSULTANTS:

PROJECT:  
**IMPROVEMENTS FOR  
MENAN  
1ST & 2ND WARDS  
MENAN IDAHO STAKE**  
  
MENAN, IDAHO

DRAWING TITLE:  
**FLOOR PLAN  
DETAILS**

PLOT DATE: 12/05/11  
PROJECT No. X  
PLOT SCALE: 1/4" = 1'-0"

DRAWN BY: JMW  
JOB NO.:

CHECKED BY: JRM  
SHEET NO. 12

DATE: OF

15-011

24X






**GENERAL NOTES**

- (A) CONTRACTOR & SUBCONTRACTOR SHALL FIELD VERIFY DIMENSIONS, EXISTING CONDITIONS & AREAS AFFECTED BY CONSTRUCTION PRIOR TO SUBMISSION OF BIDS & BEFORE COMMENCING WORK. NOTIFY ARCHITECT IMMEDIATELY OF CONDITIONS OR PROBLEMS NOT IN ACCORDANCE WITH CONTRACT DOCUMENTS.
- (B) CONTRACTOR IS RESPONSIBLE FOR REPAIRS DUE TO DAMAGE OF EXISTING WORK AS A RESULT OF NEW WORK. MATCH EXISTING MATERIALS / FINISHES WHERE REPAIRS ARE NECESSARY & AS DIRECTED BY ARCHITECT.
- (C) REMOVE RUBBISH / DEBRIS FROM PROPERTY. DISPOSE OF TRASH PROPERLY USING APPROVED DISPOSAL SITES FOR TYPE OF MATERIAL ENCOUNTERED. CONSULT LOCAL AUTHORITIES AS REQUIRED.
- (D) VERIFY LOCATION OF EXISTING UTILITIES WITH LOCAL AUTHORITIES. UNDERGROUND UTILITIES HAVE NOT BEEN INDEPENDENTLY VERIFIED BY OWNER OR ITS REPRESENTATIVE. CONTRACTOR SHALL DETERMINE LOCATION OF EXISTING UTILITIES BEFORE COMMENCING WORK AND SHALL BE RESPONSIBLE FOR DAMAGES OCCASIONED BY FAILURE TO LOCATE AND PRESERVE UTILITY LINES.
- (E) BASE BID TO INCLUDE 1500 LINEAL FEET OF CRACK REPAIR.

**PLAN NOTES**

- (1) EXTEND ASPHALT PAVING
- (2) PAINT STRIPES TO BE 4" WIDE - TYPICAL
- (3) SHADED AREA INDICATES EXTENT OF PARKING AREA TO BE SEALED, CRACK REPAIRED & RE-STRIPED
- (4) REMOVE EXISTING DAMAGED PAVEMENT AND BASE TO 30" BELOW ASPHALT. INSTALL COMPACTED SUB-BASE & BASE. INSTALL NEW ASPHALT.
- (5) REMOVE EXISTING CONC. CURB AND PREPARE AREA FOR NEW WORK.
- (6) REMOVE EXISTING PAVING & PREPARE AREA FOR NEW WORK.
- (7) PAINT STRIPES 4" WIDE AND 2'-0" O.C. DIAGONAL LINES.
- (8) STRIP EXISTING VEGETATION LAYER & TOP SOIL LAYER AS REQUIRED.
- (9) INSTALL ENGINEERED FILL SUB-BASE, ROAD BASE AND ASPHALT PAVING.
- (10) REMOVE EXISTING TREE STUMP
- (11) REPAIR EXISTING PAVEMENT CUT & FILL IN WITH NEW ASPHALT.
- (12) MATCH EXISTING ELEVATION
- (13) BUILD UP NEW GRADE ELEVATION 5" ABOVE EXISTING.

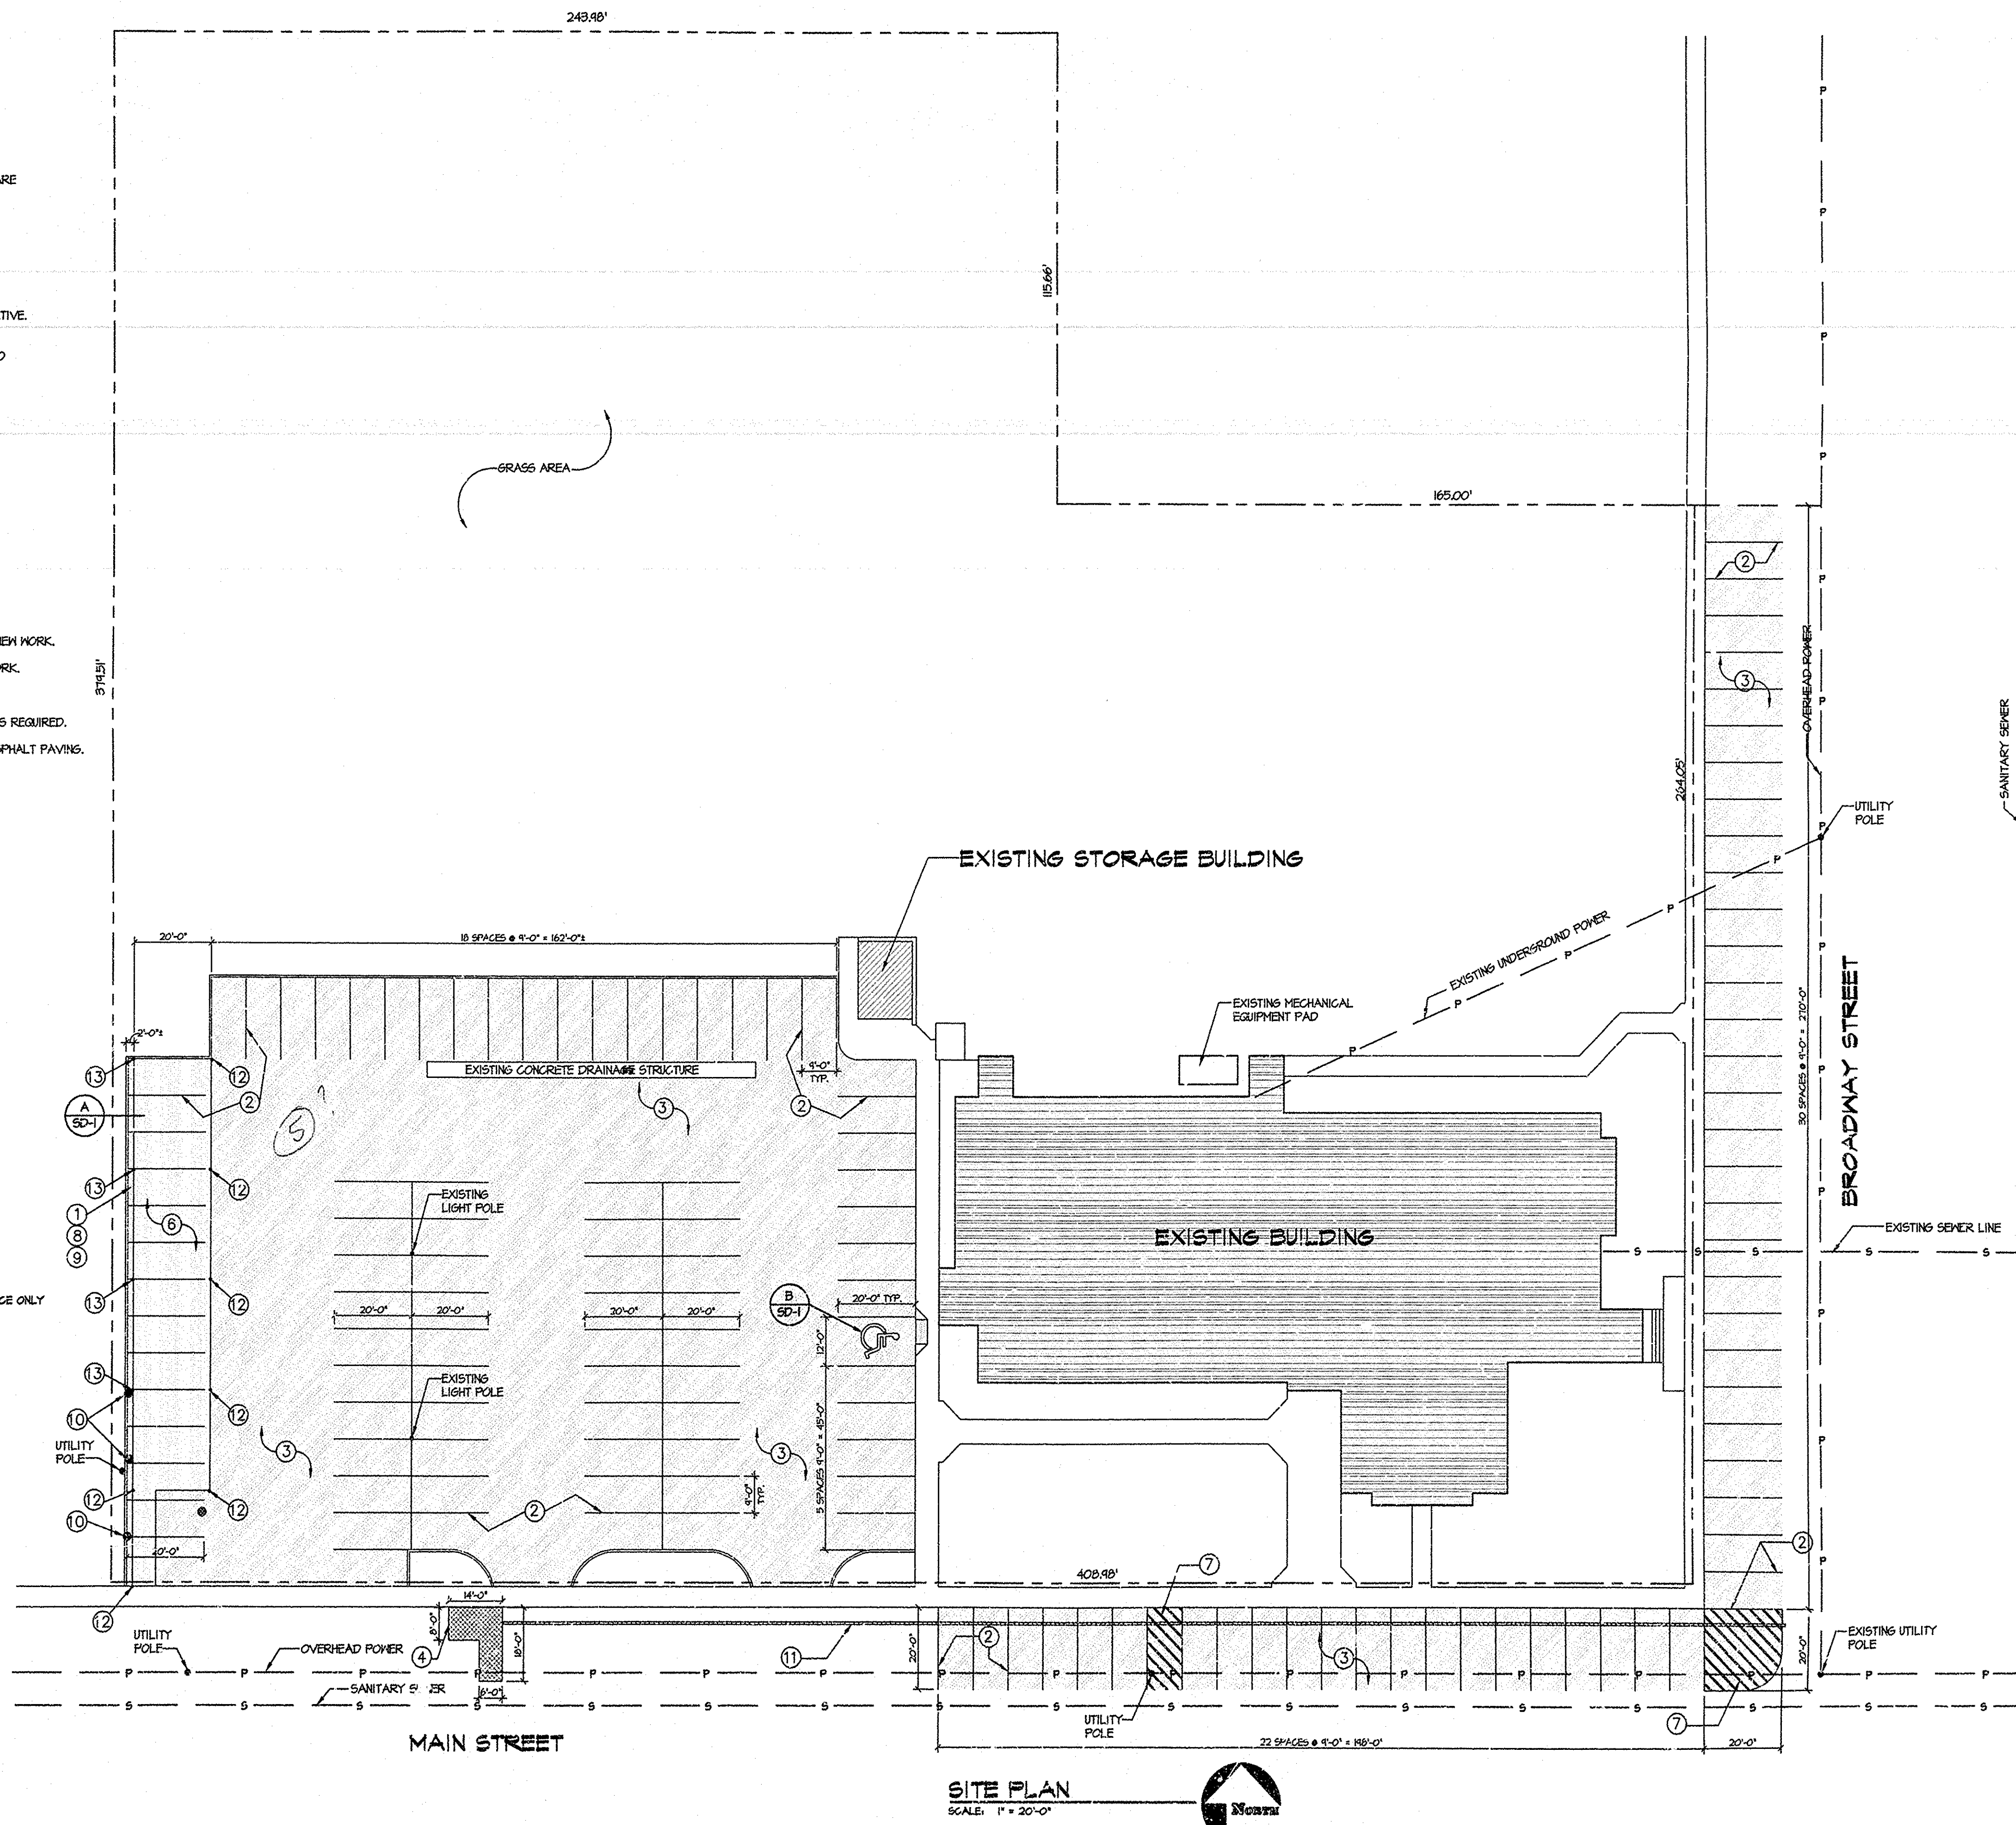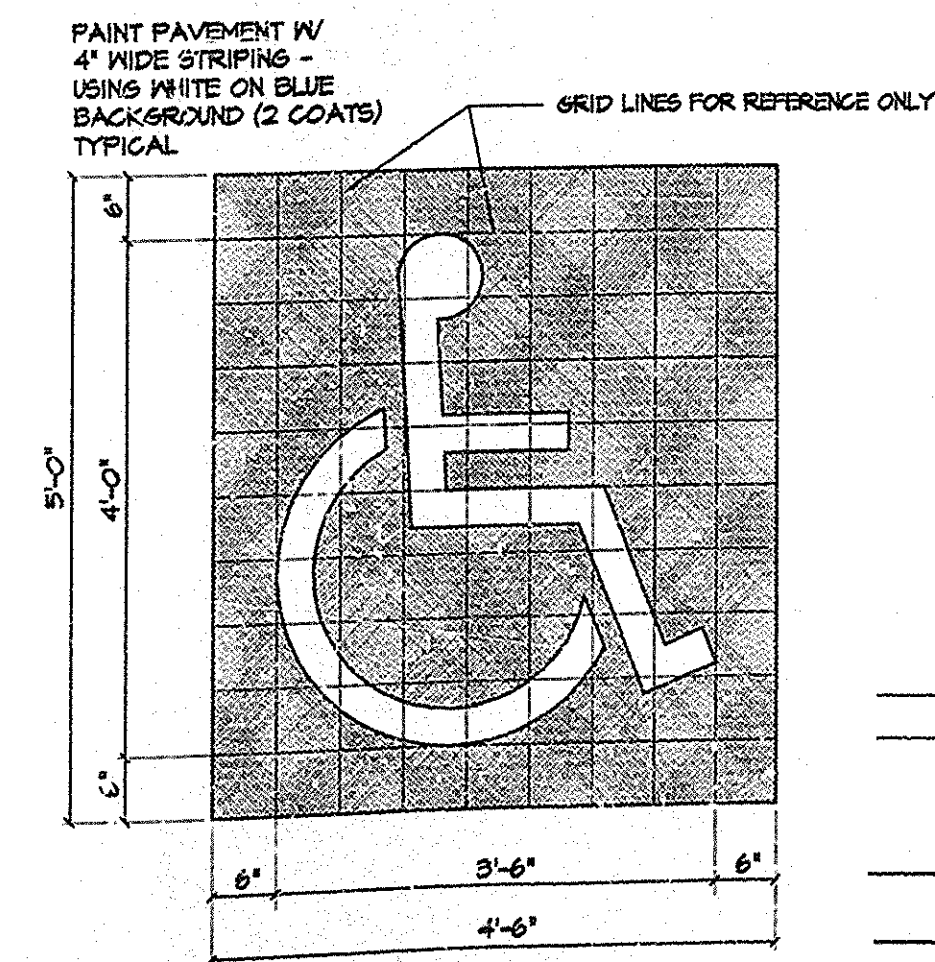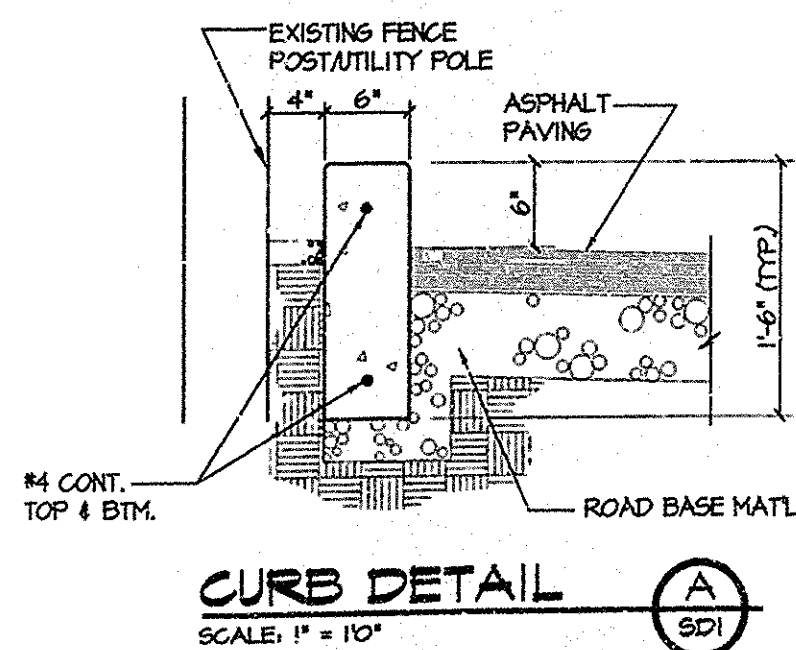

**JRW & ASSOCIATES**  
JOHN R. WATSON  
JOHNNY R. WATSON  
JENICA R. WATSON  
GARY D. RICHARDSON  
ROYAL W. GARDNER  
49 PROFESSIONAL PLAZA  
REXBURG, IDAHO 83440  
(208) 359-2309  
Qualifications Certified By:  
**N.C.A.R.B.**  
NATIONAL COUNCIL  
OF  
ARCHITECTURAL REGISTRATION  
BOARDS

**JRW & ASSOCIATES**  
JOHN R. WATSON AR-1276  
STATE OF IDAHO

CONSULTANTS:

PROJECT:  
**IMPROVEMENTS FOR MENAN 1ST. & 2ND WARDS MENAN IDAHO STAKE**  
MENAN, IDAHO

DRAWING TITLE:  
**SITE PLAN**

PLOT DATE: 11/01/01  
PROJECT No. X  
PLOT SCALE: 1"=20'

DRAWN BY: RWS  
JOB NO.:

CHECKED BY: JRM  
SHEET NO. SD-1

DATE: OF:

24X



# GENERAL STRUCTURAL NOTES

## GENERAL REQUIREMENTS

### DRAWINGS

THESE DRAWINGS HAVE BEEN PREPARED USING STANDARDS OF PROFESSIONAL CARE AND COMPLETENESS NORMALLY EXERCISED UNDER SIMILAR CIRCUMSTANCES BY REPUTABLE STRUCTURAL ENGINEERS IN THIS OR SIMILAR LOCALITIES. THEY NECESSARILY ASSUME THAT THE WORK DEPICTED WILL BE PERFORMED BY AN EXPERIENCED CONTRACTOR AND/OR WORKERS WHO HAVE A WORKING KNOWLEDGE OF THE APPLICABLE CODE STANDARDS AND REQUIREMENTS AND OF INDUSTRY ACCEPTED STANDARD GOOD PRACTICE. AS NOT EVERY CONDITION OR ELEMENT IS (OR CAN BE) EXPLICITLY SHOWN ON THESE DRAWINGS, IT IS UNDERSTOOD THAT THE CONTRACTOR WILL USE INDUSTRY ACCEPTED STANDARD GOOD PRACTICE FOR ALL MISCELLANEOUS WORK NOT EXPLICITLY SHOWN.

### MISCELLANEOUS ITEMS

CALCULATION AND DESIGN OF MISCELLANEOUS NON-STRUCTURAL ITEMS, SUCH AS STAIRS, RAILINGS, NON-STRUCTURAL WALLS AND PREFABRICATED STRUCTURAL ITEMS, SUCH AS FLOOR AND ROOF TRUSSES, ARE NOT INCLUDED AND ARE TO BE PROVIDED BY OTHERS UNLESS SPECIFICALLY NOTED ON THESE DRAWINGS.

### CONSTRUCTION MEANS AND METHODS

THESE DRAWINGS REPRESENT THE FINISHED STRUCTURE. THEY DO NOT INDICATE THE METHOD OF CONSTRUCTION. THE CONTRACTOR SHALL BE SOLELY RESPONSIBLE FOR CONSTRUCTION MEANS, METHODS, TECHNIQUES, SEQUENCES AND PROCEDURES. IT SHALL BE THE CONTRACTOR'S RESPONSIBILITY TO DESIGN AND PROVIDE ADEQUATE SHORING, BRACING, FORM-WORK, ETC., AS REQUIRED FOR THE PROTECTION OF LIFE AND PROPERTY (INCLUDING UTILITIES) DURING CONSTRUCTION. CONSTRUCTION MATERIALS SHALL BE PLACED ON THE STRUCTURE SUCH THAT THE DESIGN LOADS AS STATED HEREIN ARE NOT EXCEEDED.

### DIMENSIONS, INSERTS AND OPENINGS

THE CONTRACTOR SHALL BE RESPONSIBLE FOR VERIFICATION OF ALL DIMENSIONS, CONDITIONS AND ELEVATIONS WITH ARCHITECTURAL DRAWINGS PRIOR TO START OF CONSTRUCTION. THE CONTRACTOR SHALL INFORM THE ARCHITECT IN WRITING OF ANY DISCREPANCIES OR OMISSIONS NOTED ON THE DRAWINGS. ANY SUCH DISCREPANCY, OMISSION, OR VARIATION NOT REPORTED BEFORE START OF CONSTRUCTION SHALL BE THE RESPONSIBILITY OF THE CONTRACTOR. WHERE DISCREPANCIES OCCUR IN THESE DRAWINGS, NOTES AND DETAILS ON DRAWINGS SHALL TAKE PRECEDENCE OVER GENERAL STRUCTURAL NOTES AND TYPICAL DETAILS.

CONTRACTOR SHALL ESTABLISH AND VERIFY ALL OPENINGS AND INSERTS FOR ARCHITECTURAL, MECHANICAL, PLUMBING AND ELECTRICAL WITH APPROPRIATE TRADES, DRAWINGS AND SUBCONTRACTORS PRIOR TO CONSTRUCTION.

### STANDARDS

WHERE REFERENCE IS MADE TO VARIOUS TEST STANDARDS FOR MATERIALS, SUCH STANDARDS SHALL BE THE EDITION REFERENCED IN THE GOVERNING BUILDING CODE.

### TYPICAL DETAILS AND NOTES

TYPICAL DETAILS AND NOTES SHALL APPLY, THOUGH NOT NECESSARILY INDICATED AT A SPECIFIC LOCATION ON PLANS. WHERE NO DETAILS ARE SHOWN, CONSTRUCTION SHALL CONFORM TO SIMILAR WORK ON THE PROJECT. DETAILS MAY SHOW ONLY ONE SIDE OF CONNECTION OR MAY OMIT INFORMATION FOR CLARITY.

### SHOP DRAWINGS

SHOP DRAWINGS SHALL BE SUBMITTED FOR ALL STRUCTURAL ITEMS. SHOP DRAWINGS ARE REVIEWED ONLY FOR GENERAL COMPLIANCE WITH THE STRUCTURAL DRAWINGS. REVIEW DOES NOT INDICATE THAT THE SHOP DRAWINGS ARE CORRECT OR COMPLETE. RESPONSIBILITY FOR CORRECTNESS SHALL REST WITH THE CONTRACTOR. ANY CHANGES, SUBSTITUTIONS, OR DEVIATIONS FROM CONTRACT DRAWINGS SHALL BE CLOUDED. ANY OF THE AFOREMENTIONED SHALL NOT BE CONSIDERED APPROVED AFTER ENGINEER'S REVIEW UNLESS SPECIFICALLY NOTED ACCORDINGLY. THE SHOP DRAWINGS DO NOT SUPERSEDE OR REPLACE THE ORIGINAL CONTRACT DRAWINGS. ANY ENGINEERING PROVIDED BY OTHERS AND SUBMITTED FOR REVIEW SHALL BEAR THE SEAL OF AN APPROPRIATELY REGISTERED ENGINEER. ENGINEERING SYSTEM SOLUTIONS SHALL NOT BE RESPONSIBLE FOR THE ADEQUACY OF ENGINEERING DESIGNS PERFORMED BY OTHERS. FIVE WORKING DAYS SHALL BE ALLOWED FOR THE ENGINEER'S REVIEW. CONTRACTOR SHALL PROVIDE A COPY OF EACH SUBMITTAL FOR ENGINEERING SYSTEM SOLUTIONS RECORDS.

### MOLD

MOLD CONCERNS AND PREVENTION IS OUT OF ENGINEERING SYSTEM SOLUTIONS SCOPE OF SERVICES. ENGINEERING SYSTEM SOLUTIONS SHALL BE HELD HARMLESS, TO THE EXTENT OF THE LAW, FOR ALL MOLD PREVENTION AND MOLD RELATED CONCERNS.

### BASIS FOR DESIGN

GOVERNING BUILDING CODE: . . . . . 2012 IBC

### GRAVITY DESIGN

ROOF DEAD . . . . . 16 PSF  
ROOF SNOW LOAD . . . . . 33 PSF  
Is (SNOW LOAD IMPORTANCE FACTOR) . . . . . 1.1

### EXISTING CONDITIONS

DESIGN DOCUMENTS ARE BASED OFF OF INTERPRETED EXISTING CONDITIONS, FIELD OBSERVATIONS, AND/OR DOCUMENTS PROVIDED TO OUR OFFICE TO COMMUNICATE THE EXISTING CONDITIONS. IN THE EVENT THAT CONDITIONS DO NOT MATCH THOSE INDICATED ON THE STRUCTURAL DRAWINGS, ALL STRUCTURAL DESIGN SERVICES REQUIRED TO ENSURE THAT THE EXISTING ELEMENTS MATCH THE STRUCTURAL DOCUMENTS AND TO BRING THEM IN CONFORMANCE WITH THE CURRENT BUILDING CODE SHALL BE HANDLED AS AN ADDITIONAL SERVICE.

### STRUCTURAL OBSERVATIONS

STRUCTURAL OBSERVATIONS PERFORMED BY THE ENGINEER OF RECORD DO NOT CONSTITUTE INSPECTIONS AS DETERMINED BY THE BUILDING OFFICIAL.

STRUCTURAL OBSERVATIONS TO BE PERFORMED BY STRUCTURAL ENGINEER AT 90% COMPLETION OF PROJECT.

### CONTRACTOR RESPONSIBILITY

THE CONTRACTOR SHALL NOTIFY THE ENGINEER OF RECORD (3) WORKING DAYS PRIOR TO THE SPECIFIED STRUCTURAL OBSERVATION.

## WOOD

### GENERAL

SAWN FRAMING LUMBER SHALL COMPLY W/ THE LATEST EDITION OF THE GRADING RULES OF THE WESTERN WOOD PRODUCTS ASSOCIATION OR THE WEST COAST LUMBER INSPECTION BUREAU. ALL SAWN LUMBER SHALL BE STAMPED W/ THE GRADE MARK OF AN APPROVED LUMBER GRADING AGENCY. ALL LUMBER SHALL HAVE A MINIMUM SPECIFIC GRAVITY OF 0.50 UNLESS NOTED OTHERWISE. MOISTURE CONTENT AT TIME OF AND THROUGHOUT CONSTRUCTION SHALL NOT EXCEED 19%.

ALL WOOD IN CONTACT WITH CONCRETE SHALL BE PRESSURE TREATED, UNO.

DO NOT NOTCH OR DRILL JOISTS, BEAMS OR LOAD-BEARING STUDS W/O PRIOR APPROVAL OF THE STRUCTURAL ENGINEER.

FABRICATION AND HANDLING SHALL CONFORM W/ THE LATEST AITC AND ASTM STANDARDS.

ALL ENGINEERED WOOD PRODUCTS SHALL BE MANUFACTURED IN ACCORDANCE W/ ESR-1387 OR APPROVED EQUAL.

### SAWN LUMBER

SAWN LUMBER SHALL BE DOUGLAS FIR LARCH, NO. 2 GRADE (UNO).

### LAMINATED VENEER LUMBER (LVL)

LVL SHALL HAVE THE FOLLOWING MIN PROPERTIES:

Fb =2,600 PSI Fv = 285 PSI Fc (PERPENDICULAR) = 750 PSI  
Fc (PARALLEL) = 2310 PSI E = 1,900,000 PSI

### PARALLEL STRAND LUMBER (PSL)

PSL SHALL HAVE THE FOLLOWING MIN PROPERTIES:

Fb =2,900 PSI Fv = 290 PSI Fc (PERPENDICULAR) = 750 PSI  
Fc (PARALLEL) = 2900 PSI E = 2,000,000 PSI

### LAMINATED STRAND LUMBER (LSL)

LSL SHALL HAVE THE FOLLOWING MIN PROPERTIES:

Fb =1,700 PSI Fv = 400 PSI Fc (PERPENDICULAR) = 680 PSI  
Fc (PARALLEL) = 1400 PSI E = 1,300,000 PSI

### STRUCTURAL USE PANELS

STRUCTURAL-USE PANELS SHALL BE PERFORMANCE RATED BY THE AMERICAN PLYWOOD ASSOCIATION (APA). PANELS SHALL COMPLY WITH ICC REPORT NO. NER-108, EXPOSURE 1. INSTALL PER MANUFACTURER'S RECOMMENDATIONS. PLYWOOD SHALL BE FIVE-PLY SHEATHING LAY UP PLYWOOD WITH FACE GRAIN PERPENDICULAR TO SUPPORTS. PLYWOOD MAY BE ORIENTED PER SHEAR WALL SCHEDULE. ORIENTED STRAND BOARD (OSB) MAY BE USED AS AN ALTERNATE TO PLYWOOD. PROVIDE BLOCKING AT PANEL EDGES WHERE INDICATED ON PLANS. PANELS SHALL CONFORM TO THE FOLLOWING NOMINAL THICKNESS, SPAN RATING AND NAILING PATTERN UNLESS NOTED OTHERWISE:

THICKNESS	GRADE/MATERIALS	USE	SPAN RATING	BOUNDARY/ EDGE NAILING	FIELD NAILING
7/16"	RTD SHTG	WALLS/ROOF	24/16	8d AT 6" O.C.	8d AT 12" O.C.
15/32"	RTD SHTG	WALLS/ROOF	32/16	8d AT 6" O.C.	8d AT 12" O.C.
1/2"	RTD SHTG	WALLS/ROOF	32/16	8d AT 6" O.C.	8d AT 12" O.C.
19/32"	RTD SHTG	ROOF	40/20	10d AT 6" O.C.	10d AT 12" O.C.
5/8"	RTD SHTG	ROOF	40/20	10d AT 6" O.C.	10d AT 12" O.C.
3/4"	RTD SHTG	ROOF	48/24	10d AT 6" O.C.	10d AT 12" O.C.
3/4" T&G	RTD SHTG	FLOOR	48/24	10d AT 6" O.C.	10d AT 12" O.C.
7/8" T&G	RTD SHTG	FLOOR	60/32	10d AT 6" O.C.	10d AT 12" O.C.
1 1/8" T&G	RTD SHTG	FLOOR	60/32	10d AT 6" O.C.	10d AT 12" O.C.

### PANEL EDGE SUPPORT

PROVIDE ONE PANEL CLIP BETWEEN SUPPORTS SPACED GREATER THAN 16" O.C. AND TWO PANEL CLIPS BETWEEN SUPPORTS SPACED GREATER THAN 32" O.C. AS AN ALTERNATIVE, T&G MAY BE USED OR UNSUPPORTED PANEL EDGES MAY BE BLOCKED W/ 2x FLAT BLKG.

### PREFABRICATED PLYWOOD WEB HOIST

PREFABRICATED PLYWOOD WEB 1-JOIST/PURLINS SHALL BE DESIGNED, FABRICATED AND ERECTED IN ACCORDANCE W/ THE LATEST EDITION OF ESR-1153 OR APPROVED EQUAL.

CONNECTIONS AND BEARING MATERIAL SHALL BE DESIGNED AND FURNISHED BY JOIST MANUFACTURER.

ADDITIONAL MEMBERS SHALL BE SUPPLIED AS REQUIRED TO SUPPORT MECHANICAL EQUIPMENT.

WHERE BRIDGING INTERFERES W/ MECH OR OTHER INSTALLATIONS, REMOVE BRIDGING AFTER DECK IS IN PLACE AND REPLACE W/ ADDITIONAL MFR SUPPLIED HORIZ STRUT BRACING AT TOP AND BOTTOM CHORDS.

PROVIDE 2" (NOMINAL) SOLID BLOCKING BETWEEN JOISTS AT SUPPORTS. JOIST HANGERS AND OTHER MISCELLANEOUS FRAMING ANCHORS SHALL BE AS MANUFACTURED BY SIMPSON STRONG-TIE CO., INC., OR EQUIVALENT W/ CURRENT ICC APPROVAL.

### NAILS

ALL NAILS, EXCEPT 16d, SHALL BE COMMON WIRE NAILS UNO. 16d NAILS MAY BE SINKERS OR BOX UNO ON PLANS OR SCHEDULES. NAILS SHALL BE DRIVEN SO THAT HEADS ARE FLUSH W/ WOOD SURFACE. OVER OR UNDER DRIVEN NAILS ARE NOT ACCEPTABLE.

NAIL SIZE	SHANK DIA	LENGTH
16d	0.135" MIN	3 1/4" (MIN)
10d	0.148"	3"
8d	0.131"	2 1/2"

### BOLTS AND LAG SCREWS

ALL BOLTS SHALL BE INSTALLED IN HOLES BORED W/ A BIT 1/16 INCH LARGER THAN THE DIAMETER OF THE BOLT.

CUT WASHERS SHALL BE PLACED UNDER BOLT HEADS AND NUTS. SPOIL THREADS TO PREVENT LOOSENING.

LAG BOLTS SHALL BE INSTALLED IN PRE-DRILLED HOLES 40% TO 70% OF THE DIA OF THE LAG SCREW AND INSTALLED BY TURNING W/ A WRENCH.

### ANCHORS

FRAMING ANCHORS, HANGERS AND OTHER MISC HARDWARE SPECIFIED ON PLANS SHALL BE AS MANUFACTURED BY SIMPSON STRONG-TIE CO., INC., OR EQUIVALENT W/ CURRENT ICC APPROVAL.

WHERE METAL CONNECTORS, ANCHORS, FASTENERS, ETC., ARE INSTALLED IN OR EXPOSED TO POTENTIALLY CORROSIVE ENVIRONMENTS OR MATERIALS. (I.E. PRESSURE TREATED WOOD, FIRE RETARDANTS, DISSIMILAR METALS, ETC.), APPROPRIATE MEASURES SHALL BE TAKEN (I.E. USE OF CORROSIVE RESISTANT METAL, PROPER APPLICATION OF ADEQUATE PROTECTIVE COATING, ETC.) IN ORDER TO PROTECT THE HARDWARE AGAINST DAMAGE THAT MAY ADVERSELY AFFECT ITS LOAD CARRYING CAPACITY. REFER TO MFR FOR SPECIFIC APPLICATION, LIMITATIONS, OR ADDITIONAL REQUIREMENTS.

## STANDARD ABBREVIATIONS

AB	ANCHOR BOLT
ACI	AMERICAN CONCRETE INSTITUTE
ADOL	ADDITIONAL
AISC	AMERICAN INSTITUTE OF STEEL CONSTRUCTION
ASI	AMERICAN IRON AND STEEL INSTITUTE
AITC	AMERICAN INSTITUTE OF TIMBER CONSTRUCTION
ALT	ALTERNATE
APA	AMERICAN PLYWOOD ASSOCIATION
ARCH	ARCHITECTURAL
ASD	ALLOWABLE STRESS DESIGN
ASTM	AMERICAN SOCIETY FOR TESTING AND MATERIALS
BLDG	BUILDING
BLDG	BLOCKING
BN	BOUNDARY NAILING OR FASTENERS
BOF	BOTTOM OF FOOTING
BOS	BOTTOM OF STEEL
BOT	BOTTOM
CEC	CALIFORNIA BUILDING CODE
¢	CENTER LINE
CLR	CLEAR
CMU	CONCRETE MASONRY UNIT
COL	COLUMN
CONC	CONCRETE
CONT	CONTIGUOUS
CRSI	CONCRETE REINFORCING STEEL INSTITUTE
DBA	DEFORMED BAR ANCHOR
DEL	DOUBLE
DEMO	DEMOLITION
DA OR #	DIAMETER
DAG	DIRECTIONAL
DM	DIMENSION
DWG	DRAWING
(E)	EXISTING
EA	EACH
ELEV	ELEVATION
EN	EDGE NAILING
ESR	QUALIFICATION SERVICES REPORT
EQ	EQUAL
EQUIP	EQUIPMENT
FF	FINISH FLOOR
FDN	FOUNDATION
FT	FOOT
FTC	FOOTING
GA	GAGE
GALV	CALVANIZED
GSN	GENERAL STRUCTURAL NOTES
GT	GRID TRUSS
H	HIGH
HORIZ	HORIZONTAL
HSS	HOLLOW STRUCTURAL SHAPE
HT	HEIGHT
IBC	INTERNATIONAL BUILDING CODE
INFO	INFORMATION
ICC	INTERNATIONAL CODE COUNCIL
K	KIP (1,000 LBS.)
KLF	KIPS PER LINEAR FOOT
KSF	KIPS PER SQUARE FOOT
KSI	KIPS PER SQUARE INCH
LL	DOUBLE ANGLE
LLH	LONG LEG HORIZONTAL
LLV	LONG LEG VERTICAL
LD	LOW
LONG	LONGITUDINAL
LRFD	LOAD AND RESISTANCE FACTOR DESIGN
LT	LIGHT
MAX	MAXIMUM
MECH	MECHANICAL
MEF	MANUFACTURED
MFR	MANUFACTURER
MIN	MINIMUM
MISC	MISCELLANEOUS
NIS	NOT TO SCALE
O.C.	ON CENTER
OPP	OPPOSITE HAND
PL	PLATE
PLF	POUNDS PER LINEAR FOOT
PREFAB	PREFABRICATION
PRELIM	PRELIMINARY
PSF	POUNDS PER SQUARE FOOT
PSI	POUNDS PER SQUARE INCH
RENF	REINFORCING
REO'D	REQUIRED
RME	ROOF MOUNTED EQUIPMENT
SCHED	SCHEDULE
SHTC	SHEATHING
SM	SIMILAR
SPEC	SPECIFICATION
SSMA	STEEL STUD MANUFACTURERS ASSOCIATION
STD	STANDARD
STL	STEEL
T&B	TOP AND BOTTOM
T&G	TONGUE AND GROOVE
T O	TOP OF
TRANS	TRANSVERSE
TYP	TYPICAL
UNO	UNLESS NOTED OTHERWISE
VERT	VERTICAL
W/	WITH
W/O	WITHOUT
WT	WEIGHT
WVF	WELDED WIRE FABRIC

## SHEET INDEX

SHEET NO.	SHEET TITLE	REVISION
S0.1	GENERAL STRUCTURAL NOTES	
S1.1	ROOF FRAMING PLAN	
S2.1	TRUSS DETAILS AND TRUSS PROFILE	
S2.2	TRUSS PROFILES	


## RECORD DRAWING

DATE: FEB 20, 2015

THESE RECORD DRAWINGS HAVE BEEN PREPARED BASED ON INFORMATION PROVIDED BY OTHERS. THE DESIGN PROFESSIONAL HAS NOT VERIFIED THE ACCURACY AND/OR COMPLETENESS OF THIS INFORMATION AND SHALL NOT BE RESPONSIBLE FOR ANY ERRORS OR OMISSIONS WHICH MAY BE INCORPORATED HEREIN AS A RESULT.

SEAL:

ENGINEERING SYSTEM SOLUTIONS  
4945 NORTH 29TH EAST, STE A  
IDAHO FALLS, IDAHO 83401  
Phone: (208) 552-9874  
Fax: (208) 552-9302  
www.es2eng.com

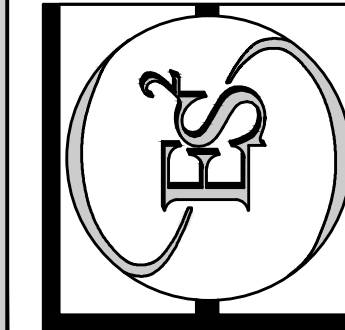

STRUCTURAL • MEP • BUILDING COMMISSIONING

PROJECT: ROOF TRUSS IMPROVEMENTS FOR:

**MENAN 2, 5 (SP)**

MENAN, ID

PROPERTY #: 507-2638

SHEET TITLE:

RECORD DRAWINGS	DATE
	2/19/15
DESCRIPTION	
REV.	

DRAWN: GTC | CHECKED: DBP

DATE: AUGUST 27, 2014  
PROJECT NUMBER: 14.2015.02  
SHEET NUMBER:

**S0.1**



THESE PLANS, DRAWINGS AND FIGURES ARE THE EXCLUSIVE PROPERTY OF ENGINEERING SYSTEM SOLUTIONS, AND SHALL NOT BE REPRODUCED OR TRANSMITTED IN ANY FORM OR BY ANY MEANS, ELECTRONIC OR MECHANICAL, INCLUDING PHOTOCOPYING, RECORDING, OR BY ANY INFORMATION STORAGE AND RETRIEVAL SYSTEM, WITHOUT THE WRITTEN CONSENT OF ENGINEERING SYSTEM SOLUTIONS. ALL RIGHTS ARE RESERVED. COPYRIGHT © 2015 ENGINEERING SYSTEM SOLUTIONS.

**FRAMING PLAN NOTES**

**FRAMING:**

- A. [---] INDICATES EXISTING WALLS, SEE PLAN FOR LOCATIONS.
- B. (E) INDICATES EXISTING STRUCTURE.

**MISC:**

- A. CONTRACTOR TO FIELD VERIFY DIMENSIONS AND STRUCTURAL ELEMENT LOCATIONS. SHOULD EXISTING CONDITIONS VARY FROM THE PLANS, NOTIFY THE ENGINEER.


- B. AT LOCATIONS THAT REQUIRE REMOVAL OF EXISTING ROOF SHEATHING TO PERFORM REPAIRS, REFER TO DETAIL B/S1.1 FOR SHEATHING REPLACEMENT.

- C. GUSSETS MAY BE DOUBLED ON ONE SIDE OF TRUSS WHERE EXISTING CONDITIONS PREVENT ATTACHMENT TO EACH SIDE, MAINTAIN TOTAL NUMBER OF REQUIRED NAILS FOR BOTH GUSSET AND PROVIDE BLOCKING BEHIND GUSSET WHERE GAP EXCEEDS 1/4".


**KEYNOTES:**

- ① REINFORCE OVERBUILD PER DETAIL A/S1.1 (BELOW).


AS BUILT

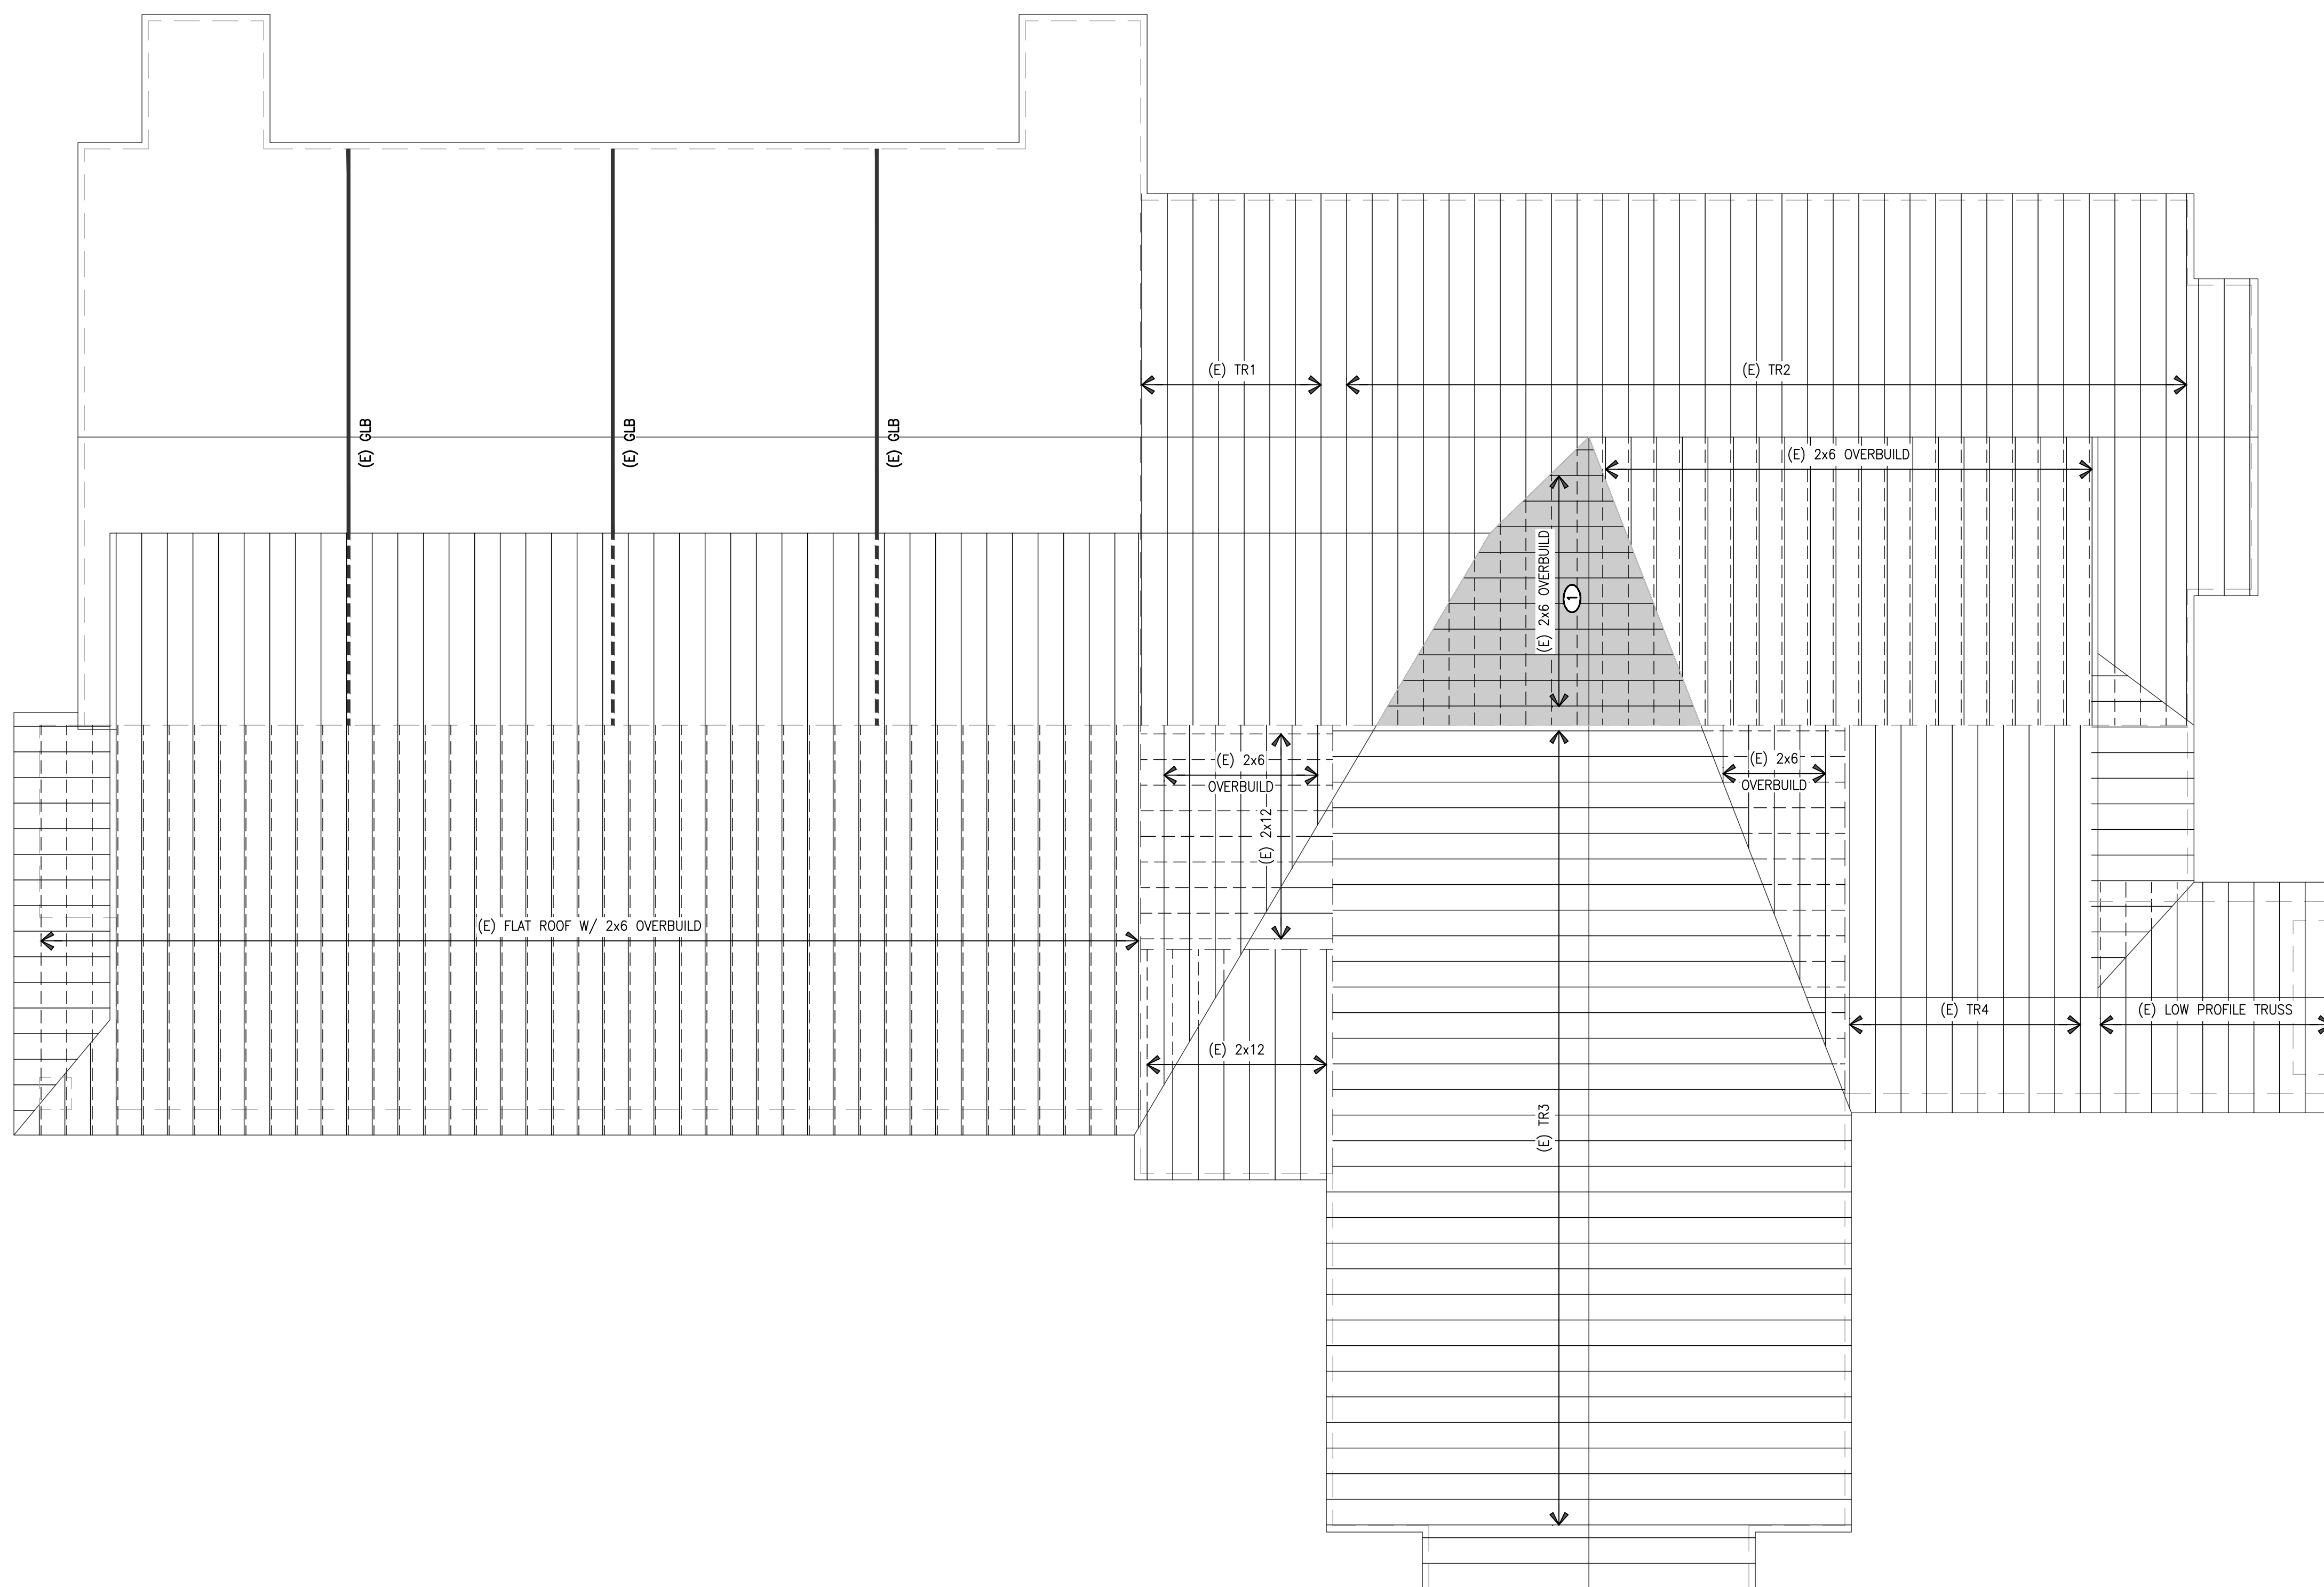

**ROOF FRAMING PLAN** SCALE: 1/8"=1'-0"

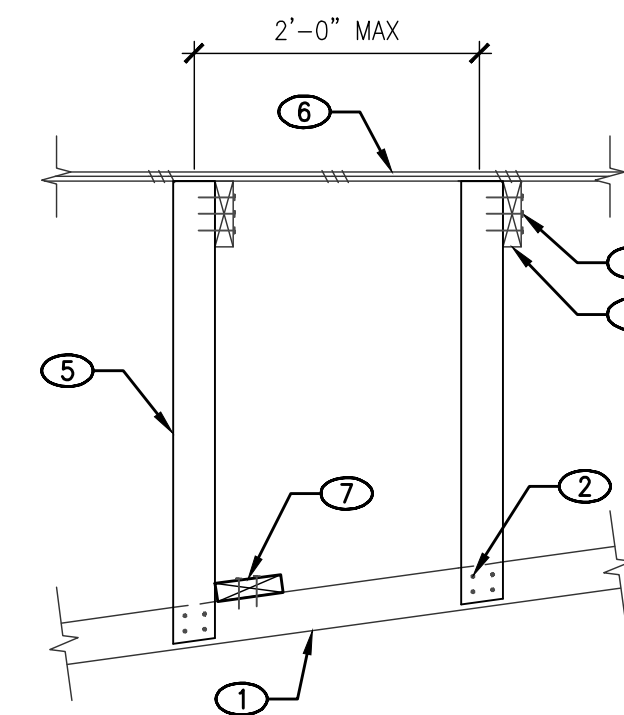


**OVERBUILD FRAMING PERPENDICULAR TO ROOF FRAMING**

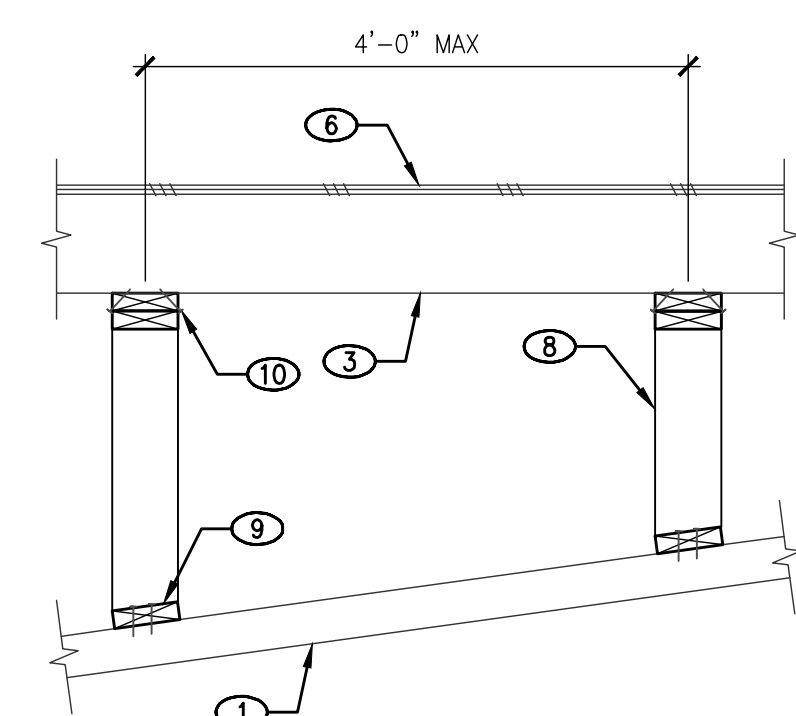


**OVERBUILD FRAMING PARALLEL TO ROOF FRAMING**

**A TYPICAL OVERBUILD RAFTER SUPPORT**  
S1.1 NO SCALE

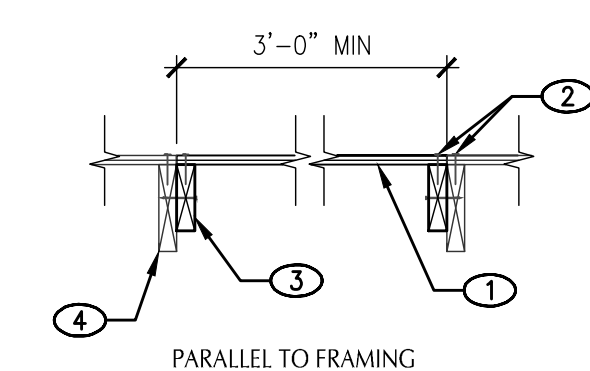

**PARALLEL TO FRAMING**

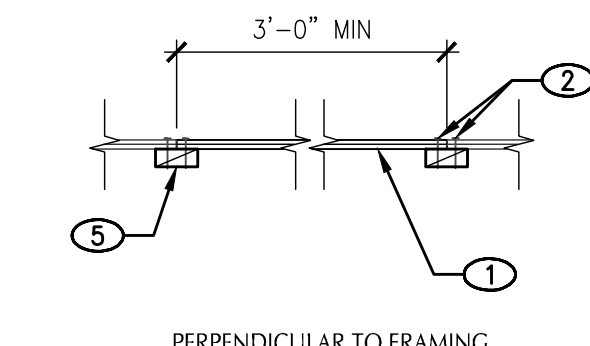

**PERPENDICULAR TO FRAMING**

**B TYPICAL DIAPHRAGM REPLACEMENT DETAIL**  
S1.1 NO SCALE

**KEYNOTES:**

1. EXISTING LOWER FRAMING MEMBER
2. (4) 16d NAILS, TYP
3. EXISTING OVERBUILD RAFTER
4. ATTACH OVERBUILD RAFTER TO 2x6 W/ (3) 16d NAILS
5. PROVIDE VERTICAL 2x6 AT 24" O.C., EACH WAY
6. EXISTING ROOF SHEATHING
7. PROVIDE 2x BRACE AT 4'-0" O.C. W/ (2) 16d NAILS AT EACH TRUSS
8. PROVIDE WALLS AT 4'-0" O.C., W/ 2x6 AT 24" O.C. (MAX), ALIGN W/ LOWER FRAMING
9. (2) 16d NAILS AT EACH TRUSS MEMBER
10. (2) 16d TOE NAILS AT EACH TRUSS MEMBER

**KEYNOTES:**


1. MATCH (E) ROOF SHEATHING
2. EDGE NAILING 8d NAILS AT 4" O.C.
3. CONT 2X6 BLOCKING, SISTER TO (E) JOIST W/ 16d NAILS AT 6" O.C.
4. (E) ROOF JOIST
5. 2x BLOCKING BETWEEN JOISTS AS REQUIRED

**RECORD DRAWING**

DATE: FEB 20, 2015

THESE RECORD DRAWINGS HAVE BEEN PREPARED BASED ON INFORMATION PROVIDED BY OTHERS. THE DESIGN PROFESSIONAL HAS NOT VERIFIED THE ACCURACY AND/OR COMPLETENESS OF THIS INFORMATION AND SHALL NOT BE RESPONSIBLE FOR ANY ERRORS OR OMISSIONS WHICH MAY BE INCORPORATED HEREIN AS A RESULT.

ENGINEERING SYSTEM SOLUTIONS  
 4943 NORTH 29TH EAST, STE A  
 IDAHO FALLS, IDAHO 83401  
 Phone: (208) 552-9874  
 Fax: (208) 552-9302  
 www.es2eng.com

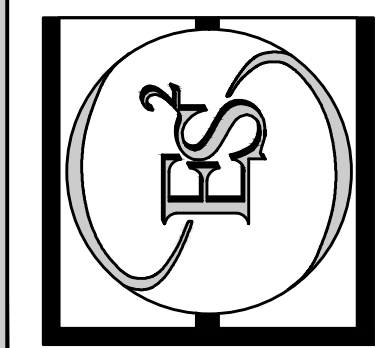

STRUCTURAL • MEP • BUILDING COMMISSIONING

**ROOF TRUSS IMPROVEMENTS FOR:**  
**MENAN 2, 5 (SP)**  
 MENAN, ID  
 PROPERTY #: 507-2638

**ROOF FRAMING PLAN**

PROJECT: SHEET TITLE:


REV.	DESCRIPTION	DATE
	RECORD DRAWINGS	2/19/15

DRAWN: GTC CHECKED: DBP

DATE: AUGUST 27, 2014  
PROJECT NUMBER: 14.2015.02  
SHEET NUMBER:

**S1.1**

THESE DRAWINGS AND FIGURES ARE THE EXCLUSIVE PROPERTY OF ENGINEERING SYSTEM SOLUTIONS, AND SHALL NOT BE REPRODUCED OR NOT FORN WITHOUT WRITTEN CONSENT. ALL RIGHTS ARE RESERVED. COPYRIGHT © ENGINEERING SYSTEM SOLUTIONS, 2015.

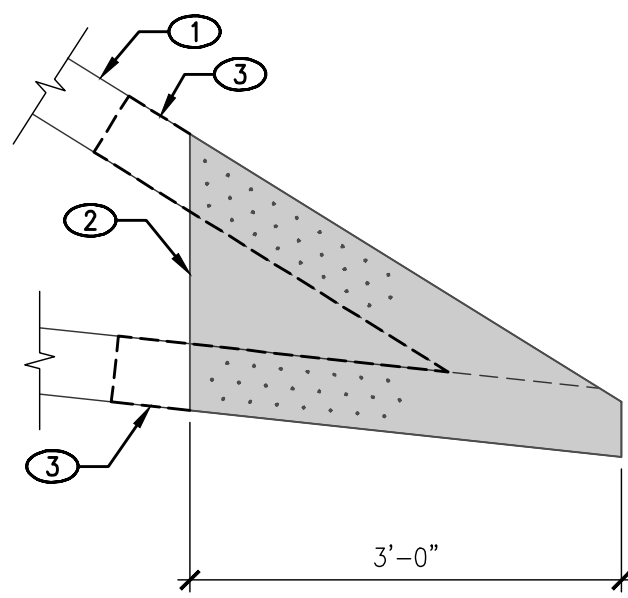


5 TRUSS UPGRADE CONNECTION  
S2.1 NO SCALE

KEYNOTES:

- EXISTING TRUSS
- 5/8" PLYWOOD GUSSET EA SIDE W/ (26) 8d NAILS INTO TOP CHORD, (22) 8d NAILS INTO BOTTOM CHORD, AS SHOWN AND (2) 3/8" BEADS OF CONSTRUCTION ADHESIVE AT EACH TRUSS MEMBER
- BLOCKING PER NOTE A.

NOTES:

- AS REQ'D ADD 2x BLOCKING SHAPE TO FIT TIGHT TO TRUSS WEB MEMBERS. GLUE EACH BLOCK WITH (2) 3/8" BEADS OF CONSTRUCTION ADHESIVE BETWEEN BLOCK AND TRUSS WEB. EXTEND BLOCK 6" PAST GUSSETS. NAIL WITH (6) 10d COMMON NAILS
- THICKER BLOCKING WILL BE REQUIRED TO ENSURE SOLID WOOD BETWEEN TRUSS MEMBERS AND GUSSET PLATE ON EACH SIDE
- 1" ROUND HOLES MAY BE DRILLED THROUGH PLYWOOD GUSSETS AT EXISTING BOLTS

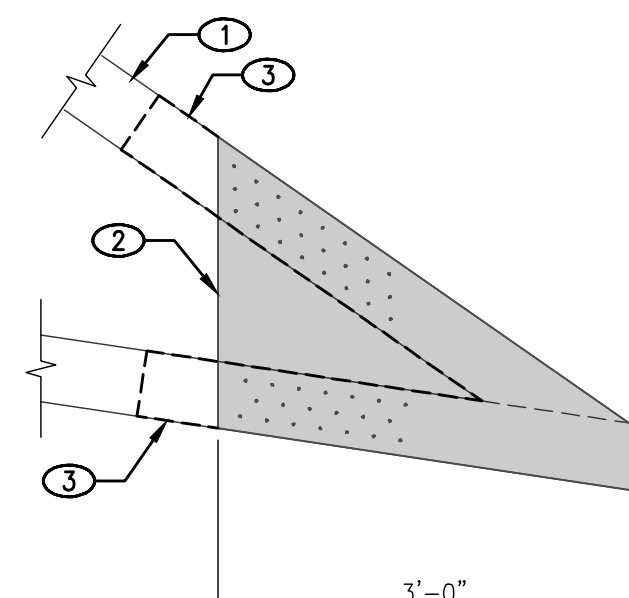


3 TRUSS UPGRADE CONNECTION  
S2.1 NO SCALE

KEYNOTES:

- EXISTING TRUSS
- 5/8" PLYWOOD GUSSET EA SIDE W/ (24) 8d NAILS INTO TOP CHORD, (20) 8d NAILS INTO BOTTOM CHORD, AS SHOWN AND (2) 3/8" BEADS OF CONSTRUCTION ADHESIVE AT EACH TRUSS MEMBER
- BLOCKING PER NOTE A.

NOTES:

- AS REQ'D ADD 2x BLOCKING SHAPE TO FIT TIGHT TO TRUSS WEB MEMBERS. GLUE EACH BLOCK WITH (2) 3/8" BEADS OF CONSTRUCTION ADHESIVE BETWEEN BLOCK AND TRUSS WEB. EXTEND BLOCK 6" PAST GUSSETS. NAIL WITH (6) 10d COMMON NAILS
- THICKER BLOCKING WILL BE REQUIRED TO ENSURE SOLID WOOD BETWEEN TRUSS MEMBERS AND GUSSET PLATE ON EACH SIDE
- 1" ROUND HOLES MAY BE DRILLED THROUGH PLYWOOD GUSSETS AT EXISTING BOLTS

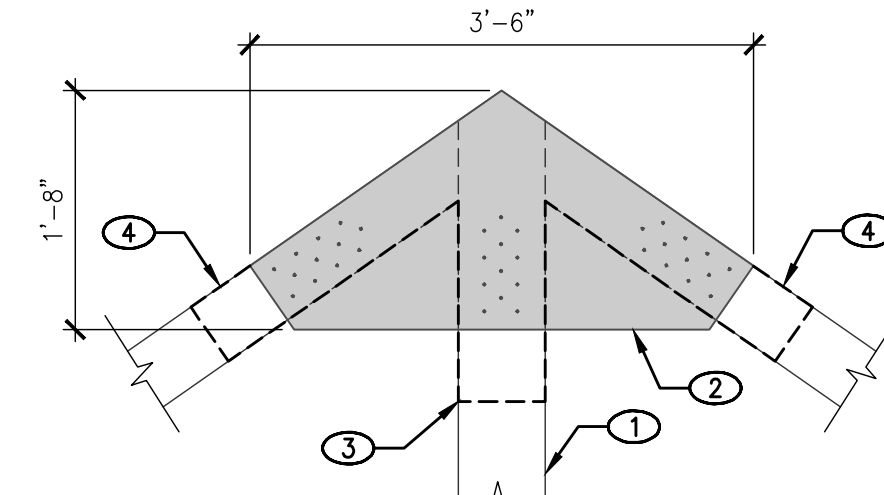


1 TRUSS UPGRADE CONNECTION  
S2.1 NO SCALE

KEYNOTES:


- EXISTING TRUSS
- 5/8" PLYWOOD GUSSET EA SIDE OVER EXISTING GUSSET W/ 10d NAILS (12) AT WEB MEMBERS AND (12) AT CHORD MEMBERS AS SHOWN W/ (2) 3/8" BEADS OF CONSTRUCTION ADHESIVE AT EACH TRUSS MEMBER
- BLOCKING AS REQUIRED TO FILL GAP BETWEEN TRUSS MEMBERS AND GUSSET PLATE
- BLOCKING PER NOTE A.

NOTES:

- AS REQ'D ADD 2x BLOCKING SHAPE TO FIT TIGHT TO TRUSS WEB MEMBERS. GLUE EACH BLOCK WITH (2) 3/8" BEADS OF CONSTRUCTION ADHESIVE BETWEEN BLOCK AND TRUSS WEB. EXTEND BLOCK 6" PAST GUSSETS. NAIL WITH (6) 10d COMMON NAILS
- THICKER BLOCKING WILL BE REQUIRED TO ENSURE SOLID WOOD BETWEEN TRUSS MEMBERS AND GUSSET PLATE ON EACH SIDE

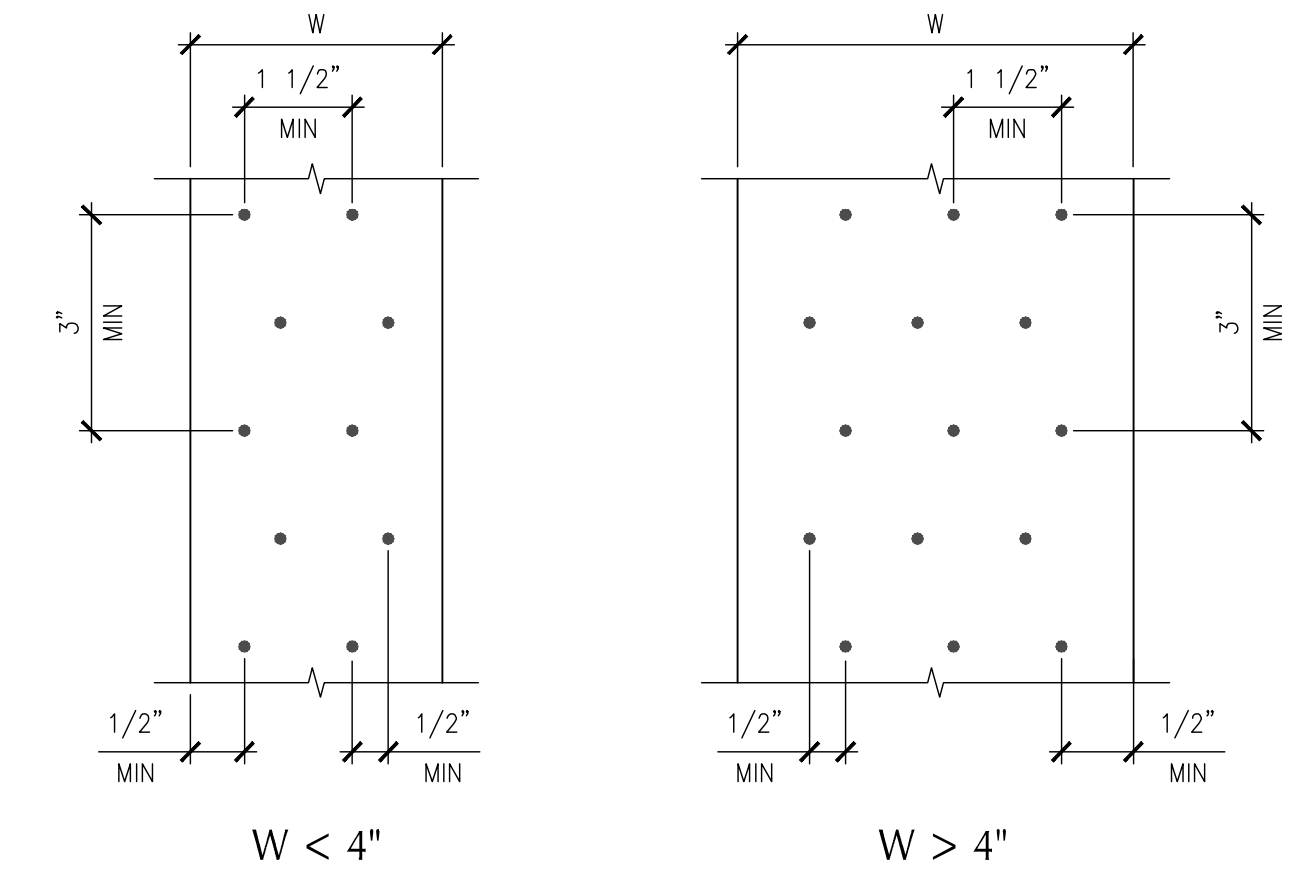

A TYPICAL NAILING PATTERN  
S2.1 NO SCALE

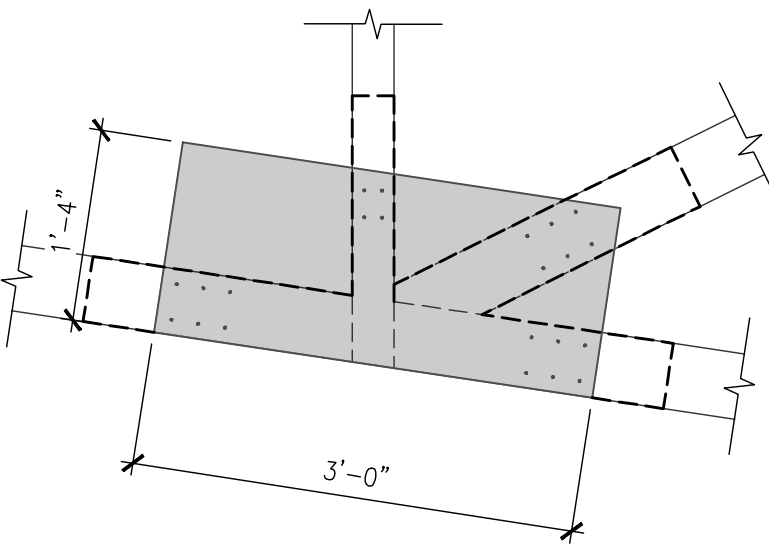


4 TRUSS UPGRADE CONNECTION  
S2.1 NO SCALE

KEYNOTES:

- EXISTING TRUSS
- 5/8" PLYWOOD GUSSET EA SIDE W/ 8d NAILS, (4) AT 2x4 WEB MEMBERS, (6) AT 2x6 WEB MEMBERS AND (6) AT CHORD MEMBERS AS SHOWN W/ (2) 3/8" BEADS OF CONSTRUCTION ADHESIVE AT EACH TRUSS MEMBER
- BLOCKING BEHIND MEMBER AS REQUIRED TO FILL GAP BETWEEN TRUSS MEMBERS AND GUSSET
- BLOCKING AS REQUIRED TO FILL GAP BETWEEN TRUSS MEMBERS AND GUSSET PLATE
- BLOCKING PER NOTE A.

NOTES:

- AS REQ'D ADD 2x BLOCKING SHAPE TO FIT TIGHT TO TRUSS WEB MEMBERS. GLUE EACH BLOCK WITH (2) 3/8" BEADS OF CONSTRUCTION ADHESIVE BETWEEN BLOCK AND TRUSS WEB. EXTEND BLOCK 6" PAST GUSSETS. NAIL WITH (6) 10d COMMON NAILS.
- 1" ROUND HOLES MAY BE DRILLED THROUGH PLYWOOD GUSSETS AT EXISTING BOLTS

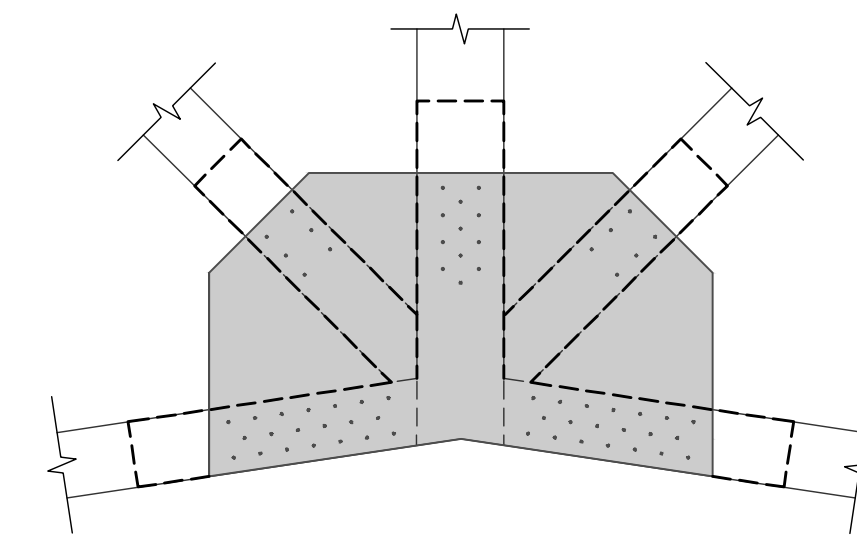


2 TRUSS UPGRADE CONNECTION  
S2.1 NO SCALE

KEYNOTES:

- EXISTING TRUSS
- 5/8" PLYWOOD GUSSET EA SIDE W/ 8d NAILS, (12) AT 2x8 WEB MEMBERS, (6) AT 2x6 WEB MEMBERS AND (20) AT CHORD MEMBERS AS SHOWN W/ (2) 3/8" BEADS OF CONSTRUCTION ADHESIVE AT EACH TRUSS MEMBER
- BLOCKING BEHIND MEMBER AS REQUIRED TO FILL GAP BETWEEN TRUSS MEMBERS AND GUSSET
- BLOCKING AS REQUIRED TO FILL GAP BETWEEN TRUSS MEMBERS AND GUSSET PLATE
- BLOCKING PER NOTE A.

NOTES:

- AS REQ'D ADD 2x BLOCKING SHAPE TO FIT TIGHT TO TRUSS WEB MEMBERS. GLUE EACH BLOCK WITH (2) 3/8" BEADS OF CONSTRUCTION ADHESIVE BETWEEN BLOCK AND TRUSS WEB. EXTEND BLOCK 6" PAST GUSSETS. NAIL WITH (6) 10d COMMON NAILS.
- 1" ROUND HOLES MAY BE DRILLED THROUGH PLYWOOD GUSSETS AT EXISTING BOLTS

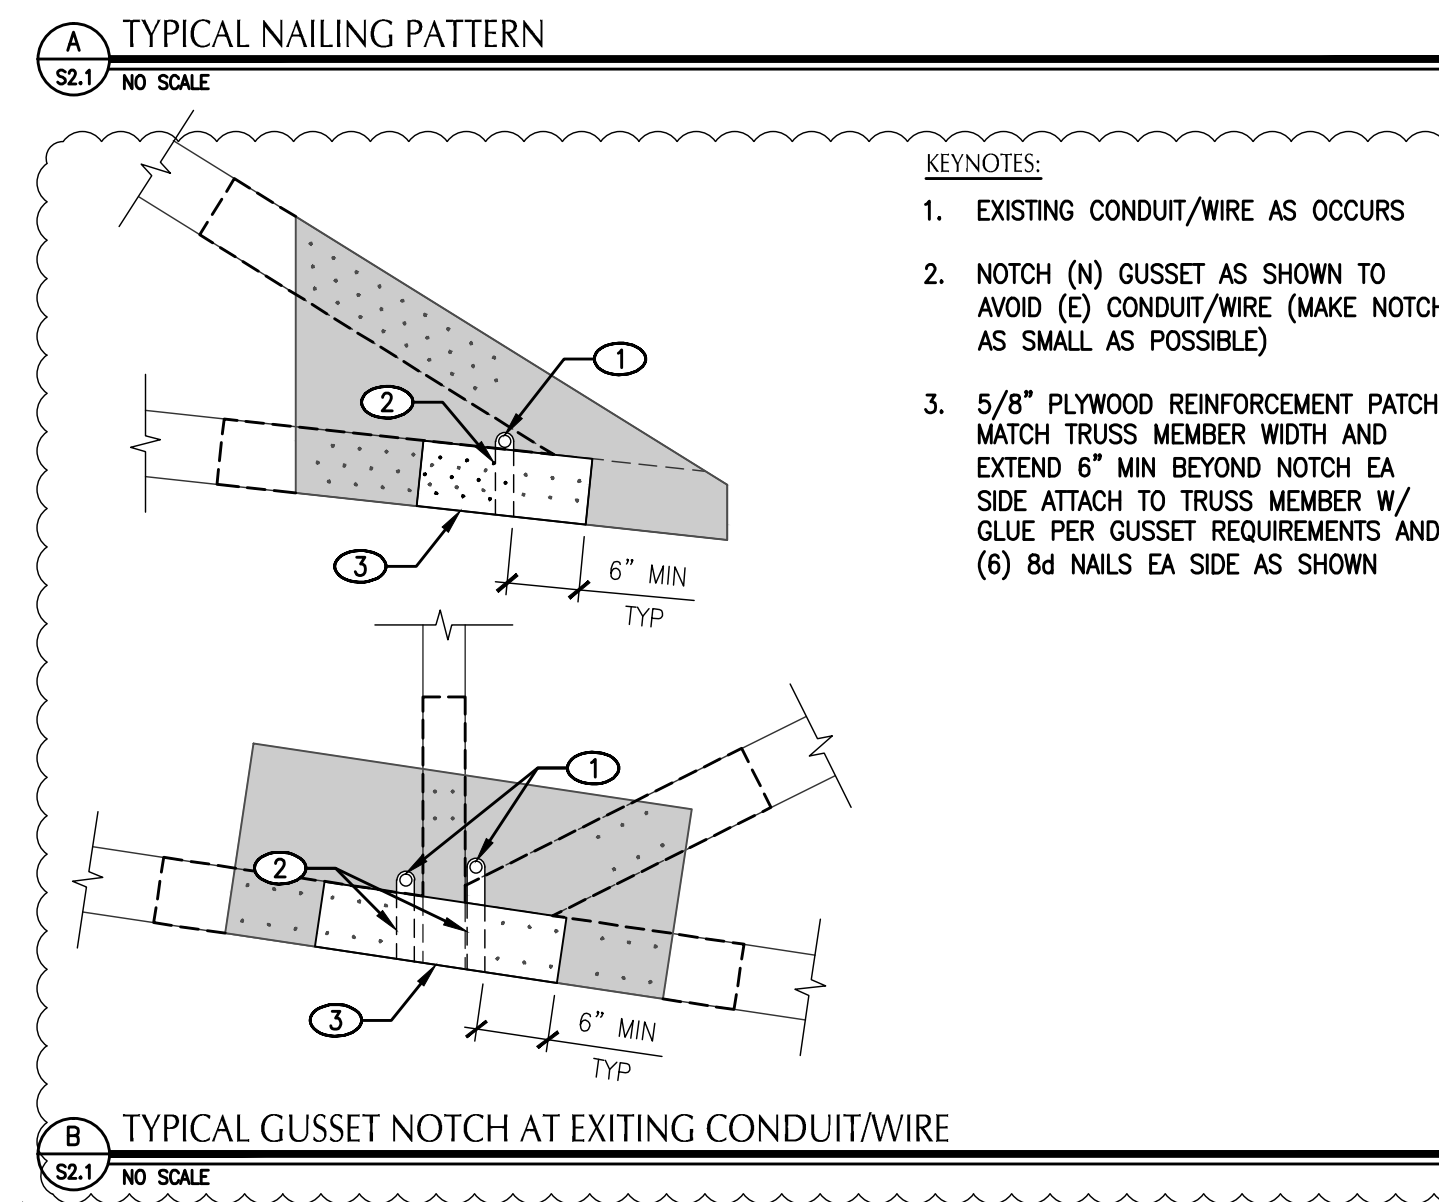

B TYPICAL GUSSET NOTCH AT EXITING CONDUIT/WIRE  
S2.1 NO SCALE

KEYNOTES:

- EXISTING CONDUIT/WIRE AS OCCURS
- NOTCH (N) GUSSET AS SHOWN TO AVOID (E) CONDUIT/WIRE (MAKE NOTCH AS SMALL AS POSSIBLE)
- 5/8" PLYWOOD REINFORCEMENT PATCH, MATCH TRUSS MEMBER WIDTH AND EXTEND 6" MIN BEYOND NOTCH EA SIDE ATTACH TO TRUSS MEMBER W/ GLUE PER GUSSET REQUIREMENTS AND (6) 8d NAILS EA SIDE AS SHOWN

KEYNOTES:


- EXISTING BOTTOM AND TOP CHORD
- EXISTING 2x4 WEB MEMBER
- EXISTING GUSSET, CONTRACTOR TO VERIFY (6) 8d NAILS MIN REQUIRED INTO EACH TRUSS CHORD AND (3) 8d NAILS MIN REQUIRED INTO EACH TRUSS WEB, EACH SIDE. ADD ADDITIONAL NAILS AS REQUIRED.
- EXISTING GUSSET, CONTRACTOR TO VERIFY (6) 8d NAILS MIN REQUIRED INTO EACH TRUSS MEMBER, EACH SIDE. ADD ADDITIONAL NAILS AS REQUIRED.
- 2x4 CONT AT MID SPAN OF COMPRESSION MEMBER W/ (2) 16d NAILS AT EA TRUSS

NOTES:

- BOTTOM CHORD MUST BE CONTINUOUS THROUGH GUSSET PLATE CONNECTIONS
- SITE MEASUREMENTS AND FIELD CONDITIONS NEED TO BE VERIFIED BY CONTRACTOR BEFORE FABRICATION OF PARTS
- ALL NEW NAILING SHALL CONFORM TO THE "TYPICAL NAILING PATTERN" DETAIL

RECORD DRAWING  
DATE: FEB 20, 2015


THESE RECORD DRAWINGS HAVE BEEN PREPARED BASED ON INFORMATION PROVIDED BY OTHERS. THE DESIGN PROFESSIONAL HAS NOT VERIFIED THE ACCURACY AND/OR COMPLETENESS OF THIS INFORMATION AND SHALL NOT BE RESPONSIBLE FOR ANY ERRORS OR OMISSIONS WHICH MAY BE INCORPORATED HEREIN AS A RESULT.

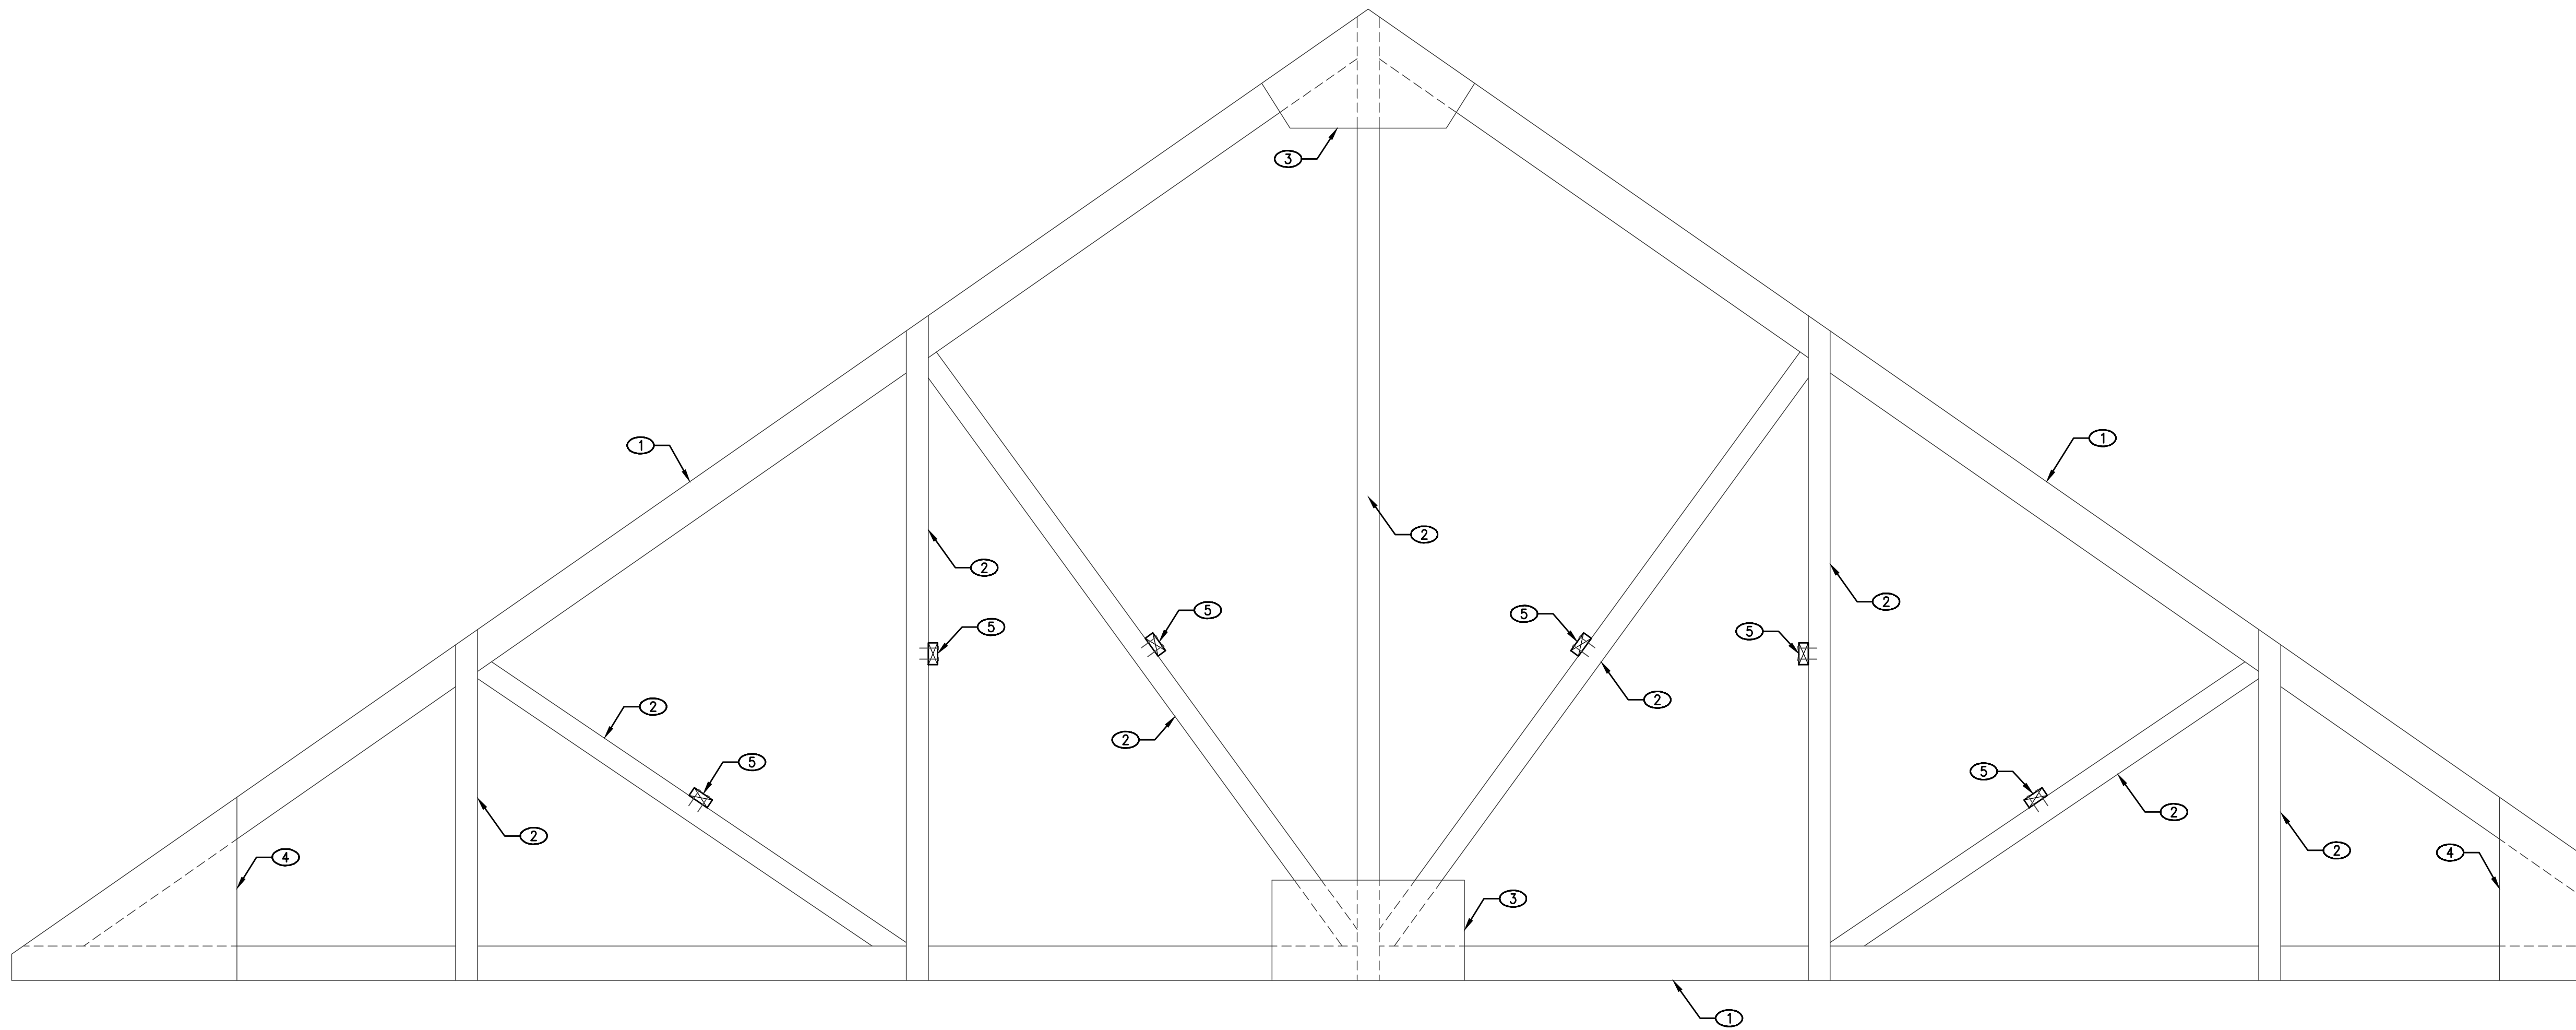

A TR1 PROFILE  
S2.1 NO SCALE

SEAL:

ENGINEERING SYSTEM SOLUTIONS  
4945 NORTH 29TH EAST, SITE A  
IDAHO FALLS, IDAHO 83401  
Phone: (208) 552-9874  
Fax: (208) 552-9302  
www.es2eng.com

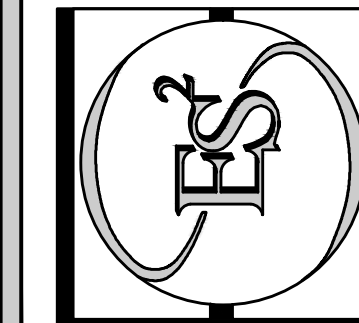

STRUCTURAL • MEP • BUILDING COMMISSIONING

PROJECT: ROOF TRUSS IMPROVEMENTS FOR:

MENAN 2, 5 (SP)

MENAN, ID

PROPERTY #: 507-2638

SHEET TITLE: TRUSS DETAILS AND TRUSS PROFILE

PROJECT:

REV.	DESCRIPTION	DATE
	RECORD DRAWINGS <td>2/19/15 </td>	2/19/15


DRAWN: GTC | CHECKED: DBP

DATE: AUGUST 27, 2014  
PROJECT NUMBER: 14.2015.02  
SHEET NUMBER:

S2.1



THESE PLANS, DRAWINGS AND FIGURES ARE THE SOLE PROPERTY OF ENGINEERING SYSTEM SOLUTIONS, AND SHALL NOT BE REPRODUCED IN ANY FORM WITHOUT WRITTEN CONSENT. ALL RIGHTS ARE RESERVED. COPYRIGHT © ENGINEERING SYSTEM SOLUTIONS. PRINTED: FEB 24, 2015

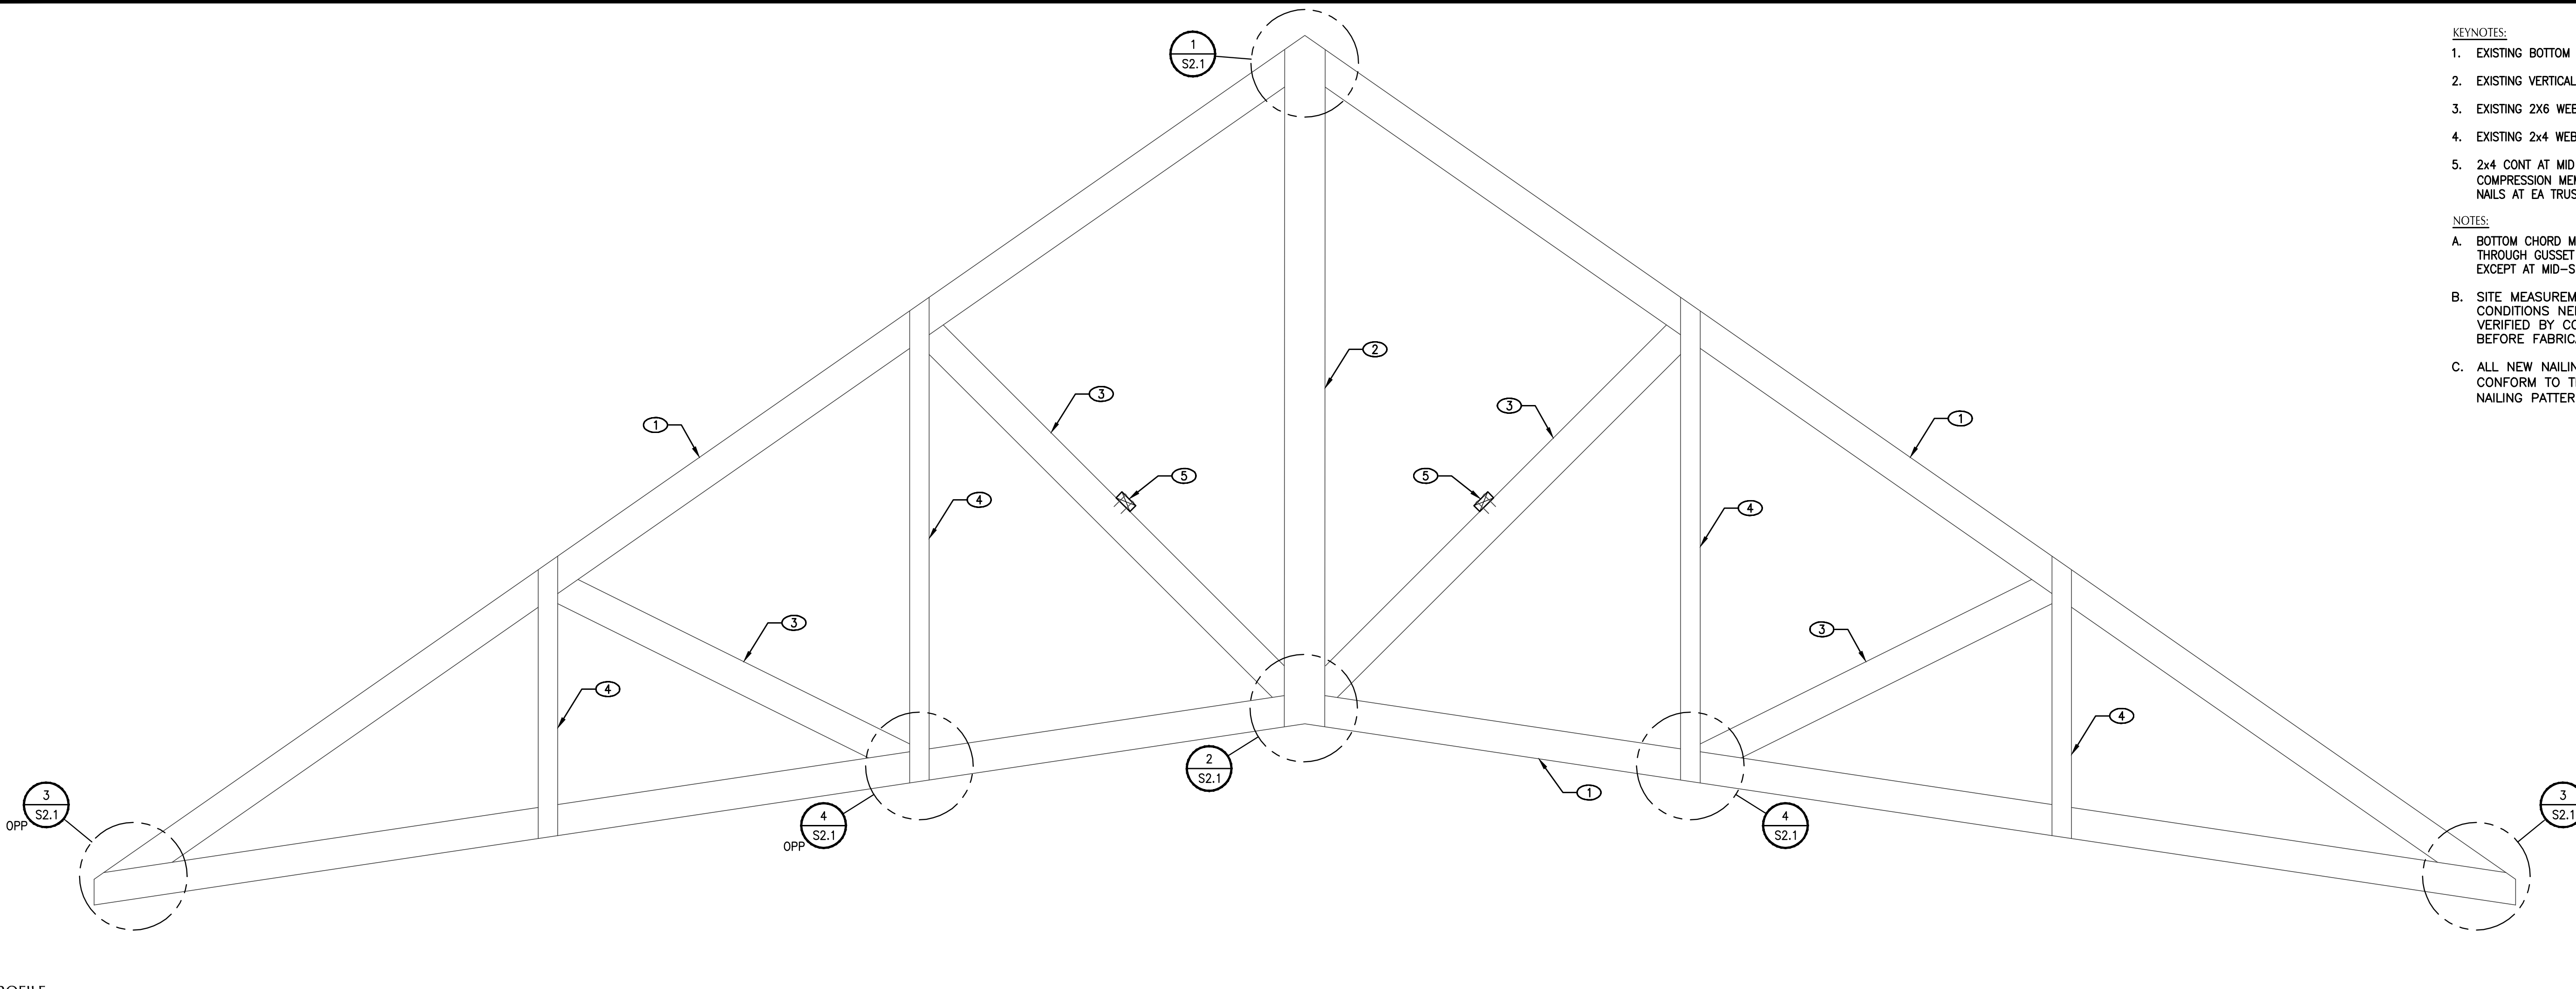


**B** TR2 PROFILE  
S2.2 NO SCALE

- KEYNOTES:**
- EXISTING BOTTOM AND TOP CHORD
  - EXISTING VERTICAL 2x8 WEB MEMBER
  - EXISTING 2x6 WEB MEMBER
  - EXISTING 2x4 WEB MEMBER
  - 2x4 CONT AT MID SPAN OF COMPRESSION MEMBER W/ (2) 16d NAILS AT EA TRUSS

- NOTES:**
- BOTTOM CHORD MUST BE CONTINUOUS THROUGH GUSSET PLATE CONNECTIONS, EXCEPT AT MID-SPAN CONNECTION
  - SITE MEASUREMENTS AND FIELD CONDITIONS NEED TO BE VERIFIED BY CONTRACTOR BEFORE FABRICATION OF PARTS
  - ALL NEW NAILING SHALL CONFORM TO THE "TYPICAL NAILING PATTERN" DETAIL

SEAL:

ENGINEERING SYSTEM SOLUTIONS  
4943 NORTH 29TH EAST, STE A  
IDAHO FALLS, IDAHO 83401  
Phone: (208) 552-9874  
Fax: (208) 552-9302  
www.es2eng.com

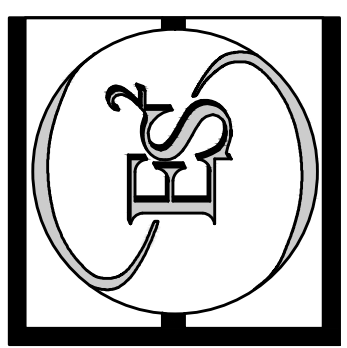

STRUCTURAL • MEP • BUILDING COMMISSIONING

ROOF TRUSS IMPROVEMENTS FOR:  
**MENAN 2, 5 (SP)**  
MENAN, ID  
PROPERTY #: 507-2638

PROJECT:

SHEET TITLE:

DATE


RECORD DRAWINGS  
DESCRIPTION

REV.	DESCRIPTION	DATE

DRAWN: GTC | CHECKED: DBP

DATE: AUGUST 27, 2014  
PROJECT NUMBER: 14.2015.02  
SHEET NUMBER:

**S2.2**

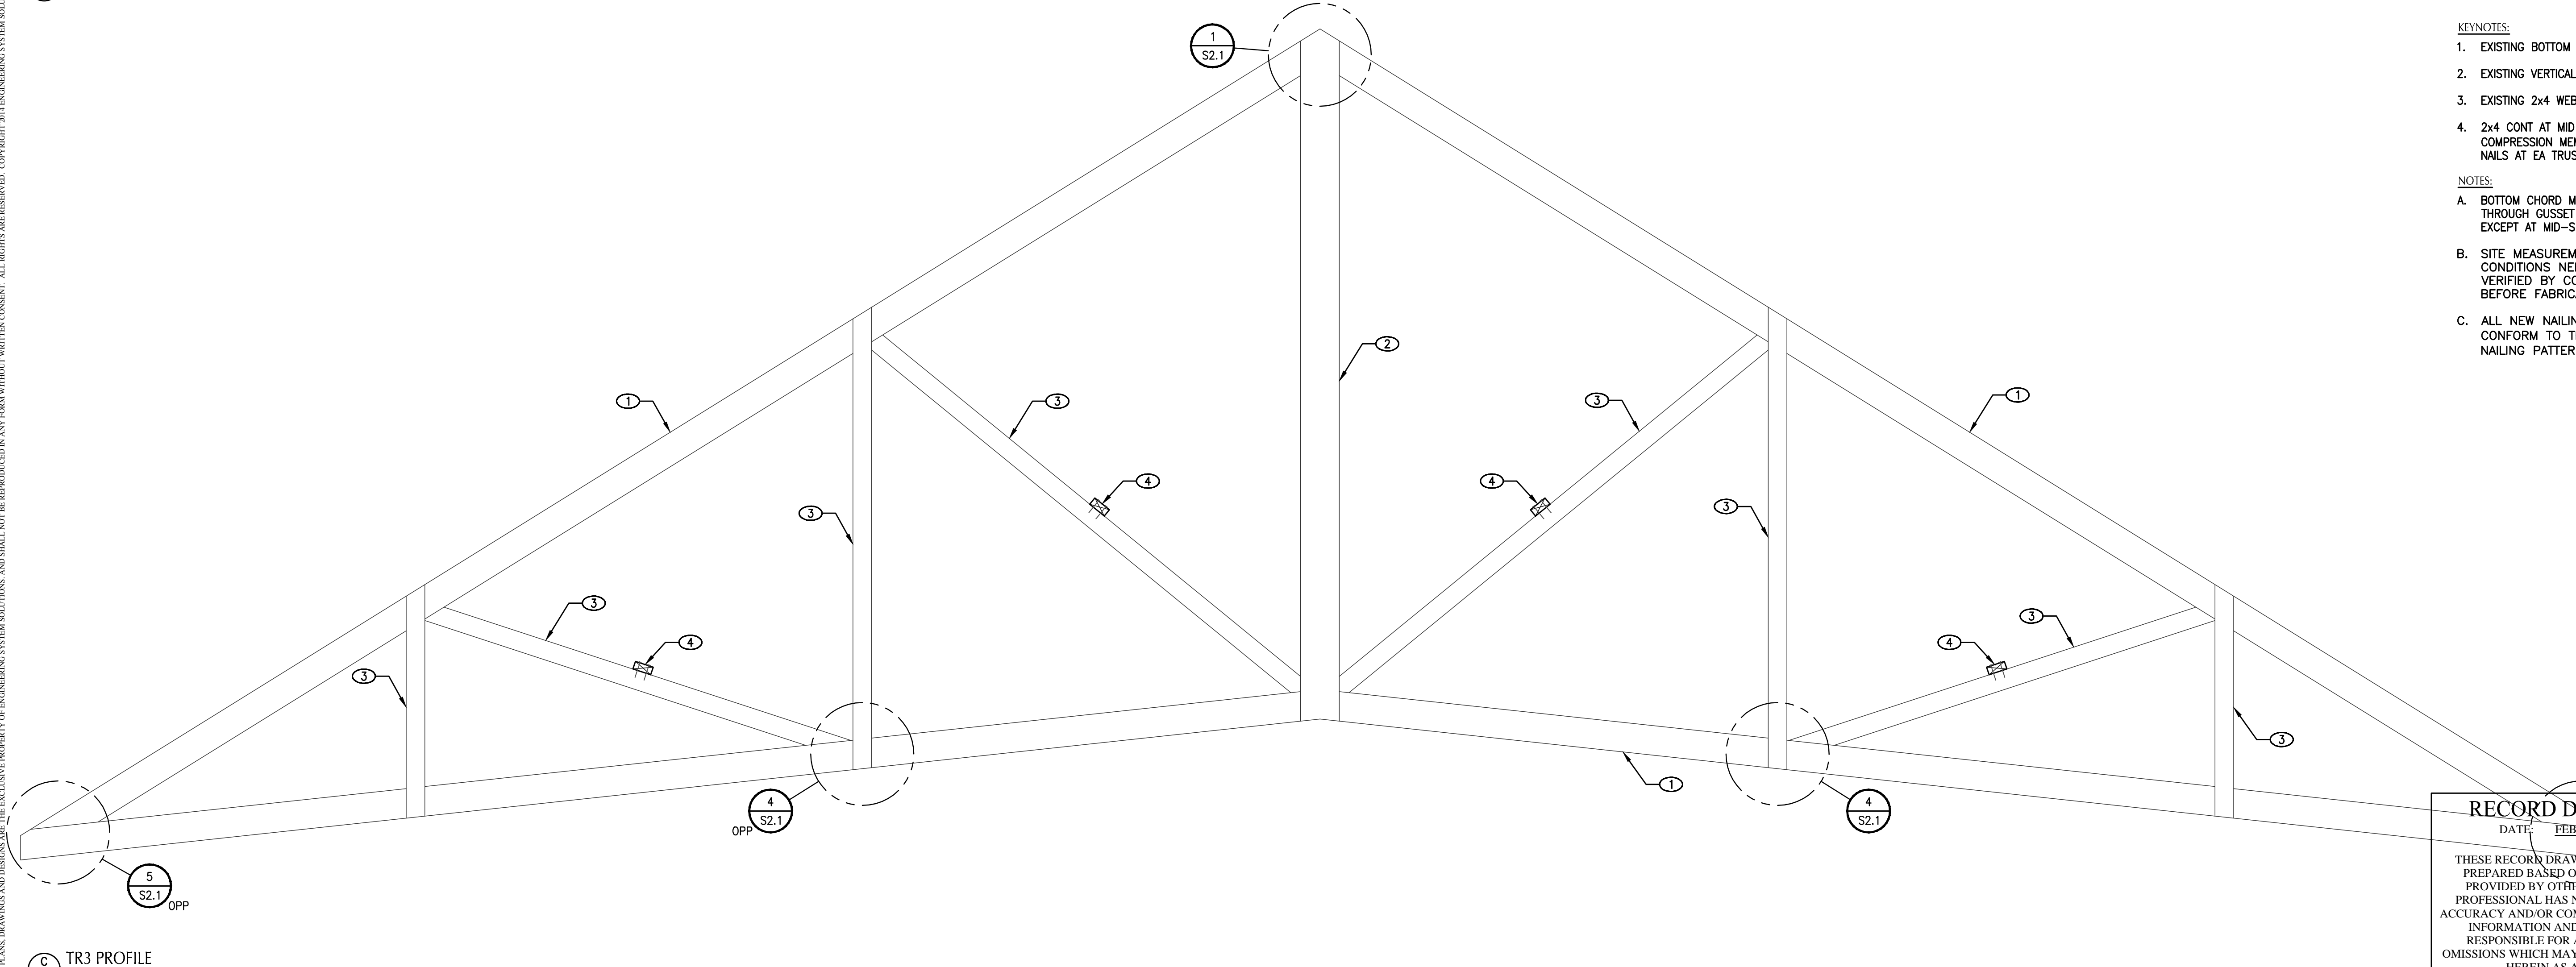

**C** TR3 PROFILE  
S2.2 NO SCALE

- KEYNOTES:**
- EXISTING BOTTOM AND TOP CHORD
  - EXISTING VERTICAL 2x8 WEB MEMBER
  - EXISTING 2x4 WEB MEMBER
  - 2x4 CONT AT MID SPAN OF COMPRESSION MEMBER W/ (2) 16d NAILS AT EA TRUSS

- NOTES:**
- BOTTOM CHORD MUST BE CONTINUOUS THROUGH GUSSET PLATE CONNECTIONS, EXCEPT AT MID-SPAN CONNECTION
  - SITE MEASUREMENTS AND FIELD CONDITIONS NEED TO BE VERIFIED BY CONTRACTOR BEFORE FABRICATION OF PARTS
  - ALL NEW NAILING SHALL CONFORM TO THE "TYPICAL NAILING PATTERN" DETAIL


**RECORD DRAWING**  
DATE: FEB 20, 2015  
THESE RECORD DRAWINGS HAVE BEEN PREPARED BASED ON INFORMATION PROVIDED BY OTHERS. THE DESIGN PROFESSIONAL HAS NOT VERIFIED THE ACCURACY AND/OR COMPLETENESS OF THIS INFORMATION AND SHALL NOT BE RESPONSIBLE FOR ANY ERRORS OR OMISSIONS WHICH MAY BE INCORPORATED HEREIN AS A RESULT.

THE CHURCH OF  
JESUS CHRIST  
OF LATTER-DAY SAINTS

Roof Trusses Evaluation Report  
of the  
Meetinghouse  
at  
3547 E Menan-Lorenzo Hwy, Menan, ID  
LDS Property No. 507-2638



Prepared by ES<sup>2</sup>  
February 21, 2013

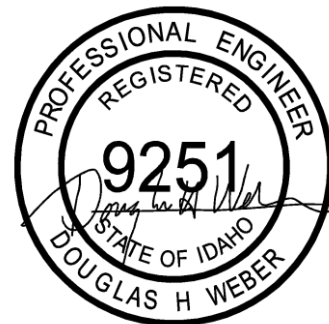



**Executive Summary**

**BUILDING DATA**

<b>LDS Property Number:</b>	507-2638	<b>Previous Structural Evaluation Report Date:</b>	8/24/2012
<b>LDS Building Plan Type:</b>	Undefined	<b>Year Constructed:</b>	1937
<b>Site Visit Date:</b>	9/6/2012	<b>Year(s) of Additions:</b>	1970, 1987
<b>Original Report Date:</b>	9/27/2012	<b>Total Building Area:</b>	~18,000 sq. ft.
<b>Structural Engineer:</b>	Doug Weber	<b>Number of Stories:</b>	2
<b>Firm Job Number:</b>	STR12.1121.05	<b>Basement:</b>	1

**COST ESTIMATE**

**STRUCTURAL:** \$24,700

**TOTAL CONSTRUCTION COST:** \$ 24,700

**STRUCTURAL DESIGN FEE:** \$3,500

**STRUCTURAL OBSERVATION FEE:** \$1,500

**SPECIAL INSPECTION FEE:** \$3,000

**TOTAL FEES:** \$ 8,000

**TOTAL STRUCTURAL COST<sup>1</sup>:** \$ 32,700

1. Estimates shown above do not include costs for removal and replacement of roofing or other replacements and improvements costs related to structural upgrade work.

## 1. Structural Description

**Table 1-1**  
**VERTICAL LOAD-RESISTING ELEMENTS**  
**FOR THE HIGH ROOF SECTIONS**

Element	Description
<b>Sheathing:</b>	1x8 overlaid with plywood sheathing
<b>Joists:</b>	2x6, 2x10, 2x12
<b>Roof Beams/Girders:</b>	GLB, 2x beams
<b>Truss Type 1:</b>	Wood truss with 1/2" plywood gusset and simple nail connections
<b>Truss Type 2:</b>	Wood truss with 1x wood gusset, bolted connections, and simple nail connections
<b>Truss Type 3:</b>	Wood scissor truss with 1x wood gusset, bolted connections, and simple nail connections
<b>Truss Type 4:</b>	Wood truss with nailer plate connections
<b>Attic insulation:</b>	Fiberglass and blown-in insulation

**Comments:**

1. There are multiple additions spanning multiple years and types of construction.

**Table 1-2**  
**VERTICAL LOAD-RESISTING ELEMENTS**  
**FOR THE LOW ROOF SECTION**

Element	Description
<b>Sheathing:</b>	Plywood sheathing
<b>Joists:</b>	2x6
<b>Roof Beams/Girders:</b>	2x beams
<b>Truss Type 3:</b>	Low profile
<b>Attic insulation:</b>	Unable to access

**Comments:**

1. The lower roof comprises roof extensions over flat roof sections and low profile trusses.



**Table 1-3  
TRUSS TYPE 1**

<b>Truss location:</b>		Classrooms	
<b>Truss span (ft):</b>	30	<b>Ridge connection:</b>	Plywood gussets 8d nails
<b>Top chord:</b>	2x6	<b>Top chord/Web connection:</b>	Plywood gussets 8d nails
<b>Bottom chord:</b>	2x6	<b>Bottom chord/Web connection:</b>	Plywood gussets 8d nails
<b>Compression web members:</b>	2x4	<b>Bottom chord splice connection:</b>	N/A
<b>Tension web members:</b>	2x4	<b>Bottom/Top chord connection:</b>	Plywood gussets 8d nails

**Table 1-4  
TRUSS TYPE 2**

<b>Truss location:</b>		Classrooms	
<b>Truss span (ft):</b>	30	<b>Ridge connection:</b>	Plywood gussets 8d nails
<b>Top chord:</b>	2x6	<b>Top chord/Web connection:</b>	16d nails
<b>Bottom chord:</b>	2x6	<b>Bottom chord/Web connection:</b>	16d nails
<b>Compression web members:</b>	2x6	<b>Bottom chord/Bottom chord connection:</b>	1x gussets with 1/2" bolts
<b>Tension web members:</b>	2x4	<b>Bottom/Top chord connection:</b>	1x gussets with 1/2" bolts

**Table 1-5  
TRUSS TYPE 3**

<b>Truss location:</b>		Chapel	
<b>Truss span (ft):</b>	34	<b>Ridge connection:</b>	1x gussets 10d nails
<b>Top chord:</b>	2x6	<b>Top chord/Web connection:</b>	16d nails
<b>Bottom chord:</b>	2x6	<b>Bottom chord/Web connection:</b>	16d nails
<b>Web members:</b>	2x4	<b>Bottom chord/Bottom chord connection:</b>	1x gussets with 1/2" bolts

		<b>Bottom/Top chord connection:</b>	1x gussets with 1/2" bolts
--	--	-------------------------------------	----------------------------

**Table 1-6  
TRUSS TYPE 4**

<b>Truss location:</b>		Offices	
<b>Truss span (ft):</b>	34	<b>Ridge connection:</b>	Nailer plates
<b>Top chord:</b>	2x6	<b>Top chord/Web connection:</b>	Nailer plates
<b>Bottom chord:</b>	2x6	<b>Bottom chord/Web connection:</b>	Nailer plates
<b>Web members:</b>	2x6	<b>Bottom chord splice connection:</b>	N/A
		<b>Bottom/Top chord connection:</b>	Nailer plates

## 2. Site Hazards

**Table 2-1  
SNOW CHARACTERIZATION**

Parameter	Description
<b>Roof snow load (psf):</b>	28 psf
<b>Ground snow load (psf):</b>	37 psf

**Reference:**

1. Sack, Ronald L., & Sheikh-Taheri, Azim (1986). *Ground and Roof Snow Loads for Idaho*. Department of Civil Engineering, University of Idaho.

**Comments:**

1. Unbalanced snow loads were used in the evaluation of these trusses.



### 3. Scope of Work

The objective of this study is to perform a visual screening (visual observation and engineering judgment) of the roof trusses, associated secondary framing, bracing, and support connections for deficiencies including failing/failed split ring truss connections and other identifiable roof framing deficiencies.

The scope also includes reviewing the roof truss as-built drawings and performing quick check calculations of the split ring truss connections and the gravity load carrying capacity of the roof trusses.

### 4. Findings

Table 4-1  
STRUCTURAL DEFICIENCIES

No.	Item	Description	Photo No.
S-1	Truss 1: Bearing site connection	Nailing pattern does not satisfy calculations	1
S-2	Truss 1: TC gusset to vertical web	Nailing pattern does not satisfy calculations	2
S-3	Truss 1: BC gusset to vertical web	Nailing pattern does not satisfy calculations	3
S-4	Truss 2: Bearing site connection	Bolt and nailing pattern does not satisfy calculations	4
S-5	Truss 2: TC and vertical web to gusset	Nailing pattern does not satisfy calculations	5
S-6	Truss 2: BC compression and tension web	Nailing pattern does not satisfy calculations	6
S-7	Truss 2: BC gusset to webs	Bolt and nailing pattern does not satisfy calculations	7
S-8	Truss 2: Overbuild at TR3	Inadequate overbuild and unbraced top chords	8,9,10
S-9	Truss 3: Bearing site connection	Bolt and nailing pattern does not satisfy calculations	11
S-10	Truss 3: TC gusset to vertical web	Nailing pattern does not satisfy calculations	12
S-11	Truss 3: BC to short span compression web	Nailing pattern does not satisfy calculations	13

**Comments:**

1. Truss 4 considered engineered and not evaluated.
2. Structural deficiencies provided in this report are based on site visit observations, review of provided existing drawings (benefit limited by incompleteness and/or difficulty reading), and the results obtained through analysis. Other deficiencies may not have been accessible or observable.
3. On-site verification is required and must occur during the construction phase when the structure is more accessible. Verification may result in additional deficiencies.

**Table 4-2  
STRUCTURAL DETERIORATION**

No.	Item	Description	Photo No.
D-1	Rodent	Evidence of rodent activity	N/A

**Comments:**

1. No deterioration was seen in the truss systems.
2. Other deterioration may not have been accessible or observable.



**5. Recommendations**

**Table 5-1  
STRUCTURAL UPGRADE MEASURES**

No.	Item	Plan No.	Recommended Upgrade Year/Timing	Actual Upgrade Year
S-1	Add extra fasteners	5-1	Next reroof	
S-2	Add extra fasteners	5-1	2013	
S-3	Add extra fasteners	5-1	2013	
S-4	Add extra fasteners	5-1	Next reroof	
S-5	Add extra fasteners	5-1	2013	
S-6	Add extra fasteners	5-1	2013	
S-7	Add extra fasteners	5-1	2013	
S-8	Restructure overbuild and brace top chords to distribute load	5-1	2013	
S-9	Add extra fasteners	5-1	Next reroof	
S-10	Add extra fasteners	5-1	2013	
S-11	Add extra fasteners	5-1	2013	
D-1	Continue to monitor and remove rodents if problem persists	5-1	2013	

**Comments:**

1. Many of the deficiencies are based on the worst case snow loads on the roof.

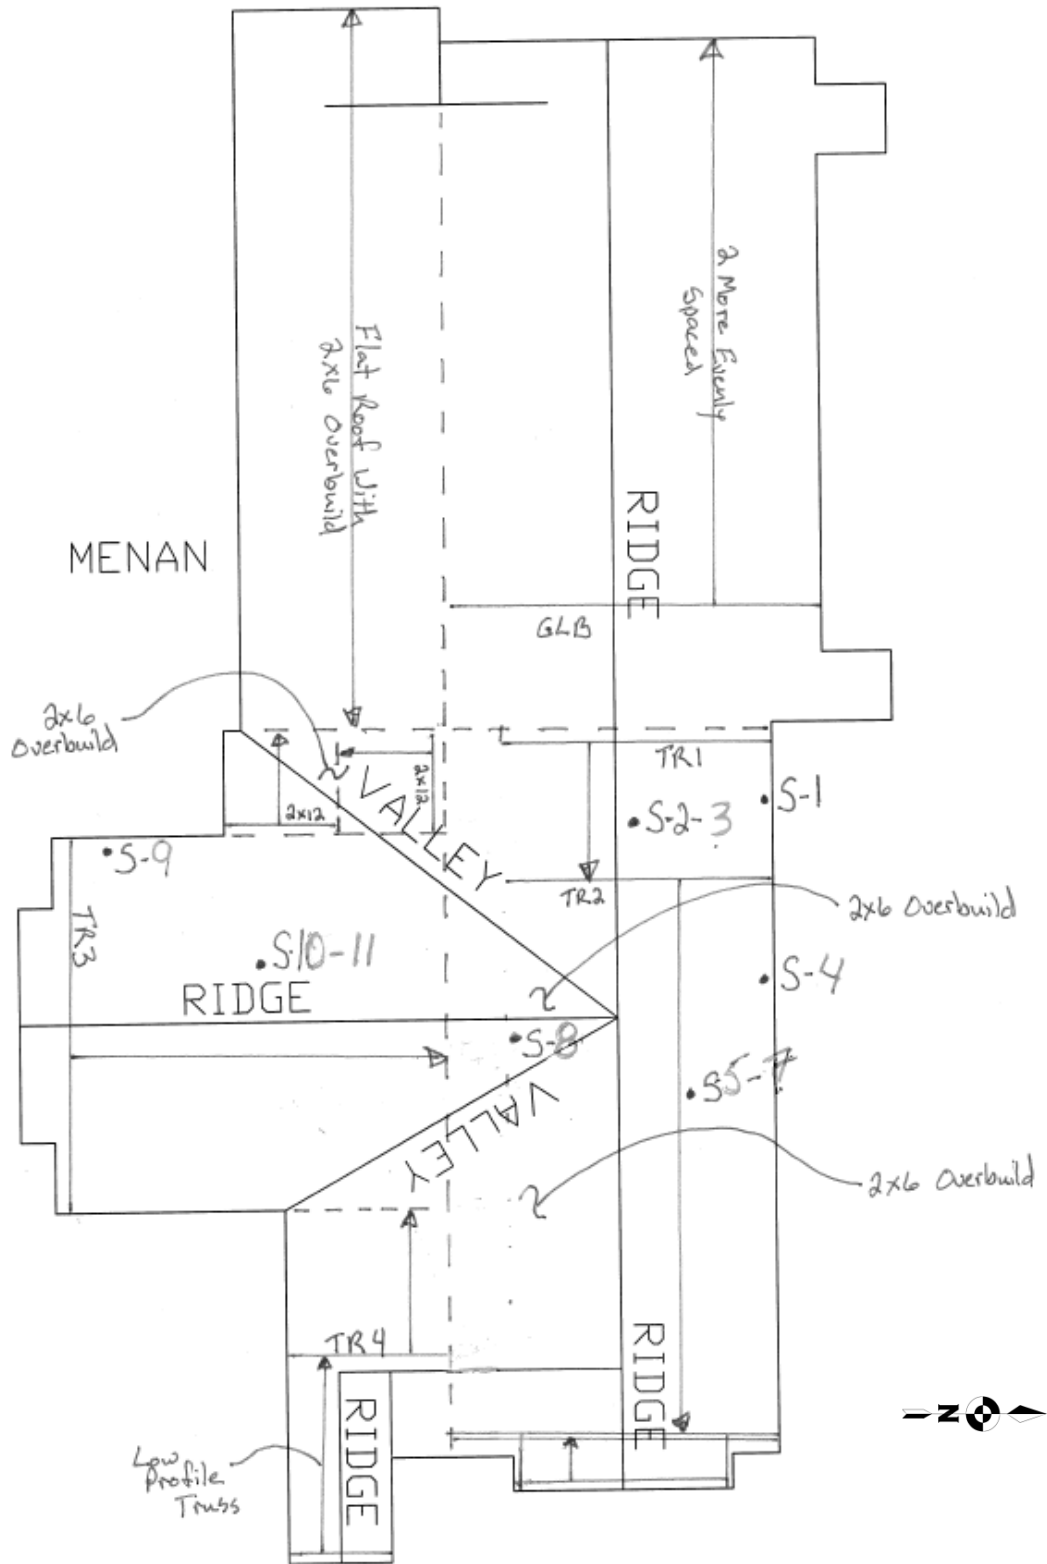


Figure 5-1 – Roof Plan – Deficiency Locations and Recommended Upgrades



## Appendix A – Photographs



**Photo 1 – Nailed bearing site connection**



**Photo 2 – TC gusset to vertical web**



**Photo 3 – BC gusset to vertical web**




**Photo 4 – Bearing site connection**





**Photo 5 – TC and vertical web to gusset**

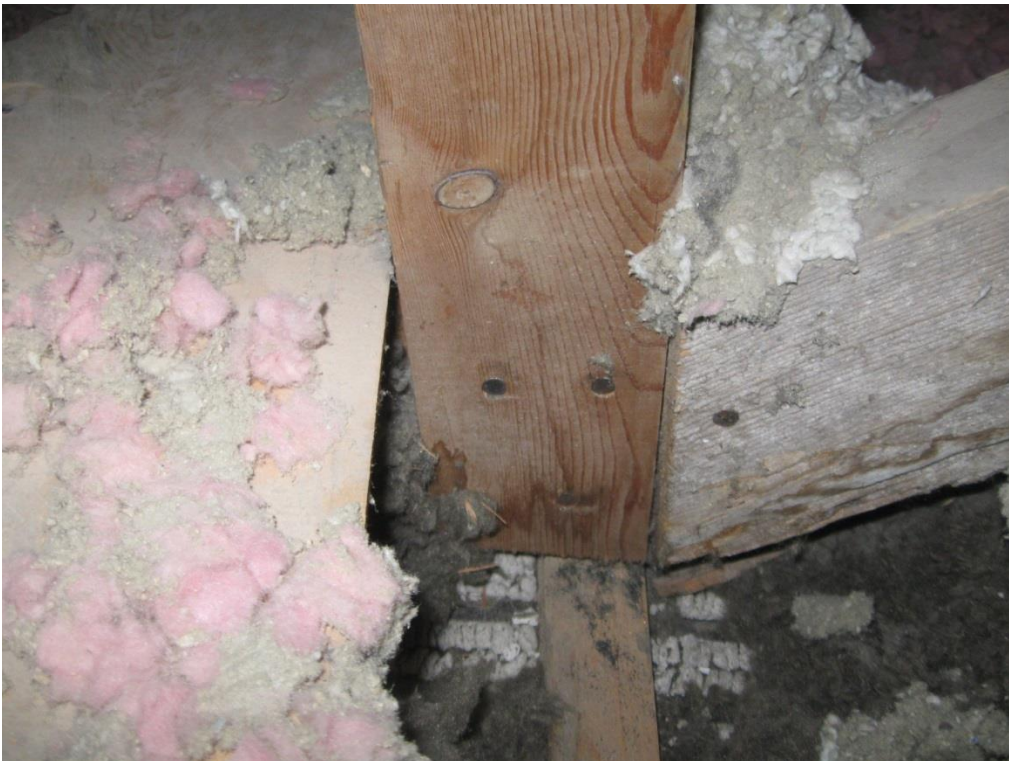

**Photo 6 – BC compression and tension webs**



**Photo 7 – BC gusset to webs**



**Photo 8 – Roof overbuild**





**Photo 9 – Roof overbuild**



**Photo 10 – Roof Overbuild**



**Photo 11 – Bearing site connection**



**Photo 12 – Bearing site connection**





**Photo 13 – BC to short compression web**

**Appendix B – Structural Construction Cost Estimate Details**

No.	Item	Cost	Recommended Upgrade Year/Timing
S-1	<b>Add extra fasteners</b>	\$840	Next reroof
S-2	<b>Add extra fasteners</b>	\$630	2013
S-3	<b>Add extra fasteners</b>	\$630	2013
S-4	<b>Add extra fasteners</b>	\$3,600	Next reroof
S-5	<b>Add extra fasteners</b>	\$2,700	2013
S-6	<b>Add extra fasteners</b>	\$2,700	2013
S-7	<b>Add extra fasteners</b>	\$2,700	2013
S-8	<b>Restructure overbuild and brace top chords to distribute load</b>	\$2,400	2013
S-9	<b>Add extra fasteners</b>	\$3,000	Next reroof
S-10	<b>Add extra fasteners</b>	\$2,250	2013
S-11	<b>Add extra fasteners</b>	\$2,250	2013
D-1	<b>Continue to monitor and remove rodents if problem persists</b>	\$1,000	2013
	<b>TOTAL</b>	<b>\$24,700</b>	

**Comments:**

1. The cost estimate is intended to be a conceptual cost estimate based on the structural engineer's judgment.




**5. Recommendations**

**Table 5-1  
 STRUCTURAL UPGRADE MEASURES**



No.	Item	Plan No.	Recommended Upgrade Year/Timing	Actual Upgrade Year
S-1	Add extra fasteners	5-1	Next reroof	
S-2	Add extra fasteners	5-1	2013	2015
S-3	Add extra fasteners	5-1	2013	2015
S-4	Add extra fasteners	5-1	Next reroof	
S-5	Add extra fasteners	5-1	2013	2015
S-6	Add extra fasteners	5-1	2013	2015
S-7	Add extra fasteners	5-1	2013	2015
S-8	Restructure overbuild and brace top chords to distribute load	5-1	2013	2015
S-9	Add extra fasteners	5-1	Next reroof	
S-10	Add extra fasteners	5-1	2013	2015
S-11	Add extra fasteners	5-1	2013	2015
D-1	Continue to monitor and remove rodents if problem persists	5-1	2013	2015

**Comments:**


1. Many of the deficiencies are based on the worst case snow loads on the roof.

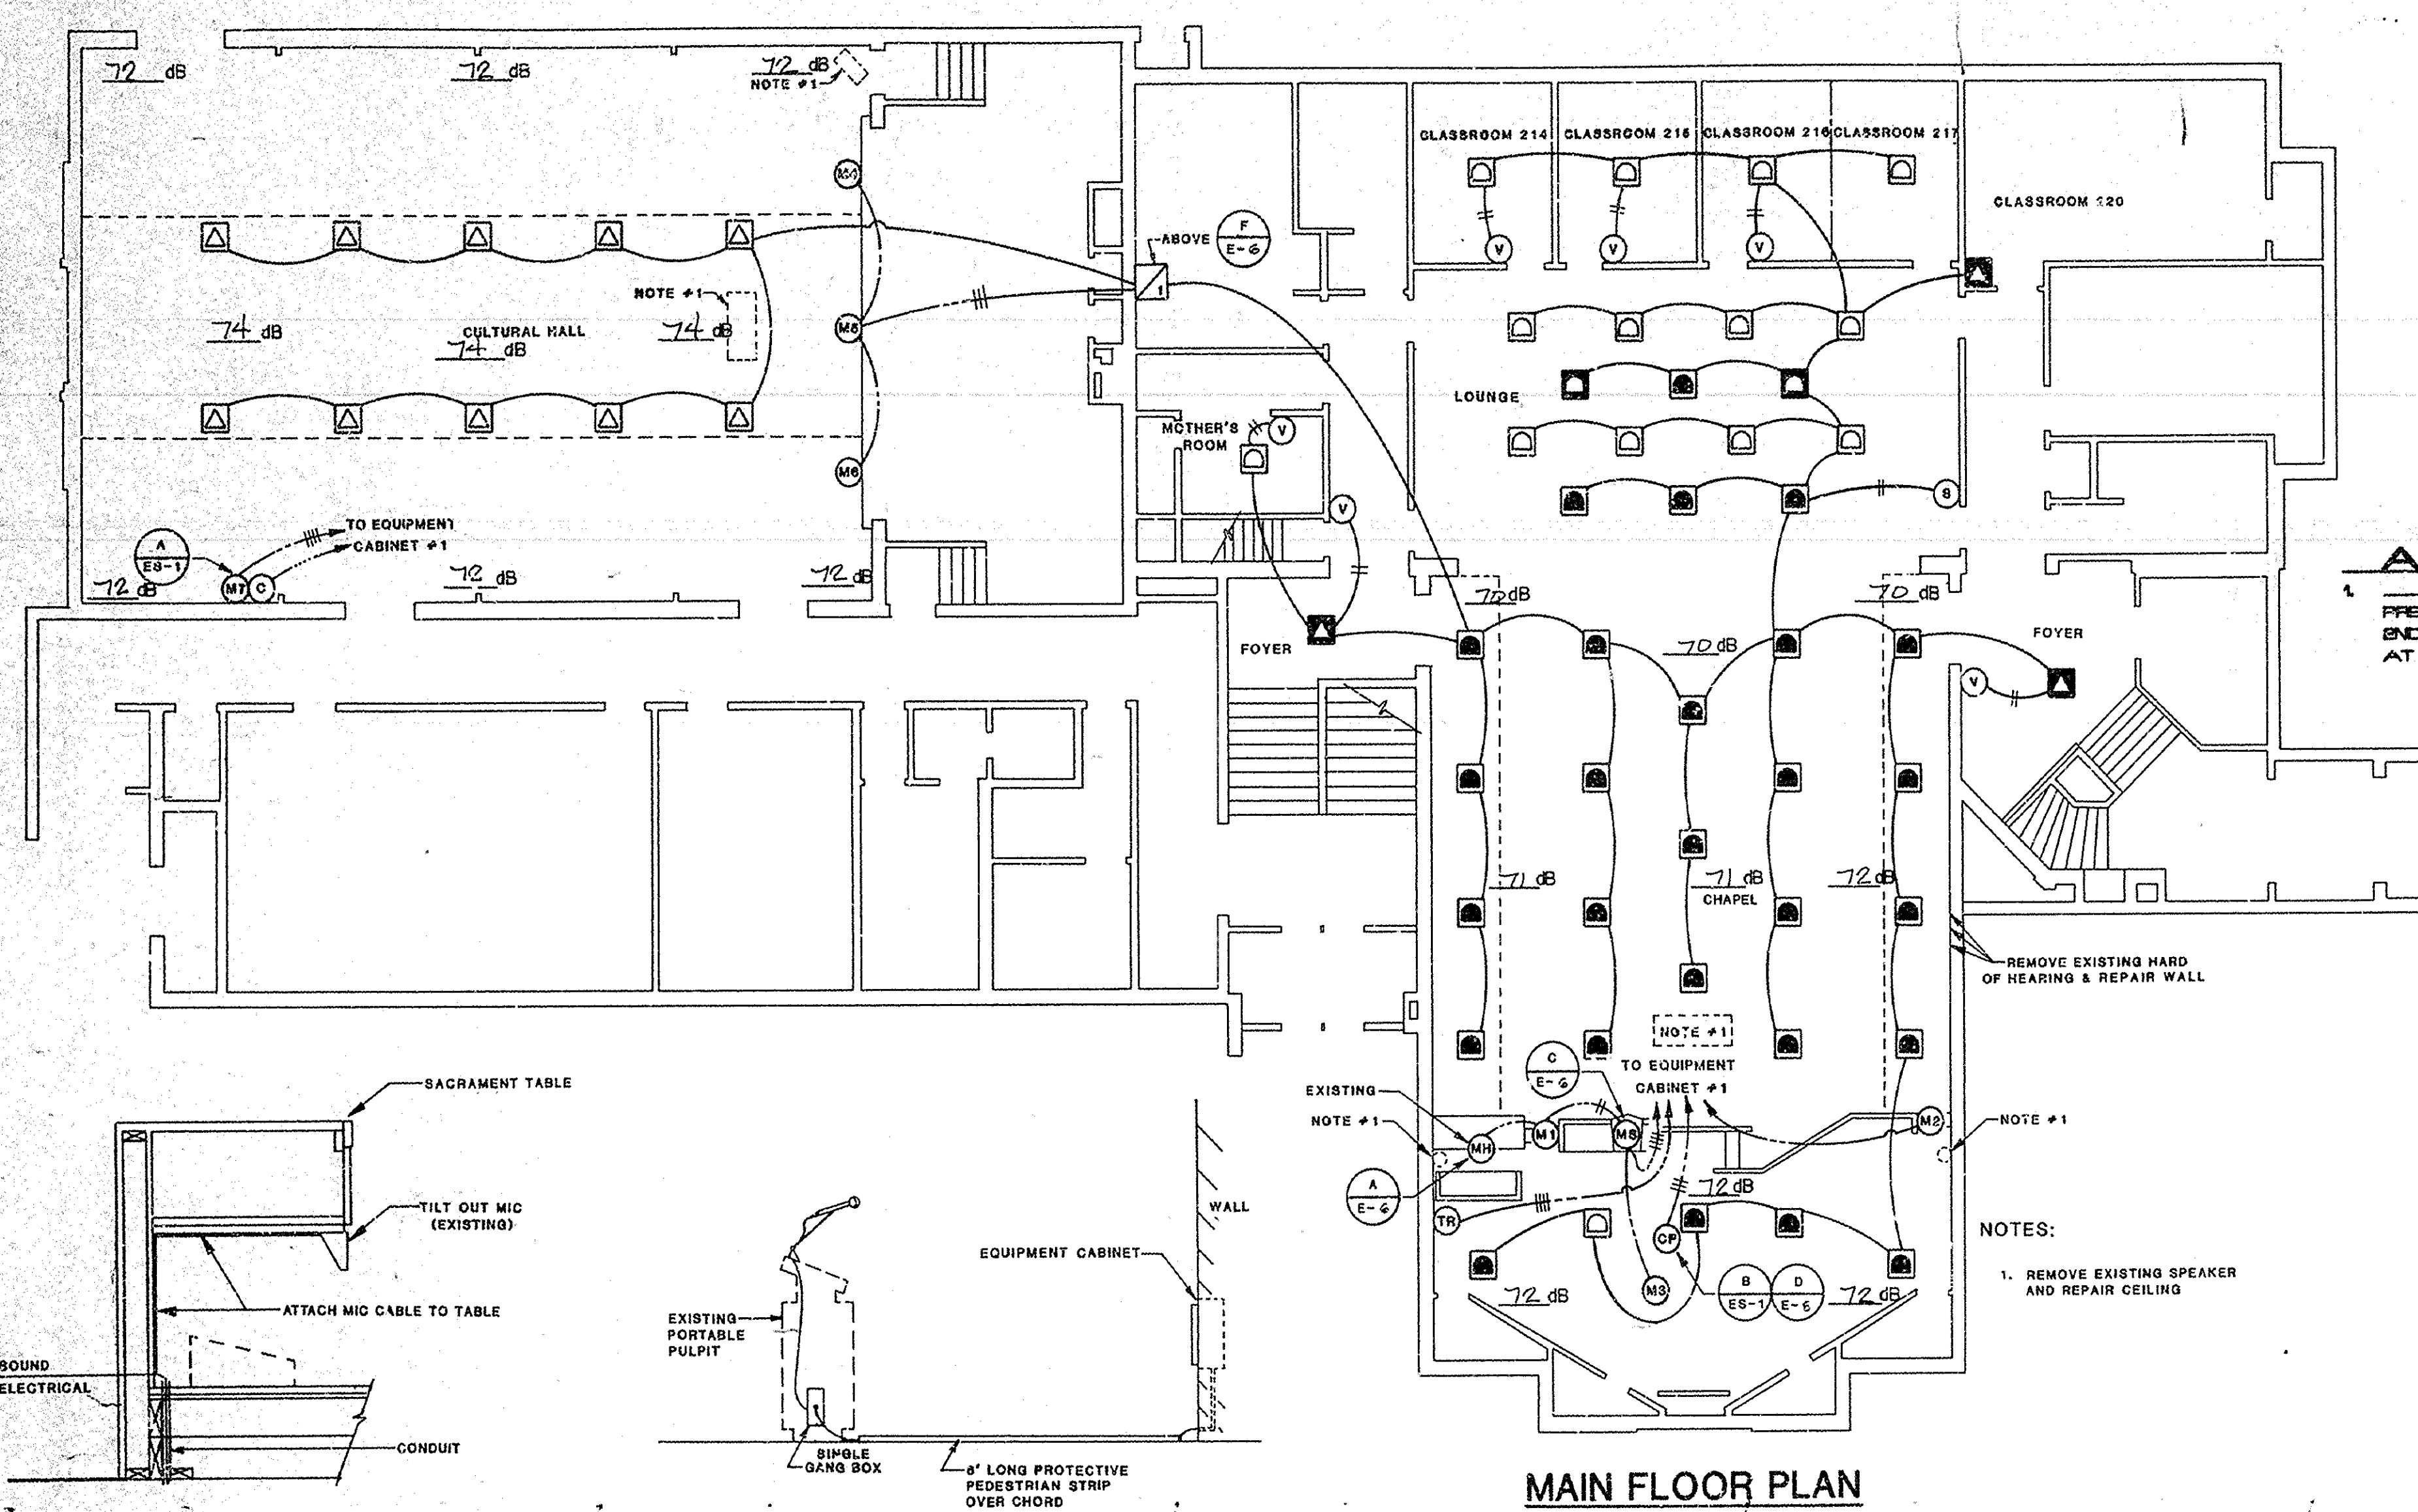


**AS BUILT NOTES**  
 1. dB INDICATES LOCATION OF SOUND PRESSURE LEVEL READINGS TAKEN DURING 2ND EQUALIZATION SPL READINGS TAKEN AT 4000 HZ, 1 OCTAVE BAND WITH PINK NOISE

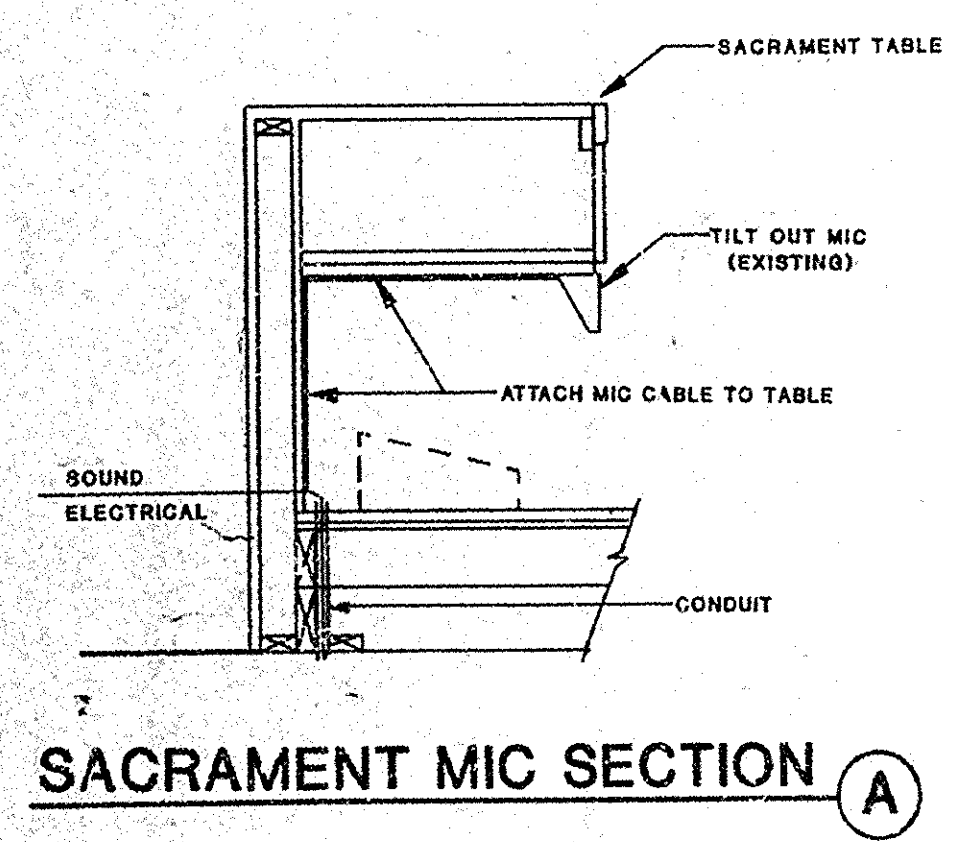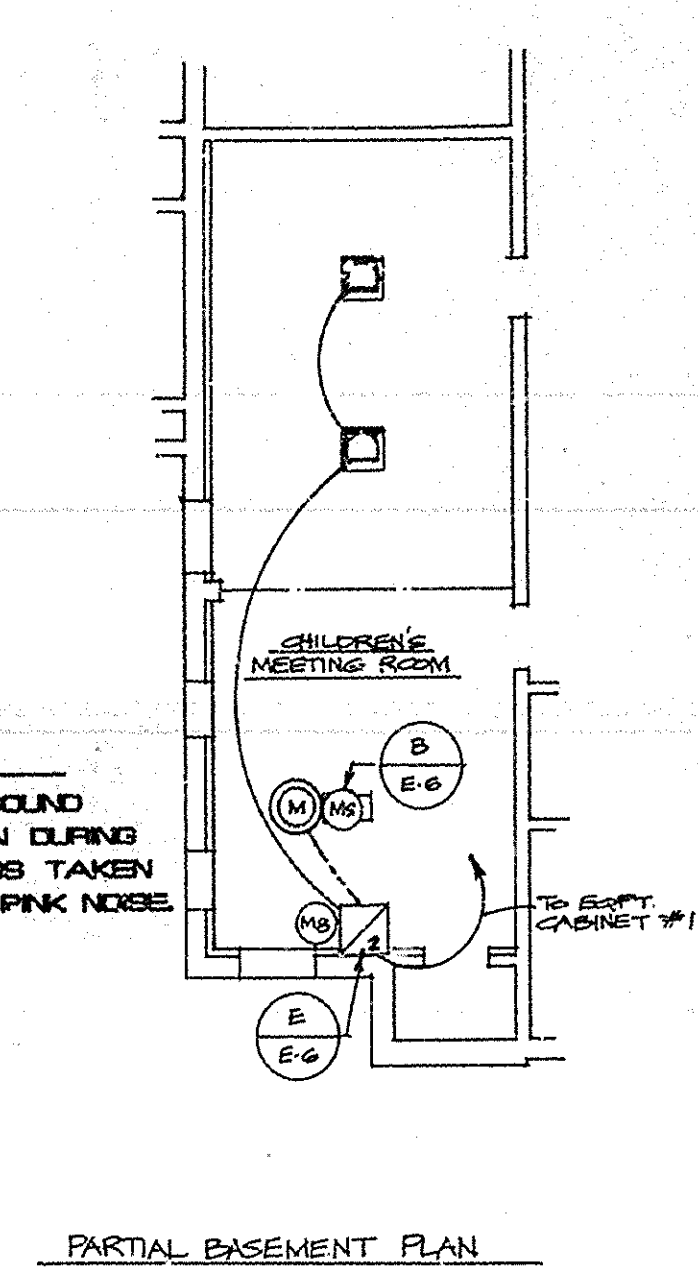


**SACRAMENT MIC SECTION A**

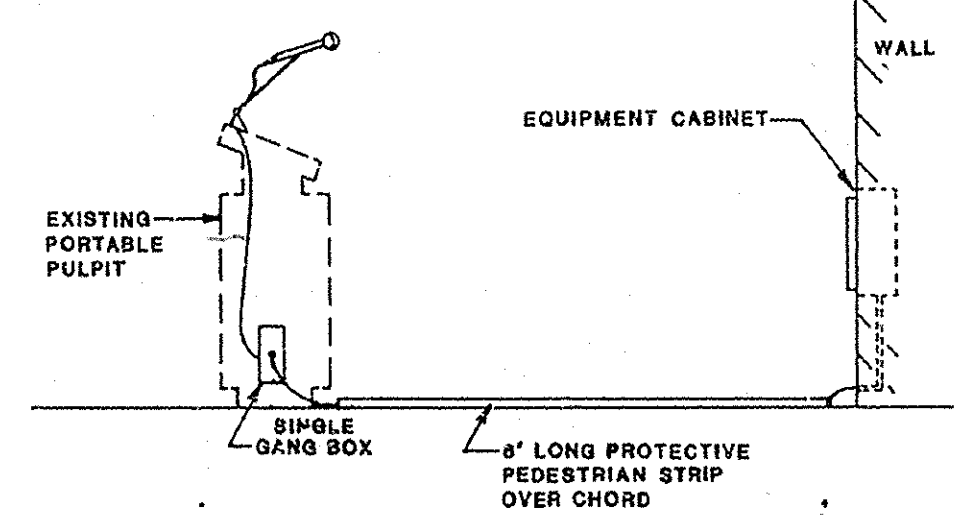


**CHILDRENS MEETING ROOM SOUND SYSTEM DETAIL B**

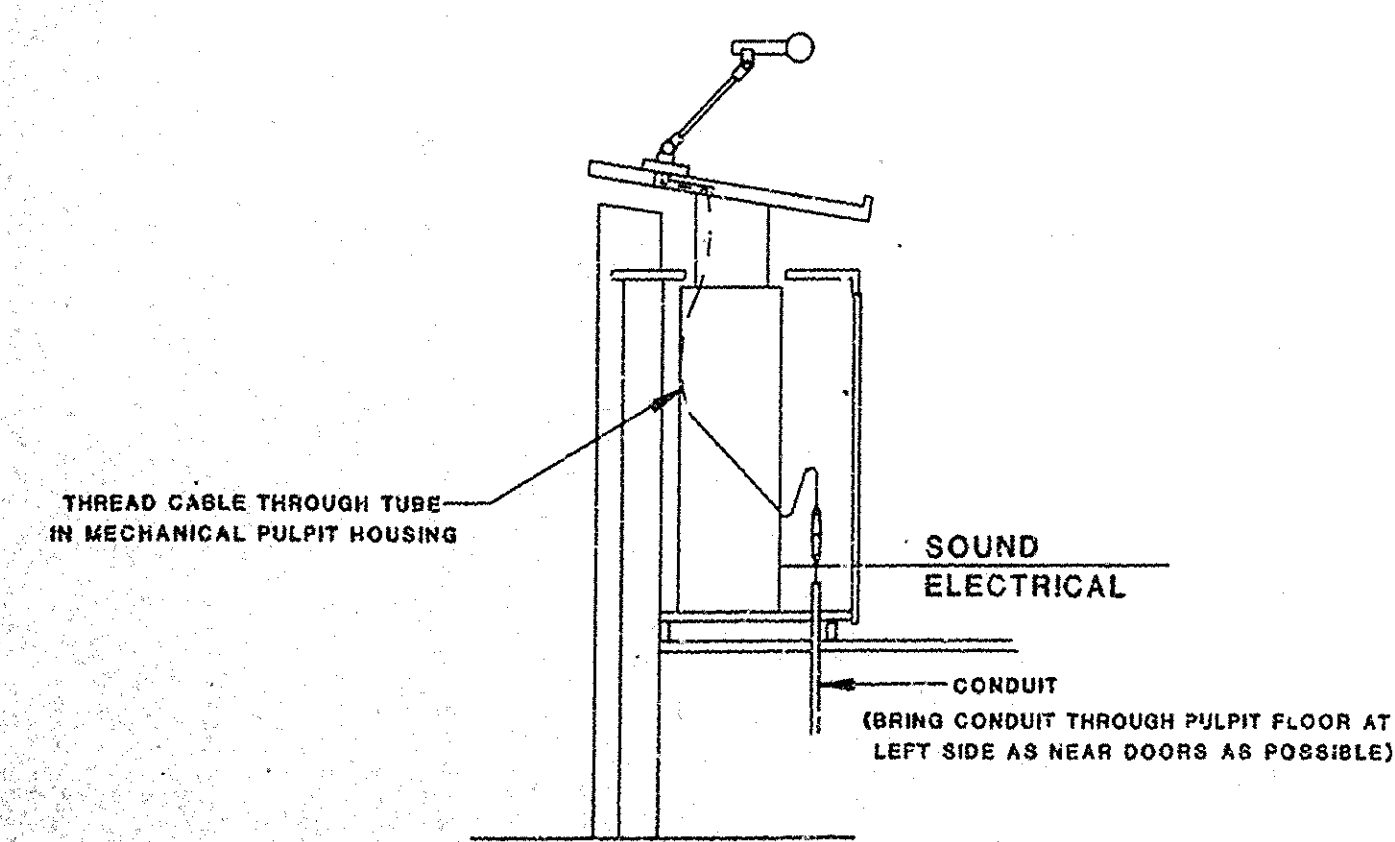


**CHAPEL PULPIT SECTION C**

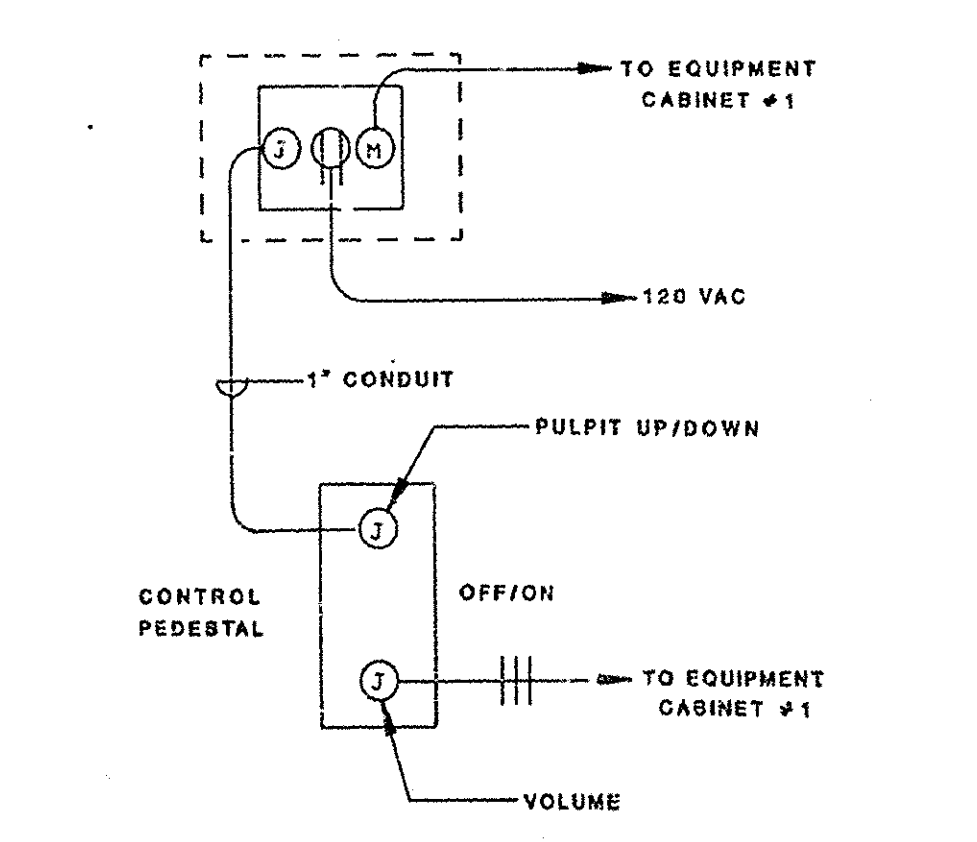

**CONTROL PEDESTAL & PULPIT ELECTRICAL DETAIL D**

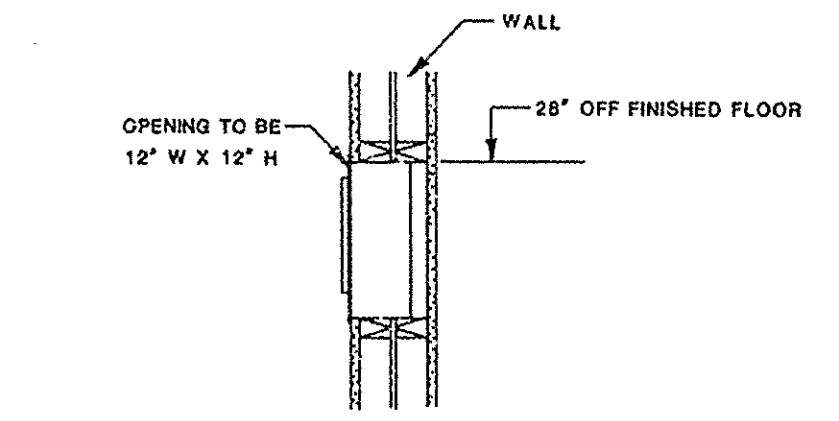


**EQUIPMENT CABINET MOUNTING DETAIL E**

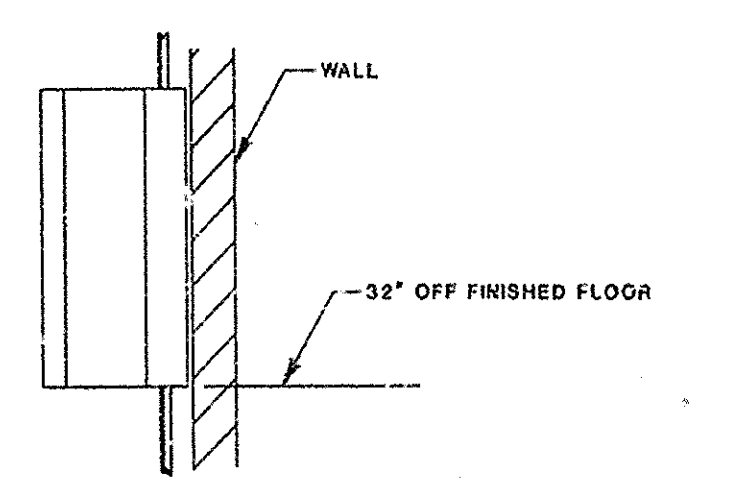


**EQUIPMENT CABINET MOUNTING DETAIL F**



SYM	DESCRIPTION	QTY	MANUFACTURE & MODEL NUMBER
MS	Microphone, pulpit Stub conduit into location	A/R	
MH	Microphone, sacrament Stub conduit into location	A/R	
MI	Microphone input Single gang box not on horiz.	A/R	
	Microphone cable #20 Cross lines indicate # of cables if more than one	A/R	Belden 8742 Columbia 2524 West Penn 292
	Control cable #20 12 cond.	A/R	Belden 9457 West Penn 265.
CP	Control pedestal Three single gang boxes	1	
TR	Tape recorder & satellite switch, Double gang box	1	
A	Amplifier, inwall 10 watt	1	IWE 170 BB Marshall KL10 BB
	Speaker cable #20 Cross lines indicate # of cables if more than one	A/R	Belden 8205 Columbia 4351 West Penn 222
S	Overflow switch Single gang box	A/R	
V	Volume control Deep double gang box	A/R	
SP8R	Speaker, 8" recessed	A/R	Jedcor CM815 Soundolier M33198
SP8E	Speaker, 8" existing	A/R	
SP4R	Speaker, 4" recessed	A/R	Jedcor CM411 Soundolier M2840-A
SP4E	Speaker, 4" existing	A/R	
SP4BS	Speaker, 4" blind short	A/R	Soundolier M4551-407
EC	Equipment cabinet 45" H	1	HME 193-C Soundolier 300-42
C	Control plate Double gang box	1	
M	Cable marking are to correspond w/ I. D. # on riser diagram		

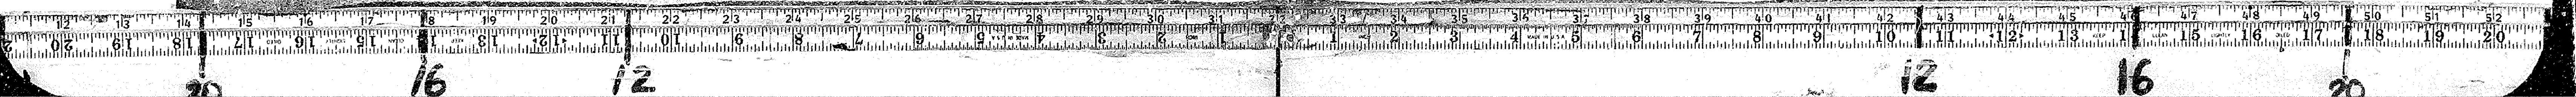



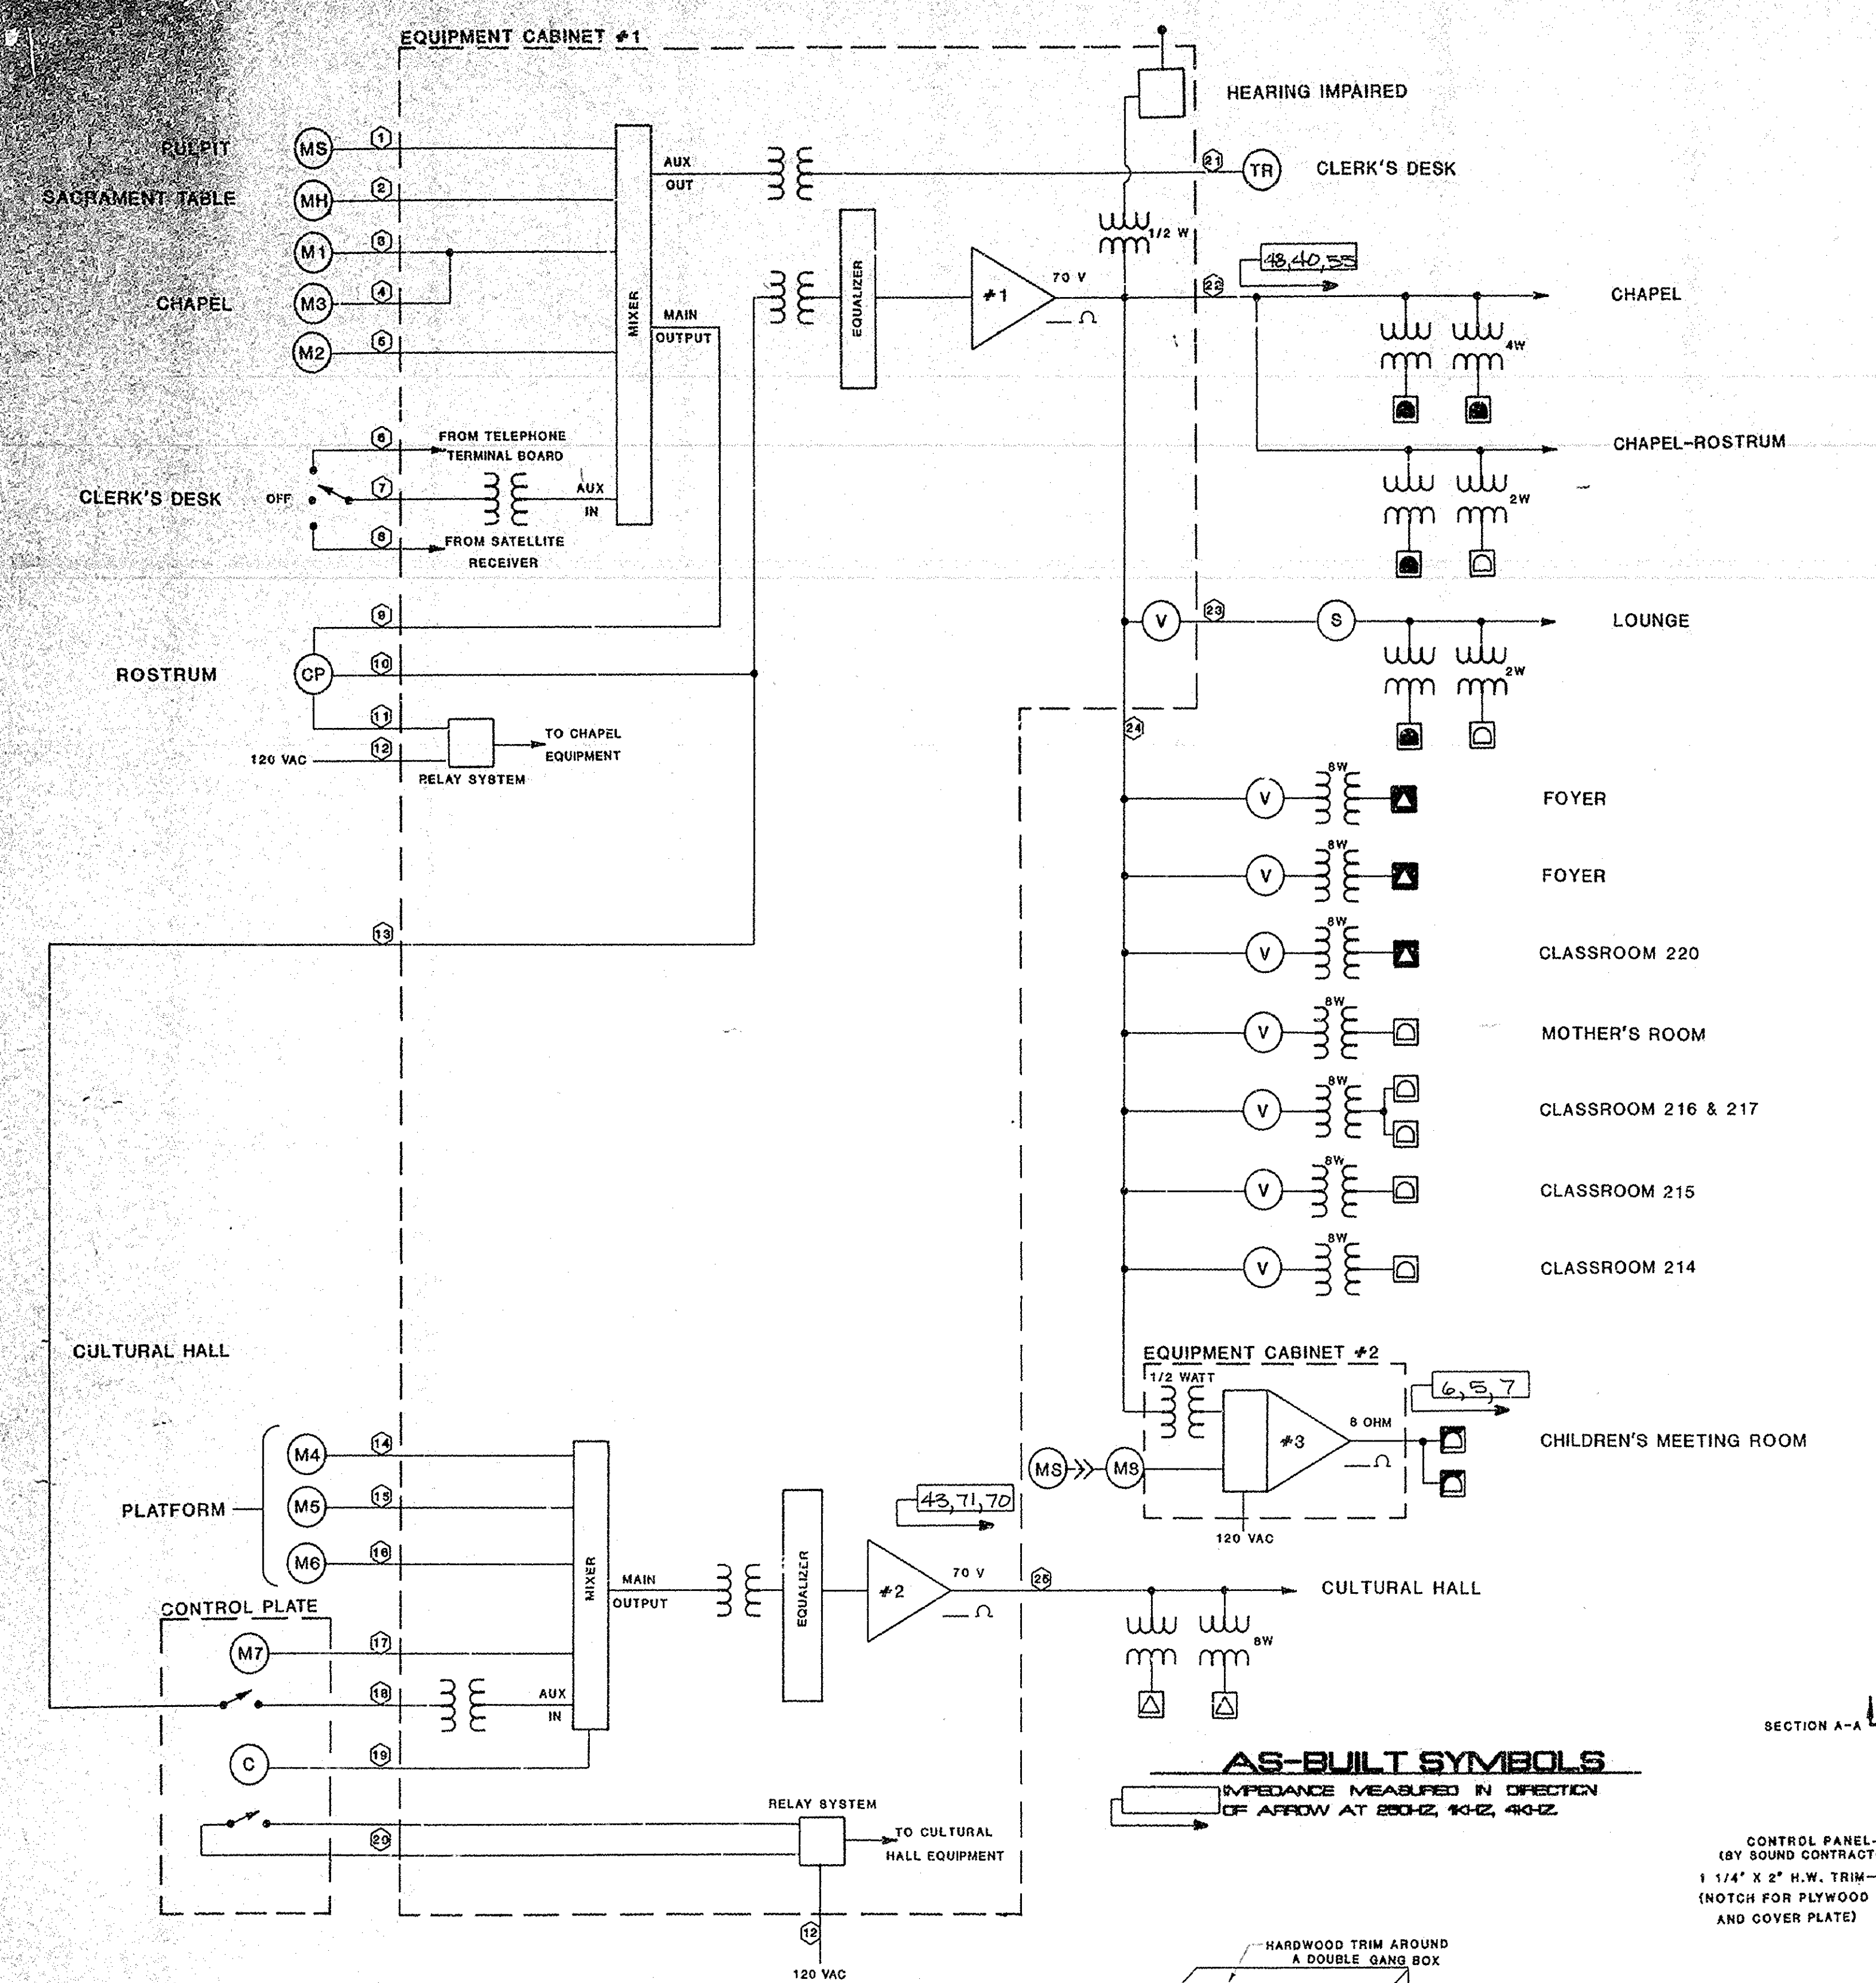


**SINGLE LINE DIAGRAM**

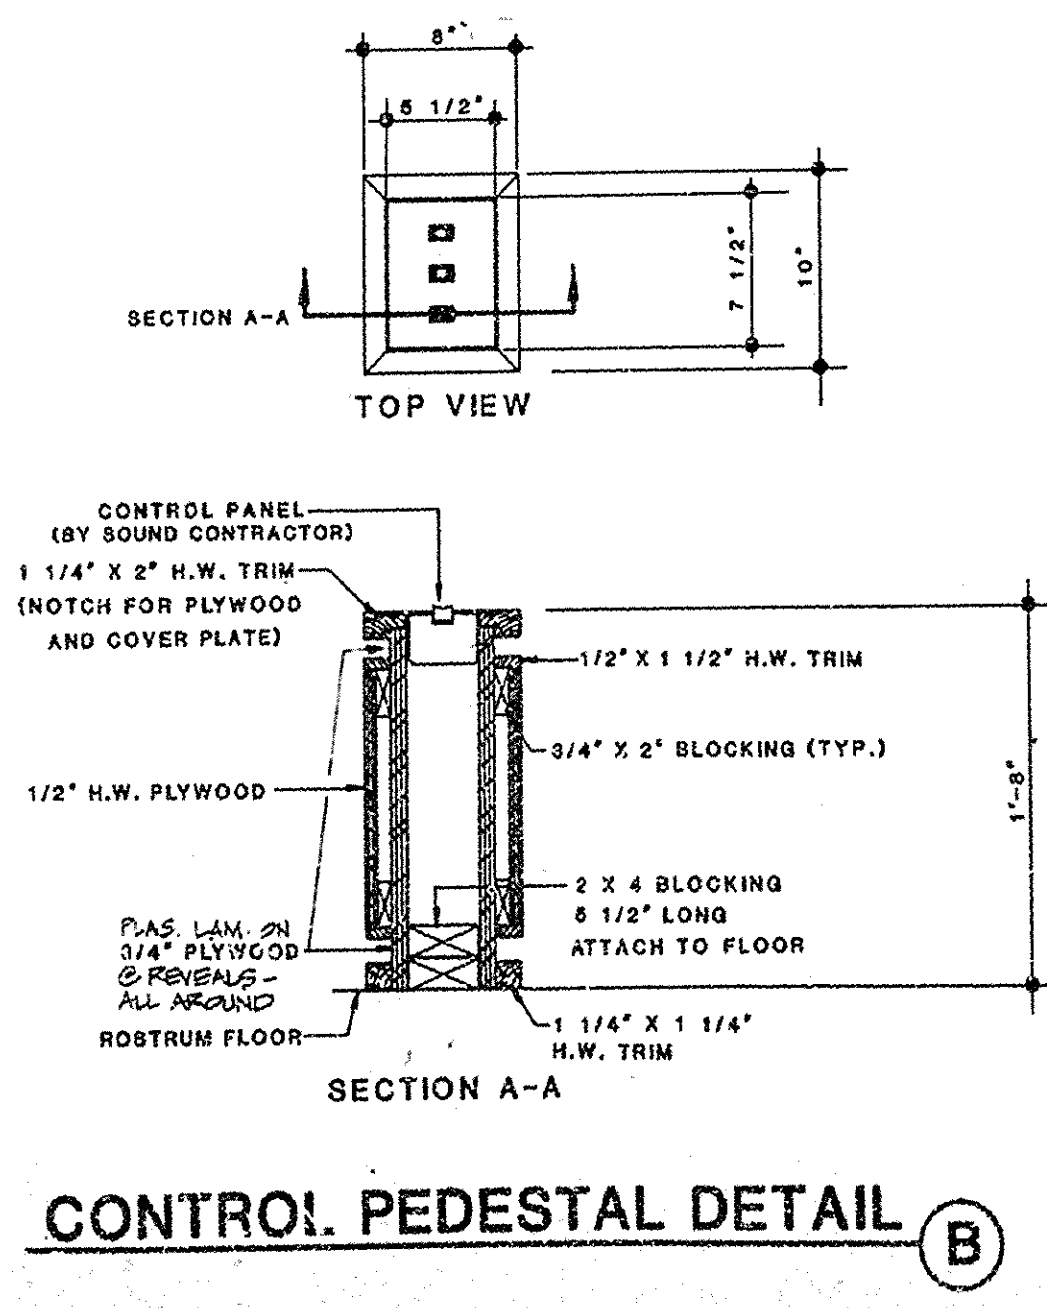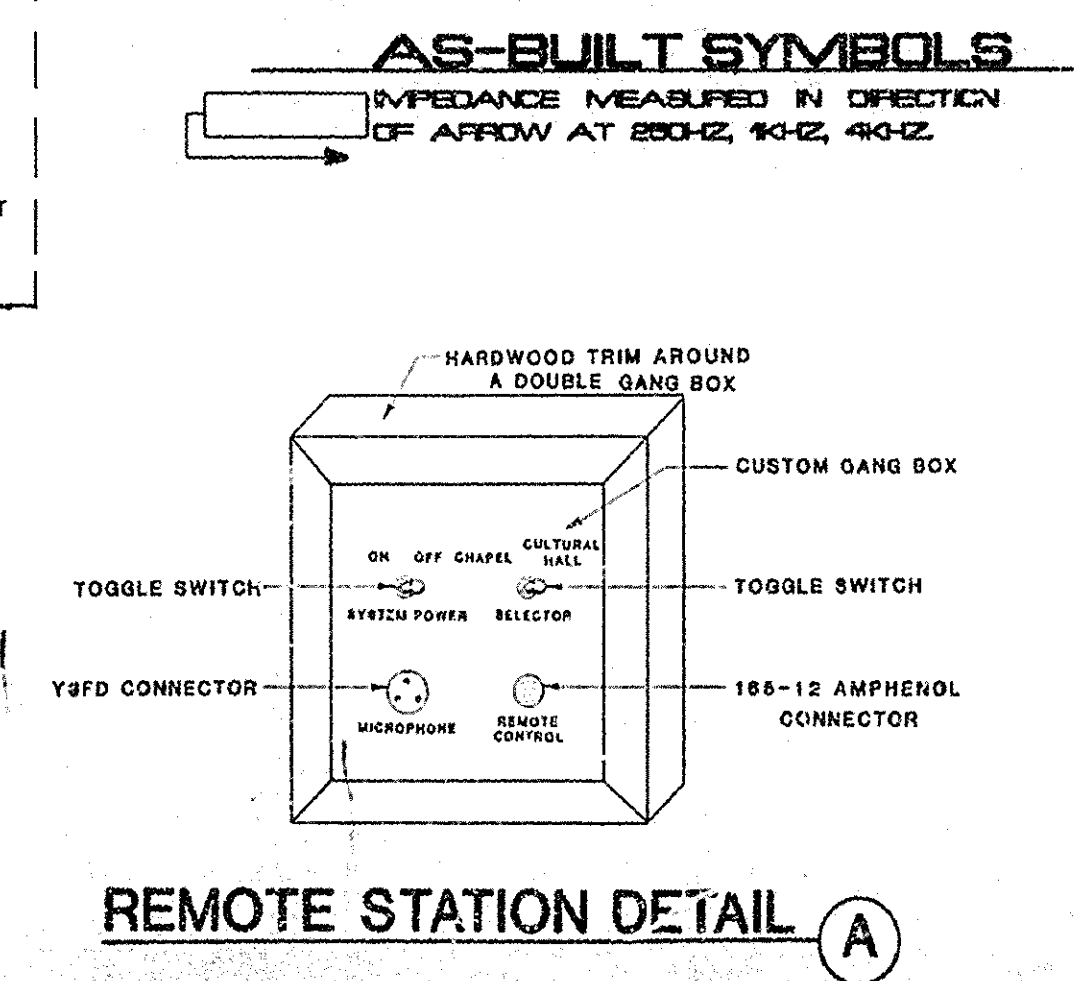

SOUND CONTRACTOR			
SYM	DESCRIPTION	QTY	MANUFACTURE & MODEL NUMBER
MS	Microphone	2	Electro-Voice RE-18 w/340 and Switchcraft A3F
MS	Microphone stand, pulpit	2	Atlas US-2 w/6" or 9" tube
MS	Microphone, multipurpose	2	Electro-Voice RE-18
MS	Microphone stand, stage	2	Electro-Voice 411A
MS	Microphone, sacrament	1	Existing
MS	Microphone stand, floor	1	Atlas MS-25 University UMS-103
MS	Multi-impedance box	1	IWE EJ-10
MS	Microphone cord	2	Audio-technica AT-6303/50 Electro-Voice 89724 Wireworks C50-01
MI	Microphone input	A/R	Switchcraft Y3FD w/wall plate
MO	Microphone output	1	Switchcraft GGP-3-63
TR	Transformer	A/R	Altec 15356A w/socket Sound Tech S070 w/socket
MIX	Mixer, automatic	1	IRP DE-4014
MIX	Mixer, automatic w/remote	1	IRP DE-4016 w/DE-207 & mating connectors
CP	Control pedestal	1	IWE PC-3 Marshall PC-3
TR	Tape recorder & satellite switch	1	Altec 15356A w/socket ATS M1070 w/socket
EQ	Equalizer	2	White 4400 w/4390
HI	Hearing Impaired	1	Com-tek PR-72b
HI		1	Com-tek SM-N
HI		1	Com-tek M-72 BS w/remote antenna
HI		1	Com-tek RHK-1
HI		1	Com-tek PI
A1	Amplifier 100 watt M2	1	Altec 1594B TDA P-912 w/HB-931
A2	Amplifier 200 watt M1	1	Altec 1590C TDA P-924 w/HB-931A
A3	Amplifier, inwall 10 watt M3	1	IWE 170 IW
OS	Overflow switch	A/R	DPST switch w/wall plate
VC	Volume control	A/R	Soundolier AT-10 w/wall plate
VC	Volume control	A/R	Soundolier AT-35
ST	Speaker transformer 4W	A/R	Electro-Voice TMS JBL 931SHT Sound Tech S049 Soundolier HT 47
ST	Speaker transformer 8W	A/R	Electro-Voice TM15 Sound Tech S054 Soundolier HT 87
SP	Speaker, 8" recessed	A/R	Altec 409-8D JBL 8140H Soundolier C803
SP	Speaker, 8" existing	A/R	Altec 409-8D JBL 8140H Soundolier C803
SP	Speaker, 4" recessed	A/R	Altec 405-8H JBL 8110H Soundolier FC104
SP	Speaker, 4" existing	A/R	Altec 405-8H JBL 8110H Soundolier FC104
SP	Speaker, 4" existing	A/R	Altec 405-8H JBL 8110H Soundolier FC104
SP	Speaker, 4" blind short	A/R	Altec 405-8H JBL 8110H Soundolier FC104
CP	Control plate	1	Custom
RS	Relay system	A/R	IWE GC-1, Marshall ESP 815

**NOTES:**  
 1. STAIN ALL EXPOSED WOOD TO MATCH EXISTING WOODWORK  
 2. MILLWORK PROVIDED BY GENERAL CONTRACTOR

DATE: 10-APR-87  
 REVISION:

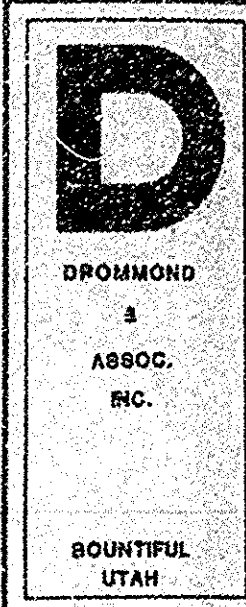

MENAN 1st & 2nd WARDS  
 MENAN IDAHO STAKE

SINGLE LINE DIAGRAM  
 AS-BUILT  
 103064

PROJECT NUMBER

507-2628-75

SHEET NUMBER


ES-1





EQUIPMENT RACK

VENT PANEL


REPAIRED HEARING TRANSMITTER  
CONTR. N-72  
SER. NO. 442829

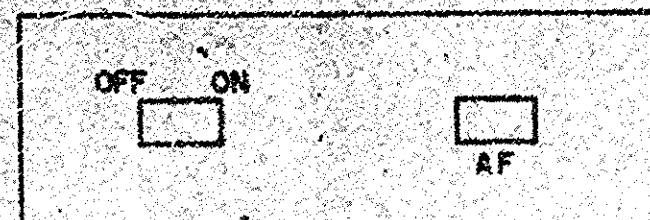

CHAPEL AMPLIFIER  
TOA P-924  
SER. NO. 447551

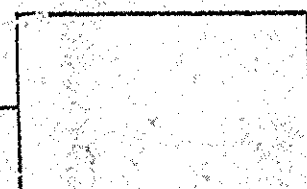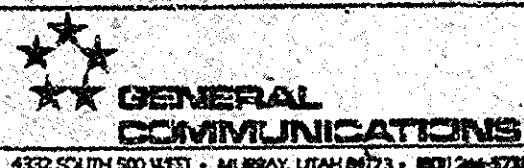

CULTURAL HALL  
TOA P-924  
SER. NO. 508259

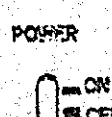

BLANK PANEL

BLANK PANEL


CULTURAL HALL MIXER  
RP 4016  
SER. NO. 88023721




CHAPEL MIXER  
RP 4014  
SER. NO. 87094780



CULTURAL HALL EQUALIZER  
WHITE 4400  
SER. NO. 65326

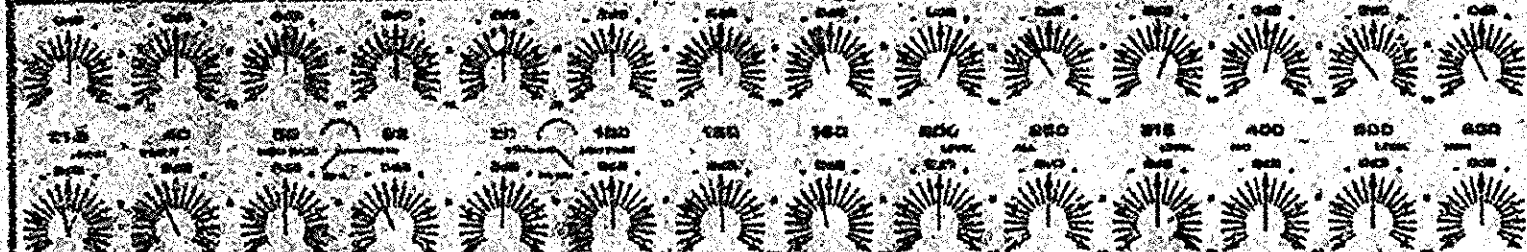

CHAPEL EQUALIZER  
WHITE 4400  
SER. NO. 65376

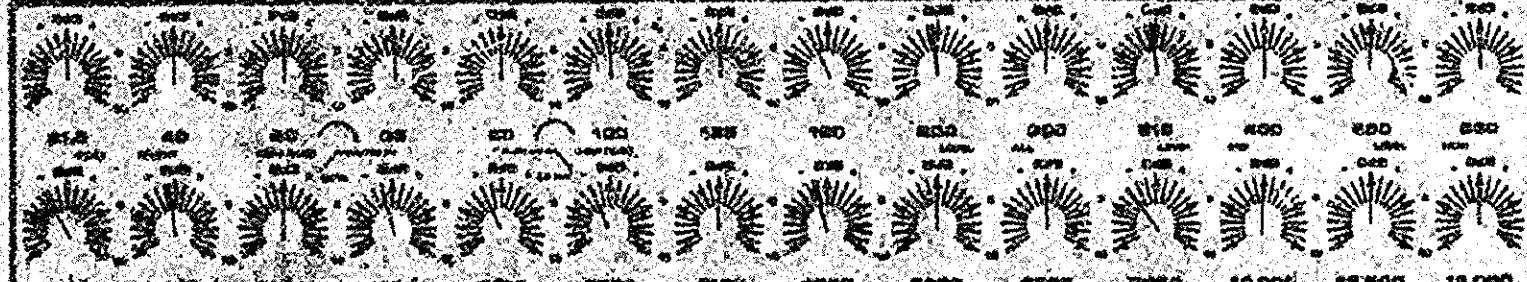

VENT PANEL

DATE INSTALLED 2-26-88  
DATE OF 2nd EQ. 7-6-88

PLEASE NOTE:

THIS SOUND SYSTEM HAS BEEN CAREFULLY BALANCED AND EQUALIZED FOR OPTIMUM RESULTS. CHANGING CONTROL SETTINGS FROM THOSE SHOWN ON DRAWING WILL SERIOUSLY DEGRADE PERFORMANCE AND VOID WARRANTY. FOR SERVICE OR ASSISTANCE PLEASE CALL GENERAL COMMUNICATIONS SERVICE DEPARTMENT (801) 266-5721.

CONTRACTORS

NAME	ADDRESS
OK CONSTRUCTION, INC.	P.O. Box 1387 3195 No. YELLOWSTONE IDAHO FALLS, ID 83403
HALE ELECTRIC	ROUTE 2 Box 376B IDAHO FALLS, ID 83401

GENERAL COMMUNICATIONS INSTALLERS

NAME	DATE COMPLETED
BRAD HARRIS	2-26-88
TIM TAYLOR 2 <sup>ND</sup> EQ	7-6-88

OWNERS REPRESENTATIVES TRAINED ON SYSTEM

NAME	POSITION	DATE
MIKE McLOW		2-27-88
VIOLA HALL	CUSTODIAN	7-6-88

REVISIONS

GENERAL COMMUNICATIONS  
4322 SOUTH 500 WEST  
ALBANY, UTAH 84703  
(801) 266-5721

PROJ. NO. 103064

DATE JAN 19 1989

PROJECT TITLE

MENAN 1,2 WARDS  
507-2628  
AS-BUILT


SHEET

ES-2






File Name: P:\2013\20130380\Drawings\3Sheet\80E-1.dwg Last Plotted: 2014/01/07 @ 3:25 PM By: dxh

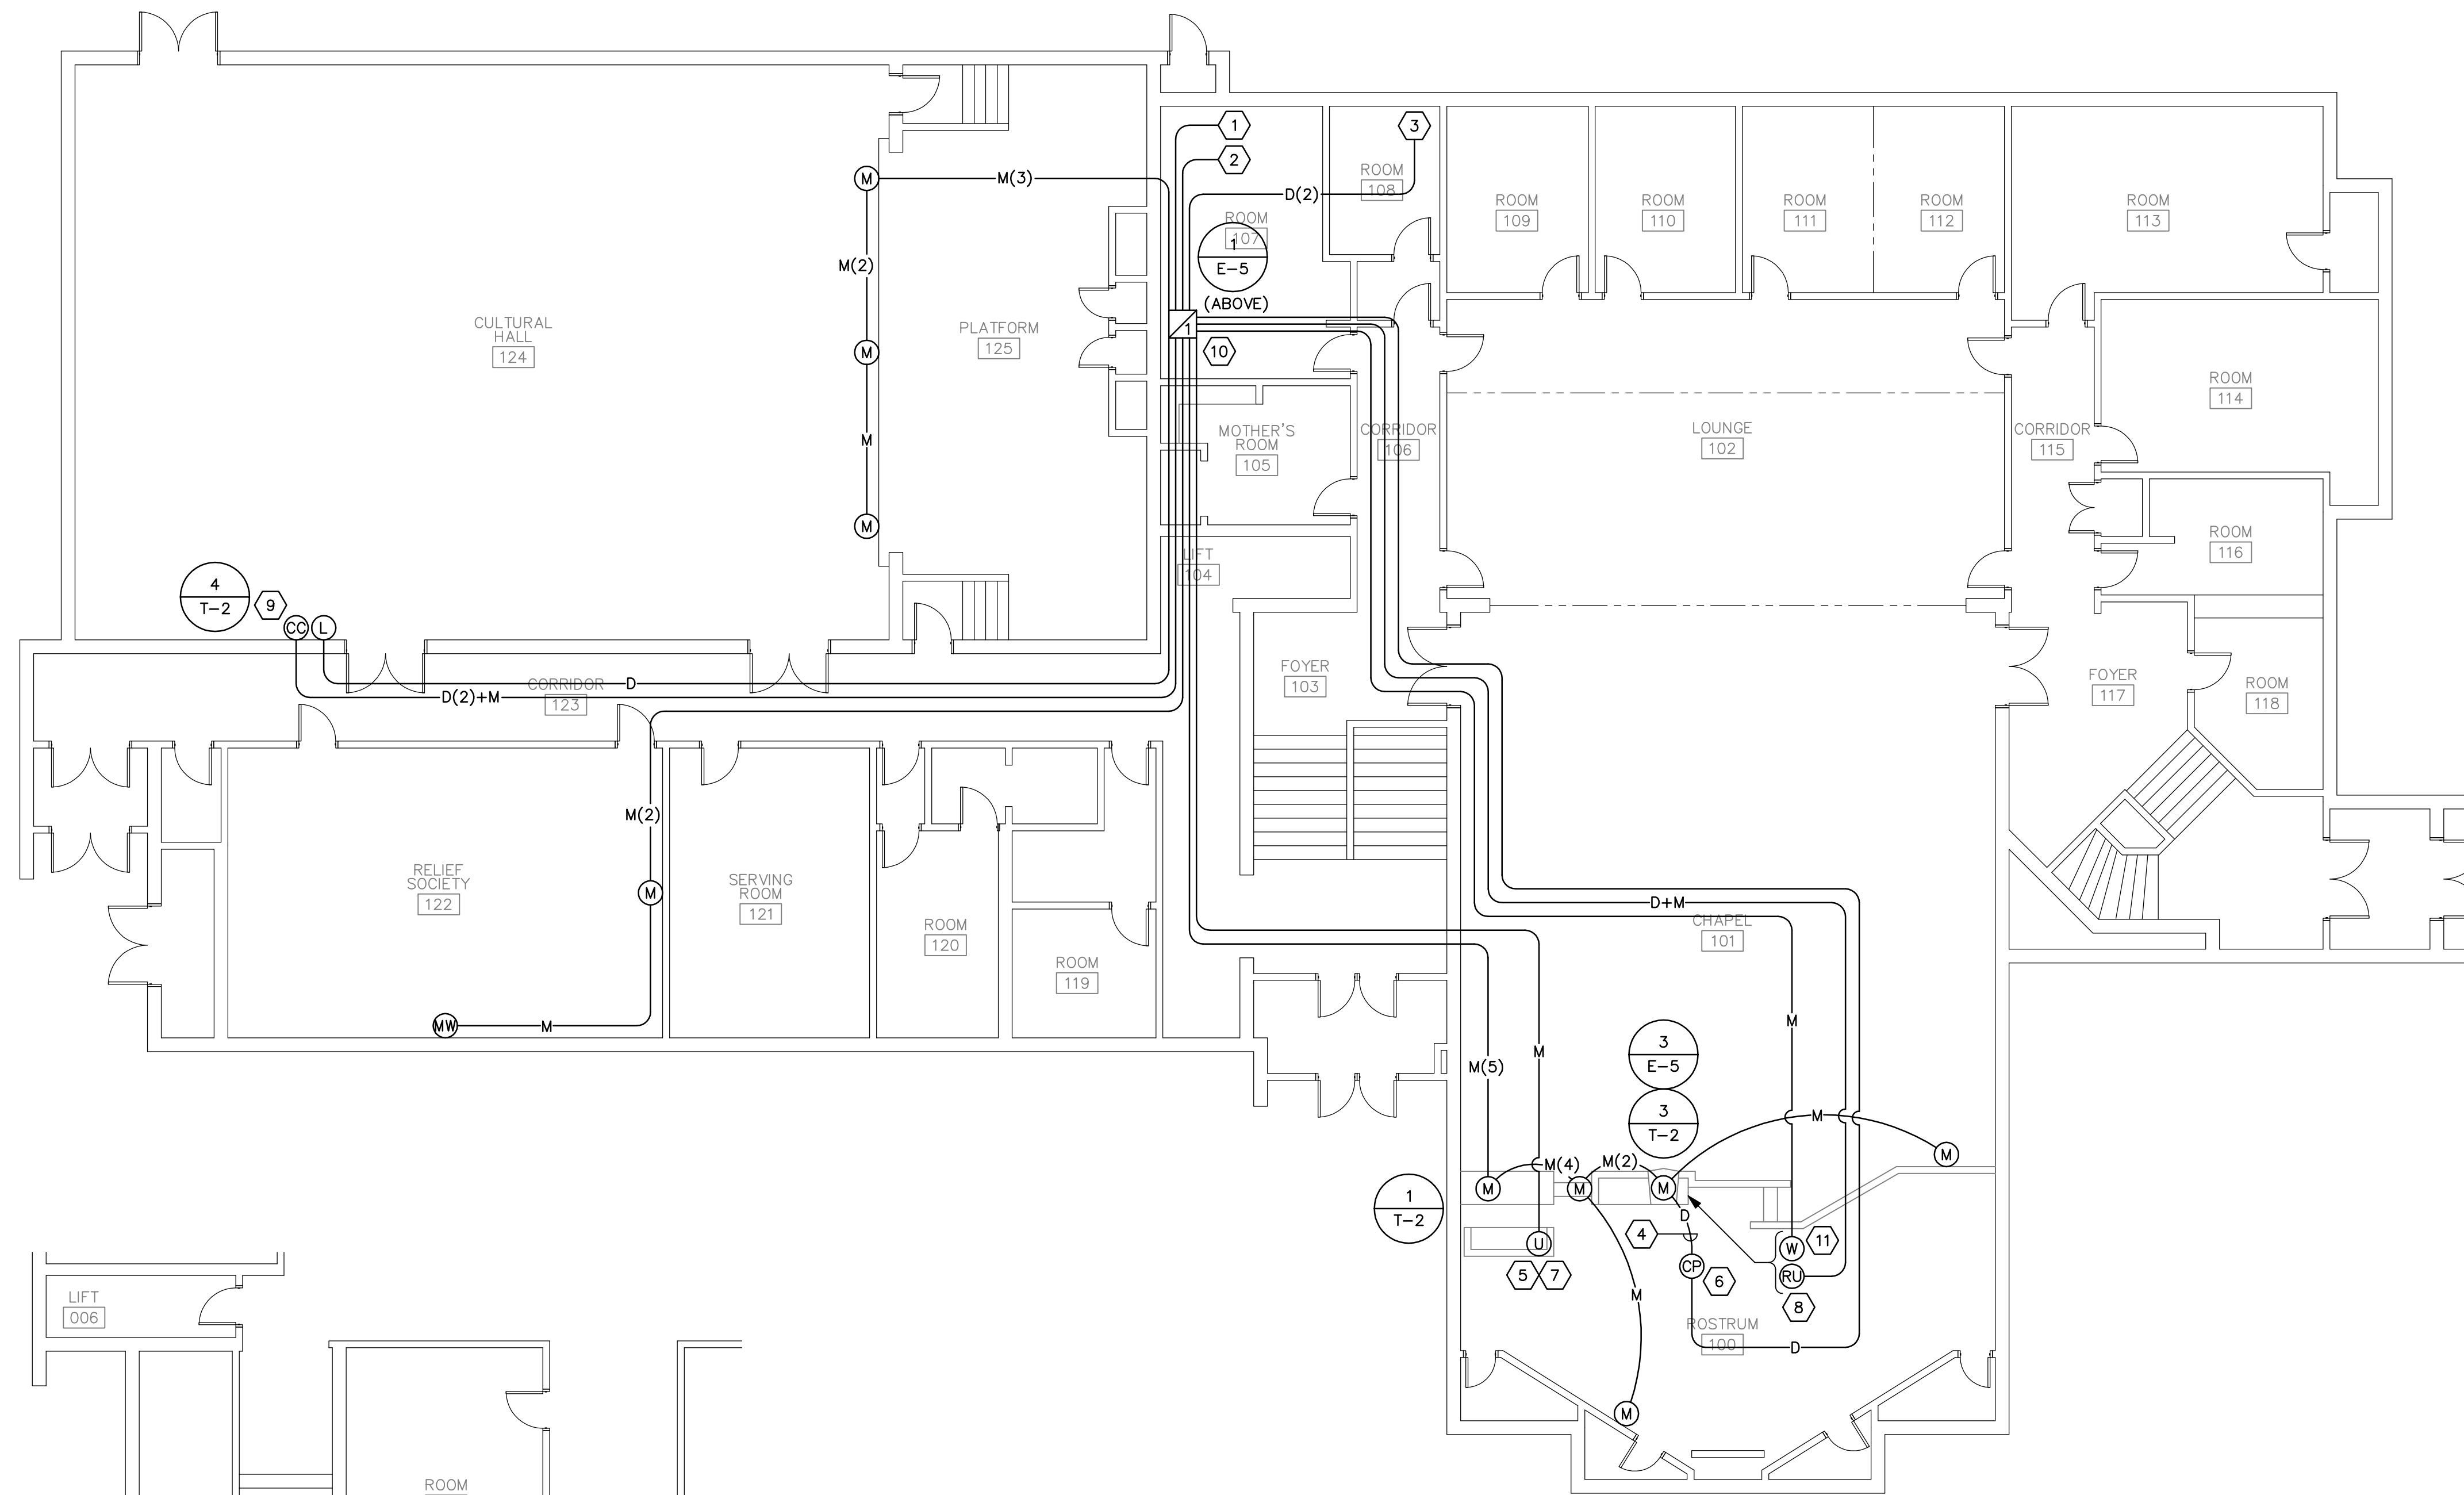

**2 MAIN FLOOR MICROPHONE LAYOUT PLAN**  
1/8" = 1'-0"

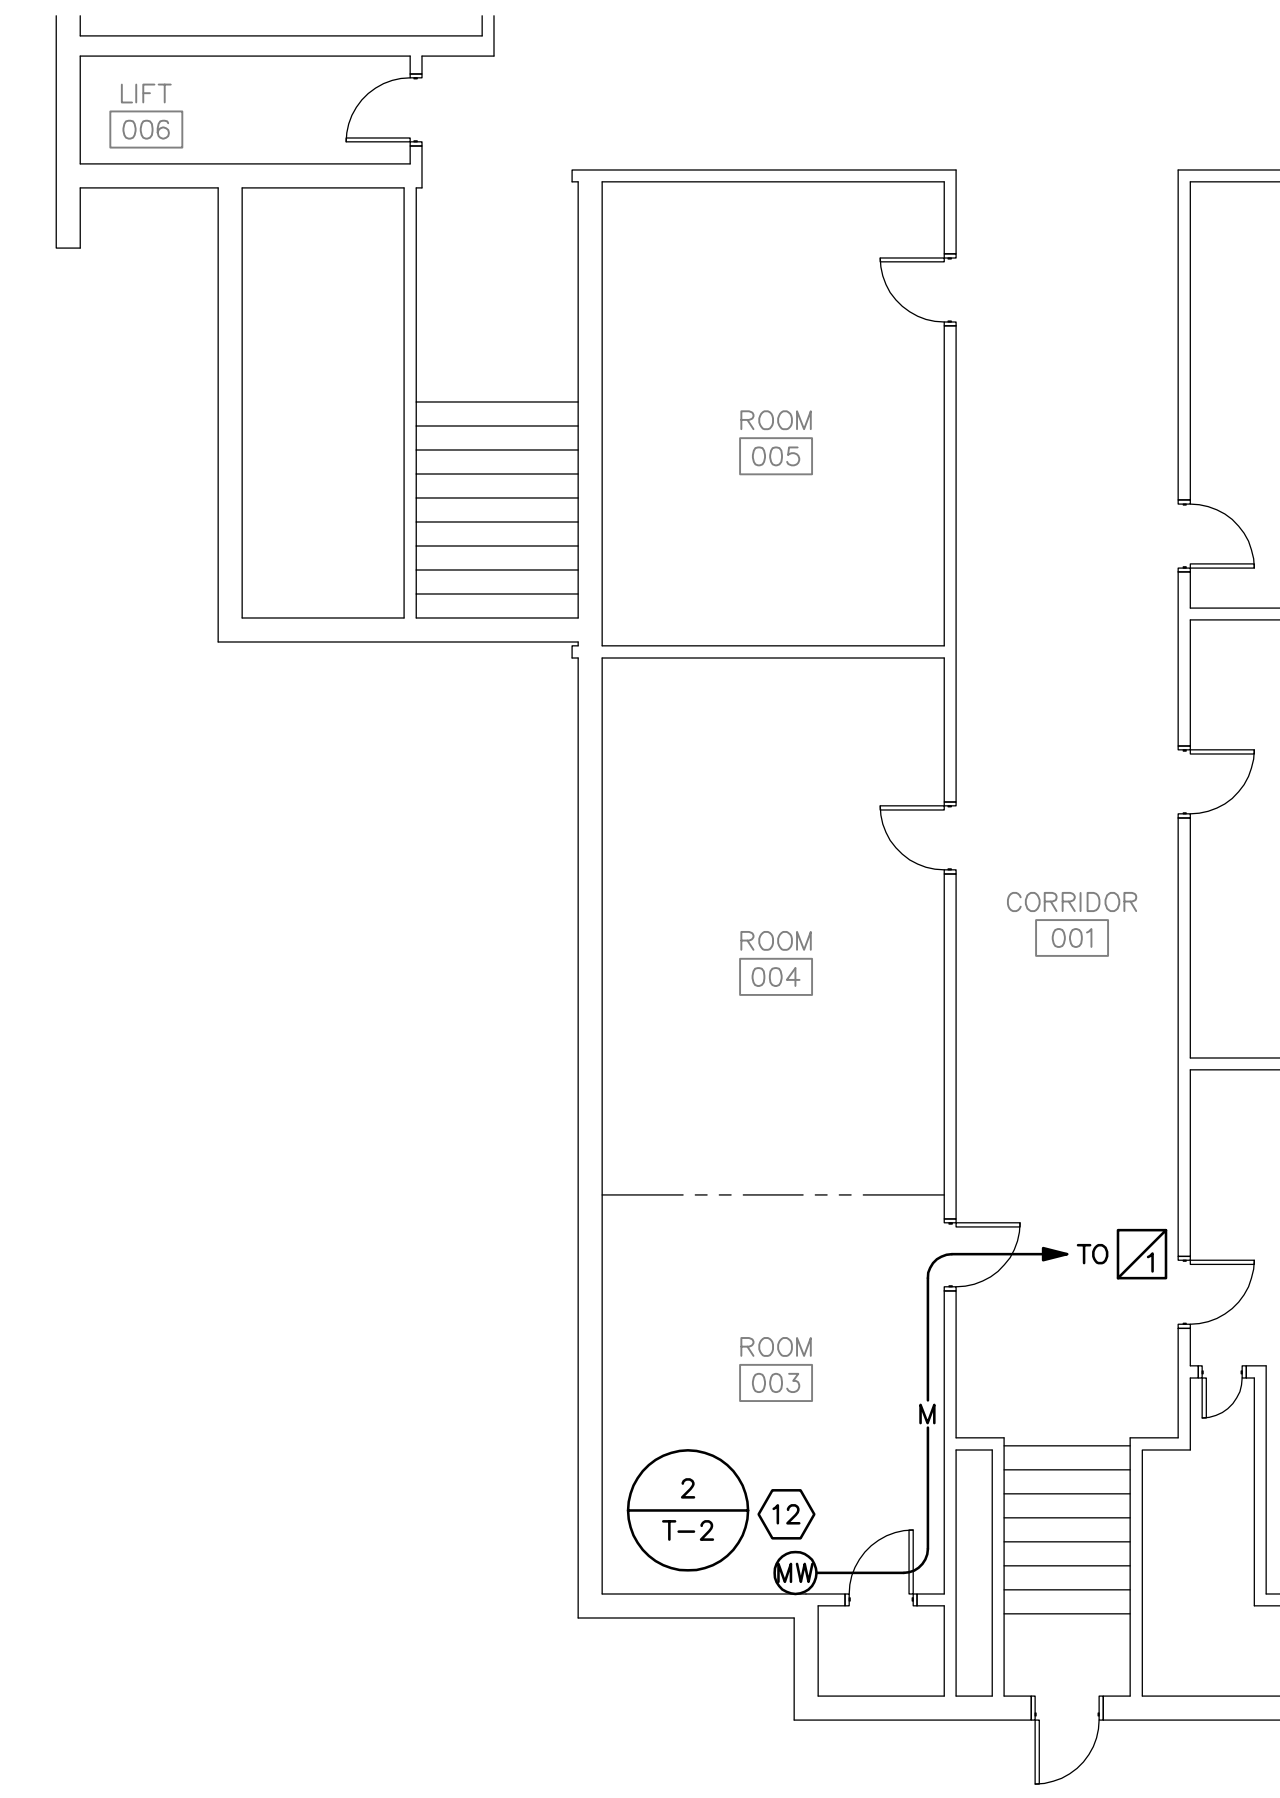

**1 BASEMENT MICROPHONE LAYOUT PLAN**  
1/8" = 1'-0"

**GENERAL SHEET NOTES**

1. UNLESS NOTE, EXISTING CABLES MAY BE REUSED IF THEY ARE WITHOUT SPLICES AND CABLE PERFORMANCE EQUALS OR EXCEEDS SPECIFIED CABLE.
2. CONDUIT IS NOT REQUIRED IN EXISTING PORTIONS OF THE BUILDING WITH THE EXCEPTION OF WHERE EXPOSED TO VIEW. CABLE THAT IS EXPOSED TO VIEW MUST BE CONCEALED IN SURFACE RACEWAY OR WOOD TRIM. OBTAIN APPROVAL FROM THE FM MANAGER PRIOR TO INSTALLATION OF ANY SURFACE MOUNTED RACEWAY.
3. ALL OBSOLETE SOUND EQUIPMENT WILL REMAIN PROPERTY OF THE OWNER. REMOVE AND DELIVER TO THE FM GROUP.
4. CEILING MOUNTED SPEAKERS SHALL BE INSTALLED IN A SYMMETRICAL PATTERN AS SHOWN ON DRAWINGS. IF ANY SPEAKER MUST BE MOVED MORE THAN ONE FOOT, CONTACT SOUND/ACOUSTICAL CONSULTANT.
5. SOUND SYMBOLS ARE NOT SHOWN TO SCALE. IF THERE IS ANY QUESTION REGARDING THE EXACT COMPONENT LOCATION, CONTACT SOUND/ACOUSTICAL CONSULTANT.
6. REFER TO DRAWINGS FOR EXACT NUMBER OF COMPONENTS WHERE QUANTITIES ARE NOT IDENTIFIED IN THE EQUIPMENT LIST.
7. SOUND CONTRACTOR WILL BE RESPONSIBLE TO COORDINATE ELECTRICAL WORK WITH FM GROUP.
8. UNLESS NOTED, INSTALL ALL NEWLY SPECIFIED SPEAKER ENCLOSURES AND CABLE IN A RECESSED FASHION. NEWLY INSTALLED SURFACE MOUNTED SPEAKER ENCLOSURES AND CABLE WILL NOT BE ACCEPTED.
9. IF EXISTING CABLE THAT IS CURRENTLY SURFACE MOUNTED IS REPLACED, INSTALL THE NEW CABLE IN THE SAME FASHION OR IN A FULLY RECESSED MANNER.
10. LOOP EXTRA CABLES THROUGH JUNCTION BOXES. DO NOT CUT. DO NOT INSTALL DIFFERENT CABLE TYPES WITHIN THE SAME CONDUIT.
11. PROVIDE HARDWOOD SURROUNDS WITH ROUNDED CORNERS FOR ALL NEW AND EXISTING SURFACE MOUNTED BOXES.

**SHEET KEYNOTES**

1. PROVIDE 1 EACH #6 THHN WITH GREEN INSULATION TO THE MAIN ELECTRICAL PANEL GROUND BUS. AFFIX AT EACH END.
2. PROVIDE 1 EACH 1" CONDUIT TO ACCESSIBLE ATTIC SPACE FOR HEARING ASSISTANCE TRANSMITTER ANTENNA.
3. BUILDING NETWORK EQUIPMENT LOCATION. REPLACE EXISTING 8-PORT SWITCH WITH 16-PORT SWITCH AND CONNECT DATA CABLES FROM SOUND RACK.
4. TO PULPIT MOTOR CONTROL.
5. REMOVE EXISTING DEVICE AND CABLE. COVER LOCATION WITH A BLANK PLATE. COLOR OF PLATE TO MATCH ELECTRICAL DEVICES.
6. REMOVE EXISTING CONTROL PANEL. INSTALL NEW AUDIO CONTROL PANEL ON EXISTING CONTROL PEDESTAL.
7. REPLACE EXISTING AUX OUT JACK AND REMOVE OBSOLETE CABLES. HOMERUN NEW CABLES FROM DEVICES TO SOUND EQUIPMENT CABINET. DRESS LOCATION.
8. REMOVE EXISTING DEVICE(S) AND CABLE. INSTALL INDICATED DEVICE(S) IN EXISTING LOCATION.
9. REMOVE EXISTING CULTURAL CENTER CONTROL PANEL AND SURFACE BOX. MOUNT NEW CULTURAL CENTER CONTROL IN SAME LOCATION. PATCH AREA AS NEEDED.
10. REMOVE EXISTING EQUIPMENT CABINET AND CABLES. DELIVER OBSOLETE EQUIPMENT TO OWNER. INSTALL NEW CABINET IN SAME LOCATION.
11. INSTALL NEW SINGLE GANG JUNCTION BOX WITH INDICATED DEVICE ON SIDE OF PULPIT ABOVE EXISTING SINGLE GANG BOX AT OUTLET HEIGHT.
12. REMOVE EXISTING IN-WALL AMPLIFIER AND CABLES. COVER BOX WITH A BLANK METAL PLATE, PAINTED TO MATCH SURROUNDING SURFACE. INSTALL INDICATED DEVICES FLUSH IN PLATE.

**SYMBOL LEGEND**

- (M) SINGLE MICROPHONE INPUT
- (MW) MICROPHONE / LINE LEVEL INPUT
- (RU) NETWORK/ SOUND SYSTEM OUT
- (CC) CULTURAL CENTER AUDIO CONTROL PANEL
- (U) RECORD JACK
- (CP) CHAPEL AUDIO CONTROL PANEL
- (W) LINE LEVEL INPUT
- (L) CHAPEL OVERFLOW SWITCH

MARK	DATE	REVISION
	01-07-14	RECORD DRAWINGS



**SPECTRUM ENGINEERS**  
324 S. State St., Suite 400  
Salt Lake City, UT 84111  
801-678-7077  
801-328-5151  
fax: 801-328-5155  
www.spectrum-engineers.com

© 2014 Spectrum Engineers, Inc.

THESE RECORD DOCUMENTS HAVE BEEN PREPARED BASED ON INFORMATION PROVIDED BY OTHERS. THE DESIGN PROFESSIONAL HAS NOT VERIFIED THE ACCURACY AND/OR COMPLETENESS OF THIS INFORMATION AND SHALL NOT BE RESPONSIBLE FOR ANY ERRORS OR OMISSIONS WHICH MAY BE INCORPORATED HEREIN AS A RESULT.

PROJECT FOR  
**THE CHURCH OF JESUS CHRIST OF LATTER-DAY SAINTS**


PROJECT NAME  
MENAN 2, 3 SOUND SYSTEM UPGRADE

PROJECT ADDRESS  
3547 E. MENAN-LORENZO HIGHWAY  
MENAN, IDAHO


SHEET TITLE  
MAIN FLOOR MICROPHONE LAYOUT PLAN

PROJECT DESIGNATION 20130380.AWA	
PROPERTY NUMBER 507-2638	SHEET NO. E-1
DEVELOPMENT NUMBER CUSTOM	
DATE 22 AUG 2013	

File Name: P:\2013\20130380\Drawings\3Sheet\80E-2.dwg Last Plotted: 2014/01/07 @ 3:25 PM By: dxh

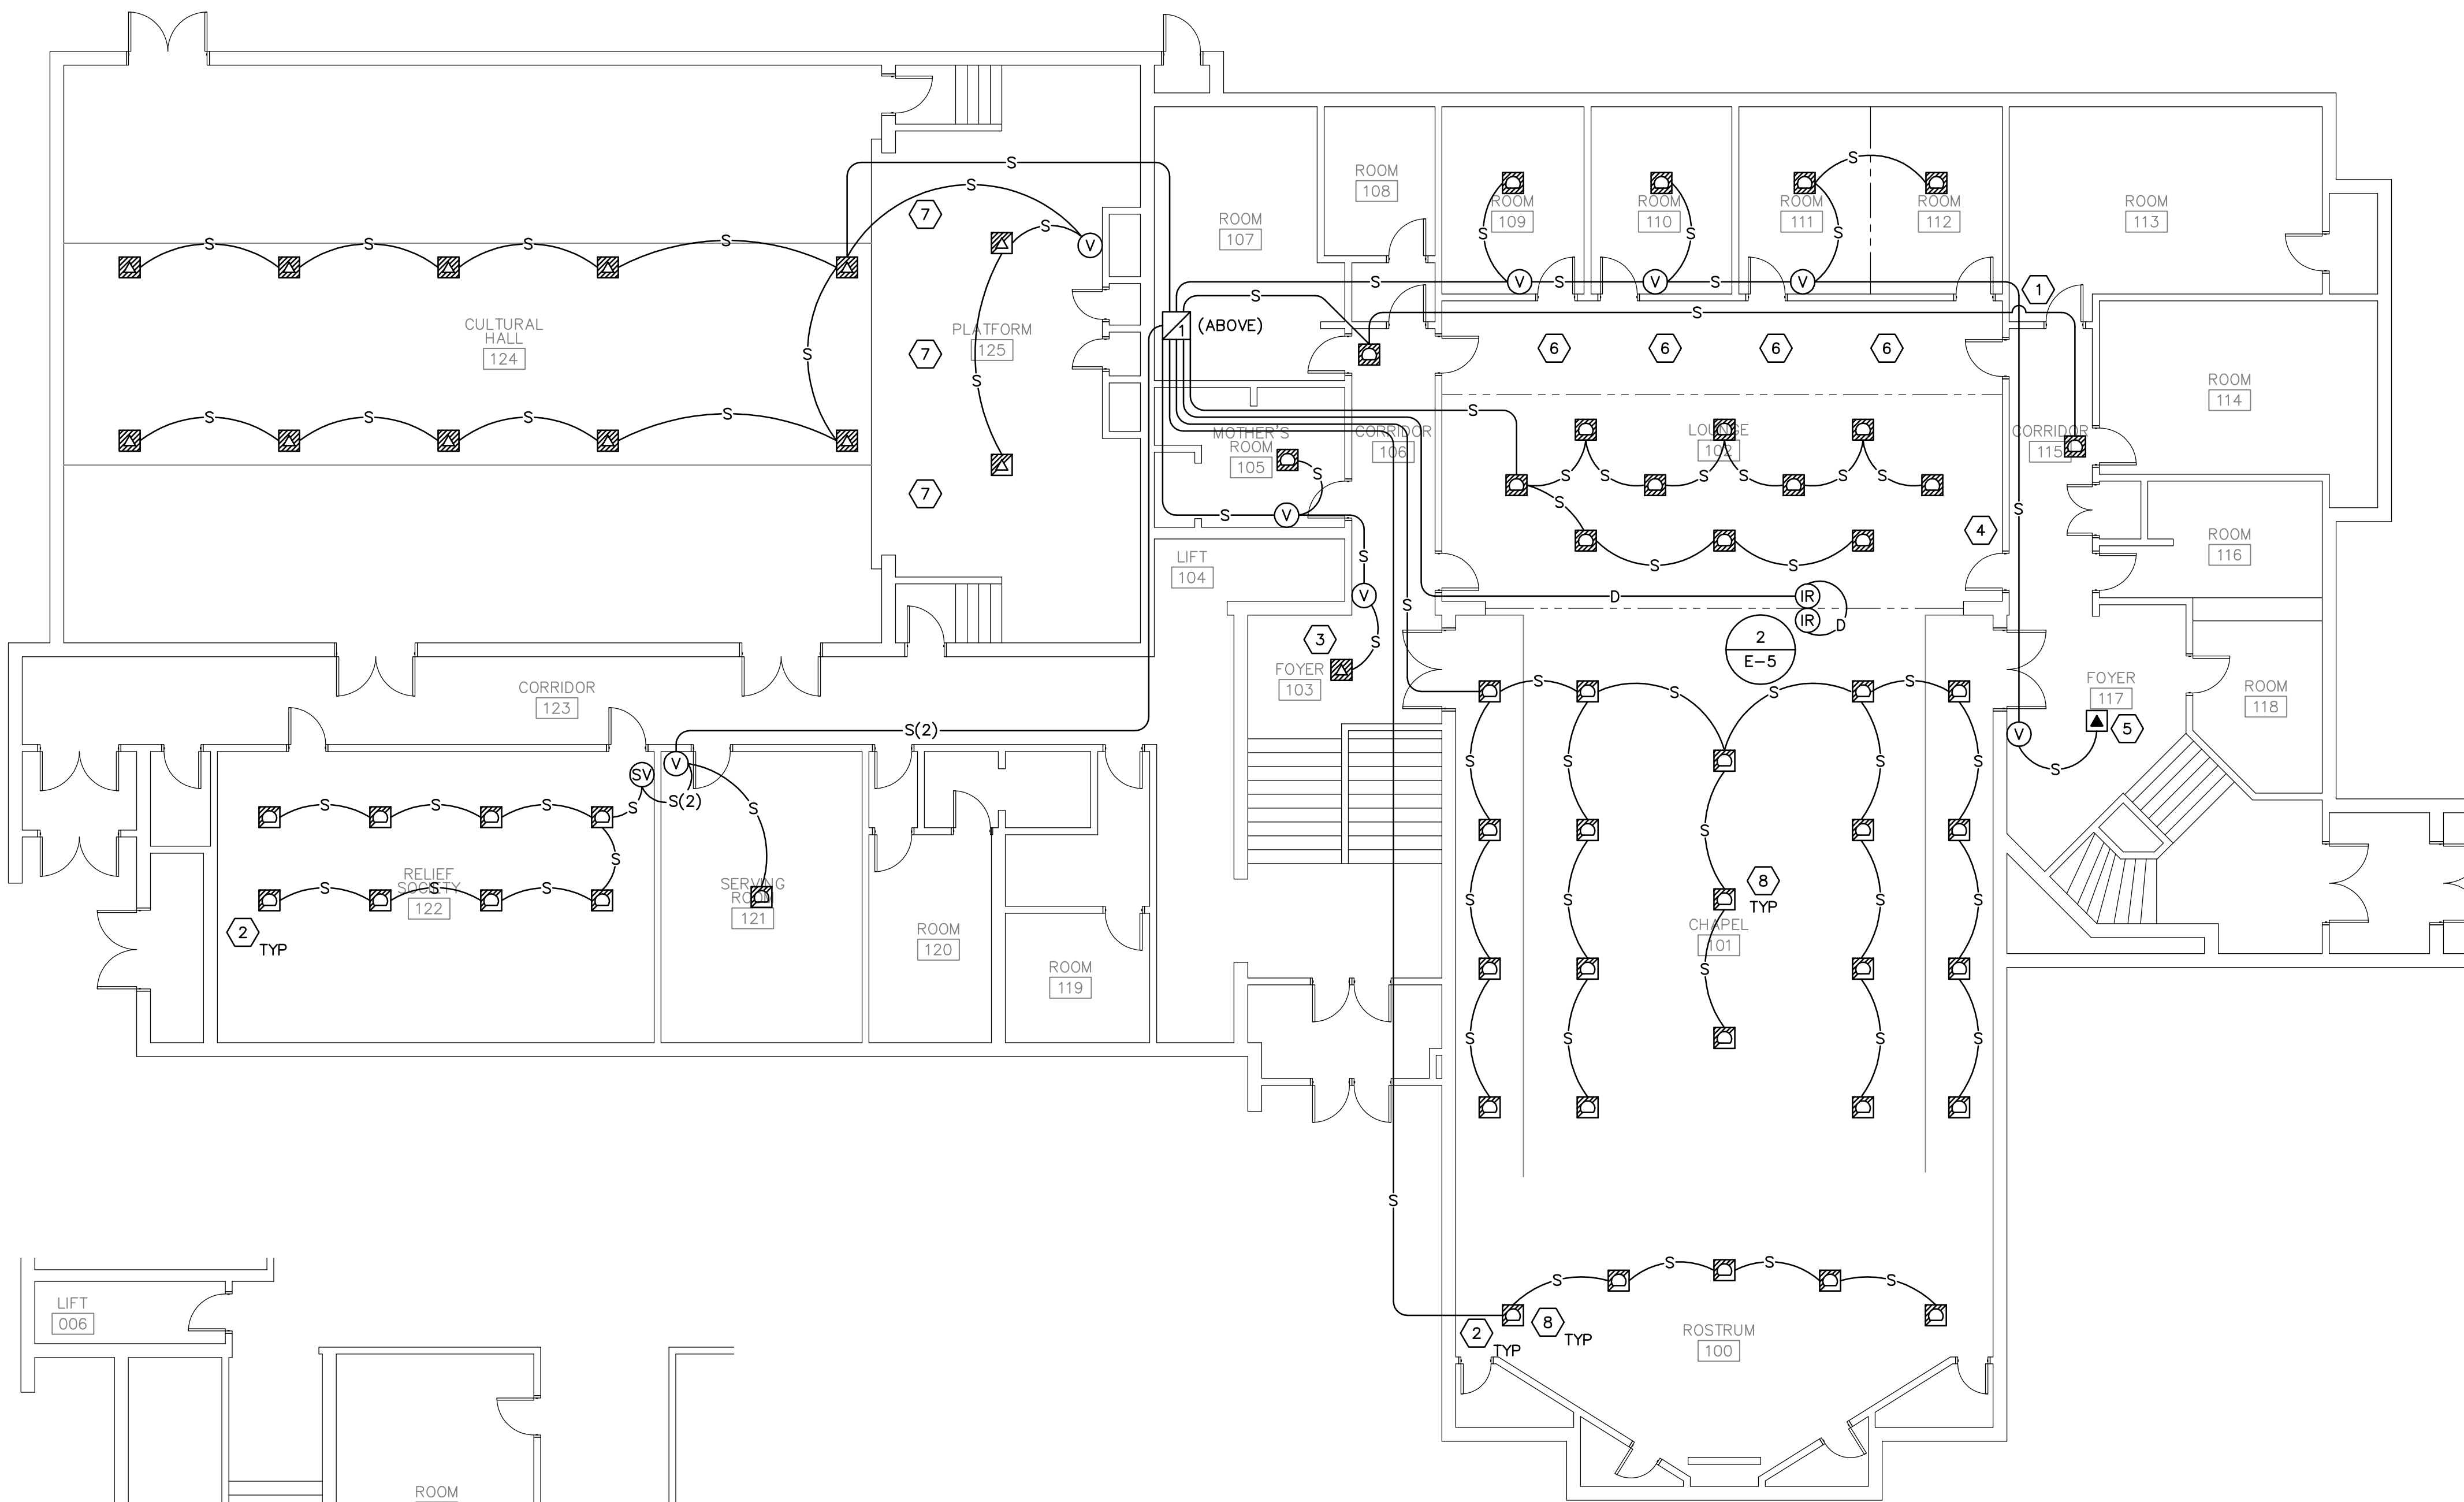

**2 MAIN FLOOR SPEAKER LAYOUT PLAN**  
1/8" = 1'-0"

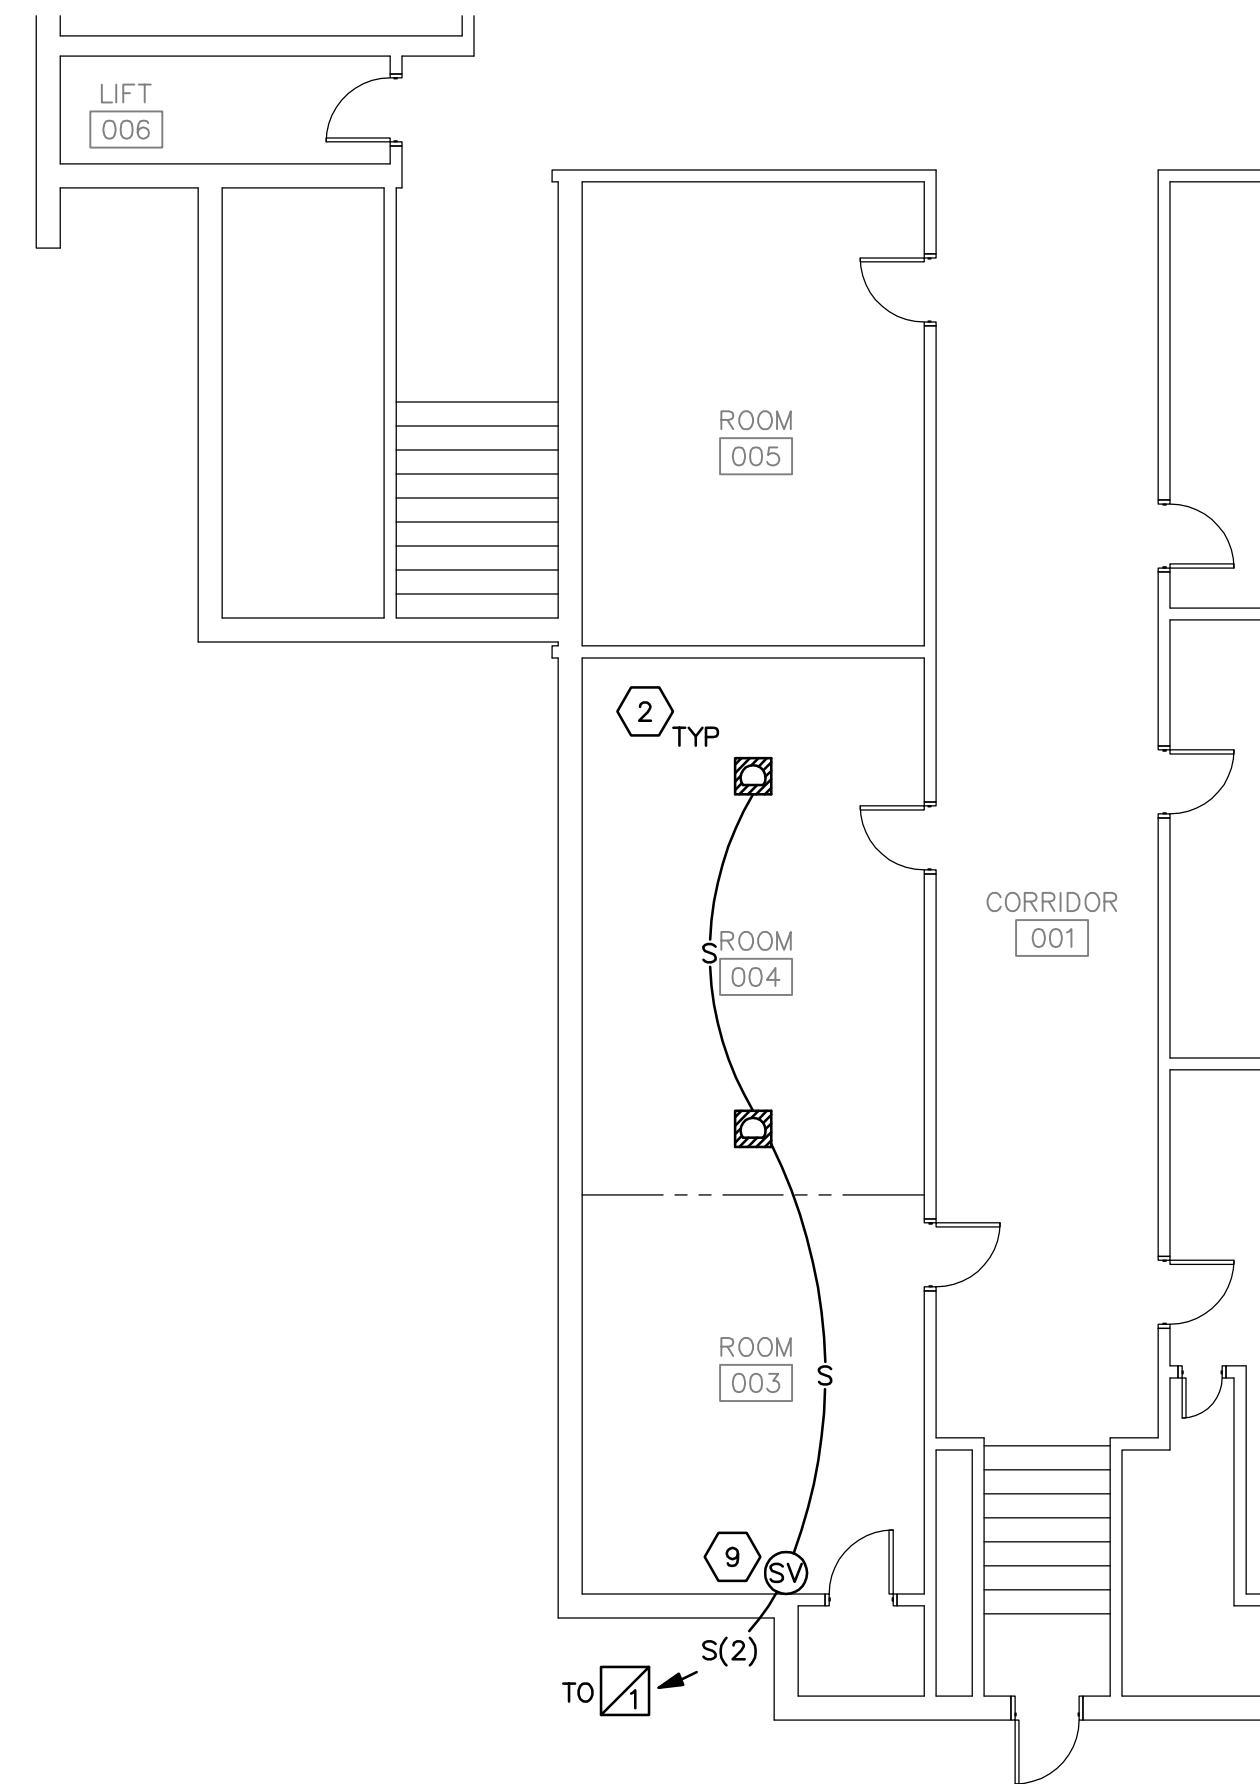

**1 BASEMENT SPEAKER LAYOUT PLAN**  
1/8" = 1'-0"

- SHEET KEYNOTES**
1. REMOVE WALL SPEAKER AND COVER BACKBOX WITH A BLANK NYLON COVER PLATE. PATCH LOCATION AS NECESSARY.
  2. INSTALL FIBERGLASS INSULATION IN ALL NEW AND EXISTING SPEAKER ENCLOSURES AS REQUIRED.
  3. REPLACE EXISTING SQUARE 8" SPEAKER GRILLE.
  4. REMOVE EXISTING DEVICE AND CABLE. COVER BACK BOX WITH BLANK NYLON COVER PLATE. COLOR OF PLATE TO MATCH ELECTRICAL DEVICES.
  5. REPLACE EXISTING BACKCAN AND ADD TILE BRIDGE.
  6. ABANDON EXISTING 4" SPEAKERS.
  7. REMOVE EXISTING CEILING MOUNTED MICROPHONE INPUT AND CABLE. COVER BOX WITH A BLANK NYLON COVER PLATE TO MATCH ELECTRICAL DEVICES.
  8. ADD BACKCAN TO EXISTING SPEAKER LOCATIONS, AS NEEDED.
  9. REMOVE EXISTING IN-WALL AMPLIFIER AND CABLES. COVER BOX WITH A BLANK METAL PLATE, PAINTED TO MATCH SURROUNDING SURFACE. INSTALL INDICATED DEVICES FLUSH IN PLATE.

- SYMBOL LEGEND**
- (V) SOUND SYSTEM VOLUME CONTROL
  - (SV) SOUND SYSTEM SOURCE SELECT/VOLUME CONTROL
  - (IR) INFRARED SENSORS

MARK	DATE	REVISION
	01-07-14	RECORD DRAWINGS

**SPECTRUM ENGINEERS**  
324 S. State St., Suite 400  
Salt Lake City, UT 84111  
800-678-7077  
801-328-5151  
fax: 801-328-5155  
www.spectrum-engineers.com

© 2014 Spectrum Engineers, Inc.  
THESE RECORD DOCUMENTS HAVE BEEN PREPARED BASED ON INFORMATION PROVIDED BY OTHERS. THE DESIGN PROFESSIONAL HAS NOT VERIFIED THE ACCURACY AND/OR COMPLETENESS OF THIS INFORMATION AND SHALL NOT BE RESPONSIBLE FOR ANY ERRORS OR OMISSIONS WHICH MAY BE INCORPORATED HEREIN AS A RESULT.



PROJECT FOR  
**THE CHURCH OF JESUS CHRIST OF LATTER-DAY SAINTS**  
PROJECT NAME  
MENAN 2, 3 SOUND SYSTEM UPGRADE  
PROJECT ADDRESS  
3547 E. MENAN-LORENZO HIGHWAY  
MENAN, IDAHO

SHEET TITLE  
MAIN FLOOR SPEAKER LAYOUT PLAN


PROJECT DESIGNATION 20130380.AWA	
PROPERTY NUMBER 507-2638	SHEET NO. E-2
DEVELOPMENT NUMBER CUSTOM	
DATE 22 AUG 2013	




File Name: P:\2013\20130380\Drawings\3Sheet\80E-3.dwg Last Plotted: 2014/01/07 @ 3:25 PM By: dxh

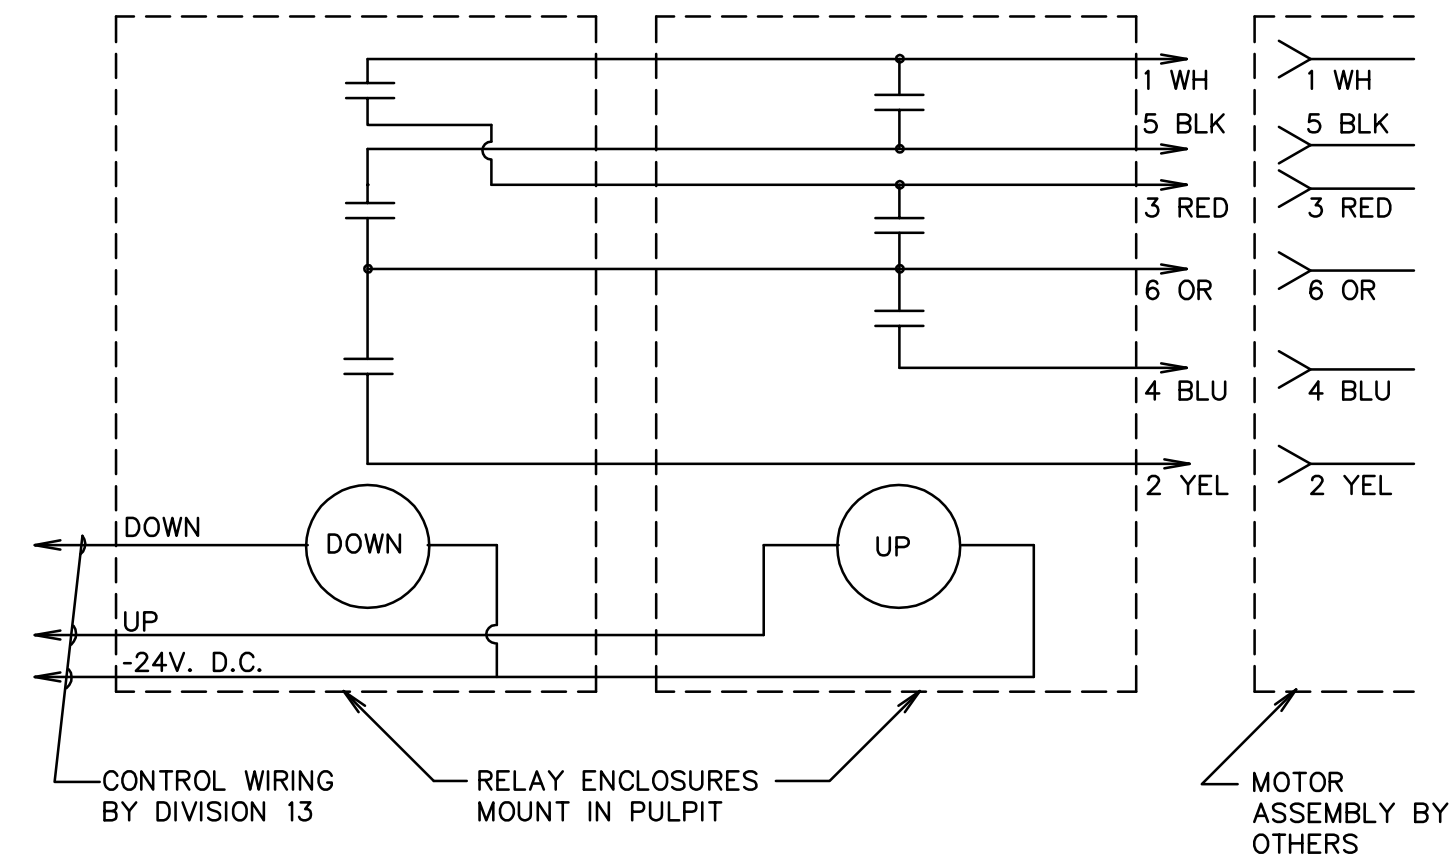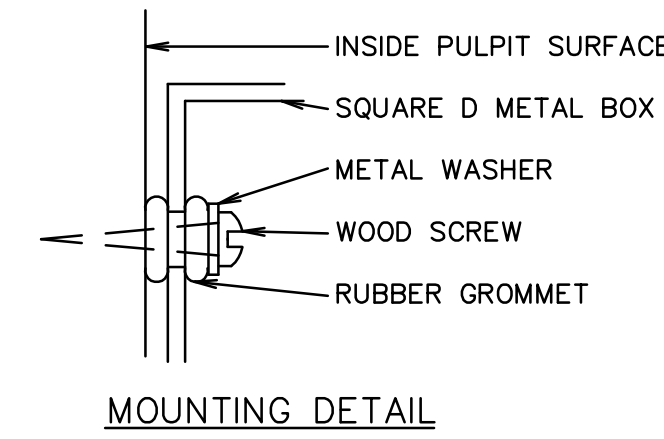


**3** PULPIT MOTOR CONTROL DIAGRAM  
 NO SCALE

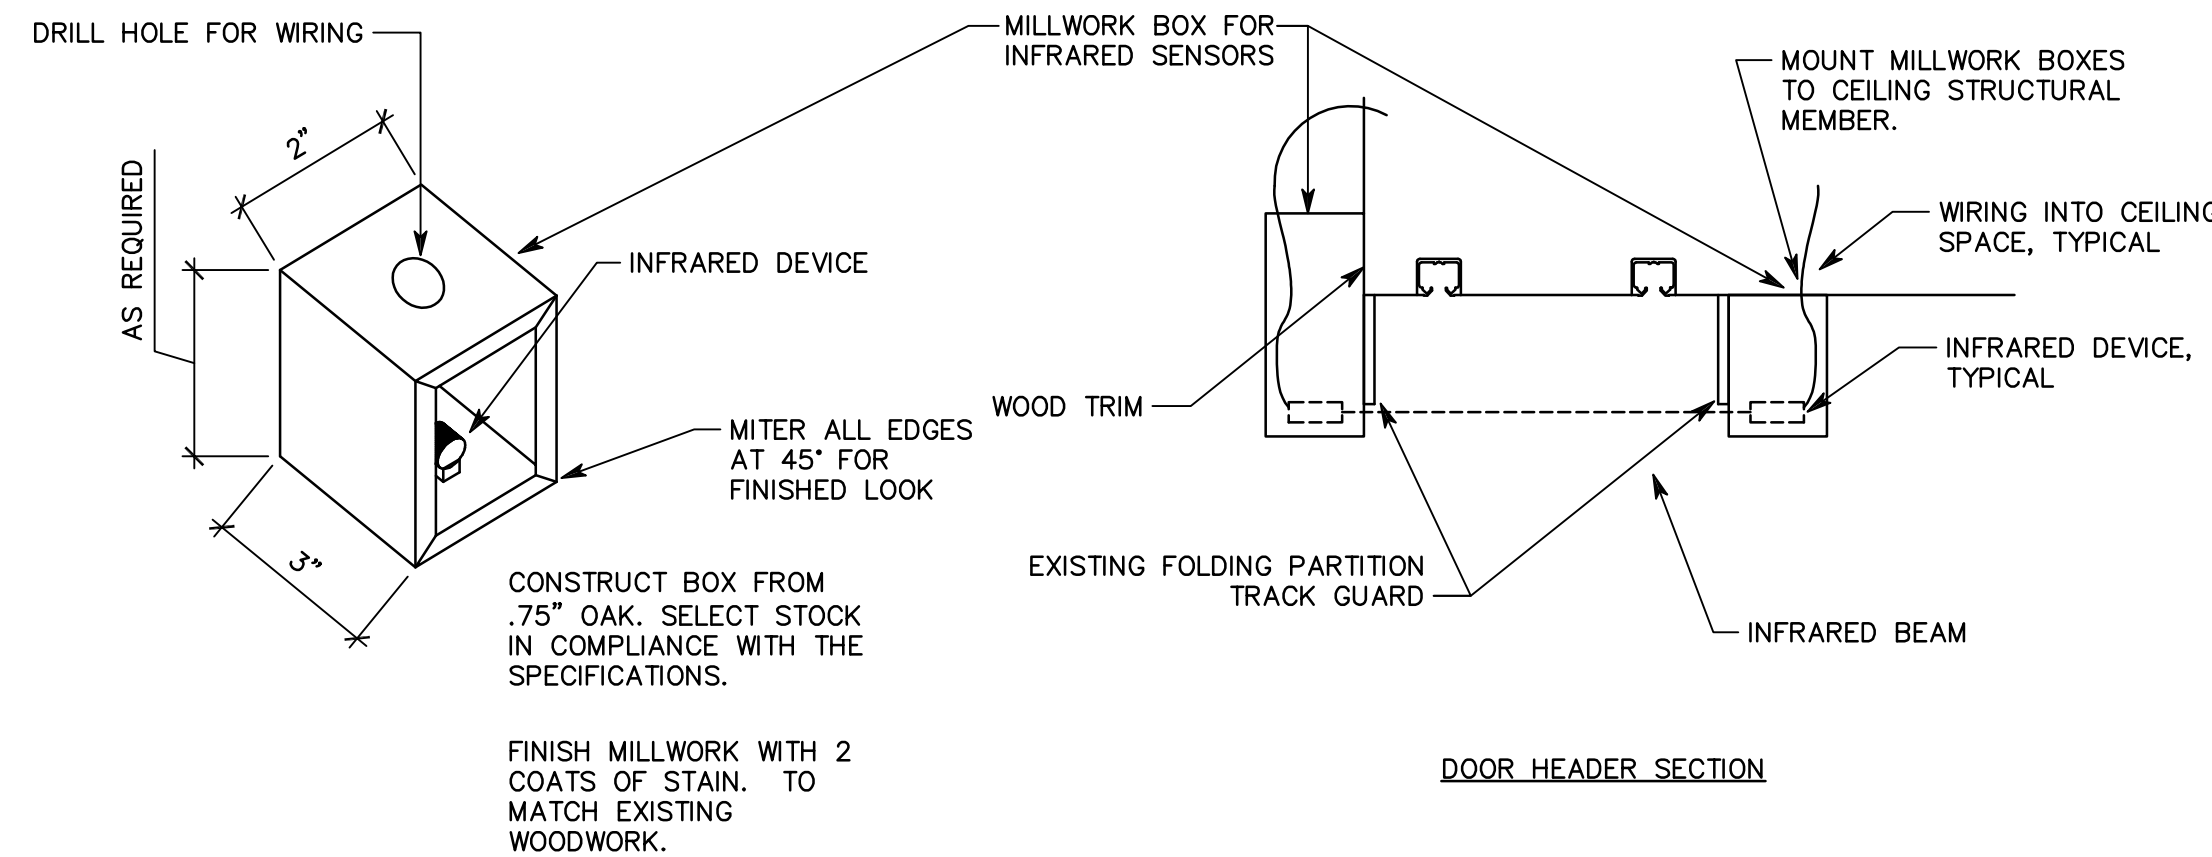

**2** INFRARED SENSOR MOUNTING DETAIL  
 NO SCALE

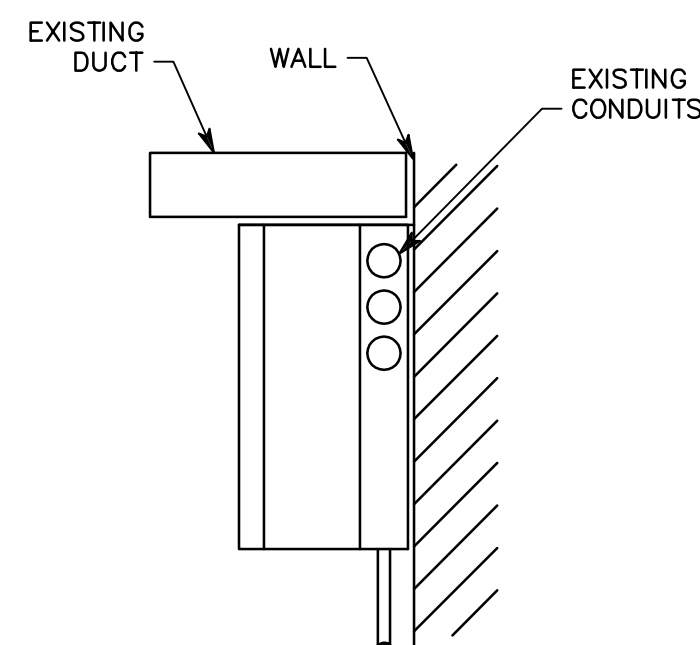

**4** EQUIPMENT CABINET MOUNTING DETAIL  
 NO SCALE

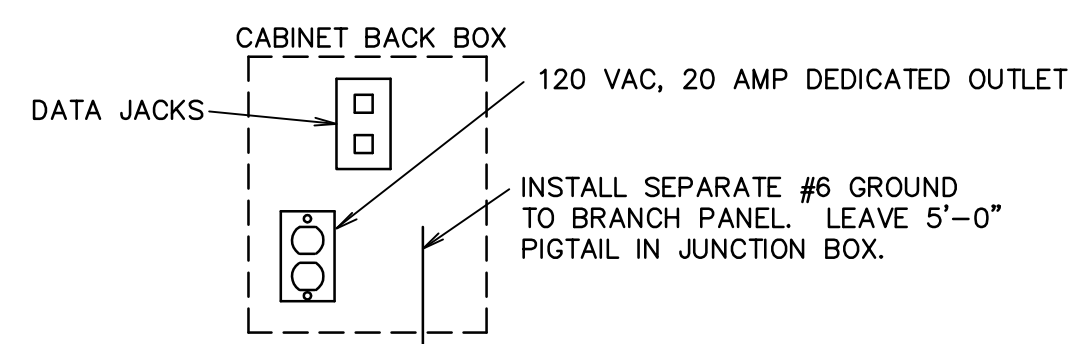

**1** SOUND CABINET POWER WIRING  
 NO SCALE

**ELECTRICAL EQUIPMENT LIST**

SYM	DESCRIPTION	QTY	ACCEPTABLE TYPES
MW RU M W U	3" DEEP, SINGLE GANG BOX MOUNTED RECESSED AT ELECTRICAL OUTLET HEIGHT, OR USE EXISTING BOX	OFF	EXCEPT AS NOTED
SV	3" DEEP, DOUBLE GANG BOX MOUNTED RECESSED AT ELECTRICAL SWITCH HEIGHT, OR USE EXISTING BOX	OFF	
V L	3" DEEP, SINGLE GANG BOX MOUNTED RECESSED AT ELECTRICAL SWITCH HEIGHT, OR USE EXISTING BOX	OFF	
CC	3.5" DEEP TRIPLE GANG BOX ORIENTED SIDWAYS AT +5'-0" ABOVE FINISHED FLOOR, OR USE EXISTING	OFF	
CP	CONTROL PEDESTAL MILLWORK, EXISTING	0	NO REQUIREMENT
IR	MILLWORK BOX MOUNTED IN DOOR HEADER	OFF	SEE DETAIL THIS SHEET
1	SOUND EQUIPMENT CABINET	1	ATLAS SOUND 324-15 MIDDLE ATLANTIC DWR-24-22 W/ FD-24 AND DWRSR-ZL
4	4" SPEAKER ENCLOSURE, EXISTING	0	NO REQUIREMENT
4	4" RECESSED METAL SPEAKER ENCLOSURE, BLIND MOUNT	OFF	ATLAS SOUND BMT95-4-7
8	8" RECESSED METAL SPEAKER ENCLOSURE	OFF	ATLAS SOUND BMT 95-8-7
8	8" SPEAKER ENCLOSURE, EXISTING	0	NO REQUIREMENT
8	8" RECESSED METAL SPEAKER ENCLOSURE, WITH T-BAR SUPPORT	OFF	ATLAS SOUND EZ 195-8 W/ FIBERGLASS
D(X)	CATEGORY 5, NON-SHIELDED, NON- PLENUM. (X) INDICATES NUMBER OF CABLES IF MORE THAN ONE	A/R	BELDEN DATABRITE 1583B WEST PENN 4245 LIBERTY 24-4P-L5-EN OR AS APPROVED BY CONSULTANT
M(X)	MICROPHONE CABLE, STRANDED (X) INDICATES NUMBER OF CABLES IF MORE THAN ONE	A/R	BELDEN 9451 WEST PENN 454 LIBERTY 22-IP-EZ OR AS APPROVED BY CONSULTANT
S(X)	SPEAKER CABLE, 16 AWG, TWISTED PAIR, JACKETED. (X) INDICATES NUMBER OF CABLES IF MORE THAN ONE	A/R	BELDEN 8471 WEST PENN 225 LIBERTY 16-2C-GRY OR AS APPROVED BY CONSULTANT

MANUFACTURER'S NAMES AND TELEPHONE NUMBERS ARE LOCATED IN THE SPECIFICATIONS  
 A/R = AS REQUIRED. SEE DRAWINGS FOR QUANTITIES REQUIRED.  
 OFF = OBTAIN FROM PLANS. SEE DRAWINGS FOR QUANTITIES REQUIRED.

MARK	DATE	REVISION
	01-07-14	RECORD DRAWINGS



324 S. State St., Suite 400  
 Salt Lake City, UT 84111  
 800-678-7077  
 801-328-5151  
 fax: 801-328-5155  
 www.spectrum-engineers.com

© 2014 Spectrum Engineers, Inc.

THESE RECORD DOCUMENTS HAVE BEEN PREPARED BASED ON INFORMATION PROVIDED BY OTHERS. THE DESIGN PROFESSIONAL HAS NOT VERIFIED THE ACCURACY AND/OR COMPLETENESS OF THIS INFORMATION AND SHALL NOT BE RESPONSIBLE FOR ANY ERRORS OR OMISSIONS WHICH MAY BE INCORPORATED HEREIN AS A RESULT.

PROJECT FOR  
**THE CHURCH OF JESUS CHRIST OF LATTER-DAY SAINTS**

PROJECT NAME  
 MENAN 2, 3 SOUND SYSTEM UPGRADE


PROJECT ADDRESS  
 3547 E. MENAN-LORENZO HIGHWAY  
 MENAN, IDAHO

SHEET TITLE  
 ELECTRICAL EQUIPMENT LIST AND DETAILS


PROJECT DESIGNATION  
 20130380.AWA  
 PROPERTY NUMBER  
 507-2638  
 DEVELOPMENT NUMBER  
 CUSTOM  
 DATE  
 22 AUG 2013

SHEET NO.  
 E-3


File Name: P:\2013\20130380\Drawings\3Sheet\80T-1.dwg Last Plotted: 2014/01/07 @ 3:25 PM By: sit

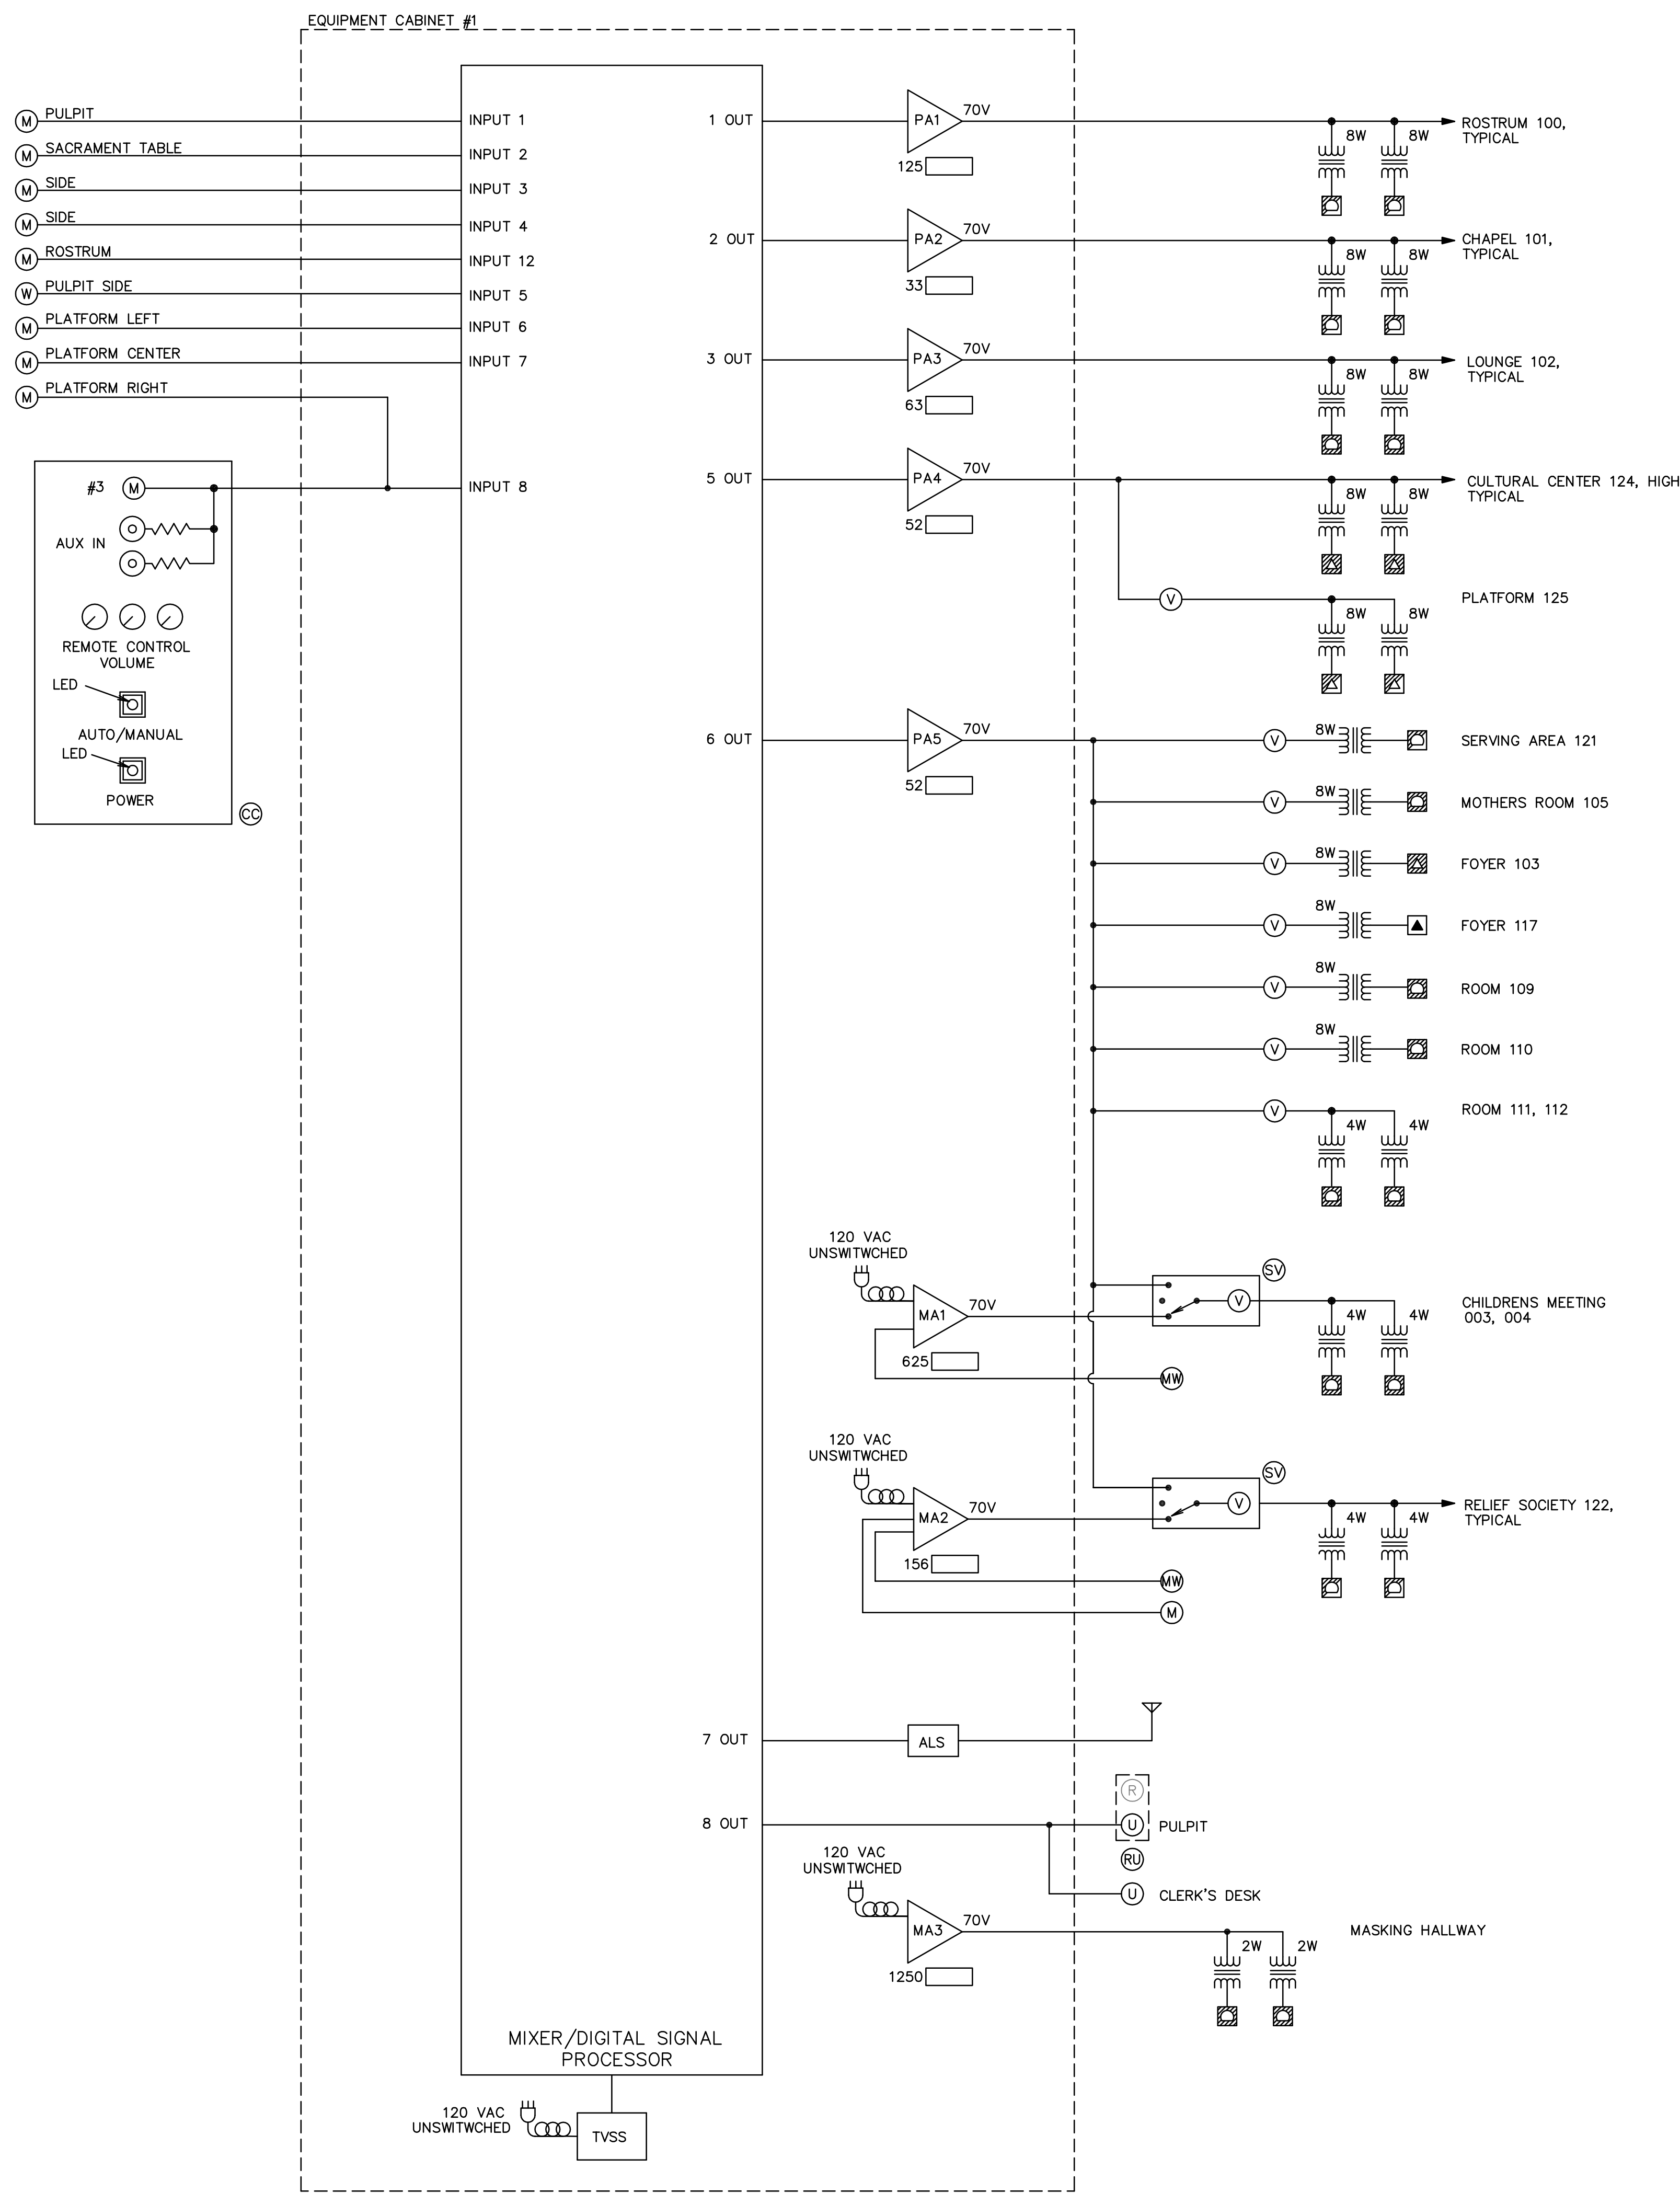


**SOUND SYSTEM SINGLE LINE DIAGRAM (FOR BSS EQUIPMENT)**  
NO SCALE

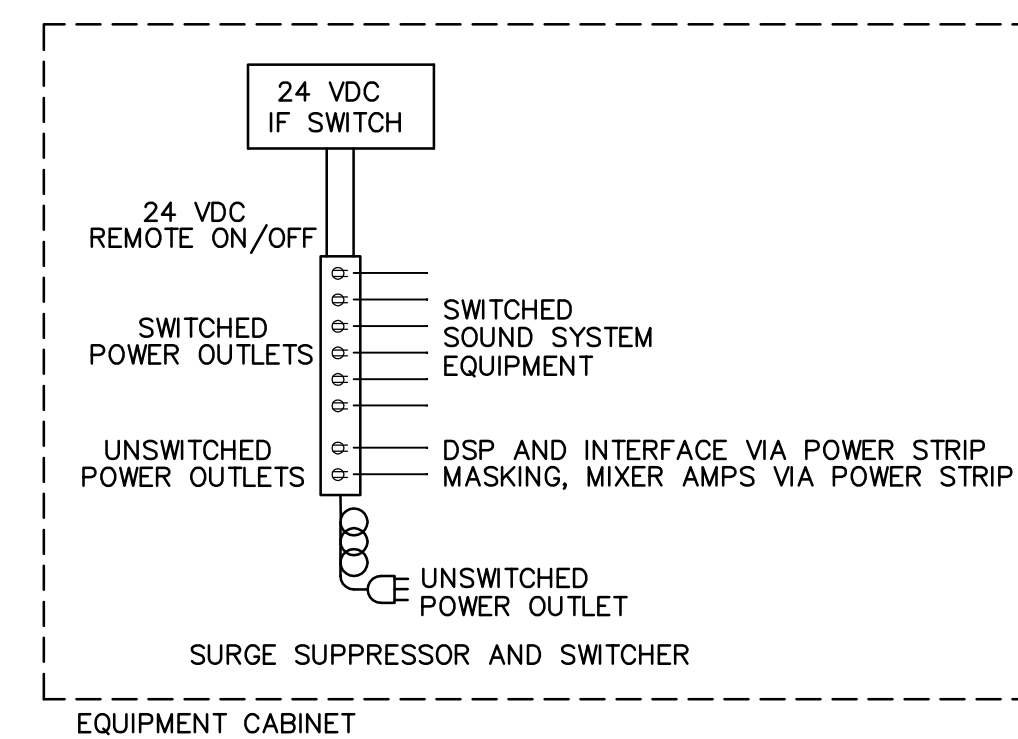

**REMOTE CONTROL DIAGRAM**  
NO SCALE

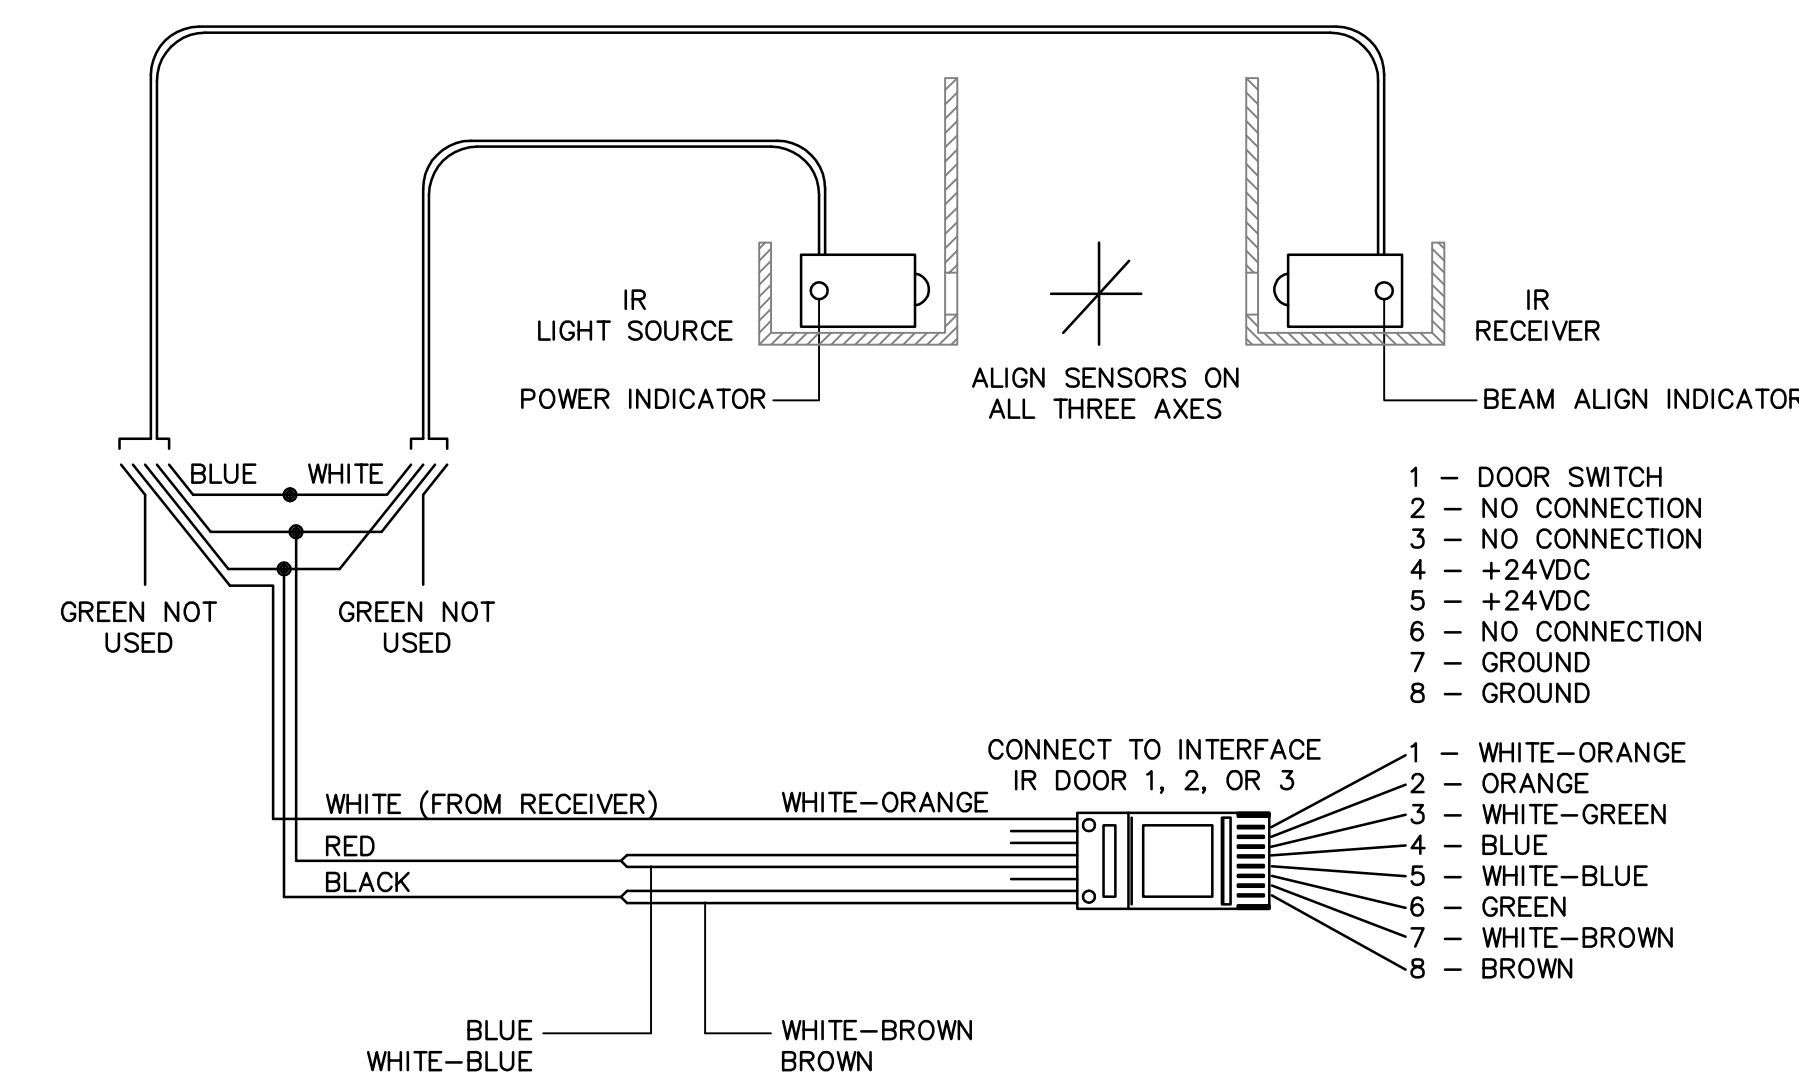

**INFRARED DOOR SENSOR WIRING DIAGRAM**  
NO SCALE

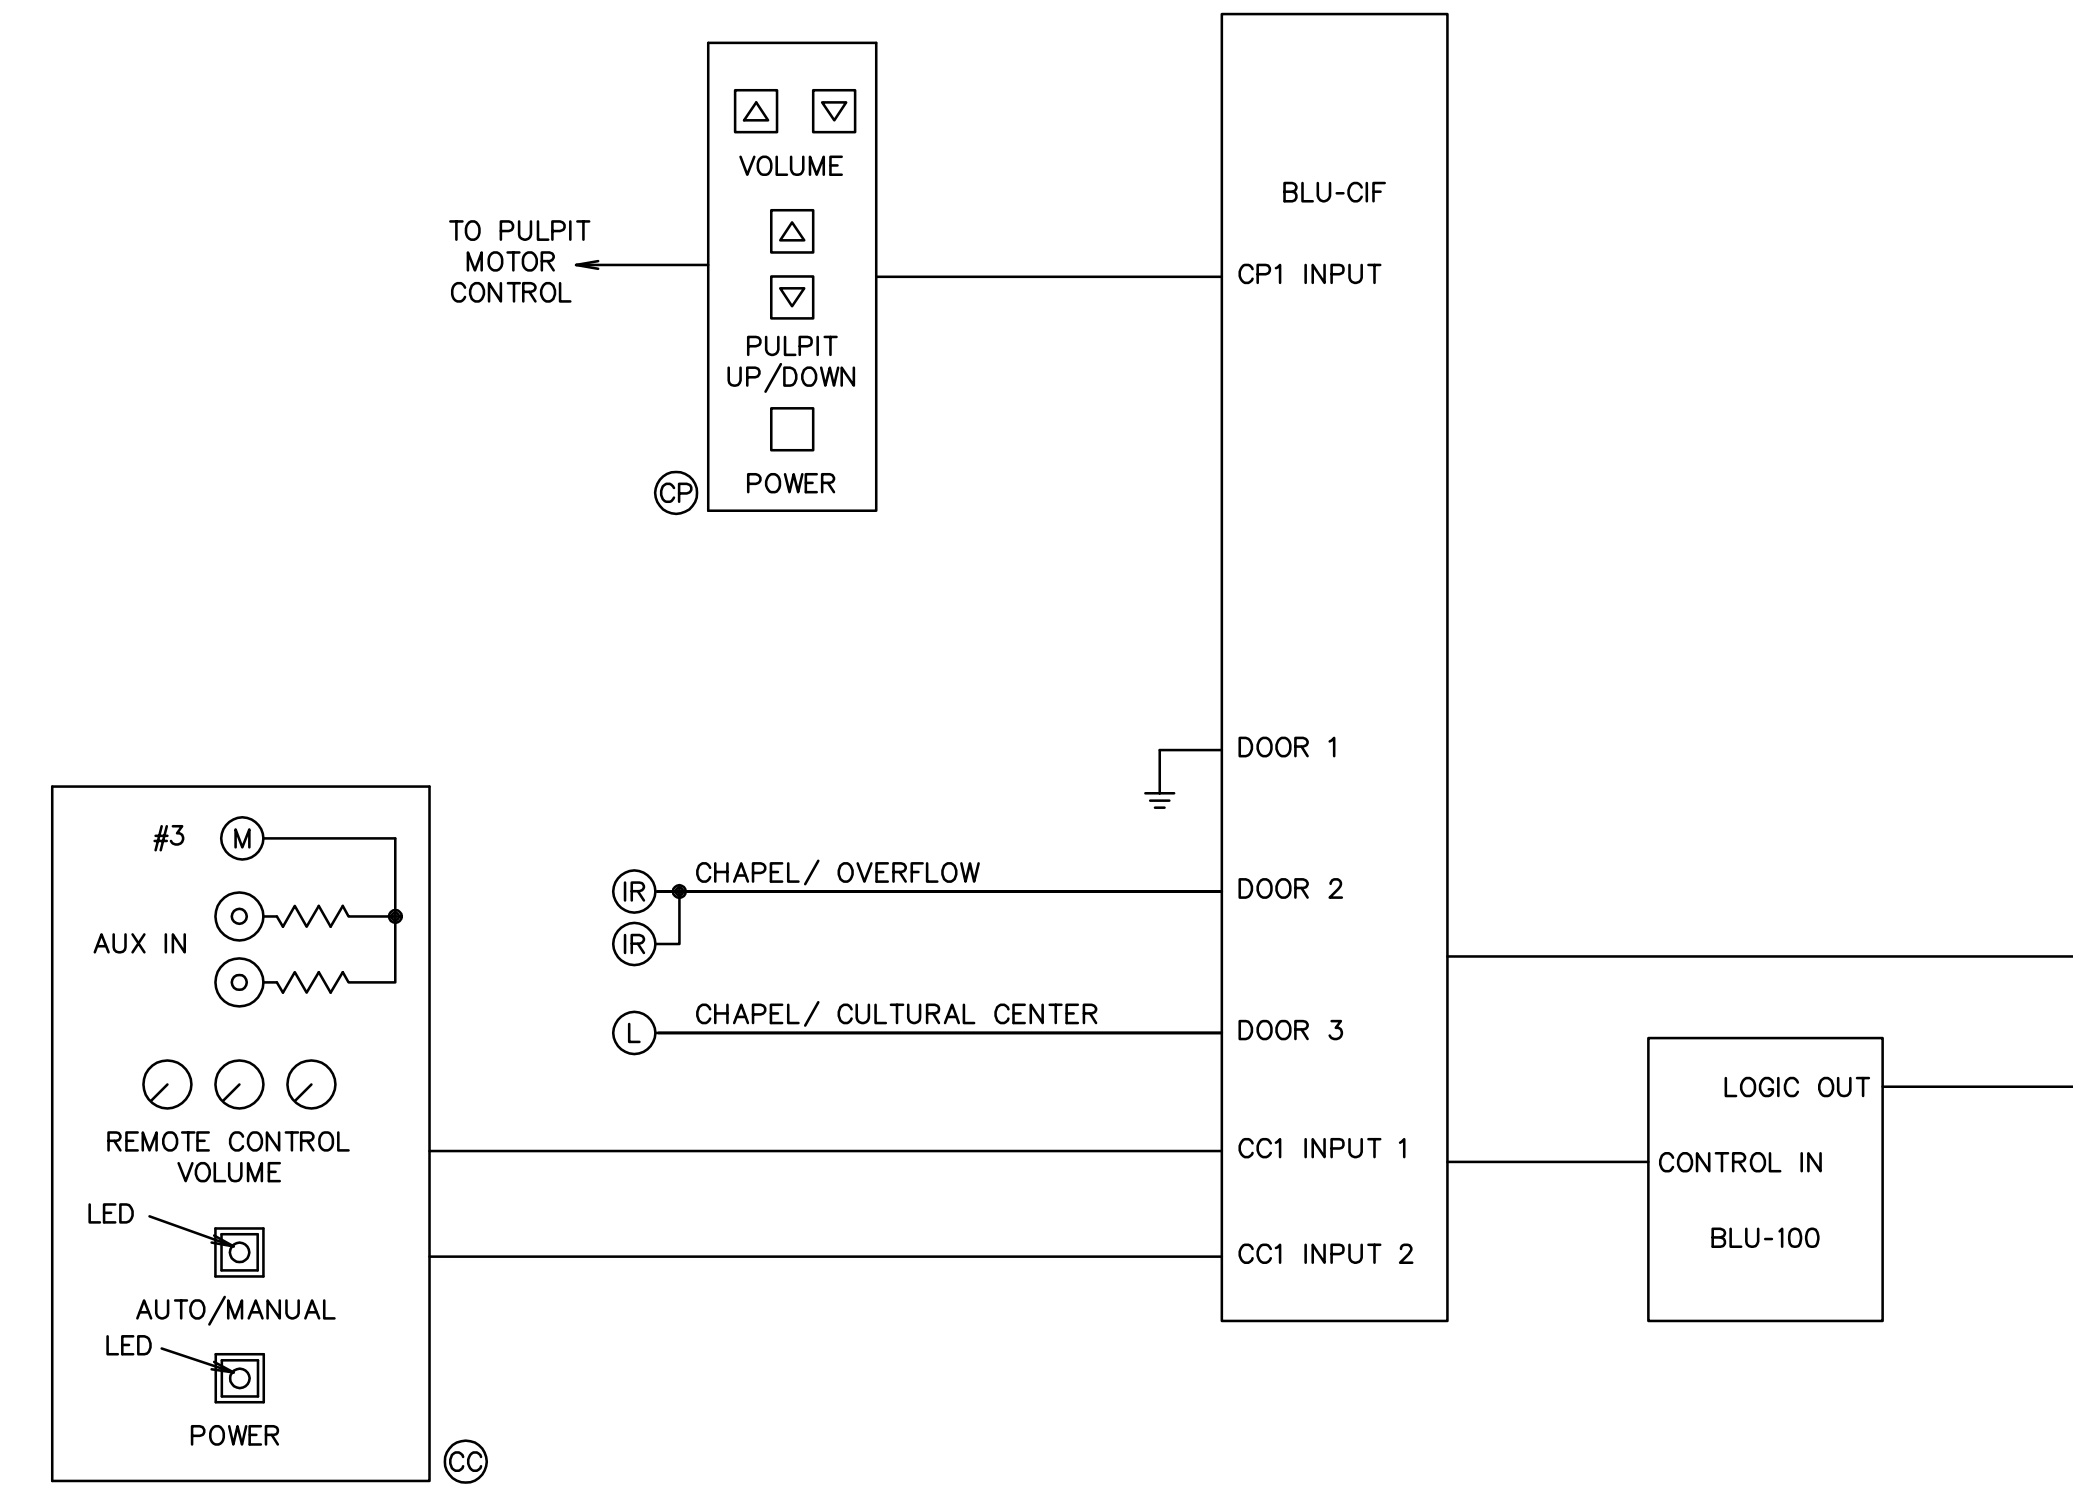

**REMOTE CONTROL WIRING DIAGRAM**  
NO SCALE

**SOUND NOTES**

- ALL OBSOLETE SOUND EQUIPMENT WILL REMAIN PROPERTY OF THE OWNER. REMOVE AND DELIVER TO THE FM GROUP.
- MOUNT SNUBBER DIODES ON ALL RELAYS. IT IS SOUND CONTRACTORS RESPONSIBILITY TO REMOVE STATIC CLICK IN SOUND SYSTEM WHEN PULPIT IS RAISED/LOWERED.
- INSTALL THE HEARING ASSISTANCE SYSTEM ANTENNA IN ACCESSIBLE ATTIC SPACE. USE THE FACTORY SUPPLIED CABLE. DO NOT ALTER LENGTH OR CONNECTORS.
- CONNECT DSP AND INTERFACE TO UNSWITCHED POWER OF SURGE SUPPRESSOR. CONNECT MIXER AMPS AND MASKING AMP TO SECOND UNSWITCHED OUTLET OF SURGE SUPPRESSOR. CONNECT BALANCE OF SOUND EQUIPMENT TO SWITCHED OUTLETS. SEE REMOTE DIAGRAM.
- CONNECT #6 GROUND WIRE TO MIDDLE SECTION OF SOUND CABINET WITHIN 12" OF DSP VIA GROUNDING BLOCK. CONNECT DSP GROUND TO GROUNDING BLOCK.
- ENABLE PHANTOM POWER ON MICROPHONE INPUTS FOR THE RELIEF SOCIETY ROOM AND CHILDREN'S MEETING ROOM MIXER/AMPLIFIERS. PHANTOM POWER CHAPEL AND CULTURAL CENTER MICROPHONE INPUTS FROM MIXER ONLY. ACTIVATE "LAST ON" OPTION FOR CHAPEL AND CULTURAL CENTER MICROPHONE INPUTS.
- SOUND SYSTEM SINGLE LINE DIAGRAM SHOWS THE CONNECTION OF THE BSS MIXER/PROCESSOR. IF THE INSTALLER SELECTS THE IVE MIXER/PROCESSOR, CONTACT SOUND/ACOUSTICAL CONSULTANT.
- INSTALL NEW SPEAKERS, TRANSFORMERS, GRILLES, AND TORSION SPRINGS IN ALL EXISTING SPEAKER ENCLOSURES. PROVIDE FIBERGLASS INSULATION IN ENCLOSURES IF NOT EXISTING.
- REPLACE ALL EXISTING SOUND SYSTEM MODULES AND COVER PLATES.
- MODIFY STANDARD DSP TEMPLATE SO OVERFLOW FROM CHAPEL TO LOUNGE AND CULTURAL CENTER ARE INDEPENDENT OF EACH OTHER.

MARK	DATE	REVISION
	01-07-14	RECORD DRAWINGS



324 S. State St., Suite 400  
Salt Lake City, UT 84111  
800-678-7077  
801-328-5151  
fax: 801-328-5155  
www.spectrum-engineers.com

© 2014 Spectrum Engineers, Inc.


THESE RECORD DOCUMENTS HAVE BEEN PREPARED BASED ON INFORMATION PROVIDED BY OTHERS. THE DESIGN PROFESSIONAL HAS NOT VERIFIED THE ACCURACY AND/OR COMPLETENESS OF THIS INFORMATION AND SHALL NOT BE RESPONSIBLE FOR ANY ERRORS OR OMISSIONS WHICH MAY BE INCORPORATED HEREIN AS A RESULT.

PROJECT FOR  
**THE CHURCH OF JESUS CHRIST OF LATTER-DAY SAINTS**  
PROJECT NAME  
MENAN 2, 3 SOUND SYSTEM UPGRADE  
PROJECT ADDRESS  
3547 E. MENAN-LORENZO HIGHWAY  
MENAN, IDAHO


SHEET TITLE  
SOUND SYSTEM DETAILS, DIAGRAMS, AND NOTES

PROJECT DESIGNATION 20130380.AWA	
PROPERTY NUMBER 507-2638	SHEET NO. T-1
DEVELOPMENT NUMBER CUSTOM	
DATE 22 AUG 2013	



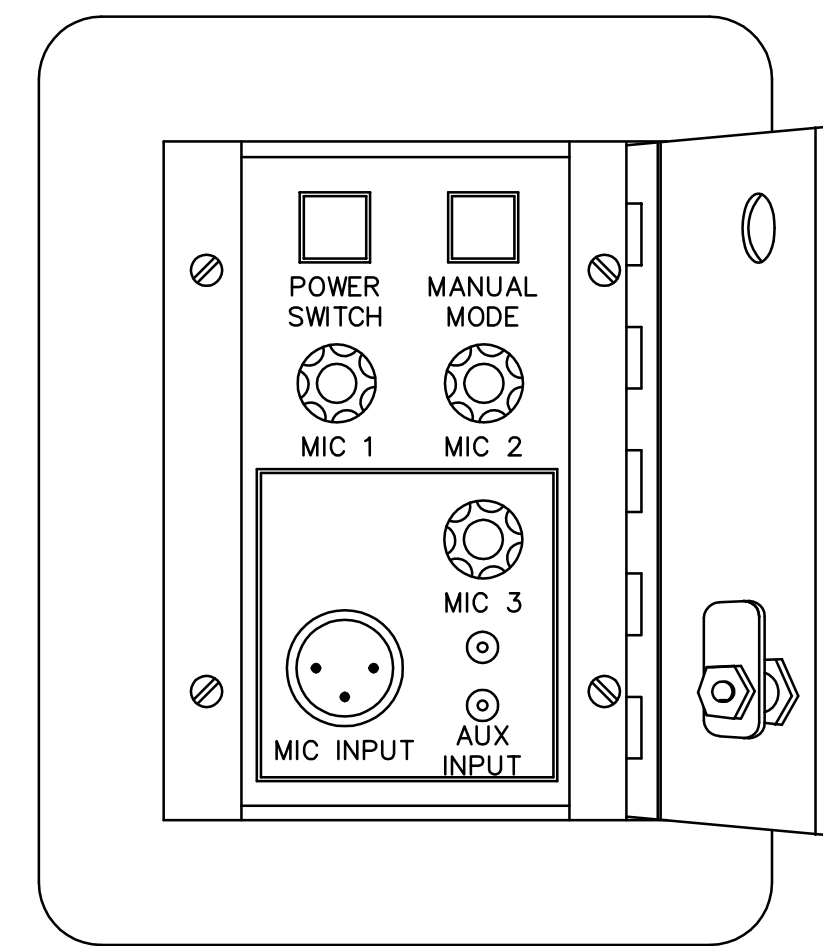

4 CULTURAL CENTER REMOTE CONTROL PANEL DETAIL

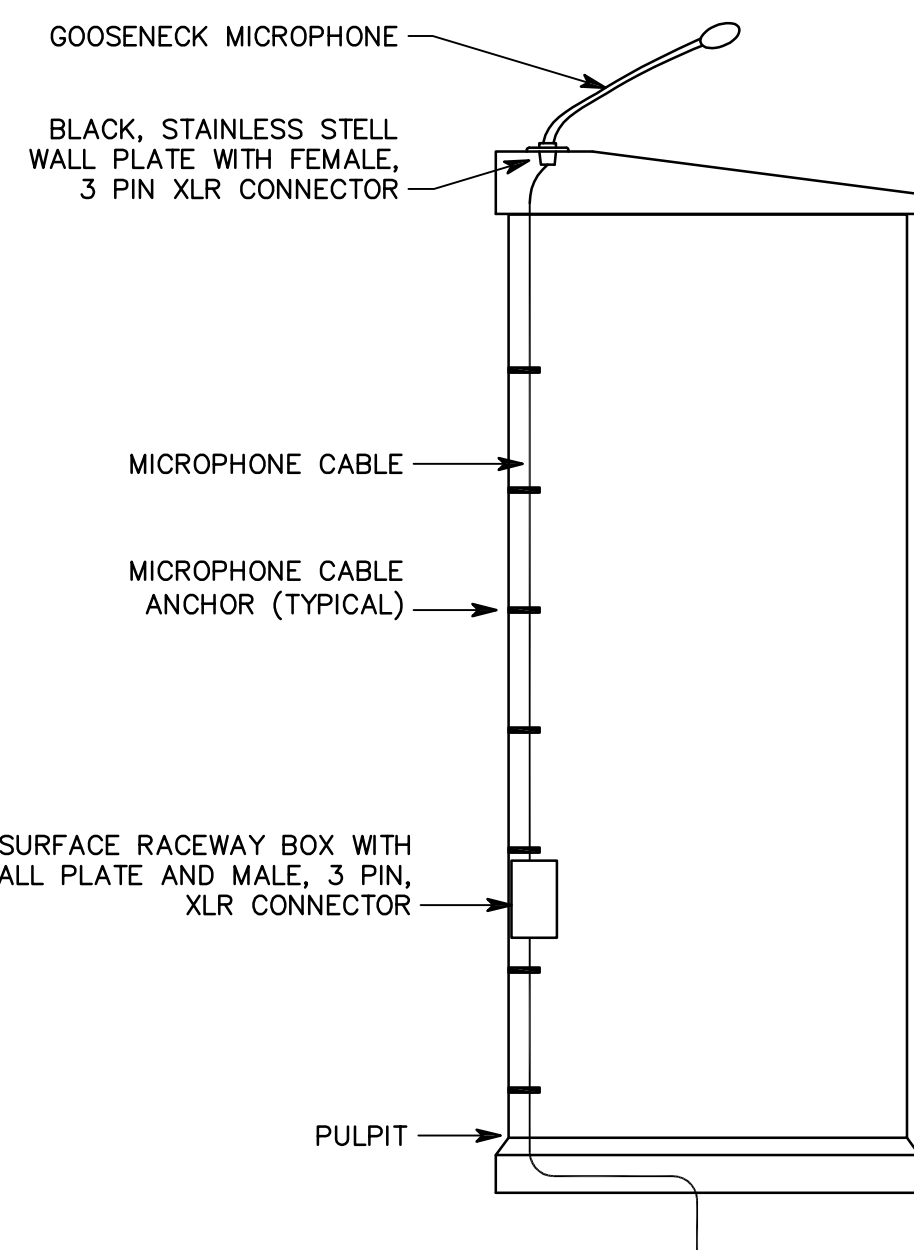


2 CHILDREN'S ROOM PULPIT DETAIL

SOUND EQUIPMENT LIST


SYM	DESCRIPTION	QTY	ACCEPTABLE TYPES
	50' MICROPHONE EXTENSION CABLES WITH BLACK CONNECTORS	2	CONQUEST B84-50 WHIRLWIND MK450
	MICROPHONE, GENERAL USE	2	ELECTRO-VOICE N/D767 SHURE BETA 57A
	LAVALIER MICROPHONE	1	COUNTRYMAN ASSOCIATES B3PLDSFF03.5B
	MICROPHONE, CHAPEL PULPIT	1	AUDIO TECHNICA ES905QL PROVIDE PHANTOM POWER
	MICROPHONE, PORTABLE PULPIT	1	AUDIO TECHNICA U855QL
	15'-0" MICROPHONE EXTENSION CABLE WITH BLACK CONNECTORS	1	CONQUEST B84-15 WHIRLWIND MK415
	STAINLESS STEEL MICROPHONE INPUTS W/BLACK POWDER COAT FINISH MOUNTED TO PULPIT	1	SEE DETAIL 2/T-2
	MICROPHONE, SACRAMENT, SEE DETAIL 1/T-2	1	BSS BLU-SM IVE IM-10
	10'-0" MICROPHONE EXTENSION CABLE W/90° MALE CONNECTOR	1	CONQUEST B84-10 WHIRLWIND MK410
	PEDESTRIAN STRIP, 8'	1	
	MULTI-IMPEDANCE BOX	1	EMTECH EJ-8
	MICROPHONE STAND, FLOOR TYPE	1	ATLAS SOUND MS20E
(M)	MICROPHONE INPUT MODULE	OFF	EMTECH MSC-M
	SINGLE GANG, HIGH IMPACT NYLON COVER PLATE	OFF	HUBBELL OR LEVITON
(MW)	MICROPHONE/AUX INPUT MODULE	OFF	EMTECH MSC-MW3
	SINGLE GANG, HIGH IMPACT NYLON COVER PLATE	OFF	HUBBELL OR LEVITON
(V)	VOLUME CONTROL MODULE	OFF	EMTECH MSC-V10, V35 SELECT APPROPRIATE MODEL FOR SPEAKER LOAD
	SINGLE GANG, HIGH IMPACT NYLON COVER PLATE	OFF	HUBBELL OR LEVITON
(SV)	SOURCE SWITCH MODULE	OFF	EMTECH MSC-S
	VOLUME CONTROL MODULE	OFF	EMTECH MSC-V35
	DOUBLE GANG, HIGH IMPACT NYLON COVER PLATE	OFF	HUBBELL OR LEVITON
(L)	SPEAKER SELECTOR SWITCH	OFF	EMTECH MSC-L USE 'S' MODULE LABEL ON 'L'-TYPE SWITCH
	SINGLE GANG, HIGH IMPACT NYLON COVER PLATE	OFF	HUBBELL OR LEVITON
(CP)	CHAPEL CONTROL PEDESTAL PLATE	1	BSS BLU-CP IVE RMI-CP
	ADAPTOR PLATE	1	EMTECH SPC5x7
(U)	SOUND SYSTEM OUT	OFF	EMTECH MSC-U
	SINGLE GANG, HIGH IMPACT NYLON COVER PLATE	OFF	HUBBELL OR LEVITON
(W)	LINE LEVEL INPUT MODULE	OFF	EMTECH MSC-W
	SINGLE GANG, HIGH IMPACT NYLON COVER PLATE	OFF	HUBBELL OR LEVITON
(RU)	NETWORK/ SOUND SYSTEM OUT	OFF	EMTECH MSC-RU
	SINGLE GANG, HIGH IMPACT NYLON COVER PLATE	OFF	HUBBELL OR LEVITON
	BLANK METAL COVER PLATE	OFF	EMTECH 170-BB

SYM	DESCRIPTION	QTY	ACCEPTABLE TYPES
(CC)	CULTURAL CENTER REMOTE CONTROL PANEL	1	BSS BLU-CC IVE RMI-CC
(IR)	INFRARED DETECTORS	OFF	BSS BLU-IR IVE IR-3
	DOUBLE GANG, HIGH IMPACT NYLON OR PLASTIC BLANK COVER PLATE	OFF	HUBBELL OR LEVITON
	MIXER, DIGITAL SIGNAL PROCESSOR, AND POWER SUPPLY	1	BSS LONDON BLU-100 W/BLU-CIF IVE 1280 W/ LDS POWER RELAY AND RMP-12-45
	POWER AMPLIFIERS	PA1, PA2	QSC CX302V CROWN CTs600
		PA3-PA5	QSC CX204V CROWN CTs4200
		MA1-MA2	ATLAS SOUND AA35 W/ RACK KIT AND PHANTOM POWER TOA BG-2035 W/ RACK KIT AND MOIS MODULE
		MA3	TOA BG-2035 W/ RACK KIT W/ EMTECH SMG-100 MODULE
	SECURITY COVERS FOR MA1 - MA3	A/R	MIDDLE ATLANTIC SECS-2 AND W/HTX SCREWS OR EQUIVALENT
	ETHERNET SWITCH, 16-PORT	1	
(ALS)	HEARING IMPAIRED SYSTEM	1	COMTEK CC-75LD
	MATCHING ISOLATION TRANSFORMERS, 600:600 OHM	A/R	PRO CO LOT 1 RDS TX-1A
	AUDIO DISTRIBUTION AMPLIFIER	A/R	RDL RUDA4D MOUNTED ON RU-RA3
(TVSS)	SURGE SUPPRESSOR AND SWITCHER	1	SURGEX SX115RT LOWELL ACSP-RPC1R-1509
	POWER STRIP	A/R	6 OUTLET POWER STRIP OR EQUAL
(S)	SPEAKER, 4" W/ TRANSFORMER	OFF	LOWELL JR410-T870 ELECTRO-VOICE 2058T ATLAS SOUND FC104T
(S)	SPEAKER, 4" W/ TRANSFORMER	OFF	LOWELL JR410-T870 ELECTRO-VOICE 2058T ATLAS SOUND FC104T
	LOUD SPEAKER GRILLE	OFF	ATLAS SOUND T720-4BT LOWELL CN-4M
(S)	SPEAKER, 8" W/ TRANSFORMER	OFF	ATLAS SOUND C803A-T87 ELECTRO VOICE 309-BT
	SQUARE SPEAKER GRILLE	1	ATLAS SOUND 170-8A
(S)	SPEAKER, 8" W/ TRANSFORMER	OFF	ATLAS SOUND C803A-T87 ELECTRO VOICE 309-BT
	LOUD SPEAKER GRILLE	OFF	ATLAS SOUND 170-8A
(S)	SPEAKER, 8" W/ TRANSFORMER	OFF	ATLAS SOUND C803A-T87 ELECTRO VOICE 309-BT
	SQUARE SPEAKER GRILLE	1	ATLAS SOUND 170-8A

MANUFACTURER'S NAMES AND TELEPHONE NUMBERS ARE LISTED IN THE SPECIFICATIONS  
 A/R = AS REQUIRED  
 OFF = OBTAIN FROM PLANS  
 RMK = RACK MOUNT KIT

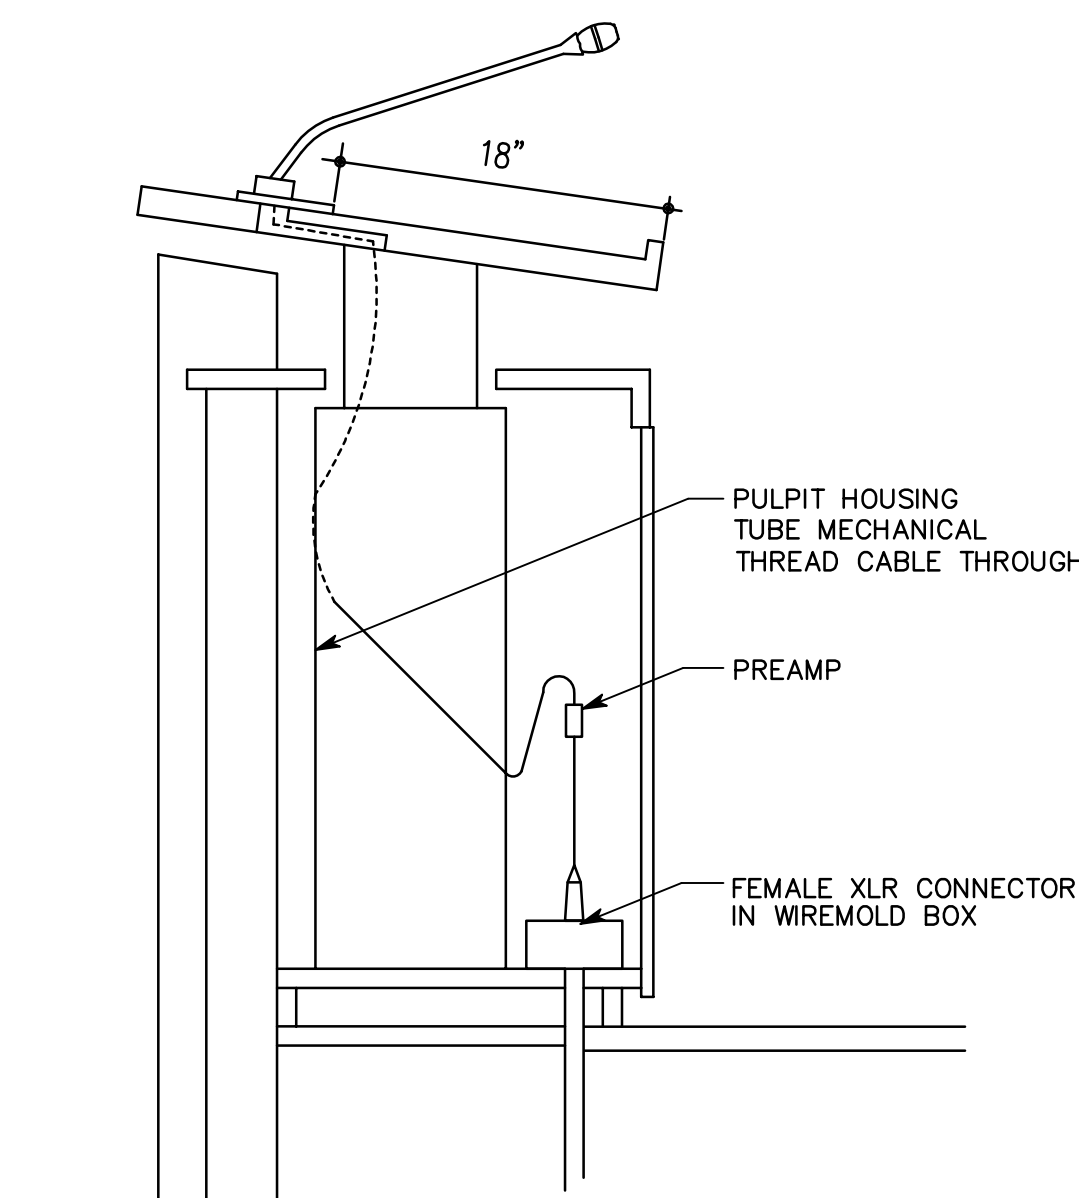

3 CHAPEL PULPIT SECTION

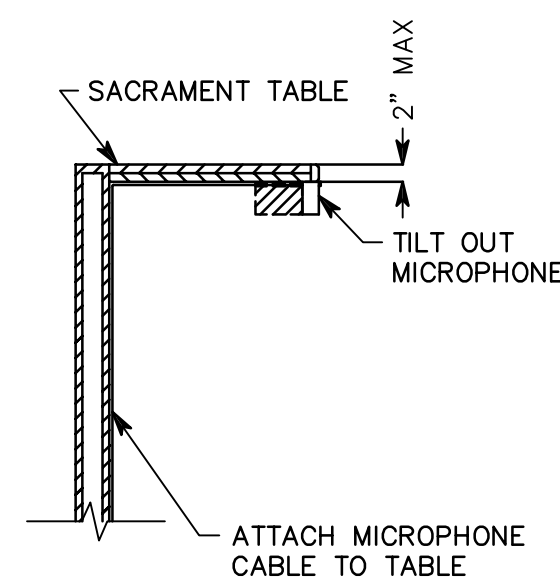

1 SACRAMENT MICROPHONE SECTION

MARK	DATE	REVISION
	01-07-14	RECORD DRAWINGS


**SPECTRUM ENGINEERS**

324 S. State St., Suite 400  
 Salt Lake City, UT 84111  
 800-678-7077  
 801-328-5151  
 fax: 801-328-5155  
 www.spectrum-engineers.com

© 2014 Spectrum Engineers, Inc.

THESE RECORD DOCUMENTS HAVE BEEN PREPARED BASED ON INFORMATION PROVIDED BY OTHERS. THE DESIGN PROFESSIONAL HAS NOT VERIFIED THE ACCURACY AND/OR COMPLETENESS OF THIS INFORMATION AND SHALL NOT BE RESPONSIBLE FOR ANY ERRORS OR OMISSIONS WHICH MAY BE INCORPORATED HEREIN AS A RESULT.

PROJECT FOR  
**THE CHURCH OF JESUS CHRIST OF LATTER-DAY SAINTS**

PROJECT NAME  
 MENAN 2, 3 SOUND SYSTEM UPGRADE

PROJECT ADDRESS  
 3547 E. MENAN-LORENZO HIGHWAY  
 MENAN, IDAHO

SHEET TITLE  
 SOUND EQUIPMENT LIST AND DETAILS

PROJECT DESIGNATION  
 20130380.AWA

PROPERTY NUMBER  
 507-2638

DEVELOPMENT NUMBER  
 CUSTOM

DATE  
 22 AUG 2013

SHEET NO.  
 T-2